
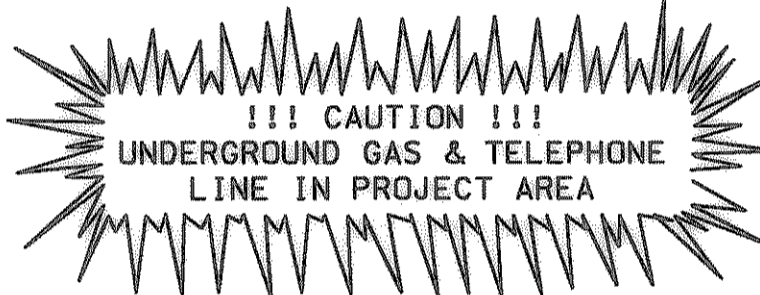
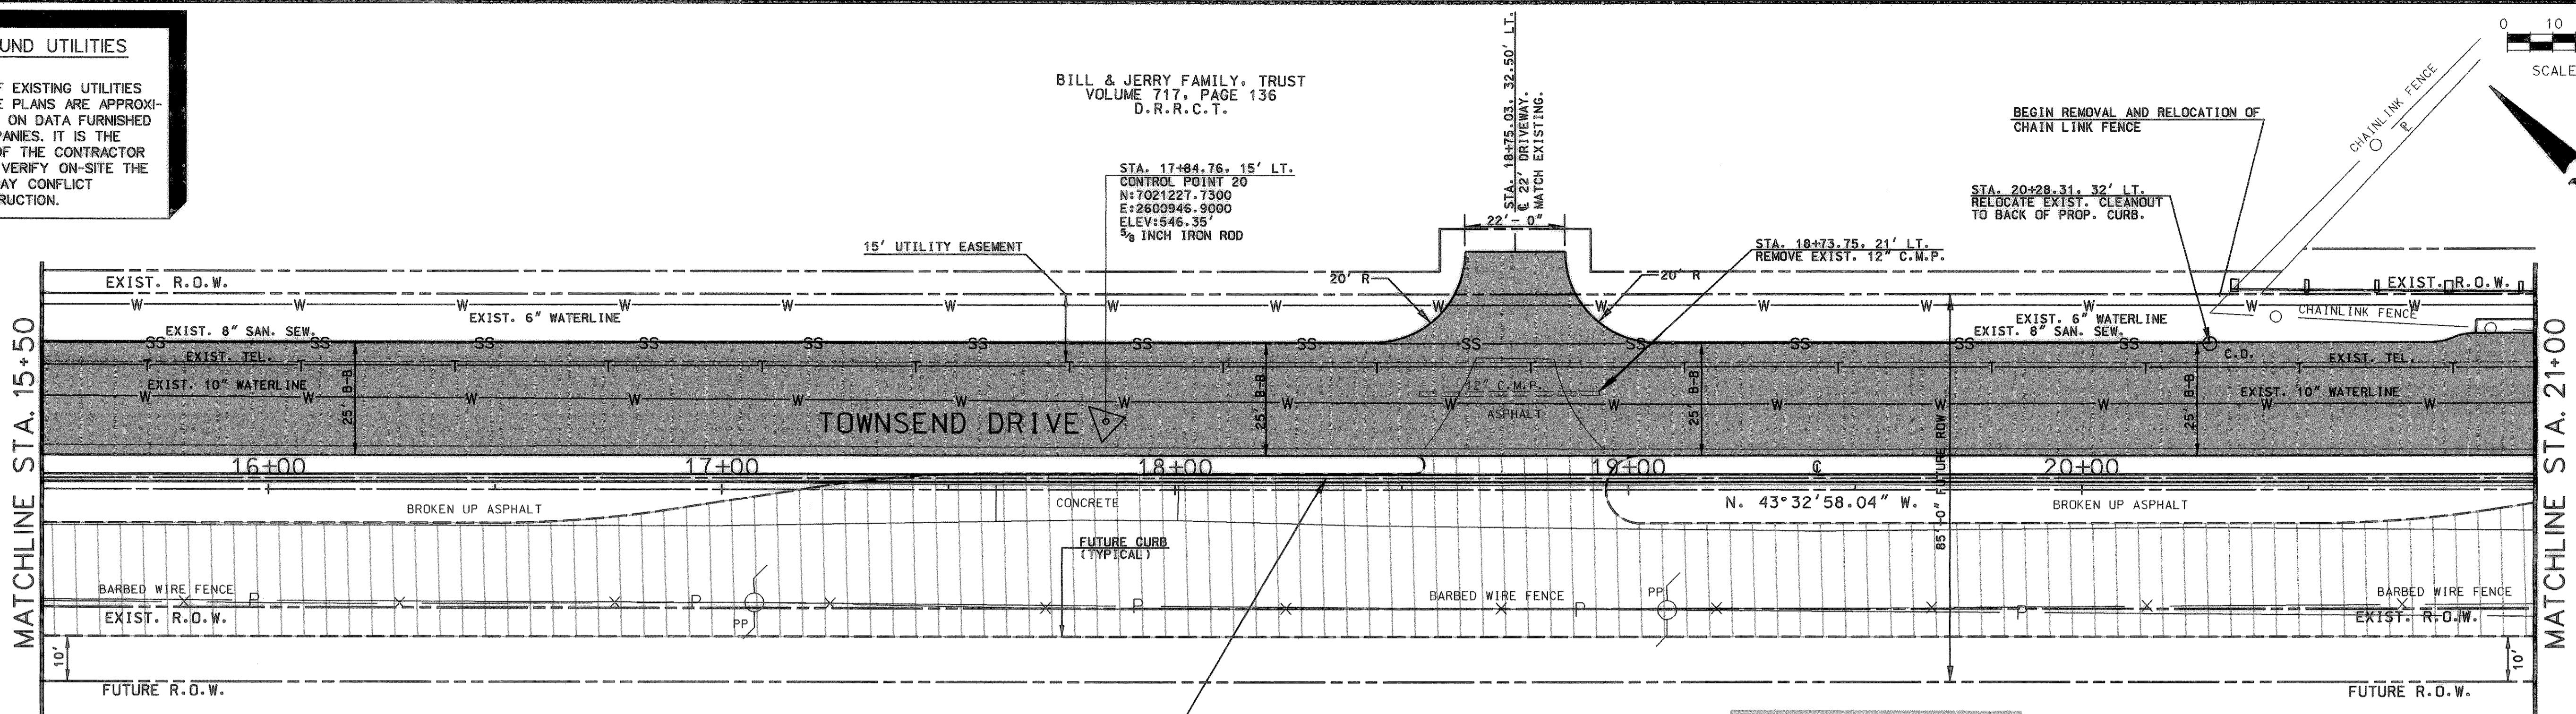
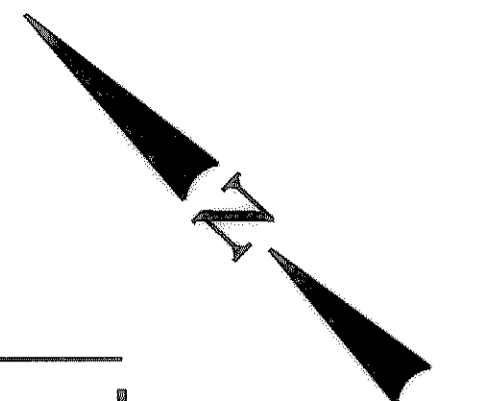


UNDERGROUND UTILITIES

THE LOCATION OF EXISTING UTILITIES SHOWN ON THESE PLANS ARE APPROXIMATE AND BASED ON DATA FURNISHED BY UTILITY COMPANIES. IT IS THE RESPONSIBILITY OF THE CONTRACTOR TO LOCATE AND VERIFY ON-SITE THE UTILITIES THAT MAY CONFLICT WITH THE CONSTRUCTION.

BILL & JERRY FAMILY, TRUST
VOLUME 717, PAGE 136
D.R.R.C.T.


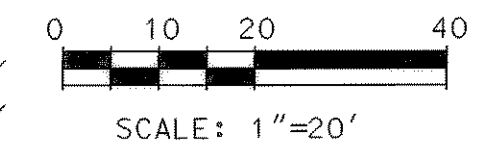


CAMBRIDGE COMPANIES
VOLUME 105, PAGE 505
D.R.R.C.T.

RECORD DRAWINGS
These record drawings have been prepared using information provided by the Construction Contractor and/or Owner. The seal and signature below only signifies that the plans have been revised in accordance with the information provided and does not guarantee that these plans accurately show every detail of the constructed project.

Design Date 4/02
Signature _____
Date _____

- LEGEND**
- PROPOSED CONCRETE CONSTRUCTION
 - FUTURE CONSTRUCTION
 - FUTURE CURB

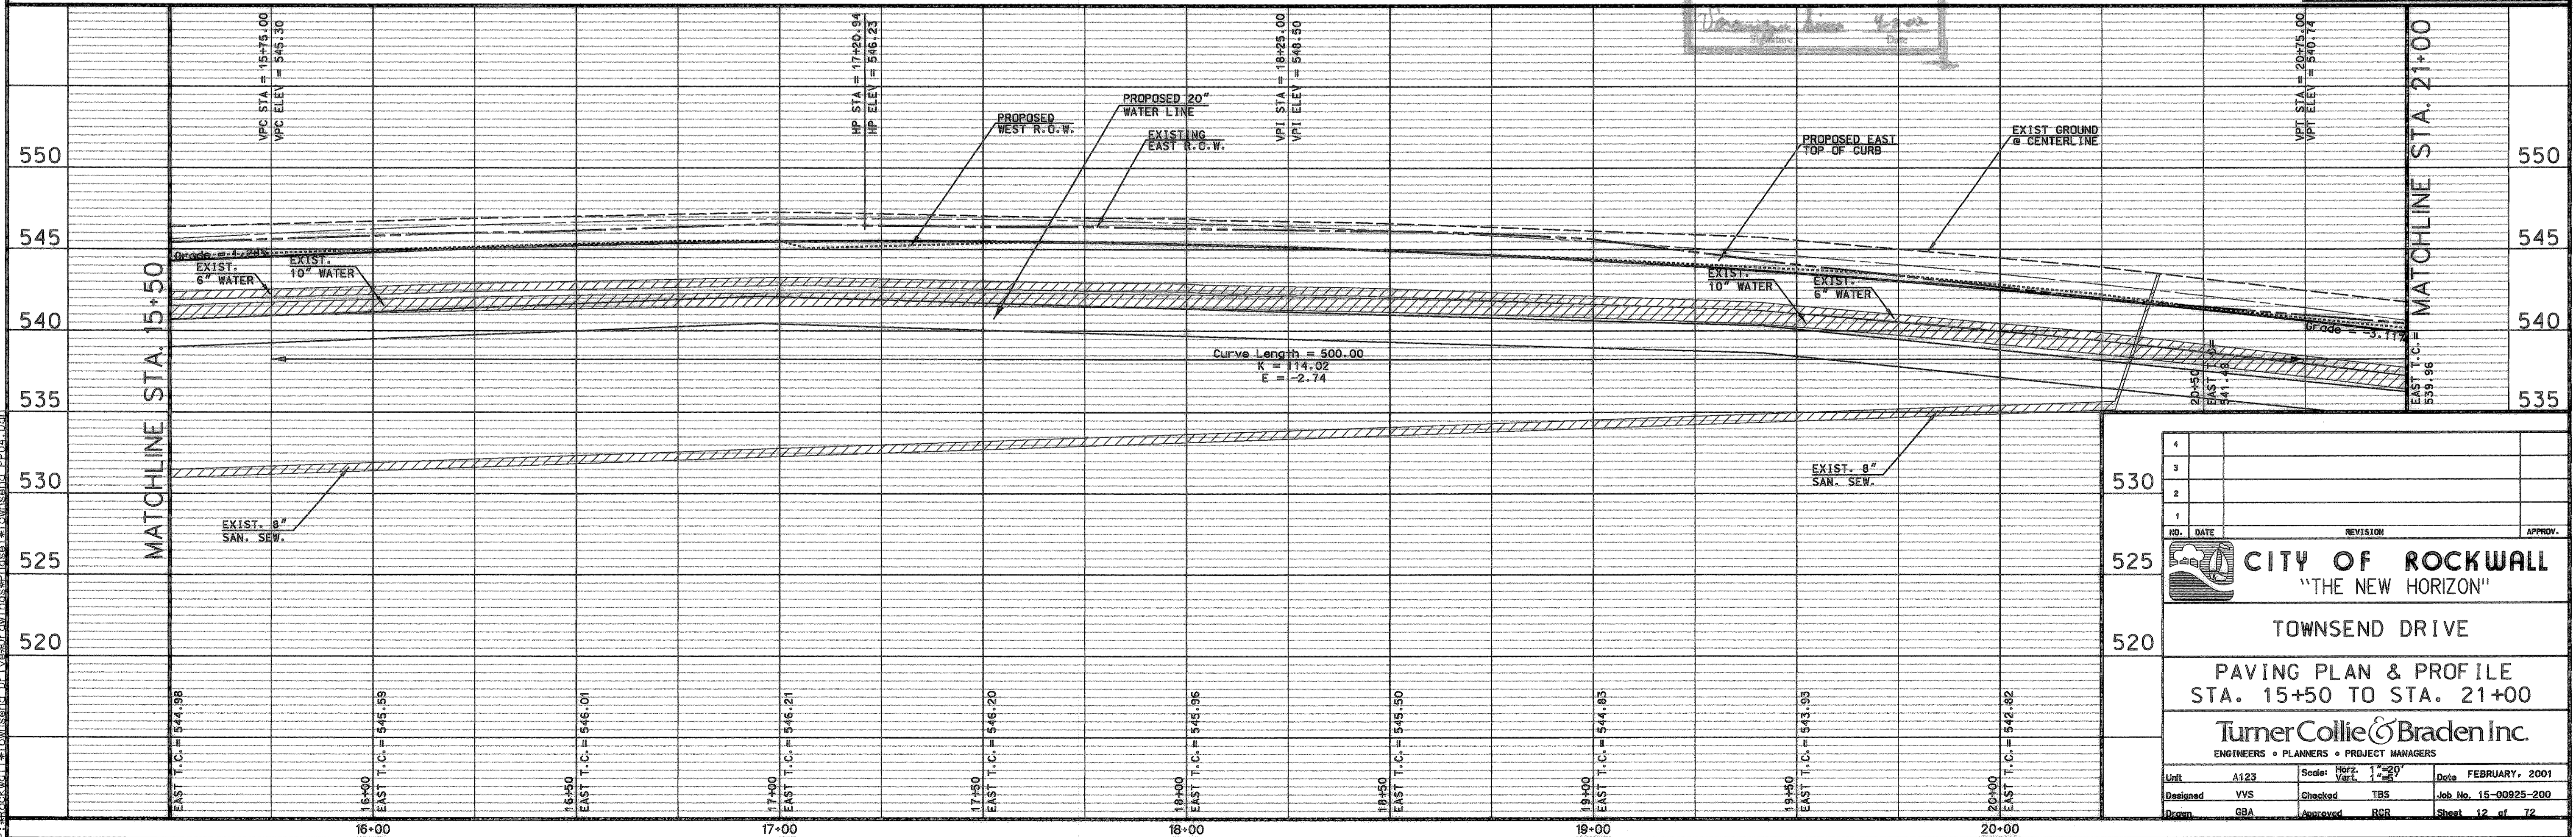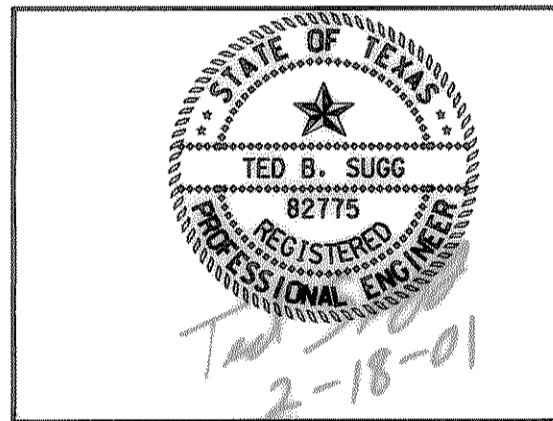

4			
3			
2			
1			
NO.	DATE	REVISION	APPROV.
<p>CITY OF ROCKWALL "THE NEW HORIZON"</p>			
<p>TOWNSEND DRIVE</p>			
<p>PAVING PLAN & PROFILE STA. 15+50 TO STA. 21+00</p>			
<p>Turner Collie & Braden Inc. ENGINEERS • PLANNERS • PROJECT MANAGERS</p>			
Unit	A123	Scale: Horiz. 1"=20' Vert. 1"=4'	Date FEBRUARY, 2001
Designed	VVS	Checked TBS	Job No. 15-00925-200
Drawn	GBA	Approved RCR	Sheet 12 of 12