


DETAIL A
N.T.S.




RECORD DRAWINGS

These record drawings have been prepared using information provided by the Construction Contractor and/or Owner. The seal and signature below only signifies that the plans have been revised in accordance with the information provided and does not guarantee that these plans accurately show every detail of the constructed project.

Caroline Sims 4-2-02
Signature Date

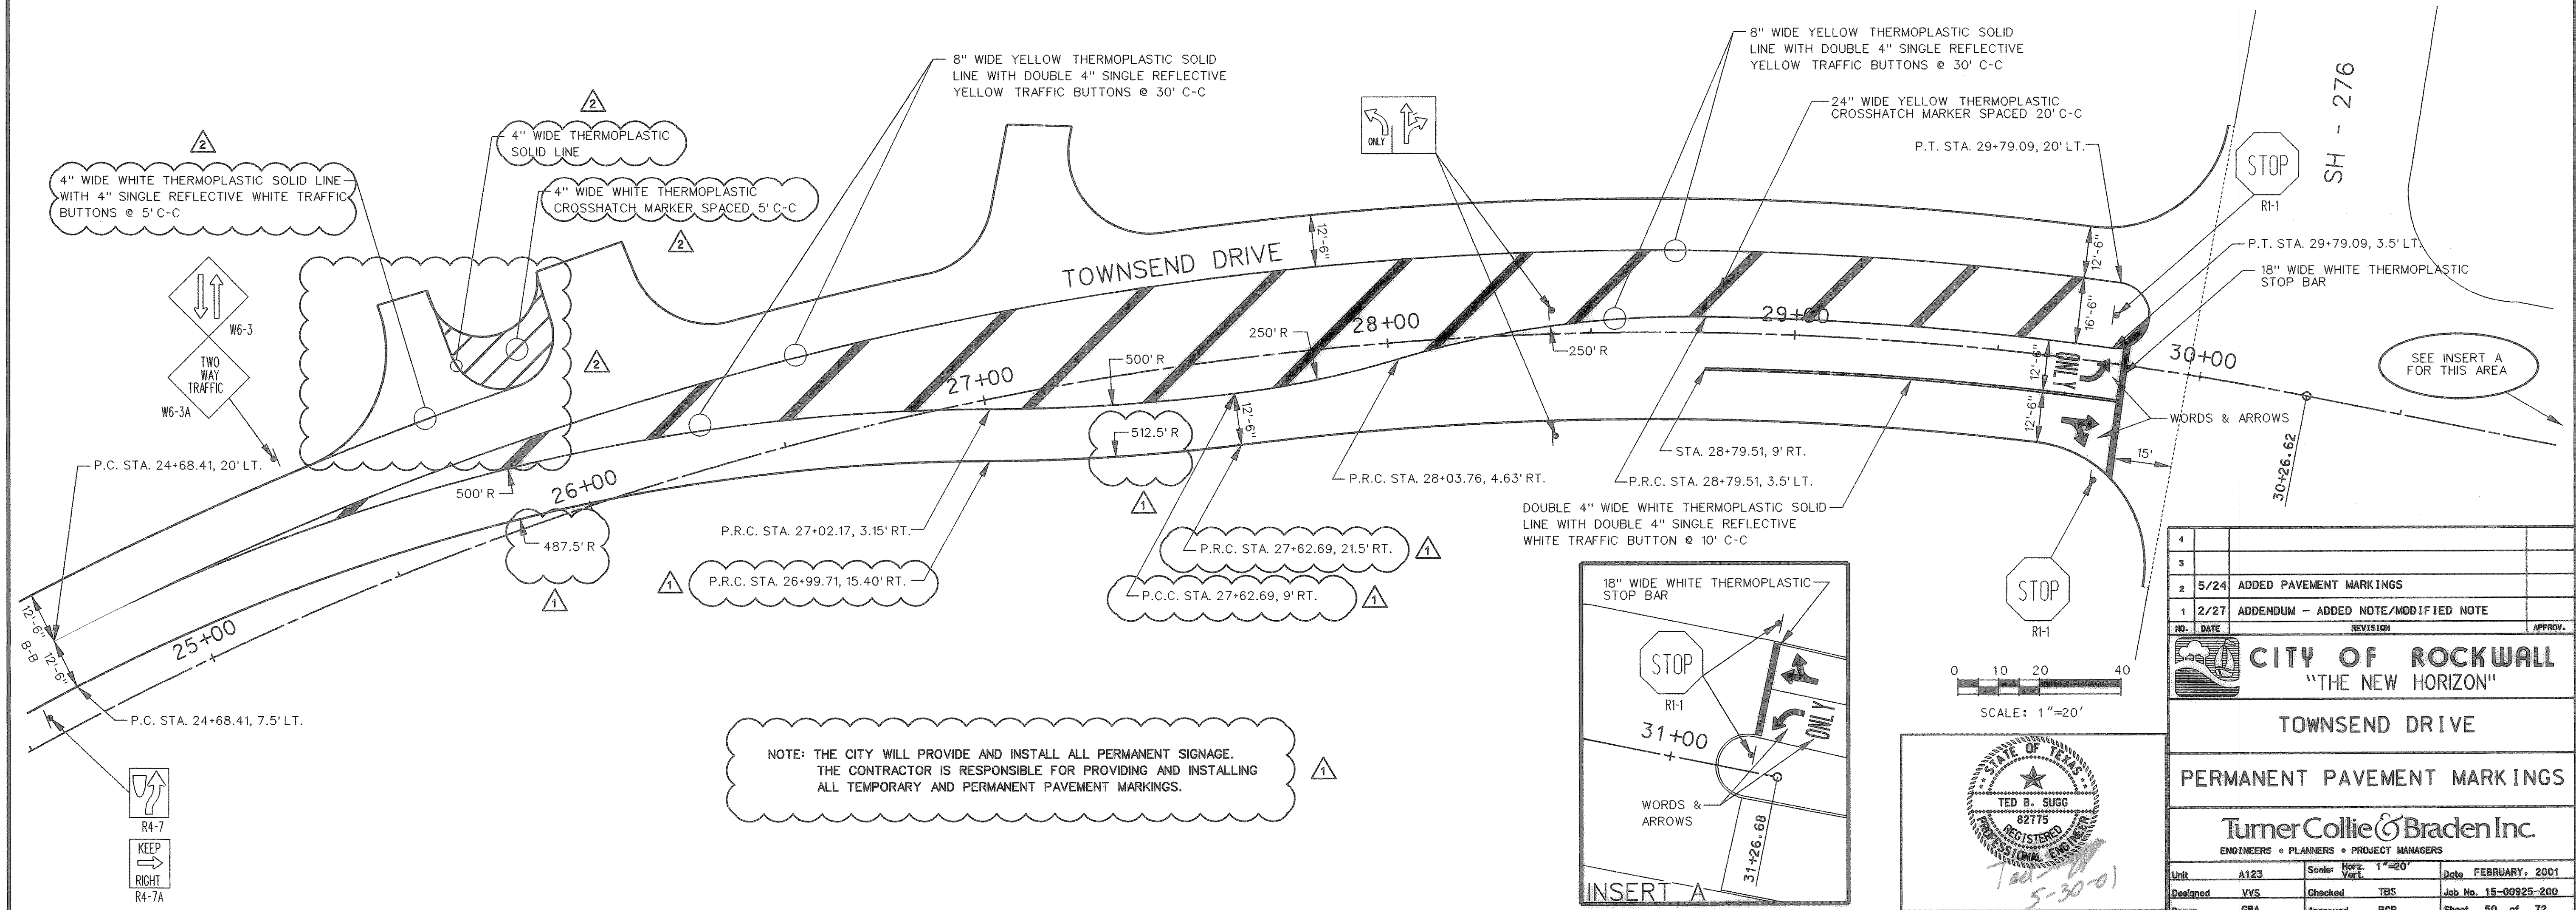

NOTE: THE CITY WILL PROVIDE AND INSTALL ALL PERMANENT SIGNAGE. THE CONTRACTOR IS RESPONSIBLE FOR PROVIDING AND INSTALLING ALL TEMPORARY AND PERMANENT PAVEMENT MARKINGS.

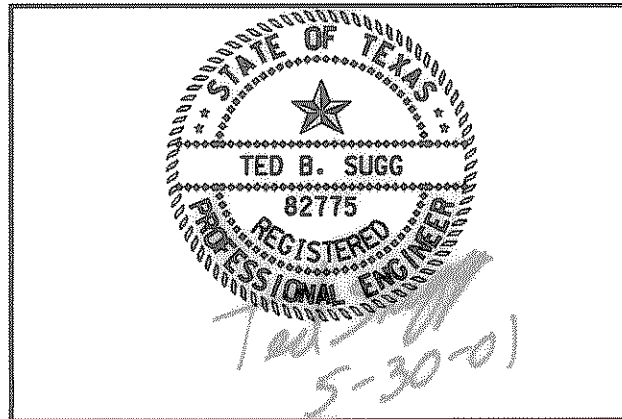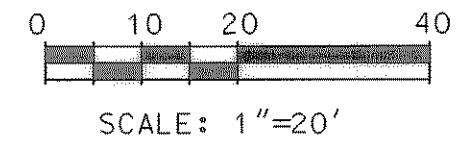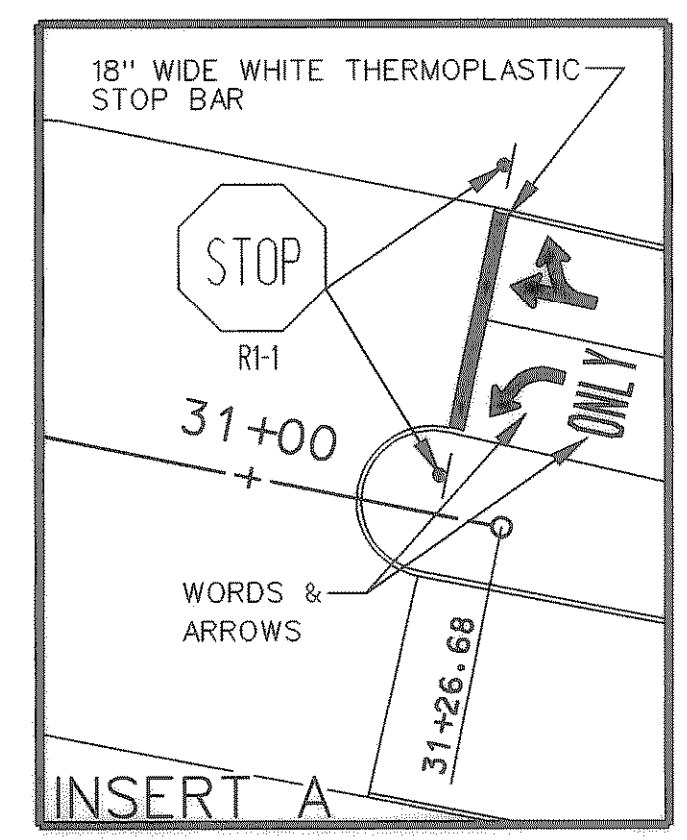

4			
3			
2	5/24	ADDED PAVEMENT MARKINGS	
1	2/27	ADDENDUM - ADDED NOTE/MODIFIED NOTE	
NO.	DATE	REVISION	APPROV.
CITY OF ROCKWALL "THE NEW HORIZON"			
TOWNSEND DRIVE			
PERMANENT PAVEMENT MARKINGS			
Turner Collie & Braden Inc. ENGINEERS • PLANNERS • PROJECT MANAGERS			
Unit	A123	Scale: Horz. 1"=20' Vert. 1"=20'	Date FEBRUARY, 2001
Designed	VVS	Checked TBS	Job No. 15-00925-200
Drawn	GBA	Approved RCR	Sheet 50 of 72