

RECORD DRAWINGS

These record drawings have been prepared using information provided by the Construction Contractor and/or Owner. The seal and signature below only signifies that the plans have been reviewed in accordance with the information provided and does not guarantee that these plans accurately show every detail of the constructed project.

Thomas Lima 4-20-02
Signature Date

- LEGEND**
- INLET PROTECTION BARRIER
 - FILTER FABRIC FENCE
 - REINFORCED FILTER FABRIC FENCE
 - STABILIZED CONSTRUCTION EXIT
 - P1 TO BE INSTALLED DURING SUGGESTED CONSTRUCTION PHASE 1
 - P2 TO BE INSTALLED DURING SUGGESTED CONSTRUCTION PHASE 2
 - P3 TO BE INSTALLED DURING SUGGESTED CONSTRUCTION PHASE 3
 - P4B TO BE INSTALLED DURING SUGGESTED CONSTRUCTION PHASE 4B

NOTE: STORMWATER POLLUTION PREVENTION CONTROL DEVICES ARE TO BE INSTALLED DURING THE PHASES NOTED AND REMAIN IN PLACE UNTIL COMPLETION OF THE PROJECT.

| NO. | DATE | REVISION | APPROV. |
|-----|------|----------|---------|
| 4 | | | |
| 3 | | | |
| 2 | | | |
| 1 | | | |

CITY OF ROCKWALL
"THE NEW HORIZON"

TOWNSEND DRIVE

STORM WATER POLLUTION PREVENTION PLAN LAYOUT


Turner Collie & Braden Inc.
ENGINEERS • PLANNERS • PROJECT MANAGERS

Scale: Horiz. 1"=40' Vert. 1"=10'

Unit: A123
Designed: VVS
Drawn: GBA

Checked: TBS
Approved: RCR

Date: FEBRUARY, 2001
Job No. 15-00925-200
Sheet 52 of 72

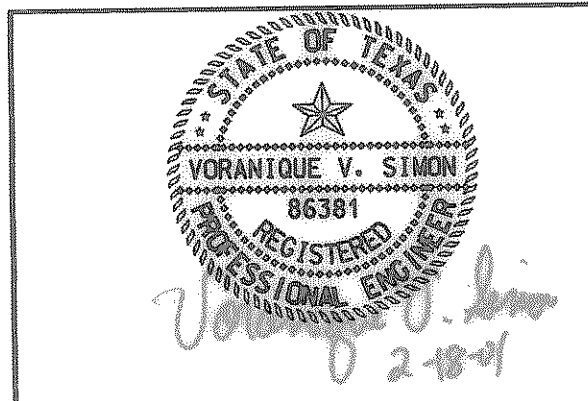

P:\2002\15-00925-200\Drawings\15-00925-200-52.dwg