
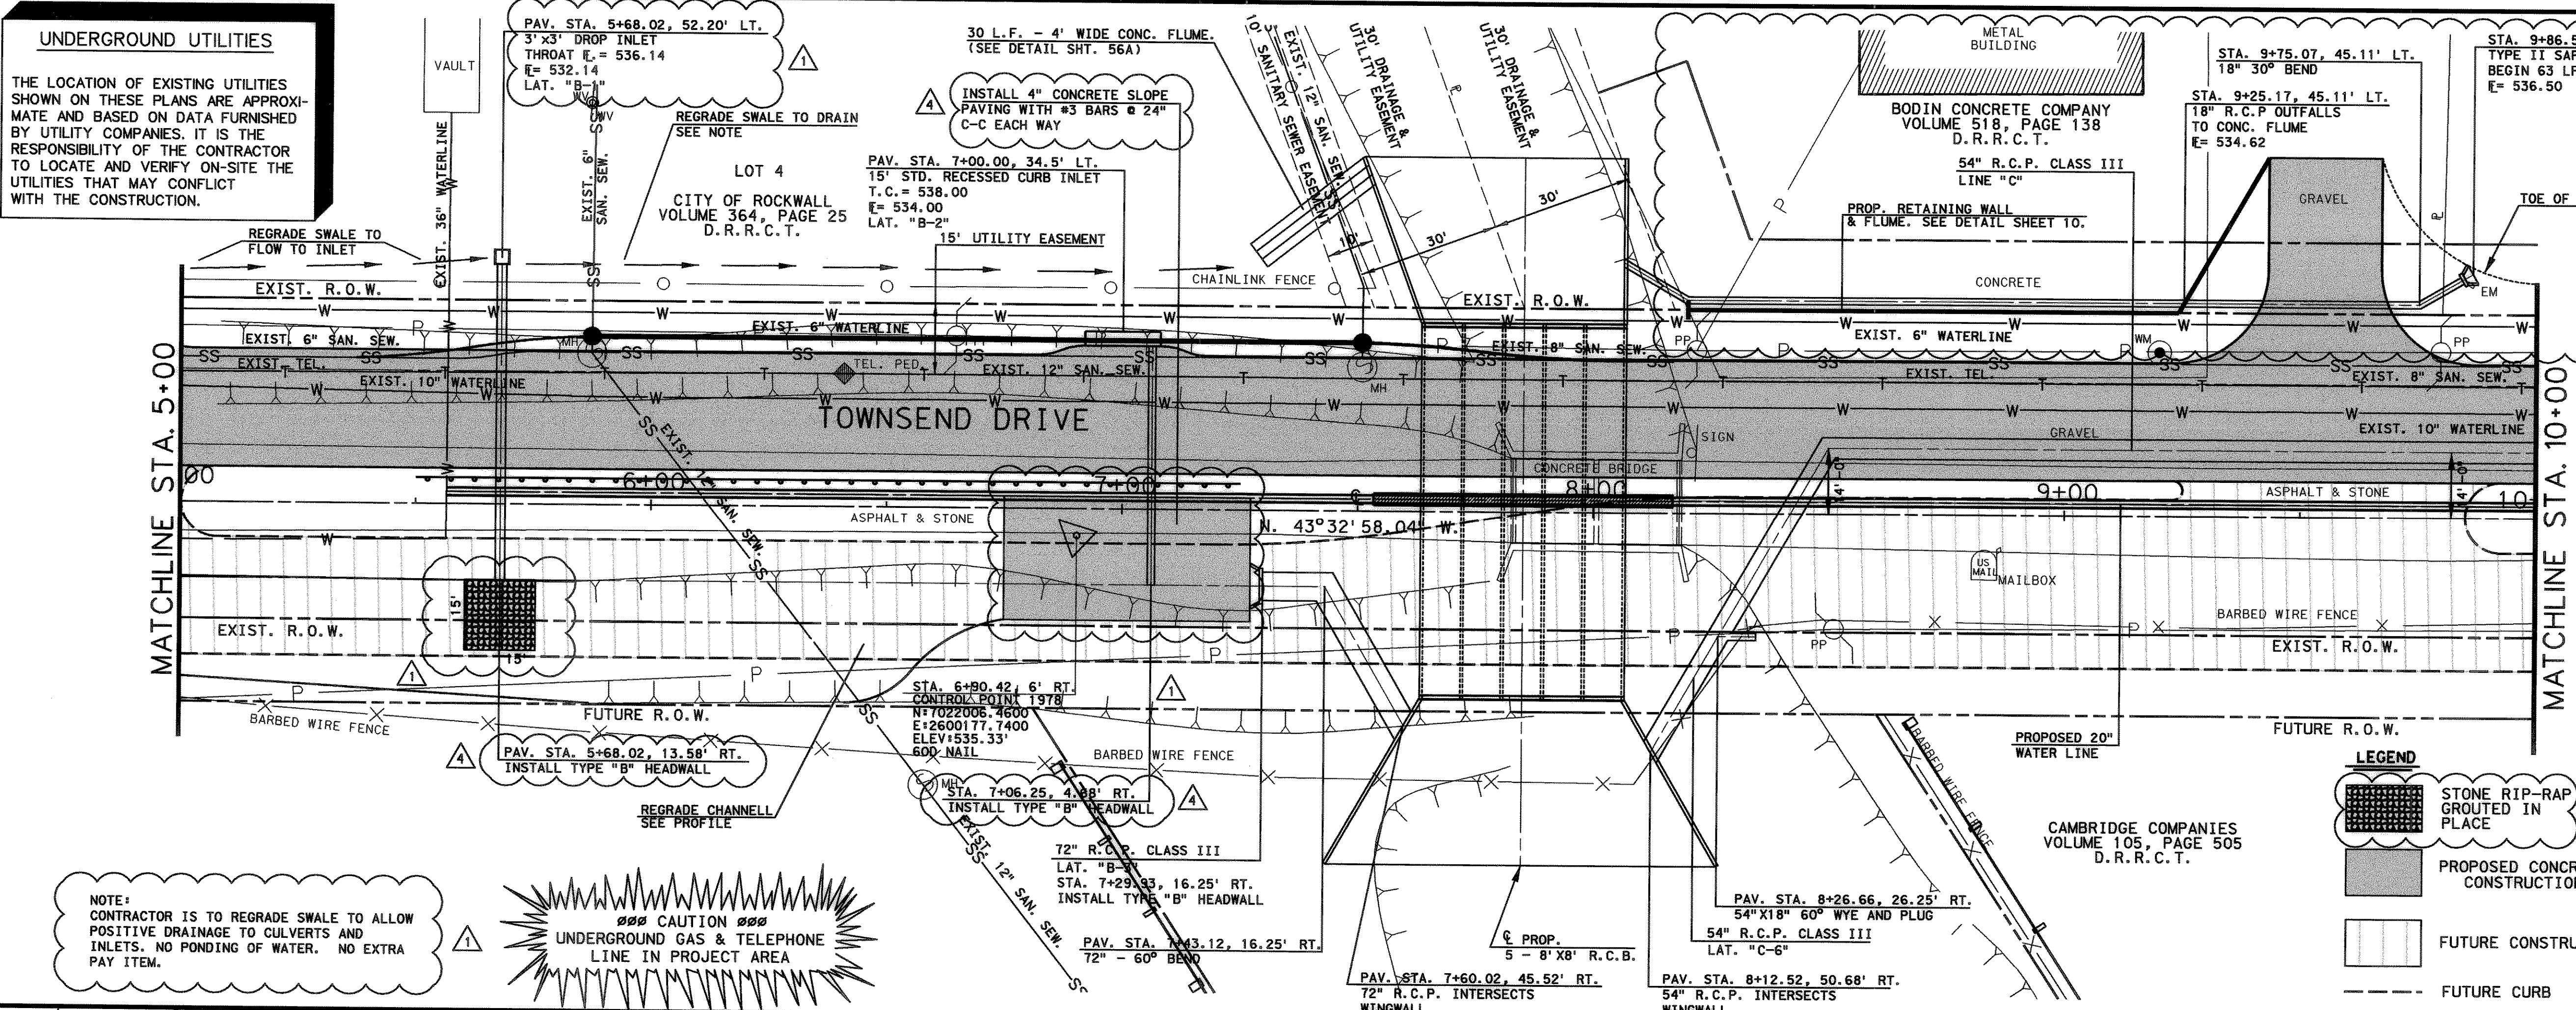


UNDERGROUND UTILITIES

THE LOCATION OF EXISTING UTILITIES SHOWN ON THESE PLANS ARE APPROXIMATE AND BASED ON DATA FURNISHED BY UTILITY COMPANIES. IT IS THE RESPONSIBILITY OF THE CONTRACTOR TO LOCATE AND VERIFY ON-SITE THE UTILITIES THAT MAY CONFLICT WITH THE CONSTRUCTION.


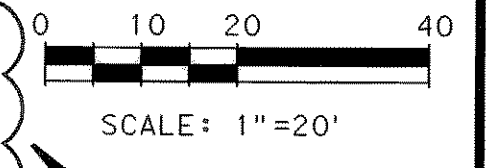


NOTE: CONTRACTOR IS TO REGRADE SWALE TO ALLOW POSITIVE DRAINAGE TO CULVERTS AND INLETS. NO PONDING OF WATER. NO EXTRA PAY ITEM.

CAUTION UNDERGROUND GAS & TELEPHONE LINE IN PROJECT AREA

LEGEND

- STONE RIP-RAP GROUDED IN PLACE
- PROPOSED CONCRETE CONSTRUCTION
- FUTURE CONSTRUCTION
- FUTURE CURB

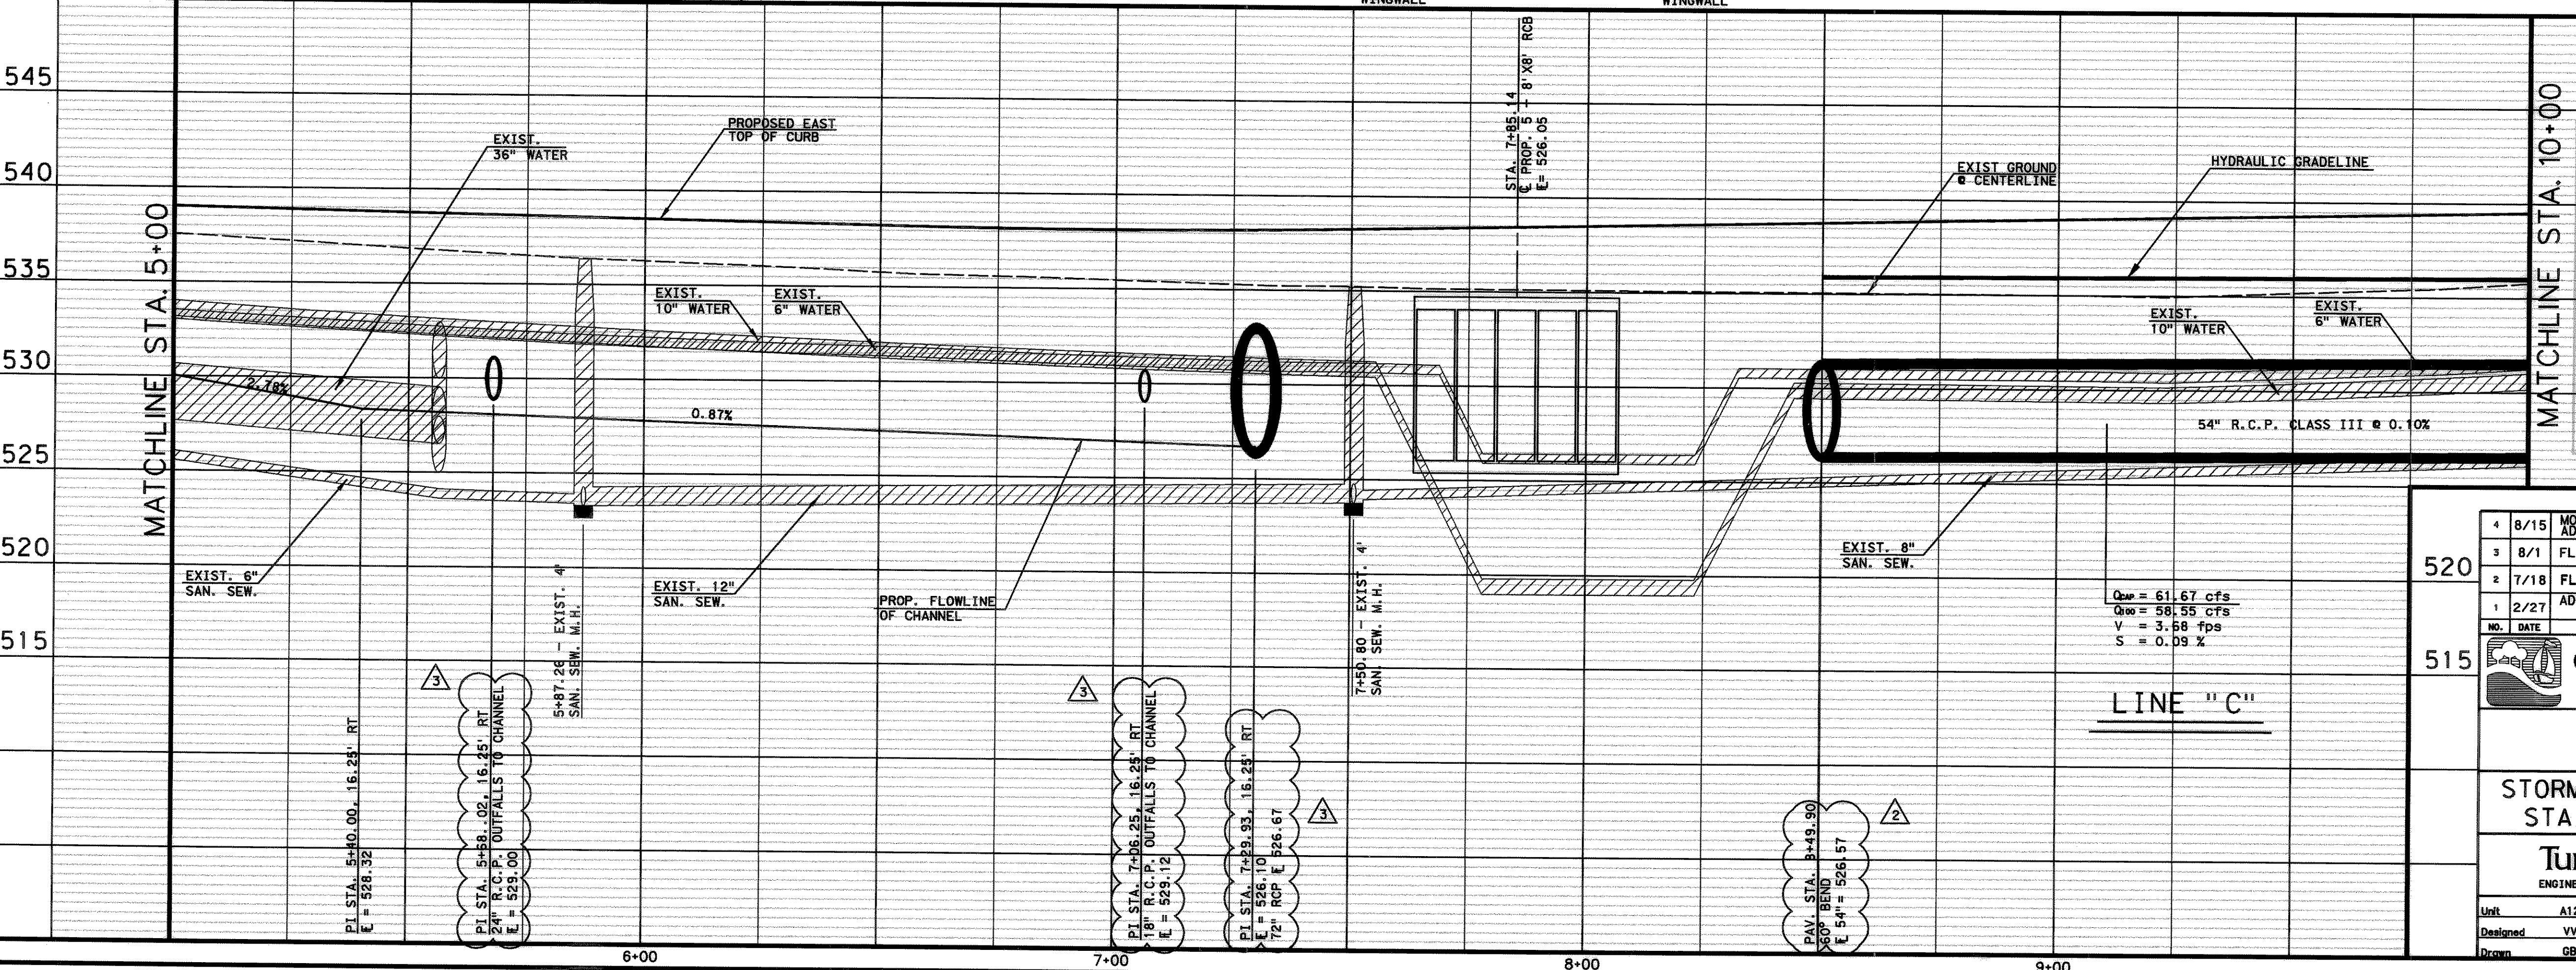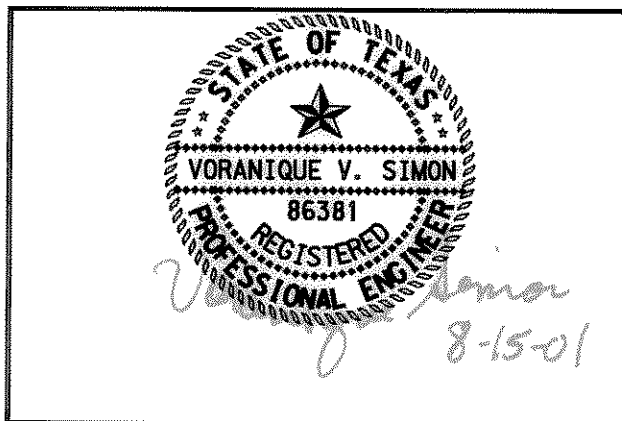

RECORD DRAWINGS

These record drawings have been prepared using information provided by the Construction Contractor and/or Owner. The seal and signature below only signifies that the plans have been reviewed in accordance with the information provided and does not guarantee that these plans accurately show every detail of the constructed project.

Voranique V. Simon 4-2002

NO.	DATE	REVISION	APPROV.
4	8/15	MODIFIED 18\"/>	

CITY OF ROCKWALL
"THE NEW HORIZON"

TOWNSEND DRIVE

STORM SEWER PLAN & PROFILE
STA. 5+00 TO STA. 10+00

TurnerCollie & Braden Inc.
ENGINEERS • PLANNERS • PROJECT MANAGERS

Unit	A123	Scale	Horz. 1\"/>
Designed	VVS	Checked	TBS
Drawn	GBA	Approved	RGR

Date: FEBRUARY, 2001
Job No. 15-00925-200
Sheet 21 of 72

P:\Rockwall\Townsend Drive\Drawings\Phase1\Townsend Draw.mxd