

UNDERGROUND UTILITIES




THE LOCATION OF EXISTING UTILITIES SHOWN ON THESE PLANS ARE APPROXIMATE AND BASED ON DATA FURNISHED BY UTILITY COMPANIES. IT IS THE RESPONSIBILITY OF THE CONTRACTOR TO LOCATE AND VERIFY ON-SITE THE UTILITIES THAT MAY CONFLICT WITH THE CONSTRUCTION.

PAV. STA. 10+51.29, 48.41' LT.
2' X 2' DROP INLET
THROAT E= 538.30
E= 534.30
LAT. "C-5"


LOT 1
T.E. PITTS, INC
VOLUME 195, PAGE 704
D.R.R.C.T.

PAV. STA. 12+50.00, 34.5' LT.
10' STD. RECESSED CURB INLET
T.C. = 541.14
E= 537.14
LAT. "C-3"

BILL & JERRY WAY FAMILY TRUST
VOLUME 7192, PAGE 323
D.R.R.C.T.

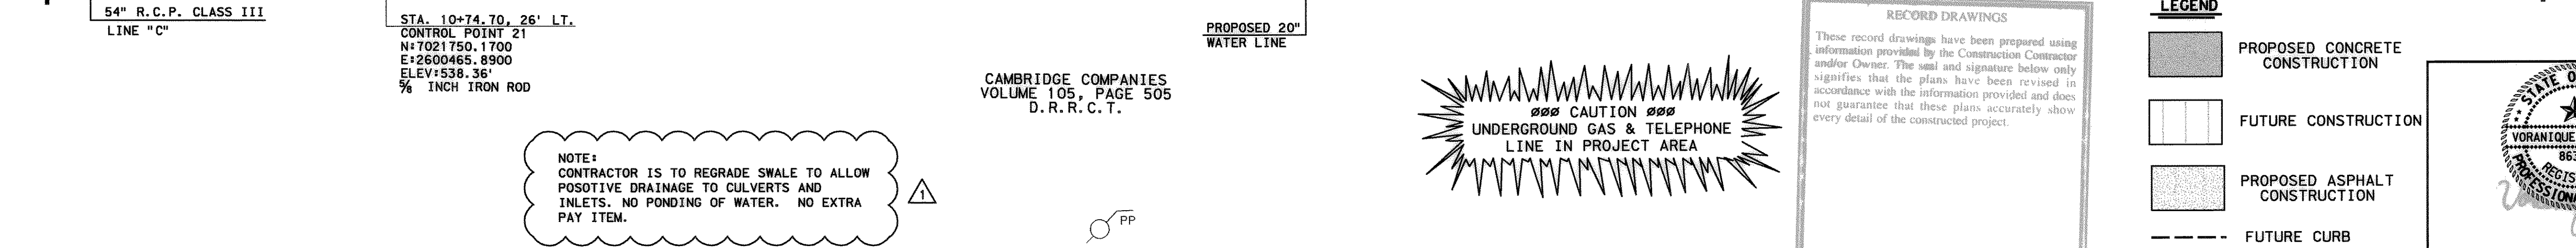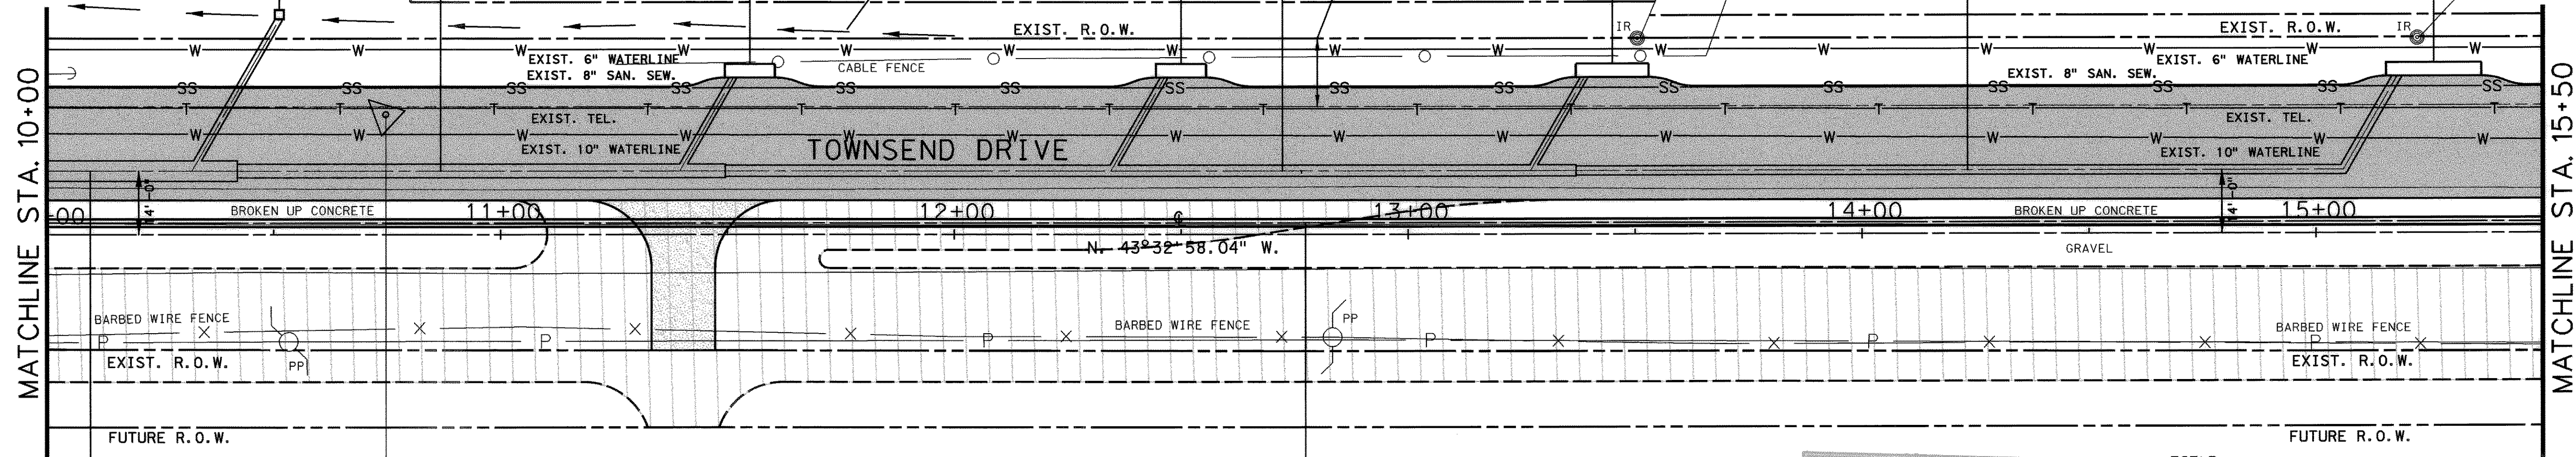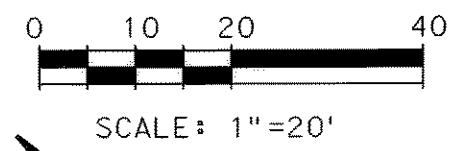


NOTE:
CONTRACTOR IS TO REGRADE SWALE TO ALLOW POSITIVE DRAINAGE TO CULVERTS AND INLETS. NO PONDING OF WATER. NO EXTRA PAY ITEM.

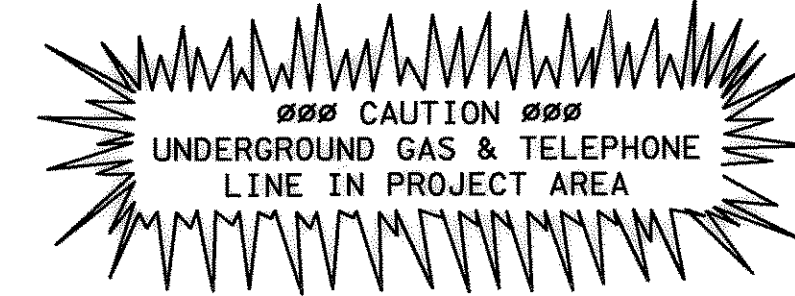

RECORD DRAWINGS
These record drawings have been prepared using information provided by the Construction Contractor and/or Owner. The seal and signature below only signifies that the plans have been revised in accordance with the information provided and does not guarantee that these plans accurately show every detail of the constructed project.

Voraniq V. Simon
4-2-02
Signature Date

- LEGEND**
- PROPOSED CONCRETE CONSTRUCTION
 - FUTURE CONSTRUCTION
 - PROPOSED ASPHALT CONSTRUCTION
 - FUTURE CURB

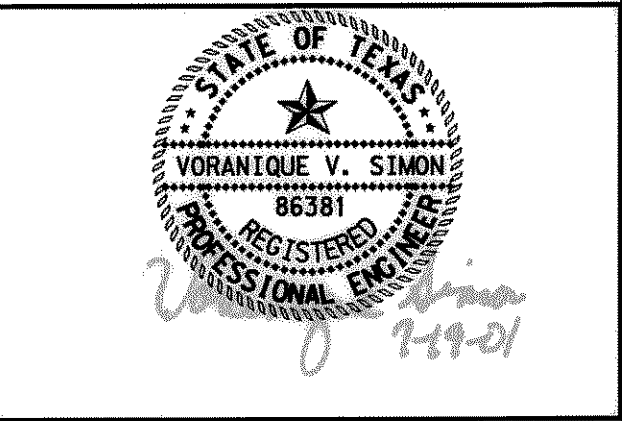

P:\Rockwell\Townsend Drive\Drawings\Phase3\Townsend_Drain\PP03.Dwg

4			
3			
2	7/18	FLOWLINE ADJUSTMENTS	
1	2/27	ADDENDUM - MODIFIED NOTE	
NO.	DATE	REVISION	APPROV.

CITY OF ROCKWALL
"THE NEW HORIZON"

TOWNSEND DRIVE

STORM SEWER PLAN & PROFILE
STA. 10+00 TO STA. 15+50

TurnerCollie & Braden Inc.
ENGINEERS • PLANNERS • PROJECT MANAGERS

Unit	A123	Scale	Horz: 1"=20'	Vert: 1"=5'	Date	FEBRUARY, 2001
Designed	VVS	Checked	TBS	Job No.	15-00925-200	
Drawn	GBA	Approved	RCR	Sheet	22 of 72	