
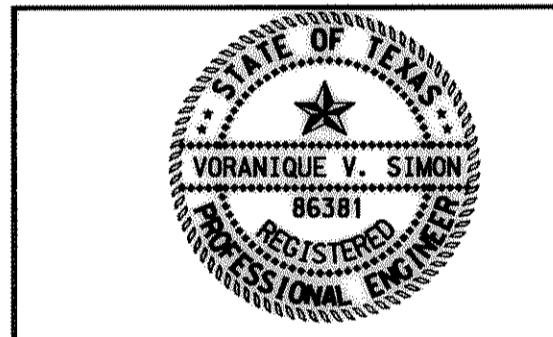
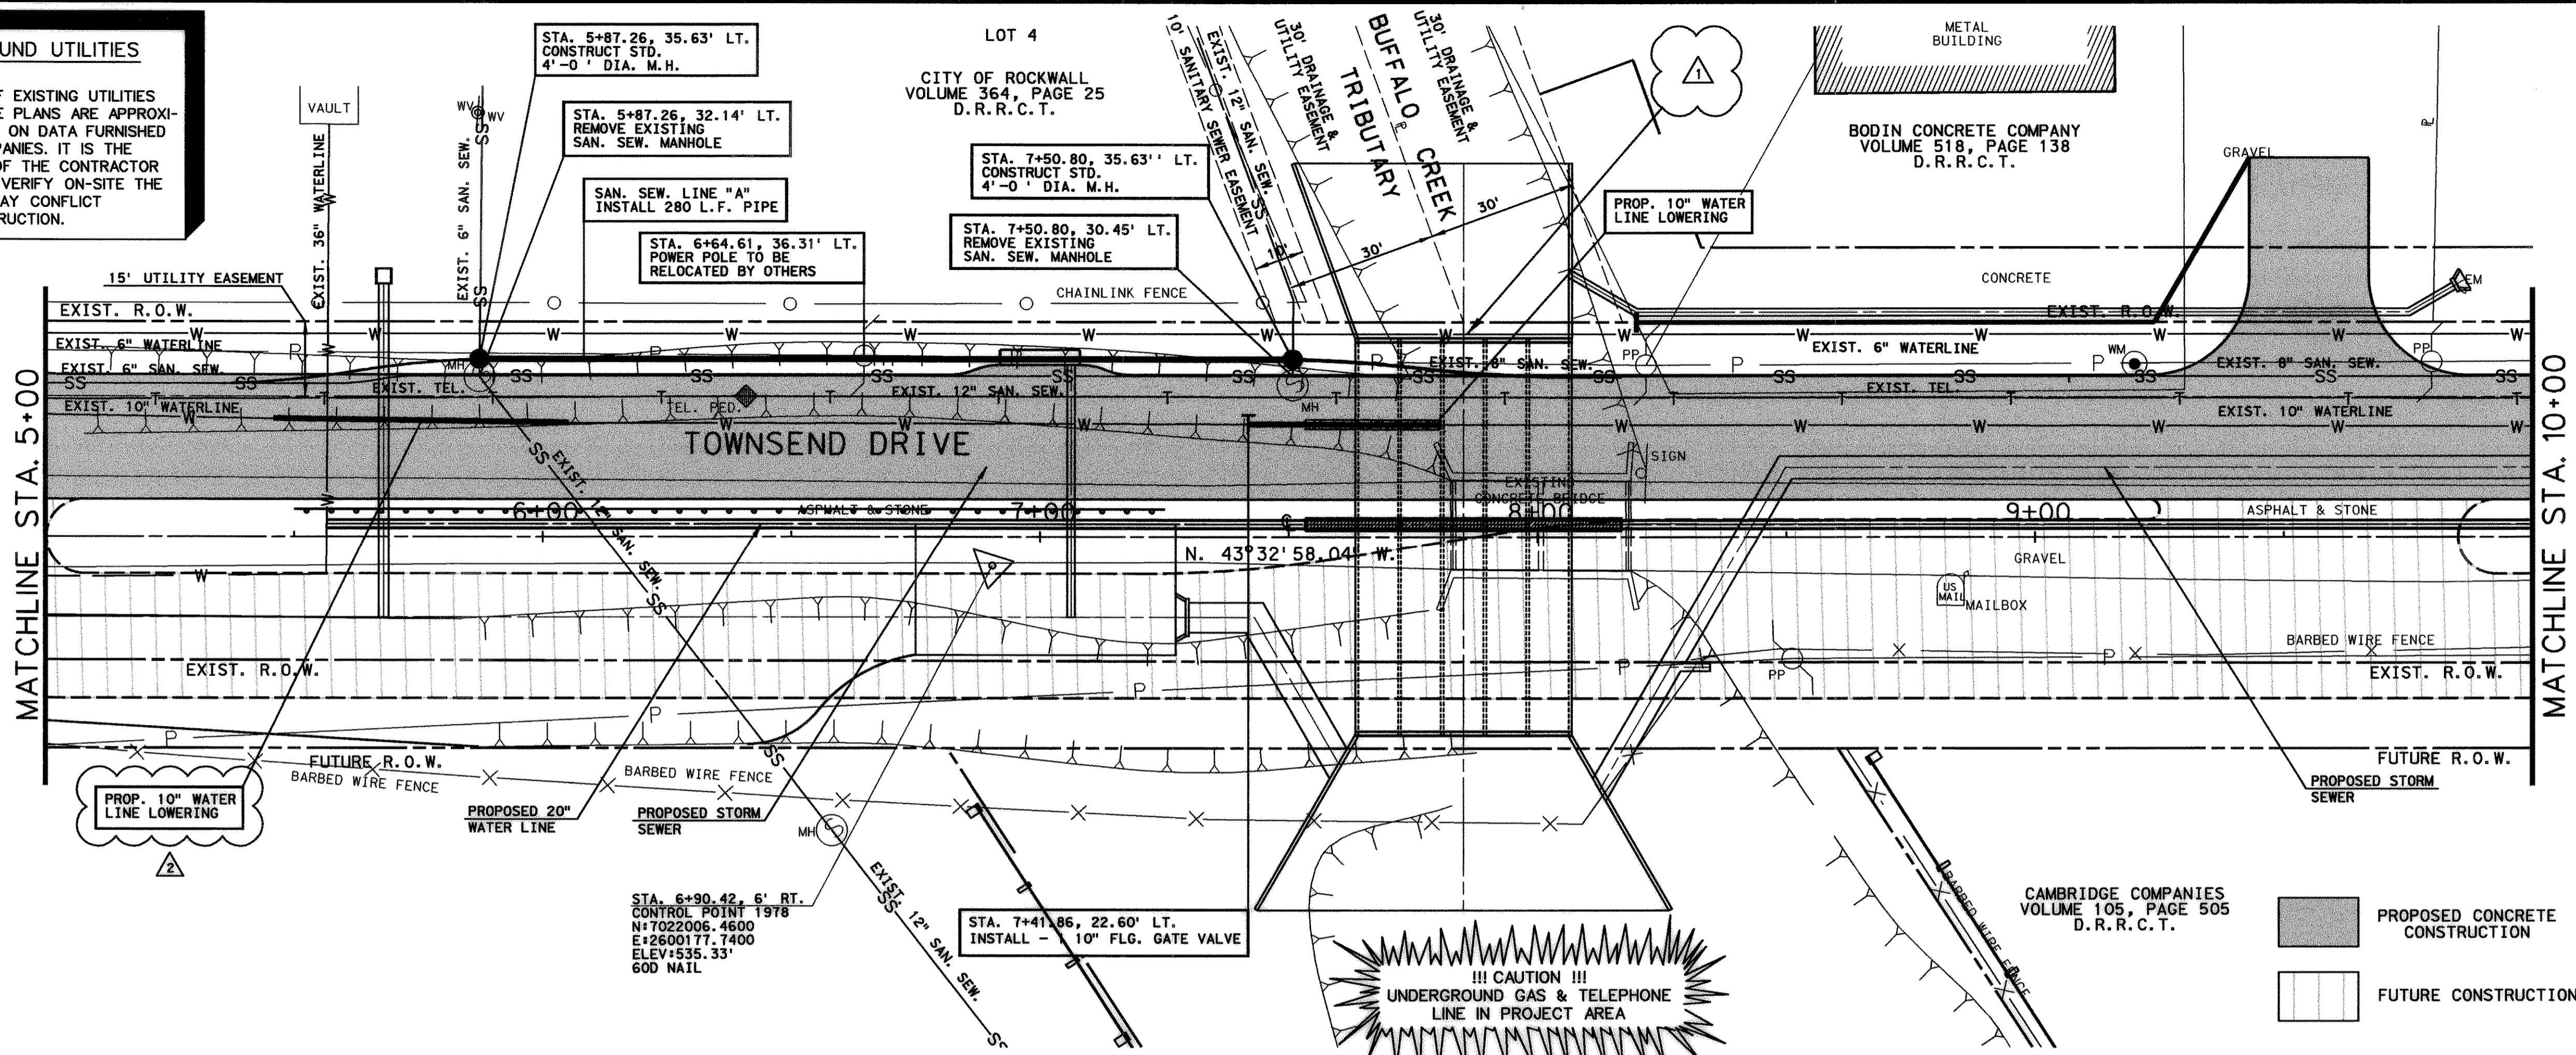
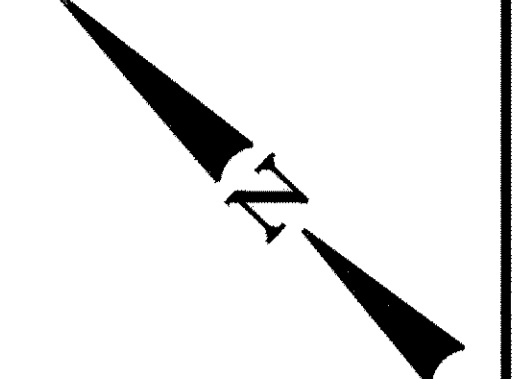


UNDERGROUND UTILITIES


THE LOCATION OF EXISTING UTILITIES SHOWN ON THESE PLANS ARE APPROXIMATE AND BASED ON DATA FURNISHED BY UTILITY COMPANIES. IT IS THE RESPONSIBILITY OF THE CONTRACTOR TO LOCATE AND VERIFY ON-SITE THE UTILITIES THAT MAY CONFLICT WITH THE CONSTRUCTION.

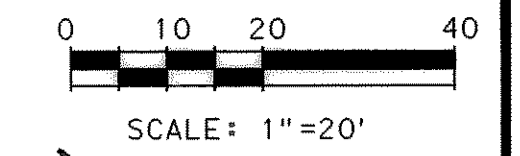

PROPOSED CONCRETE CONSTRUCTION
FUTURE CONSTRUCTION

RECORD DRAWING
 These record drawings have been prepared using information provided by the Construction Contractors and/or Owners. The seal and signature below only signifies that the plans have been prepared in accordance with the information provided and does not guarantee that these plans accurately show every detail of the constructed project.

Voranique V. Simon 4-2-02
 Signature Date

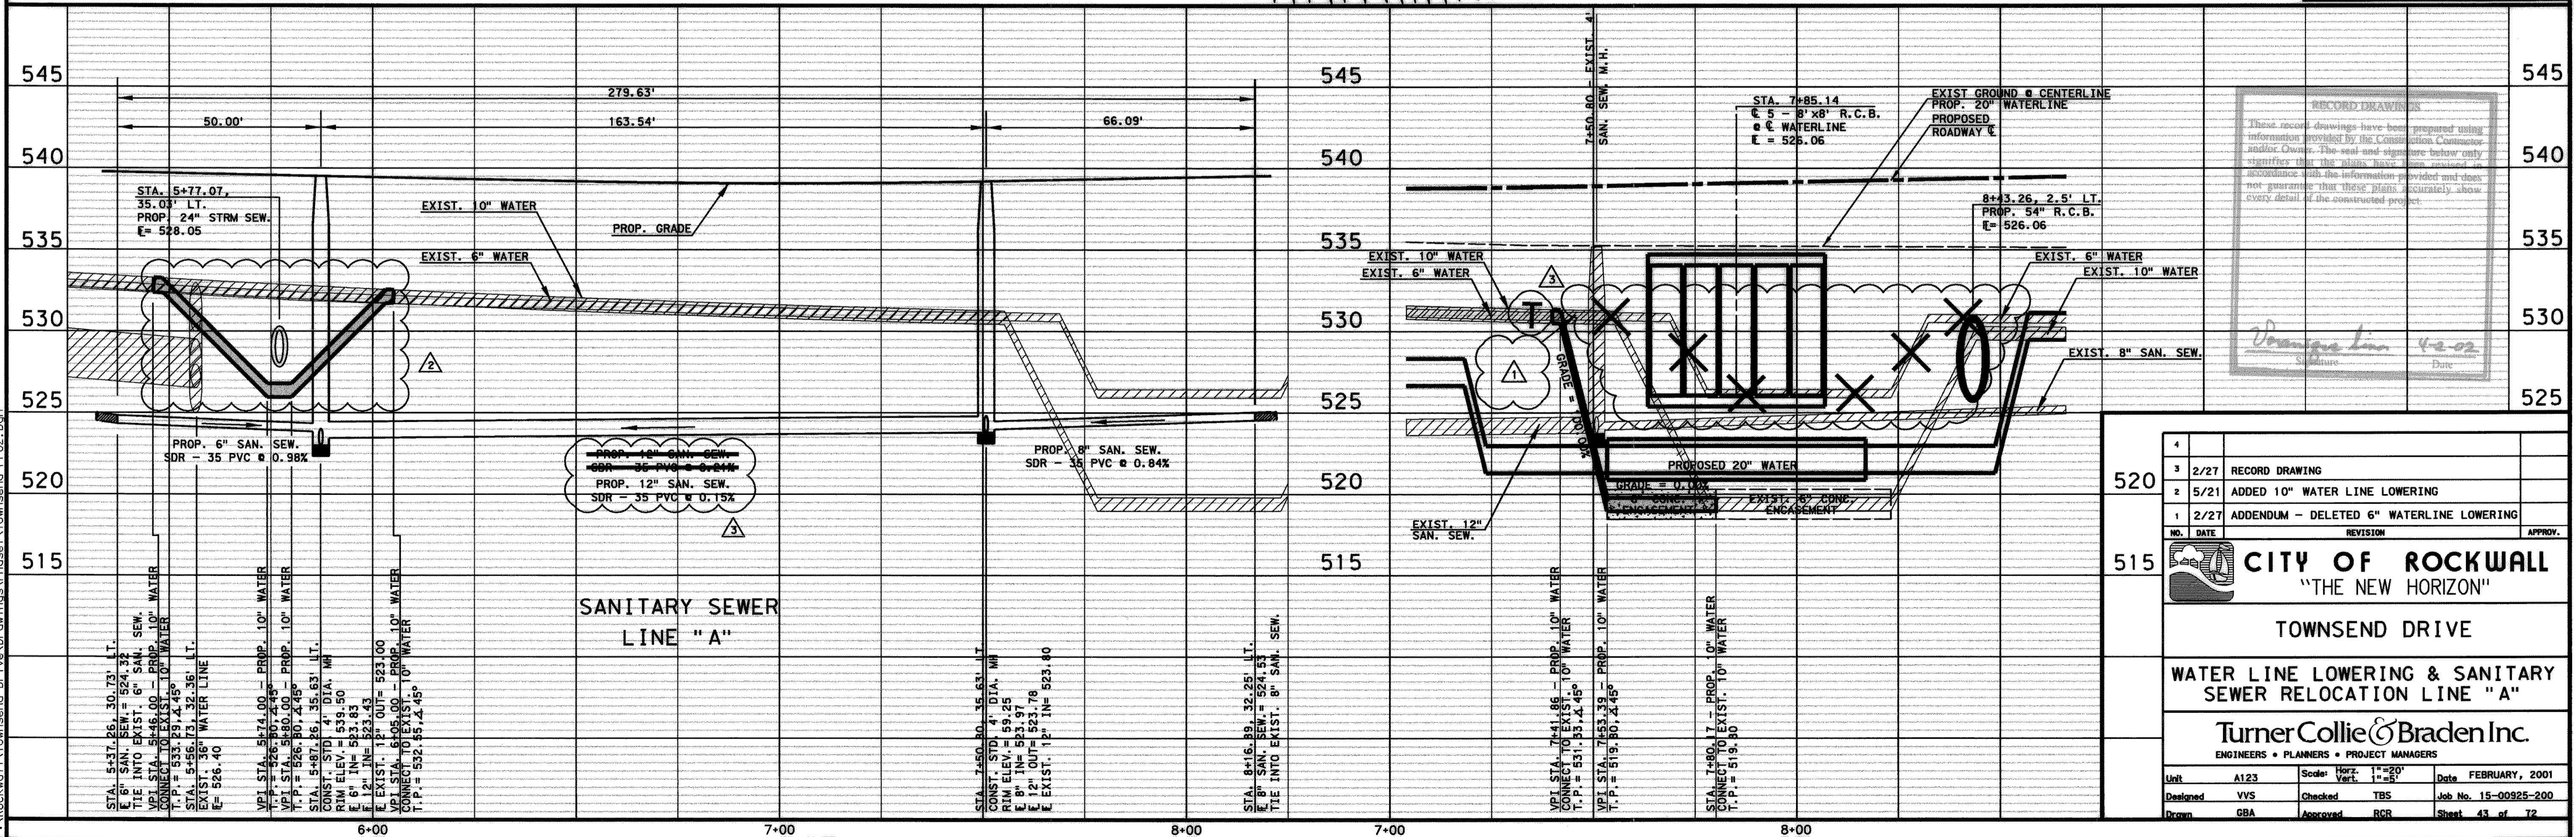

NO.	DATE	REVISION	APPROV.
4			
3	2/27	RECORD DRAWING	
2	5/21	ADDED 10" WATER LINE LOWERING	
1	2/27	ADDENDUM - DELETED 6" WATERLINE LOWERING	

CITY OF ROCKWALL
 "THE NEW HORIZON"
TOWNSEND DRIVE
WATER LINE LOWERING & SANITARY SEWER RELOCATION LINE "A"
Turner Collie & Braden Inc.
 ENGINEERS • PLANNERS • PROJECT MANAGERS

Unit	A123	Scale: Horiz. 1"=20' Vert. 1"=5'	Date	FEBRUARY, 2001
Designed	VVS	Checked	TBS	Job No. 15-00925-200
Drawn	GBA	Approved	RGR	Sheet 43 of 72

P:\Rockwall\Townsend Dr. Ives\Drawings\Phase1\Townsend_PP02.Dwg