

TIME: 12:47 FILE: DAMAP2-phlt-04124.dwg

JERRY HEFLIN  
VOLUME 1725, PAGE 167  
D.R.R.C.T.

NAN A. SMART,  
W.I. LOFLAND  
AND JULIANNA BOND  
VOLUME 70, PAGE 183  
D.R.R.C.T.

570

LOT 1A-R, BLOCK A  
LOFLAND INDUSTRIAL  
PARK ADDITION  
CABINET E, PAGE 131  
P.R.R.C.T.

LOT 1, BLOCK B  
LOFLAND INDUSTRIAL  
PARK ADDITION  
CABINET B, PAGE 307  
P.R.R.C.T.

LOT 1, BLOCK A  
ROCKWALL COUNTY LAW  
ENFORCEMENT CENTER  
CABINET C, PAGE 1  
P.R.R.C.T.

AIMEE ADDITION  
CABINET D, PAGE 101  
P.R.R.C.T.

MATCHLINE SHEET D001

TOWNSEND BLVD

JUSTIN RD

C-10  
0.70

C-11  
0.31

C-4  
0.32

C-9  
0.73

C-2  
0.29

C-3  
0.40

C-1  
0.32

B-13  
2.27

B-7  
0.12

B-5  
0.38

B-4  
0.45

B-6  
0.10


570

580

# RECORD DRAWING 01/16/09


LEGEND:

	DRAINAGE AREA DESIGNATION FLOW IN CFS (100 YR)
	DRAINAGE AREA BOUNDARY
	MAJOR DRAINAGE AREA DIVIDE
	DRAINAGE AREA SUB DIVIDE
	DIRECTION OF FLOW

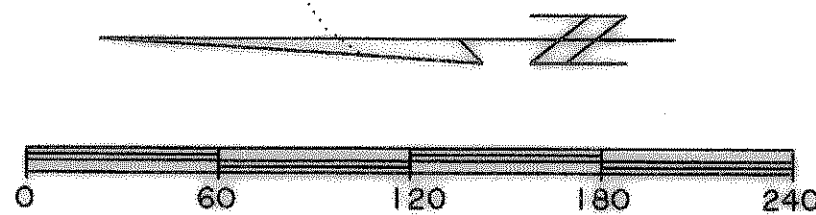

NOTES:  
1. ALL SITES SHALL BE REQUIRED TO DETAINE TO EXISTING CONDITIONS (C=0.35) UPON DEVELOPMENT.

PREPARED BY:  
**WIER & ASSOCIATES, INC.**  
ENGINEERS SURVEYORS LAND PLANNERS  
701 HIGHLANDER BLVD., SUITE 300 ARLINGTON, TEXAS 76015 METRO (817)467-7700  
6849 ELM STREET IRVING, TEXAS 75034 METRO (214)387-8000  
www.wierassociates.com

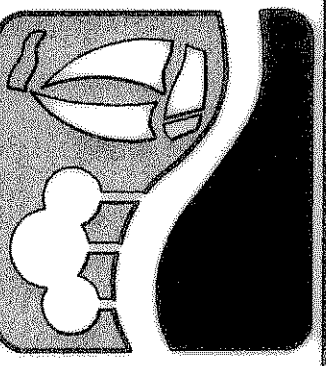

CITY OF ROCKWALL  
TOWNSEND BLVD  
(JUSTIN RD TO BOYDSTUN ST)  
& BOYDSTUN ST  
(TOWNSEND BLVD TO CLARK ST)

DRAINAGE AREA  
MAP

STATE OF TEXAS  
RONALD RAMIREZ  
81821  
REGISTERED  
PROFESSIONAL ENGINEER  
WIER & ASSOCIATES, INC.  
LAST SHEET EDIT  
DATE 01-19-2009  
WA# 04124  
SHEET NO.  
D002