



**DRIVE 19 @ BOYDSTUN ST STA 3+06.71**

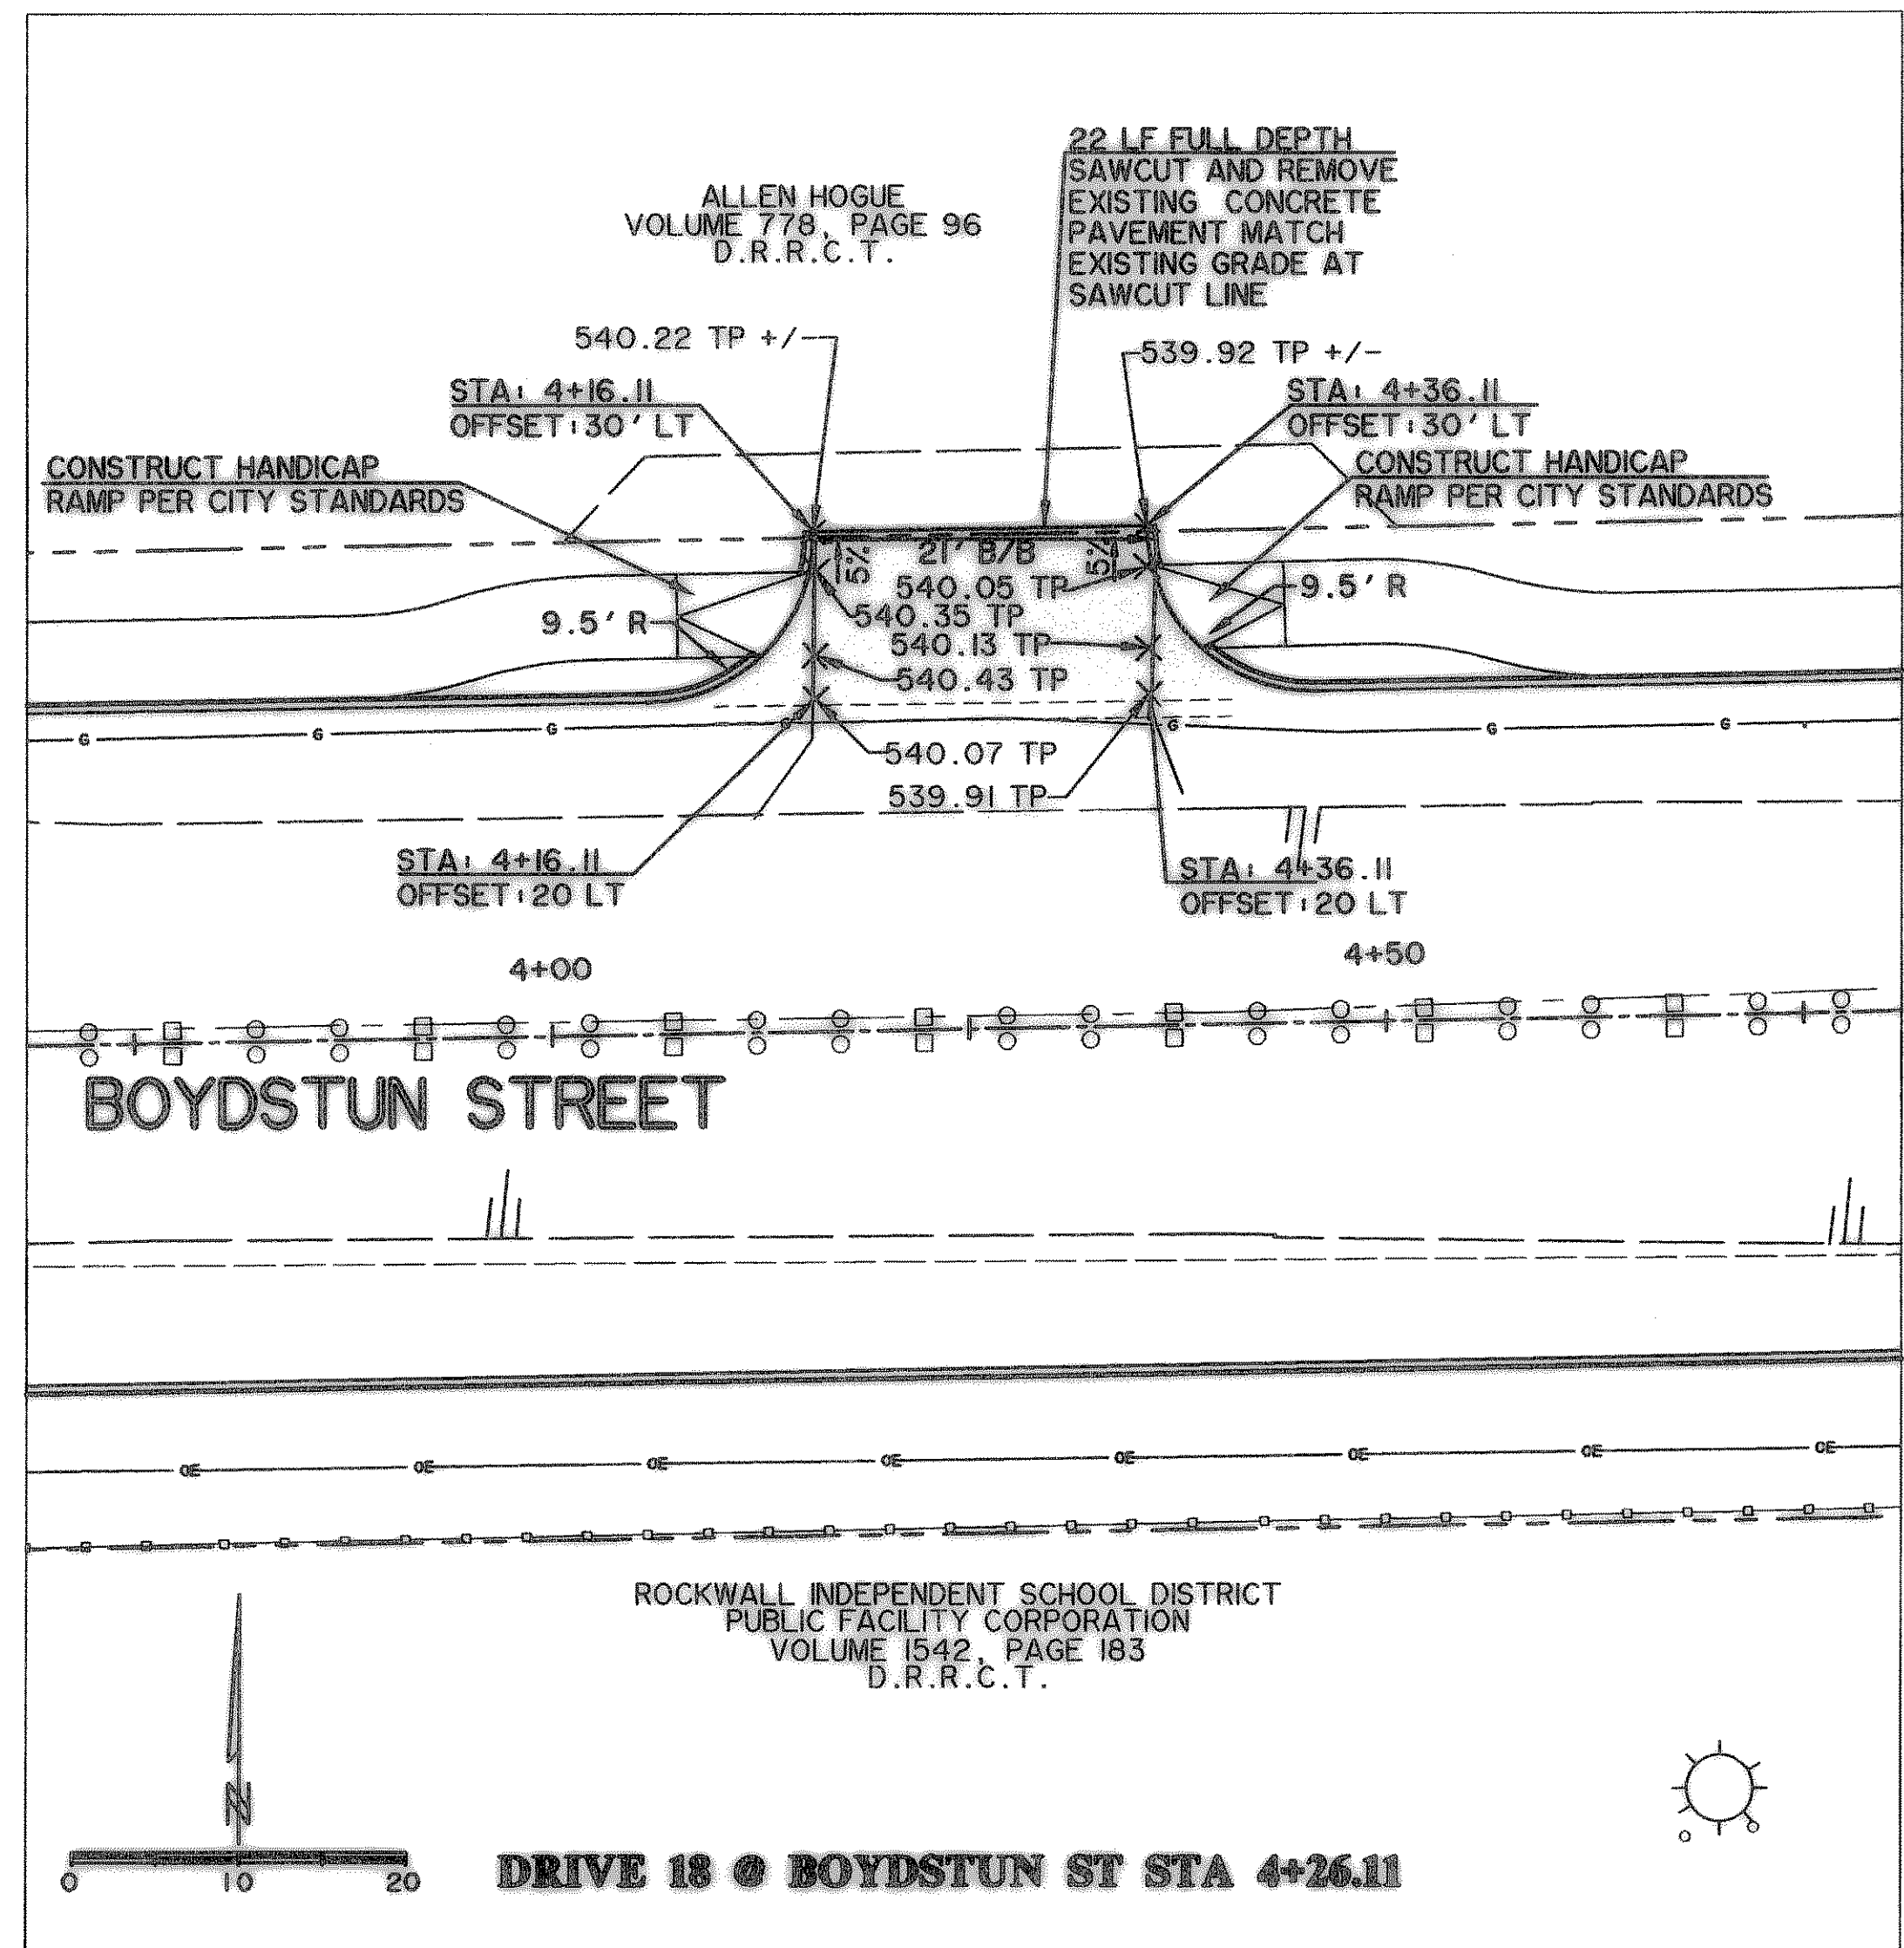

**DRIVE 18 @ BOYDSTUN ST STA 4+26.11**

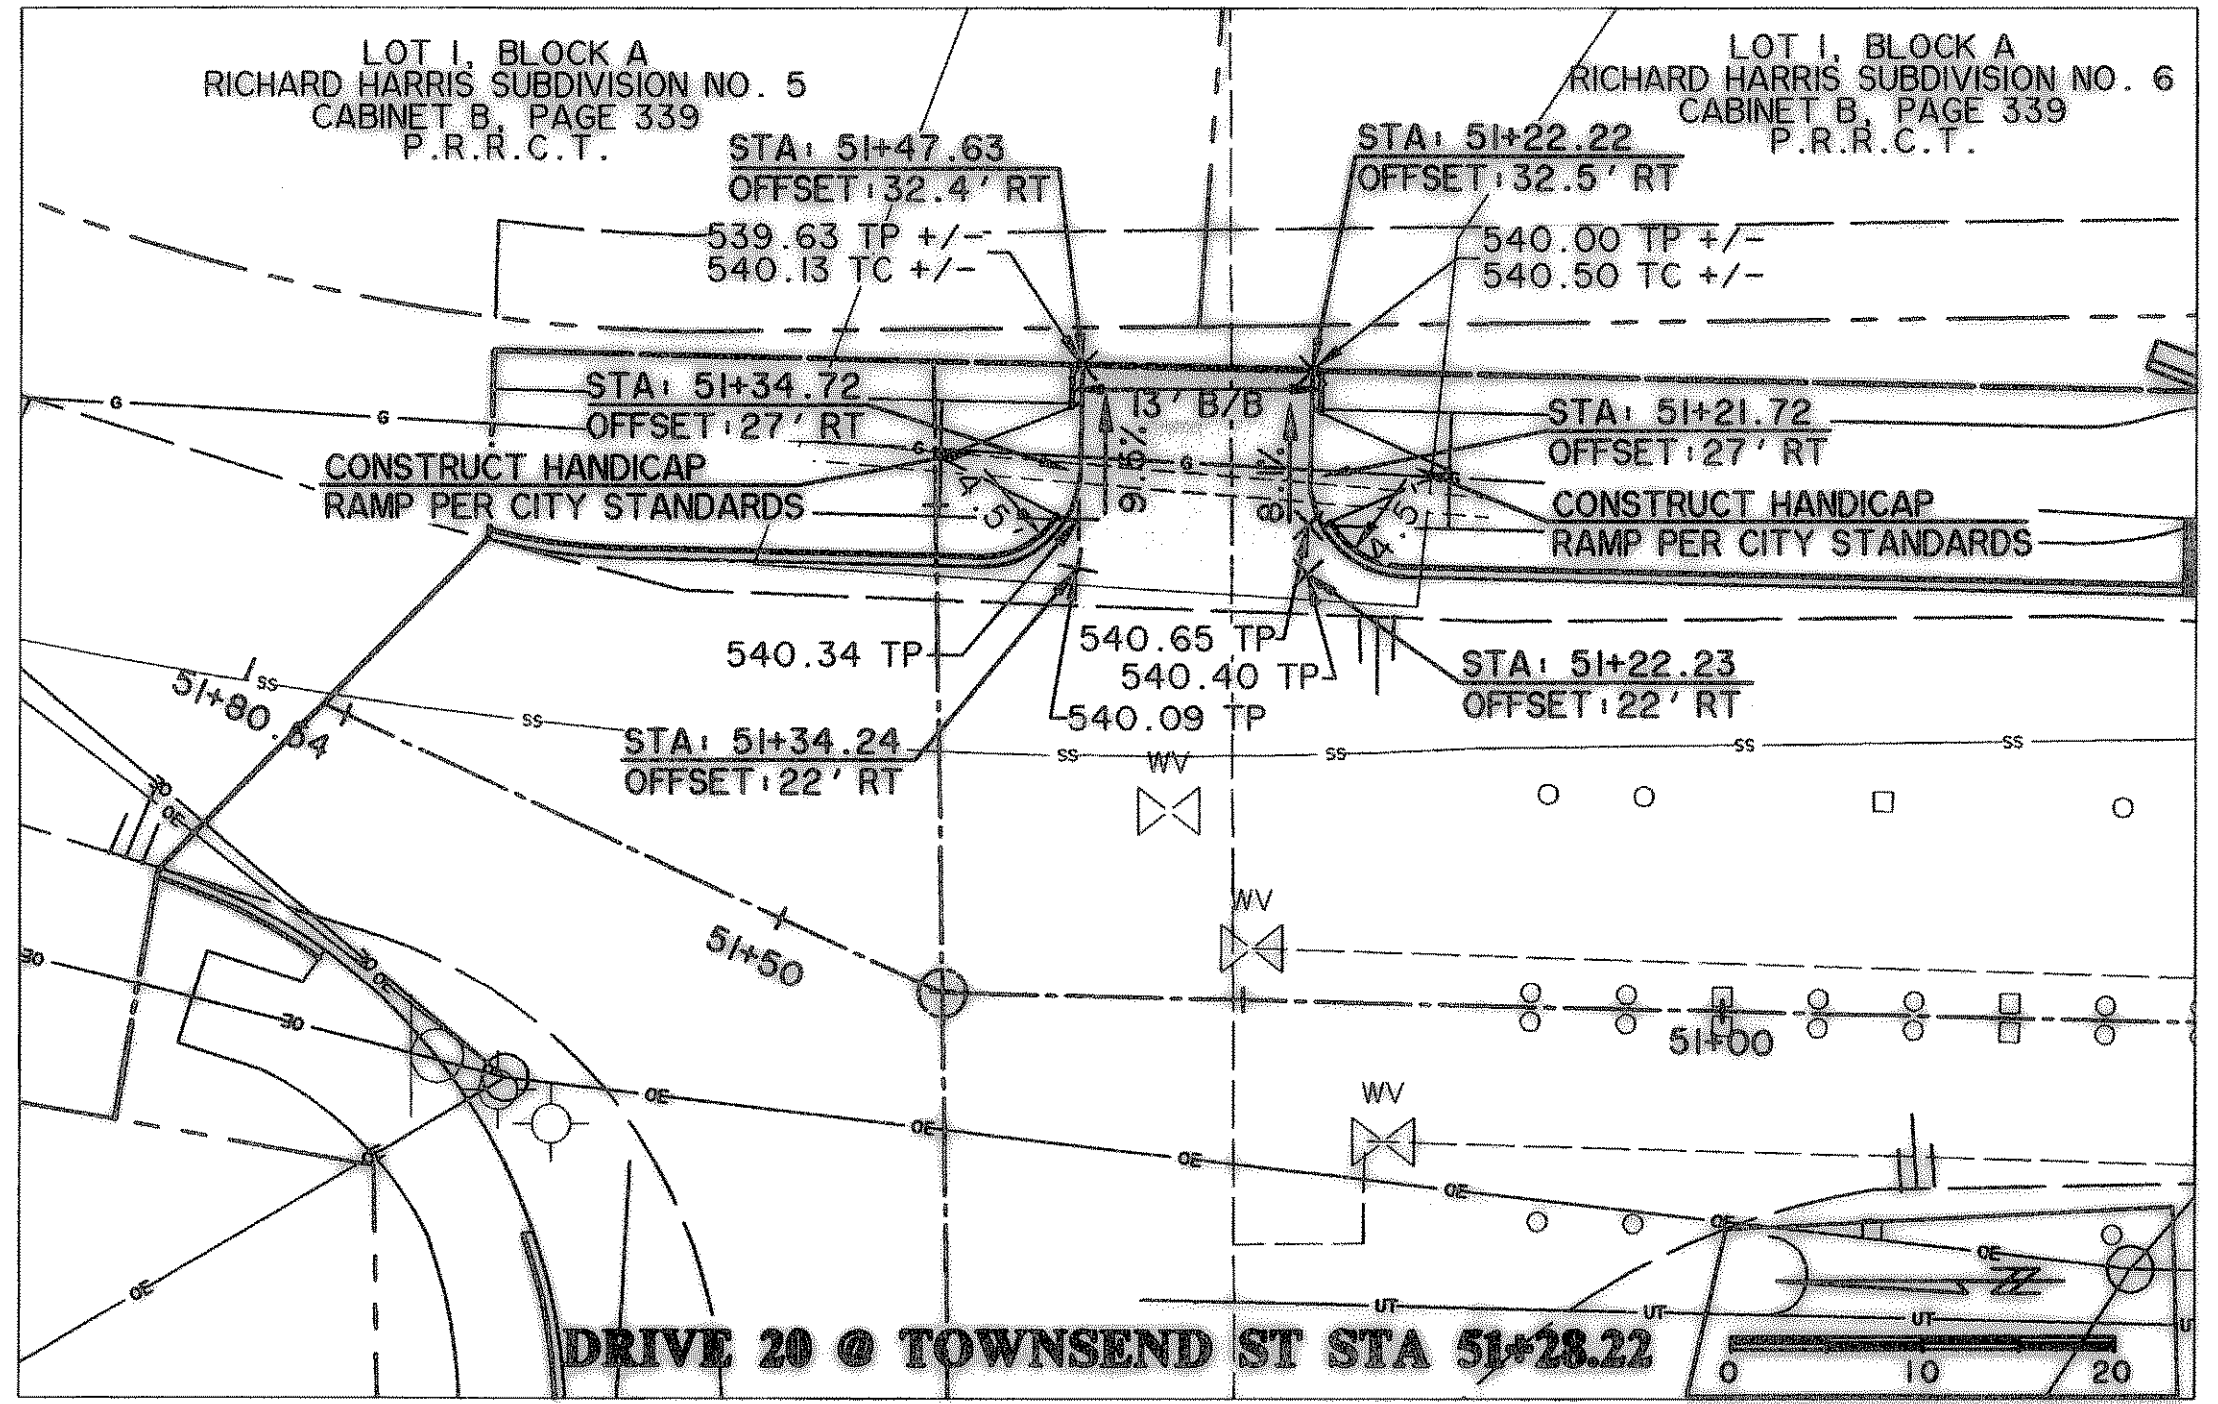


**DRIVE 20 @ TOWNSEND ST STA 51+28.22**

MAX CROSS SLOPE FOR SIDEWALKS SHALL BE 2% AT ALL LOCATIONS, INCLUDING ALL DRIVEWAY CROSSINGS.

NOTE: SEE PAVING PLAN & PROFILE SHEETS FOR GENERAL UTILITY LINE LOCATIONS AND/OR OTHER INFORMATION.

**RECORD DRAWING**  
01/16/09

PREPARED BY:  
**VIA WIER & ASSOCIATES, INC.**  
ENGINEERS SURVEYORS LAND PLANNERS  
701 HIGHLANDER BLVD., SUITE 300 ARLINGTON, TEXAS 76015 METRO (617)467-7700  
6849 ELVA STREET FISCO, TEXAS 75024 METRO (214)357-0000  
www.viawier.com

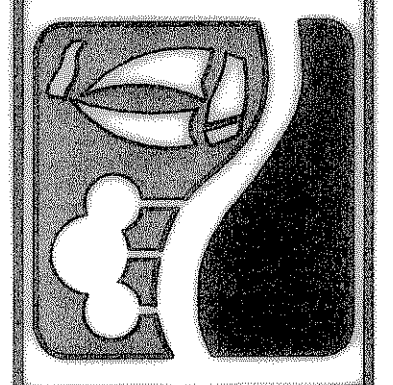

**CITY OF ROCKWALL**  
**TOWNSEND BLVD**  
**(JUSTIN RD TO BOYDSTUN ST)**  
**& BOYDSTUN ST**  
**(TOWNSEND BLVD TO CLARK ST)**  
**BOYDSTUN STREET**  
**DRIVEWAY PLAN**

**BOYDSTUN STREET**  
**DRIVEWAY PLAN**



Copyright ©  
WIER & ASSOCIATES, INC.  
LAST SHEET EDIT  
DATE 01-07-2009  
WA# 04124  
**SHEET NO.**  
**P202**

TIME 16.08 FILE: DRIVE2-PHI-04124.dwg