


**RECORD
DRAWING**
01/16/09

PREPARED BY:
WIER & ASSOCIATES, INC.
ENGINEERS SURVEYORS LAND PLANNERS
701 HIGHLANDER BLVD., SUITE 300 ARLINGTON, TEXAS 76015 METRO (817)467-7700
8849 ELM STREET FRISCO, TEXAS 75034 METRO (214)387-8000
www.wierassociates.com

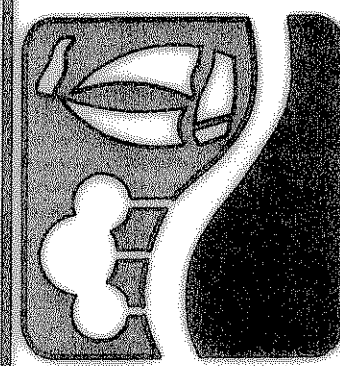

CITY OF ROCKWALL
TOWNSEND BLVD
(JUSTIN RD TO BOYDSTUN ST)
& BOYDSTUN ST
(TOWNSEND BLVD TO CLARK ST)

PAVING DETAILS



RONALD RAMIREZ
81821
REGISTERED PROFESSIONAL ENGINEER

COPYRIGHT ©
WIER & ASSOCIATES, INC.
LAST SHEET EDIT
DATE 01-07-2009
WAR 04124

SHEET NO.
P002