


TIME: 12:56 FILE: PAVES-P11-04124.dwg

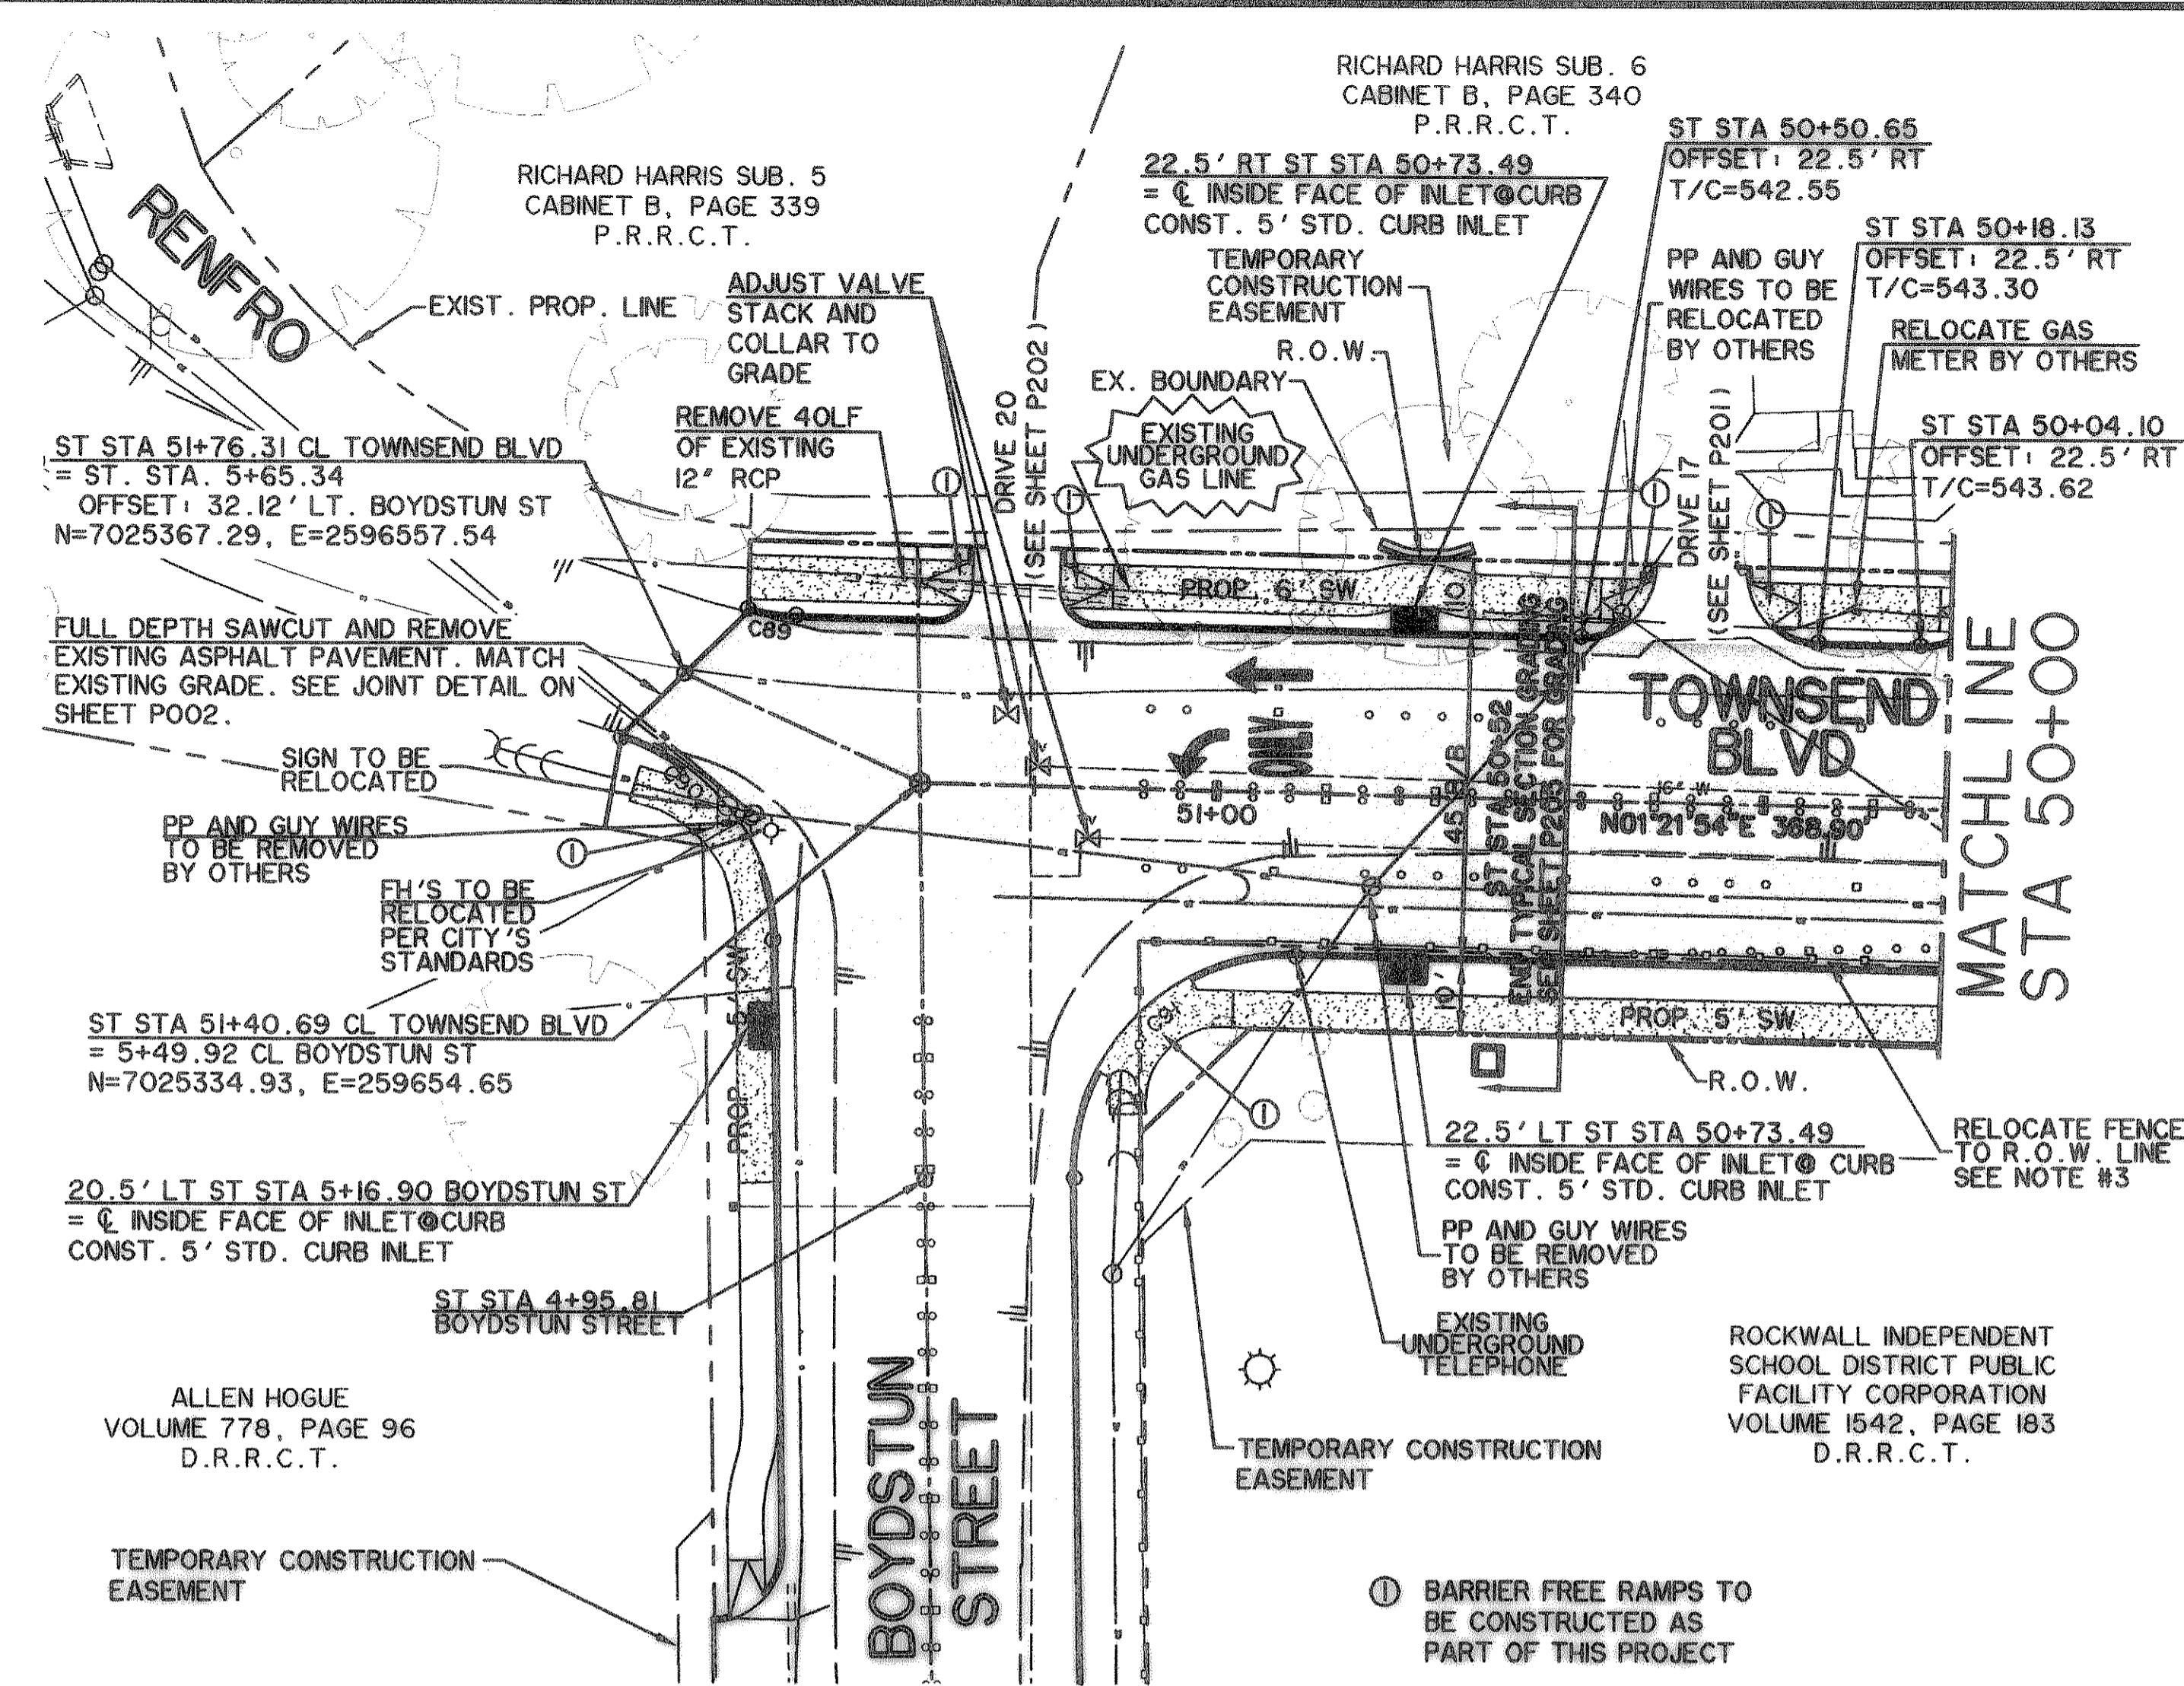



**CAUTION !!!**  
UNDERGROUND UTILITIES

EXISTING UTILITIES AND UNDERGROUND FACILITIES INDICATED ON THESE PLANS HAVE BEEN LOCATED FROM REFERENCE INFORMATION SUPPLIED BY VARIOUS OWNERS OF THE FACILITIES. THE ENGINEER DOES NOT ACCEPT THE RESPONSIBILITY FOR THE UTILITY LOCATIONS SHOWN, IT SHALL BE THE RESPONSIBILITY OF THE CONTRACTOR TO VERIFY BOTH HORIZONTALLY AND VERTICALLY THE LOCATION OF ALL EXISTING UTILITIES AND UNDERGROUND FACILITIES PRIOR TO CONSTRUCTION, TO TAKE NECESSARY PRECAUTIONS IN ORDER TO PROTECT ALL FACILITIES ENCOUNTERED, AND TO NOTIFY THE ENGINEER PROMPTLY OF ALL CONFLICTS OF THE WORK WITH EXISTING FACILITIES. THE CONTRACTOR SHALL PRESERVE AND PROTECT ALL EXISTING UTILITIES FROM DAMAGE DURING CONSTRUCTION. ANY DAMAGE BY THE CONTRACTOR TO EXISTING UTILITIES SHALL BE REPAIRED BY THE CONTRACTOR AT HIS EXPENSE. CONTACT ALL POSSIBLE UTILITY AND UNDERGROUND FACILITY OWNERS.

- NOTES
1. CONTRACTOR SHALL COORDINATE RELOCATIONS WITH FRANCHISE UTILITIES AT LEAST THREE WEEKS PRIOR TO CONSTRUCTION.
  2. ALL DIMENSIONS, LINES, CURVES, AND POINTS ARE TO THE BACK OF CURB UNLESS NOTED OTHERWISE.
  3. COORDINATE FENCE RELOCATION WITH OWNER. SECURITY AT OWNER'S PROPERTY SHALL BE MAINTAINED AT ALL TIMES BY TEMPORARY FENCING OR OTHER MEANS.

CURVE TABLE						
CURVE	DELTA	LENGTH	RADIUS	TANGENT	CHORD BR	CHORD LN
C89	12°58'30"	6.68	29.50	3.35	N07°51'09"E	6.67
C90	72°03'29"	37.10	29.50	21.46	N52°58'15"E	34.70
C91	92°21'55"	47.56	29.50	30.74	N44°49'03"W	42.57

SEE SHEET P205  
FOR GRADING OF  
THIS INTERSECTION

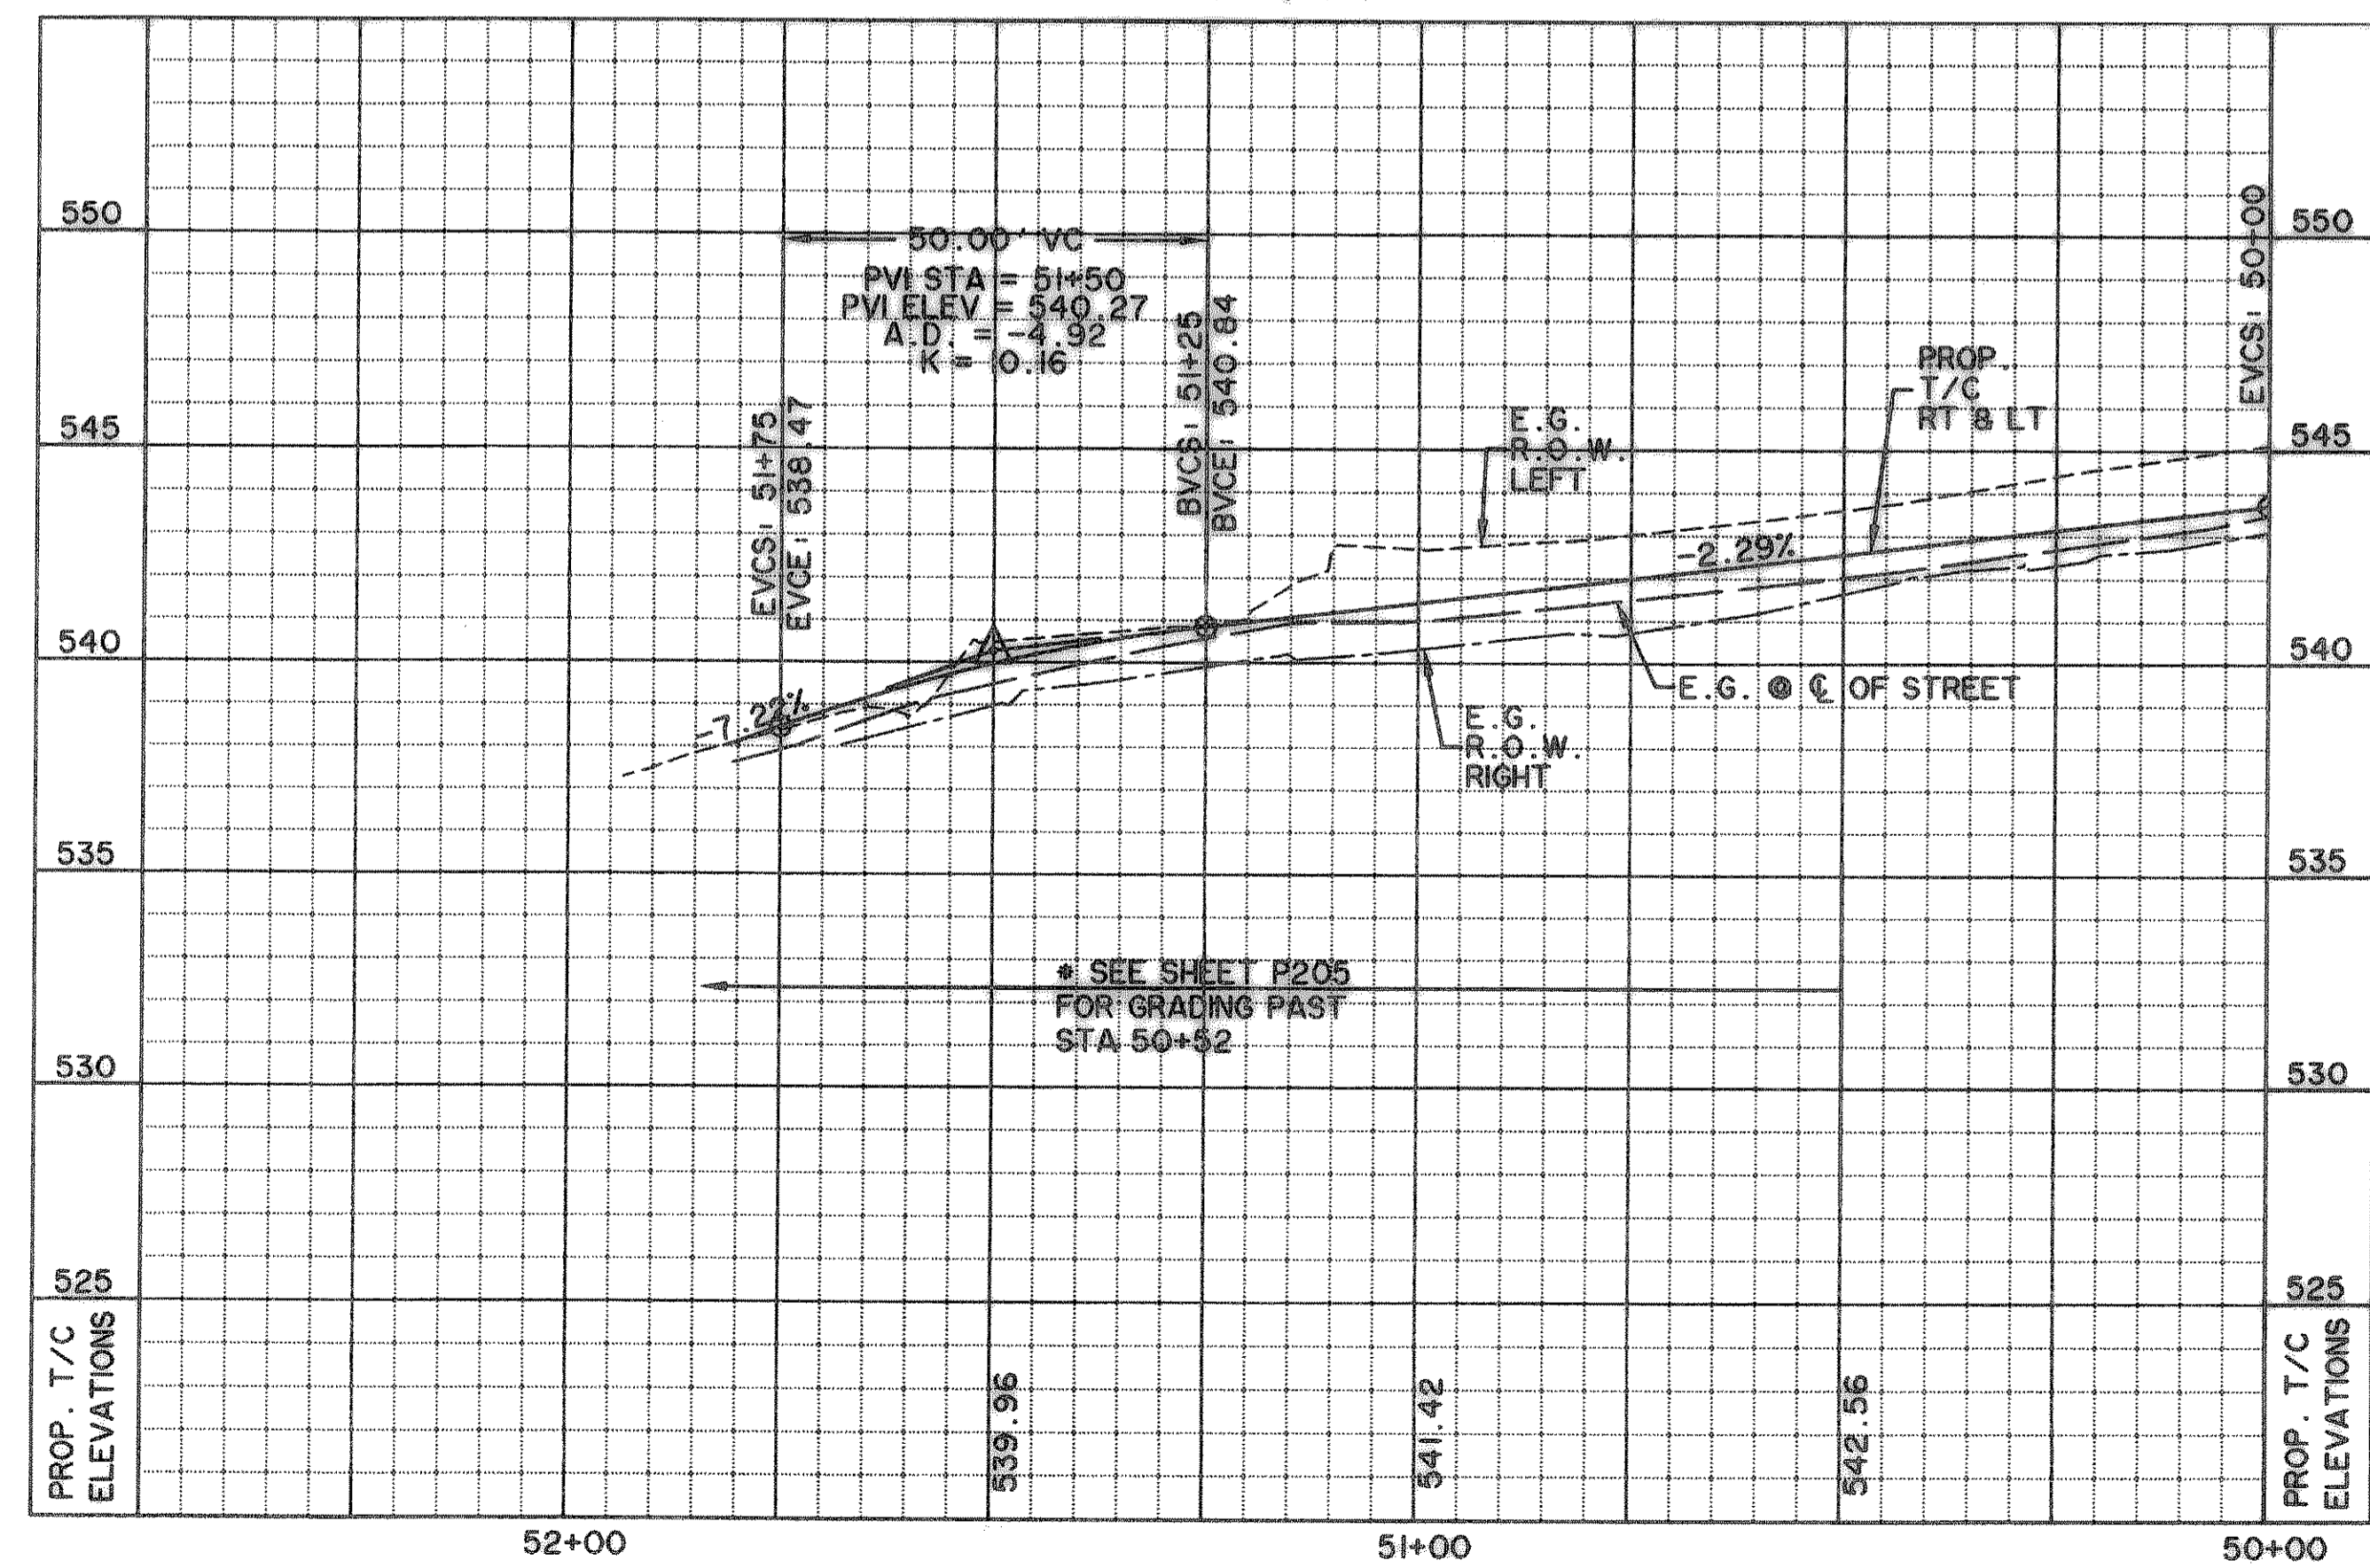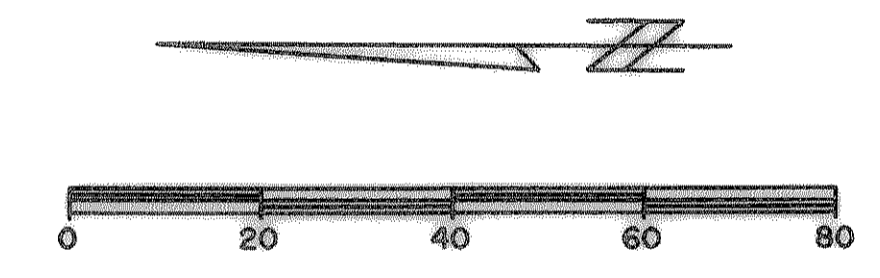


**RECORD  
DRAWING  
01/16/09**

**BENCHMARKS:**  
 "□" CUT IN THE EAST END OF THE HEADWALL LOCATED ON THE NORTHWEST CORNER OF THE INTERSECTION OF BOYDSTUN STREET AND CLARK STREET. ELEVATION 534.21  
 "□" CUT IN THE SOUTHWEST CORNER OF THE HEADWALL LOCATED ON THE WEST SIDE OF INDUSTRIAL BLVD, APPROXIMATELY 250± FEET NORTH OF THE INTERSECTION OF INDUSTRIAL AND THE I-30 ACCESS ROAD. ELEVATION 544.77

**LEGEND**

- 3600 PSI CONCRETE PAVEMENT
- PROPOSED SIDEWALK
- PROPOSED ASPHALT PAVEMENT
- W — EXISTING WATER LINE
- SS — EXISTING SEWER LINE
- R.O.W. LINE
- LOT LINE
- FIRE HYDRANT
- STORM DRAIN INLET
- WATER VALVES
- DIRECTION OF FLOW
- EXISTING SIGN
- OE — EXISTING OVERHEAD ELECTRIC
- G — EXISTING UNDERGROUND GAS
- EXISTING WATER VALVE
- UT — EXISTING UNDERGROUND TELEPHONE
- EXISTING ASPHALT PAVEMENT
- BARRIER FREE RAMP TO BE CONST. W/PROJECT
- INTERLOCKING PAVING STONES TO BE APPROVED BY CITY

PREPARED BY:  
**VIA WIER & ASSOCIATES, INC.**  
 ENGINEERS SURVEYORS LAND PLANNERS  
 701 HIGHLANDER BLVD., SUITE 300 ARLINGTON, TEXAS 76015 METRO (817)467-7700  
 6849 ELM STREET FRISCO, TEXAS 75034 METRO (214)387-8000  
 www.viawier.com

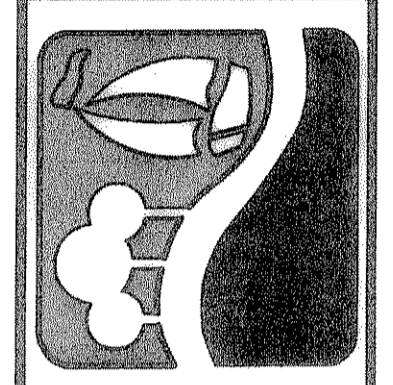

**CITY OF ROCKWALL  
 TOWNSEND BLVD  
 (JUSTIN RD TO BOYDSTUN ST)  
 & BOYDSTUN ST  
 (TOWNSEND BLVD TO CLARK ST)**

**TOWNSEND BLVD  
 PAVING PLAN & PROFILE  
 STA 50+00 TO STA 51+41**

STATE OF TEXAS  
 RONALD RAMIREZ  
 81821  
 REGISTERED PROFESSIONAL ENGINEER  
 11/22/09  
 COPYRIGHT ©  
 WIER & ASSOCIATES, INC.  
 LAST SHEET EDIT  
 DATE: 01-08-2009  
 WA# 04124  
**SHEET NO.  
 P101**