

CITY OF ROCKWALL

TRAFFIC SIGNAL INTERSECTION IMPROVEMENTS

ROCKWALL COUNTY

LIMITS: N. LAKESHORE DRIVE AT MASTERS DRIVE
TYPE OF WORK: FOR THE CONSTRUCTION OF A TRAFFIC SIGNAL
AND PEDESTRIAN CROSSING IMPROVEMENTS



City of Rockwall
The New Horizon

FOR THE CITY OF ROCKWALL, TEXAS
ENGINEERING DEPARTMENT

CIP2015-015

CITY CONTACT: JEREMY WHITE, P.E.
EMAIL: JWHITE@ROCKWALL.COM
PHONE: 972-771-7746

Kimley»Horn

TBPE FIRM REGISTRATION NO. F-928
2201 WEST ROYAL LANE, STE. 275, IRVING, TX 75063
PHONE: 214-420-5800 FAX: 214-420-5680
WWW.KIMLEY-HORN.COM

PROJECT INTERSECTION



N
ROCKWALL COUNTY
N.T.S.
TXDOT
DALLAS DISTRICT

RECORD DRAWINGS

THESE RECORD DRAWINGS HAVE BEEN PREPARED TO REFLECT ANY CHANGES AND/OR MODIFICATIONS MADE TO THE DESIGN PLANS, PROVIDED BY THE CONTRACTOR AND THE CITY INSPECTOR. UNLESS OTHERWISE NOTED, THE PROJECT HAS BEEN CONSTRUCTED IN SUBSTANTIAL CONFORMANCE WITH THE DESIGN DRAWINGS. THE ENGINEERING CONSULTANT IS NOT RESPONSIBLE FOR ACCURACY AND COMPLETENESS EXCEPT FOR WHAT WAS PROVIDED BY THE CONTRACTOR. THE PLAN SET USED FOR BIDDING ORIGINALLY SEALED 5/4/2016 AND REVISED 8/8/2016.

Thomas P. Grant, P.E. 2/20/2017
SIGNATURE DATE

THOMAS P. GRANT, P.E., KIMLEY-HORN AND ASSOCIATES, INC.

MAY 2016 FINAL CONSTRUCTION PLANS

REVISIONS

SEALED FINAL PLANS: _____ 5/4/2016 _____

REVISION 1: _____ 8/8/2016 - ELECTRICAL SERVICE REVISION & ADD SIGN _____

RECORD DRAWINGS: _____ 2/20/2017 - RECORD DRAWINGS _____

Plotted By: Yehorovich, Brendan - Sheet Set: ### - Location: GENERAL NOTES - February 20, 2017 10:45:28am - K:\LAC_PFT\Yehorovich\064420914-tokeshore signal design rockwall\CAD\plansheets\GENERAL NOTES.dwg
 This document, together with the concepts and designs presented herein, is intended only for the specific purpose and client for which it was prepared. Release of any information contained on this document without written authorization and adaptation by Kimley-Horn and Associates, Inc. shall be without liability to Kimley-Horn and Associates, Inc.

GENERAL NOTES:

Repair or replace any structures and utilities that might have been damaged by negligence or a failure to have utility locates performed. Perform all electrical work in accordance with the National Electrical Code and Texas Department of Transportation Specifications. Consult with appropriate electric company representatives according to their respective area to coordinate electrical services installations.

Provide a formed smooth finish for all portions of drill shafts extending above proposed ground. Include cost for this work in the unit bid price for this item. Traffic signal pole foundations will be paid for once regardless of extra work caused by obstructions.

Install a 5/8"x10' copper clad ground rod in each traffic signal pole foundation. The ground rod for each foundation will protrude above the finish grade of the foundation a minimum of 1" and a maximum of 2".

Concrete removal required for installation of drilled shafts will be subsidiary to Item 416.

Provide sulfate resistant concrete for all drilled shafts.

Material On Hand (MOH) will not be used in calculating partial payments for Mobilization.

Provide grooved joints at 10-foot intervals and ¼ inch expansion joint material for doweled curb at the same locations as on the existing pavement. For Curb and Gutter sections, provide grooved joints at 10-foot intervals and ¼ inch expansion joint material at a maximum of 50-foot centers and at all radius points and inlets. Curb and Gutter transitions will be paid for by the foot at the unit price for the corresponding curb or curb and gutter section. Saw joints at the same location as on the existing pavement.

Furnish one type of post throughout the project except as specifically noted in the plans.

Form a 3/4-inch chamfer on the top edge of each pedestal pole foundation.

Probe for utilities and underground structures prior to drilling foundations. Foundations shall be paid for once regardless of extra work caused by obstructions.

Provide submittal literature for all traffic signal equipment before installation.

Furnish and install a new controller (eight phase NEMA TS 2 Type 2) and cabinet (NEMA TS 2 Size 6, 16 position load bay), meeting the requirements of Departmental Materials Specifications DMS-11170. Provide the cabinet with an "A" connector harness for NEMA TS 2 Type 2 controllers. Provide detector panel toggle switches with a fixed position that additionally permit the user to disconnect the detector. Provide a pole-mounted cabinet that has three brackets for pole mounting.

Provide three (4) cameras for this project, including one (1) spare camera. Provide a set-up system. Load required set-up software onto all of the City Signal Shop's notebook computers and provide all necessary licensing. The Contractor does not provide computers as part of the set-up system. Ensure the C/PDU operational software is stored internally in flash memory and capable of being updated without the removal and replacement of memory devices. Install the VIVDS detection zones as directed. Have qualified personnel on site at the time of the signal turn-on to assist with the installation of VIVDS detection zones. If the camera locations shown in the plans do not allow for proper sight of the proposed detection zones, relocate the cameras as needed and as directed. This labor and material cost will not be paid separately, but is subsidiary to this item.

Item 502:

Access will be provided to all business and residences at all times. Provide written proposed lane closure information by 1:00 pm on the business day prior to the proposed closures. Do not close lanes when this requirement is not met. Place barricades and signs in locations that do not obstruct the sight distance of drivers. Do not commence work on the road before sunrise and adhere to the Freeway Lane Closure Table. Do not operate or park any equipment/machinery closer than 30 feet from the traveled roadway after sunset unless authorized by the City. When moving unlicensed equipment on or across any pavement or public highways, protect the pavement from all damage using an acceptable method. Limit lane closures to the hours between 9:00 am and 3:30 pm. Work in other areas of the project is not restricted to this time frame.

Item 618:

The location of conduits and ground boxes are diagrammatic shown and may be shifted to accommodate field conditions as directed. Secure permission and approval from the proper authority prior to cutting into or removing any sidewalks or curbs for installation of this Item. When holes are drilled through concrete structures, use a coring device. Do not use masonry or concrete drills. Place conduit under existing pavement by an approved boring method. Do not place boring pits closer than 2 feet from the edge of the pavement unless otherwise directed. Do not use water jetting. When conduits are bored, do not exceed 18 inches in the vertical and horizontal tolerances as measured from the intended target point. Do not use a pneumatically driven device for punching holes beneath the pavement (commonly known as a "missile"). Furnish and install a non-metallic mule tape in conduit runs in excess of 50 feet. Also furnish and install non-metallic mule tape in conduit installed for future use and cap using standard weather-tight conduit caps, as approved. Furnish Garvin # PT-1250-3K, ComStar PUL 1250P3K, Ideal Part No. 31-315 or equal as approved by the Engineer. This work will not be paid for directly, but is subsidiary to this Item. Use a colored cleaner-primer on all PVC to PVC joints before application of PVC cement. Seal all conduit ends with a permanently soft, non-toxic duct seal. Use a duct seal that does not adversely affect other plastic materials or corrode metals. 2" Schedule 80 PVC will be used at the power pole to supply electricity to underground services.

Item 620:

The equipment grounding conductor shall be identified by a continuous green colored jacket insulation or bare wire. Grounded conductors (Neutral) shall be identified by a continuous white colored jacket. Ungrounded conductors (Hot) in a 120/240v or 240/480v system shall be identified by each pole or leg. For 240-volt branch circuit fed from 120/240 source and 480-volt branch circuit fed from 240/480 source, ensure one leg is identified by a continuous black colored jacket and the other leg by a continuous red colored jacket.

Item 624:

Slack conductors required by Standard Sheet ED(3)-14 will be subsidiary to Item 624. Concrete removal required for installation of ground boxes will be subsidiary to Item 624.

Item 628:

Contact the appropriate utility company during the first three weeks of the project lead-time period to allow adequate time for any necessary utility adjustments, transformer installation, etc. Label the service enclosures indicating service address as well as all required information as shown on the Electrical Detail (ED) standard sheets. Labeling shall be silk screening or other acceptable method. This work will not be paid for directly, but is subsidiary to this Item.

A Licensed Master Electrician shall be required to install all electrical services.

Item 644:

Prior to taking elevations to determine lengths for fabrication of sign posts, obtain verification of all proposed locations. All sign mounts shall have a clamp base system for all small roadside sign assemblies.

Item 677:

A water blasting method approved by the Engineer will be the only method allowed for the removal of permanent and temporary pavement markings except on a sealcoat surface. A 2 foot wide sealcoat will be required on sealcoat surfaces to eliminate permanent and temporary pavement markings.

Item 680:

Requirements for this Item include the following work, all of which are subsidiary to this Item:

1. Provide submittal literature for all traffic signal equipment before installation.
2. Furnish and install a new controller (eight phase NEMA TS 2 Type 2) and cabinet (NEMA TS 2 Size 6, 16 position load bay), meeting the requirements of Departmental Materials Specifications DMS-11170. Provide the cabinet with an "A" connector harness for NEMA TS 2 Type 2 controllers. Provide detector panel toggle switches that additionally permit the user to disconnect the detector. For a pole-mount controller, provide three mounting brackets and install a 5' x 5' x 4" Class A concrete foundation under the cabinet in accordance to Items 420 and 421.
3. Install the controller cabinet in an orientation as directed.
4. Connect all field wiring to the controller assembly, including solid state relay (SSR) coaxial cable termination into the polyphaser. The City will assist in determining how the detection cables are to be connected, and will also program the controller for operation, hook up the malfunction management unit (MMU) or conflict monitor, detector units, and other equipment, and turn on the controller. Have a qualified technician and a representative from the controller supplier on the project site to place the traffic signals in operation.
5. Furnish and install all sign panels for mounting on signal poles, mast arms, and span wires. Fabricate the sign panels in accordance with Item 636, and mount with Astro-Sign Brac, Signfix aluminum channel, or equal as approved by the Engineer. Submit five (5) sets of shop drawings for street name signs.
6. Provide 250W HPS Equivalent LED Fixtures with 240 volt electronic LED drivers as shown on the Material Producers List.
7. Remove the existing stop sign panels after the traffic signals are in operation.
8. Furnish and Install the emergency vehicle preemption equipment.
9. Have a qualified technician on the project site to place the traffic signal in operation.
10. Use qualified personnel to respond to and diagnose all trouble calls during the thirty-day test period. Repair any malfunction to Contractor-supplied signal equipment. Provide to the Engineer a local telephone number, not subject to frequent changes and available on a 24-hour basis, for reporting trouble calls. Response time to reported calls must be less than 2 hours. Make appropriate repairs within 24 hours. Place a logbook in the controller cabinet and keep a record of each trouble call reported. Notify the Engineer of each trouble call. Do not clear the error log in the conflict monitor or MMU during the thirty-day test period without approval.
11. Prevent any damage to property owner's poles, fences, shrubs, mailboxes, etc. Protect all underground and overhead utilities and repair any damage. Provide access to all driveways during construction. The Contractor shall protect the existing neighborhood development walls to avoid damage. Contractor shall be responsible for any damage inflicted to the walls during construction.
12. The Contractor shall restore any site construction impacts to a similar or better condition subsidiary to TxDOT Item 680. This restoration includes but is not limited to turf restoration, sodding, or irrigation.

Item 682:

Install signal head attachments so that the wiring to each signal head passes from the mast arm through the attachment hardware to the signal head. Do not leave cable or wiring exposed. Provide signal head attachments that allow for adjustment about the horizontal and vertical axis. Provide aluminum pedestrian and vehicle signal heads in the following color: Federal Yellow #13538 of Federal Standard 595. Provide non-painted aluminum tubing. Provide back plates and the inside of visors with a flat black finish. Provide aluminum vented back plates for all traffic signal heads. Turn down signal heads or cover with burlap or other material, as approved, until traffic signal is placed in operation. Mount signal heads level and plumb and aim as directed.

Item 684:

Identify each cable as shown on the plans (cable 1, etc.) with permanent marking labels (Panduit Type PLM standard single marker tie, Thomas&Betts Type 548M, or equal) at each ground box, pole base, and controller.

Item 686:

Provide 12 circuit Buchanan Type 112SN, Kulka Type 985-GP-12 CU, or equal terminal strips in the signal pole access compartment. Provide additional terminal strips of 8 circuits each when more than 12 circuits are required. The conductors for the Line and Load side of the terminal strip shall be identified with a plastic label with two straps per tag. The line side shall have each signal head, PED head, and push button identified on the tag. Mark pole shafts and mast arms with the identification numbers from the plans to facilitate field-assembly. Identify pole shafts and mast arms by intersection for projects with multiple intersections. Provide nuts on top and bottom (double nuts) of the base plate as shown on the plans. Set anchor bolts for mast arm signal poles and strain poles so that two are in tension and two are in compression. Obtain approval of anchor bolt placement before placing concrete. Provide vertical clearance of 17 to 19 feet from the roadway to the lowest point of the signal head or mast arm. Place signal heads 40 feet minimum and 180 feet maximum from the stop line. If the nearest signal is more than 180 feet from the stop line, place a supplemental near-side signal head. Determine the field measurements and elevations from the actual field location of the poles, considering all above and below ground utilities and existing roadway elevations. Provide vibration dampers for mast arms 28 feet to 48 feet in length. Install as shown on MA-DPD-12.

Item 688:

Verify the location of the APS units and the direction of the arrows on the signs prior to installation.

TS 41

Aluminum signs shall be made according to the standards outlined in the TxDOT 'Standard Highway Sign Designs for Texas' manual, 2012 edition, Revision 1 - October 2014.

TS 42

ILSN Street name signs shall be double-sided, LED illuminated, and mounted from the ILSN arm provided on each traffic signal pole. Contractor shall coordinate with the City on design of ILSNS and provide shop drawings of the signs for approval to the City prior to manufacturing the signs.

TS 44, TS 45, TS46

Opticom System shall include:

- (2 EA) 3M 721 Opticom Detectors
- (1 EA) 3M 380 Card Rack
- (1 EA) 3M 762 Phase Selector
- (2 EA) Narrow Hub Opticom Detector Brackets
- (418 LF) 138 Opticom Cable

TS 69

Any adjustments required to the irrigation system shall be subsidiary to this item to maintain the existing irrigation operations. No additional pay will be accepted for additional irrigation work.

Other Notes:

Follow all applicable construction notes included in the "City of Rockwall Construction Notes" Revised November, 2015. This document can be found on the City's web site.

Contractor shall protect pedestrian safety while curb ramps are being removed and reconstructed.

RECORD DRAWINGS

THESE RECORD DRAWINGS HAVE BEEN PREPARED TO REFLECT ANY CHANGES AND/OR MODIFICATIONS MADE TO THE DESIGN PLANS, PROVIDED BY THE CONTRACTOR AND THE CITY INSPECTOR. UNLESS OTHERWISE NOTED, THE PROJECT HAS BEEN CONSTRUCTED IN SUBSTANTIAL CONFORMANCE WITH THE DESIGN DRAWINGS. THE ENGINEERING CONSULTANT IS NOT RESPONSIBLE FOR ACCURACY AND COMPLETENESS EXCEPT FOR WHAT WAS PROVIDED BY THE CONTRACTOR. THE PLAN SET USED FOR BIDDING ORIGINALLY SEALED 5/4/2016 AND REVISED 8/6/2016.

Thomas P. Grant, P.E.
2/20/2017

SIGNATURE
DATE

THOMAS P. GRANT, P.E., KIMLEY-HORN AND ASSOCIATES, INC.

No.	REVISIONS	DATE	BY
2	RECORD DRAWINGS	2/20/2017	TG

2201 WEST ROYAL LANE, SUITE 275, IRVING, TX 75068
 PHONE: 214-420-6600
 WWW.KIMLEY-HORN.COM
 © 2017 KIMLEY-HORN AND ASSOCIATES, INC.
 Texas Registered Engineering Firm # F-528

KHA PROJECT	DATE	SCALE	DESIGNED BY	DRAWN BY	CHECKED BY
0644-20914	FEBRUARY 20, 2017	AS SHOWN	LAS	SMR/JWR	TFG

CITY OF
 ROCKWALL
 LAKESHORE AT
 MASTERS

GENERAL NOTES



SHEET NUMBER
3

CIP NO. 2015-15

Plotted By: Yehorovich, Brendan - Sheet Set: ## - Layout: INTERSECTION REMOVALS LAYOUT - February 20, 2017 - 10:48:50am - K:_LAC_TIP\0\Project\064420914\LakeShore signal design\rockwall\cad\plan\sheet\INTERSECTION REMOVALS LAYOUT.dwg
 This document, together with the concepts and designs presented herein, is intended only for the specific purpose and client for which it was prepared. Reuse of any information contained herein without written authorization and approval by Kimley-Horn and Associates, Inc. shall be without liability to Kimley-Horn and Associates, Inc.

NOTES:


- SEVERAL UTILITIES EXIST IN THE AREA AND ALL UTILITIES SHOWN ON THE PLANS ARE APPROXIMATE. THE CONTRACTOR SHALL BE RESPONSIBLE FOR CALLING 1-800-DIG-TESS, BILLY CHAFFIN AT THE CITY OF ROCKWALL AT 972-772-6333, AND ALL AFFECTED UTILITY COMPANIES FOR UTILITY LOCATES PRIOR TO ANY DRILLING OR EXCAVATION ON THE PROJECT.
- THE ROADWAY ILLUMINATION ASSEMBLY REMOVAL SHALL INCLUDE REMOVING THE LAMP FIXTURE, THE ILLUMINATION POLE, AND REMOVING THE FOUNDATION 2' BELOW FINISH GRADE AND BACKFILLING WITH SIMILAR FILL. CONTRACTOR SHALL BE RESPONSIBLE FOR CONTACTING PHILLIP DICKERSON AT 972-551-6712 WITH ONCOR TO COORDINATE THE REMOVAL OF THE EXISTING ILLUMINATION STRUCTURE AS WELL AS ANY SERVICE MODIFICATIONS. THIS WORK SHALL BE COMPLETED SUBSIDIARY TO TXDOT ITEM # 610 2072.
- CURB REMOVAL SHALL INCLUDE FULL DEPTH SAWCUT AND BLOCKOUT FOR INSTALLATION OF RAMPS.
- ILLUMINATION POLE BEING REMOVED HAS EXISTING COMMUNICATION DEVICE ON ILLUMINATION ARM THAT IS IN OLD AND NOT IN SERVICE. IT WILL BE REMOVED WITH THE ILLUMINATION POLE.
- LANDSCAPE REMOVAL IS SUBSIDIARY TO ITEM 680.

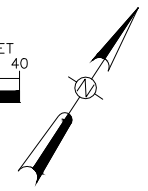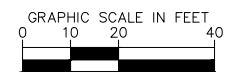

LEGEND:

- RIGHT OF WAY
- FIRE HYDRANT
- ⊕ EXISTING GROUND MT. SIGN


RECORD DRAWINGS
 THESE RECORD DRAWINGS HAVE BEEN PREPARED TO REFLECT ANY CHANGES AND/OR MODIFICATIONS MADE TO THE DESIGN PLANS, PROVIDED BY THE CONTRACTOR AND THE CITY INSPECTOR. UNLESS OTHERWISE NOTED, THE PROJECT HAS BEEN CONSTRUCTED IN SUBSTANTIAL CONFORMANCE WITH THE DESIGN DRAWINGS. THE ENGINEERING CONSULTANT IS NOT RESPONSIBLE FOR ACCURACY AND COMPLETENESS EXCEPT FOR WHAT WAS PROVIDED BY THE CONTRACTOR. THE PLAN SET USED FOR BIDDING ORIGINALLY SEALED 5/4/2016 AND REVISED 8/8/2016.
Thomas P. Grant, P.E. 2/20/2017
 SIGNATURE DATE
 THOMAS P. GRANT, P.E., KIMLEY-HORN AND ASSOCIATES, INC.

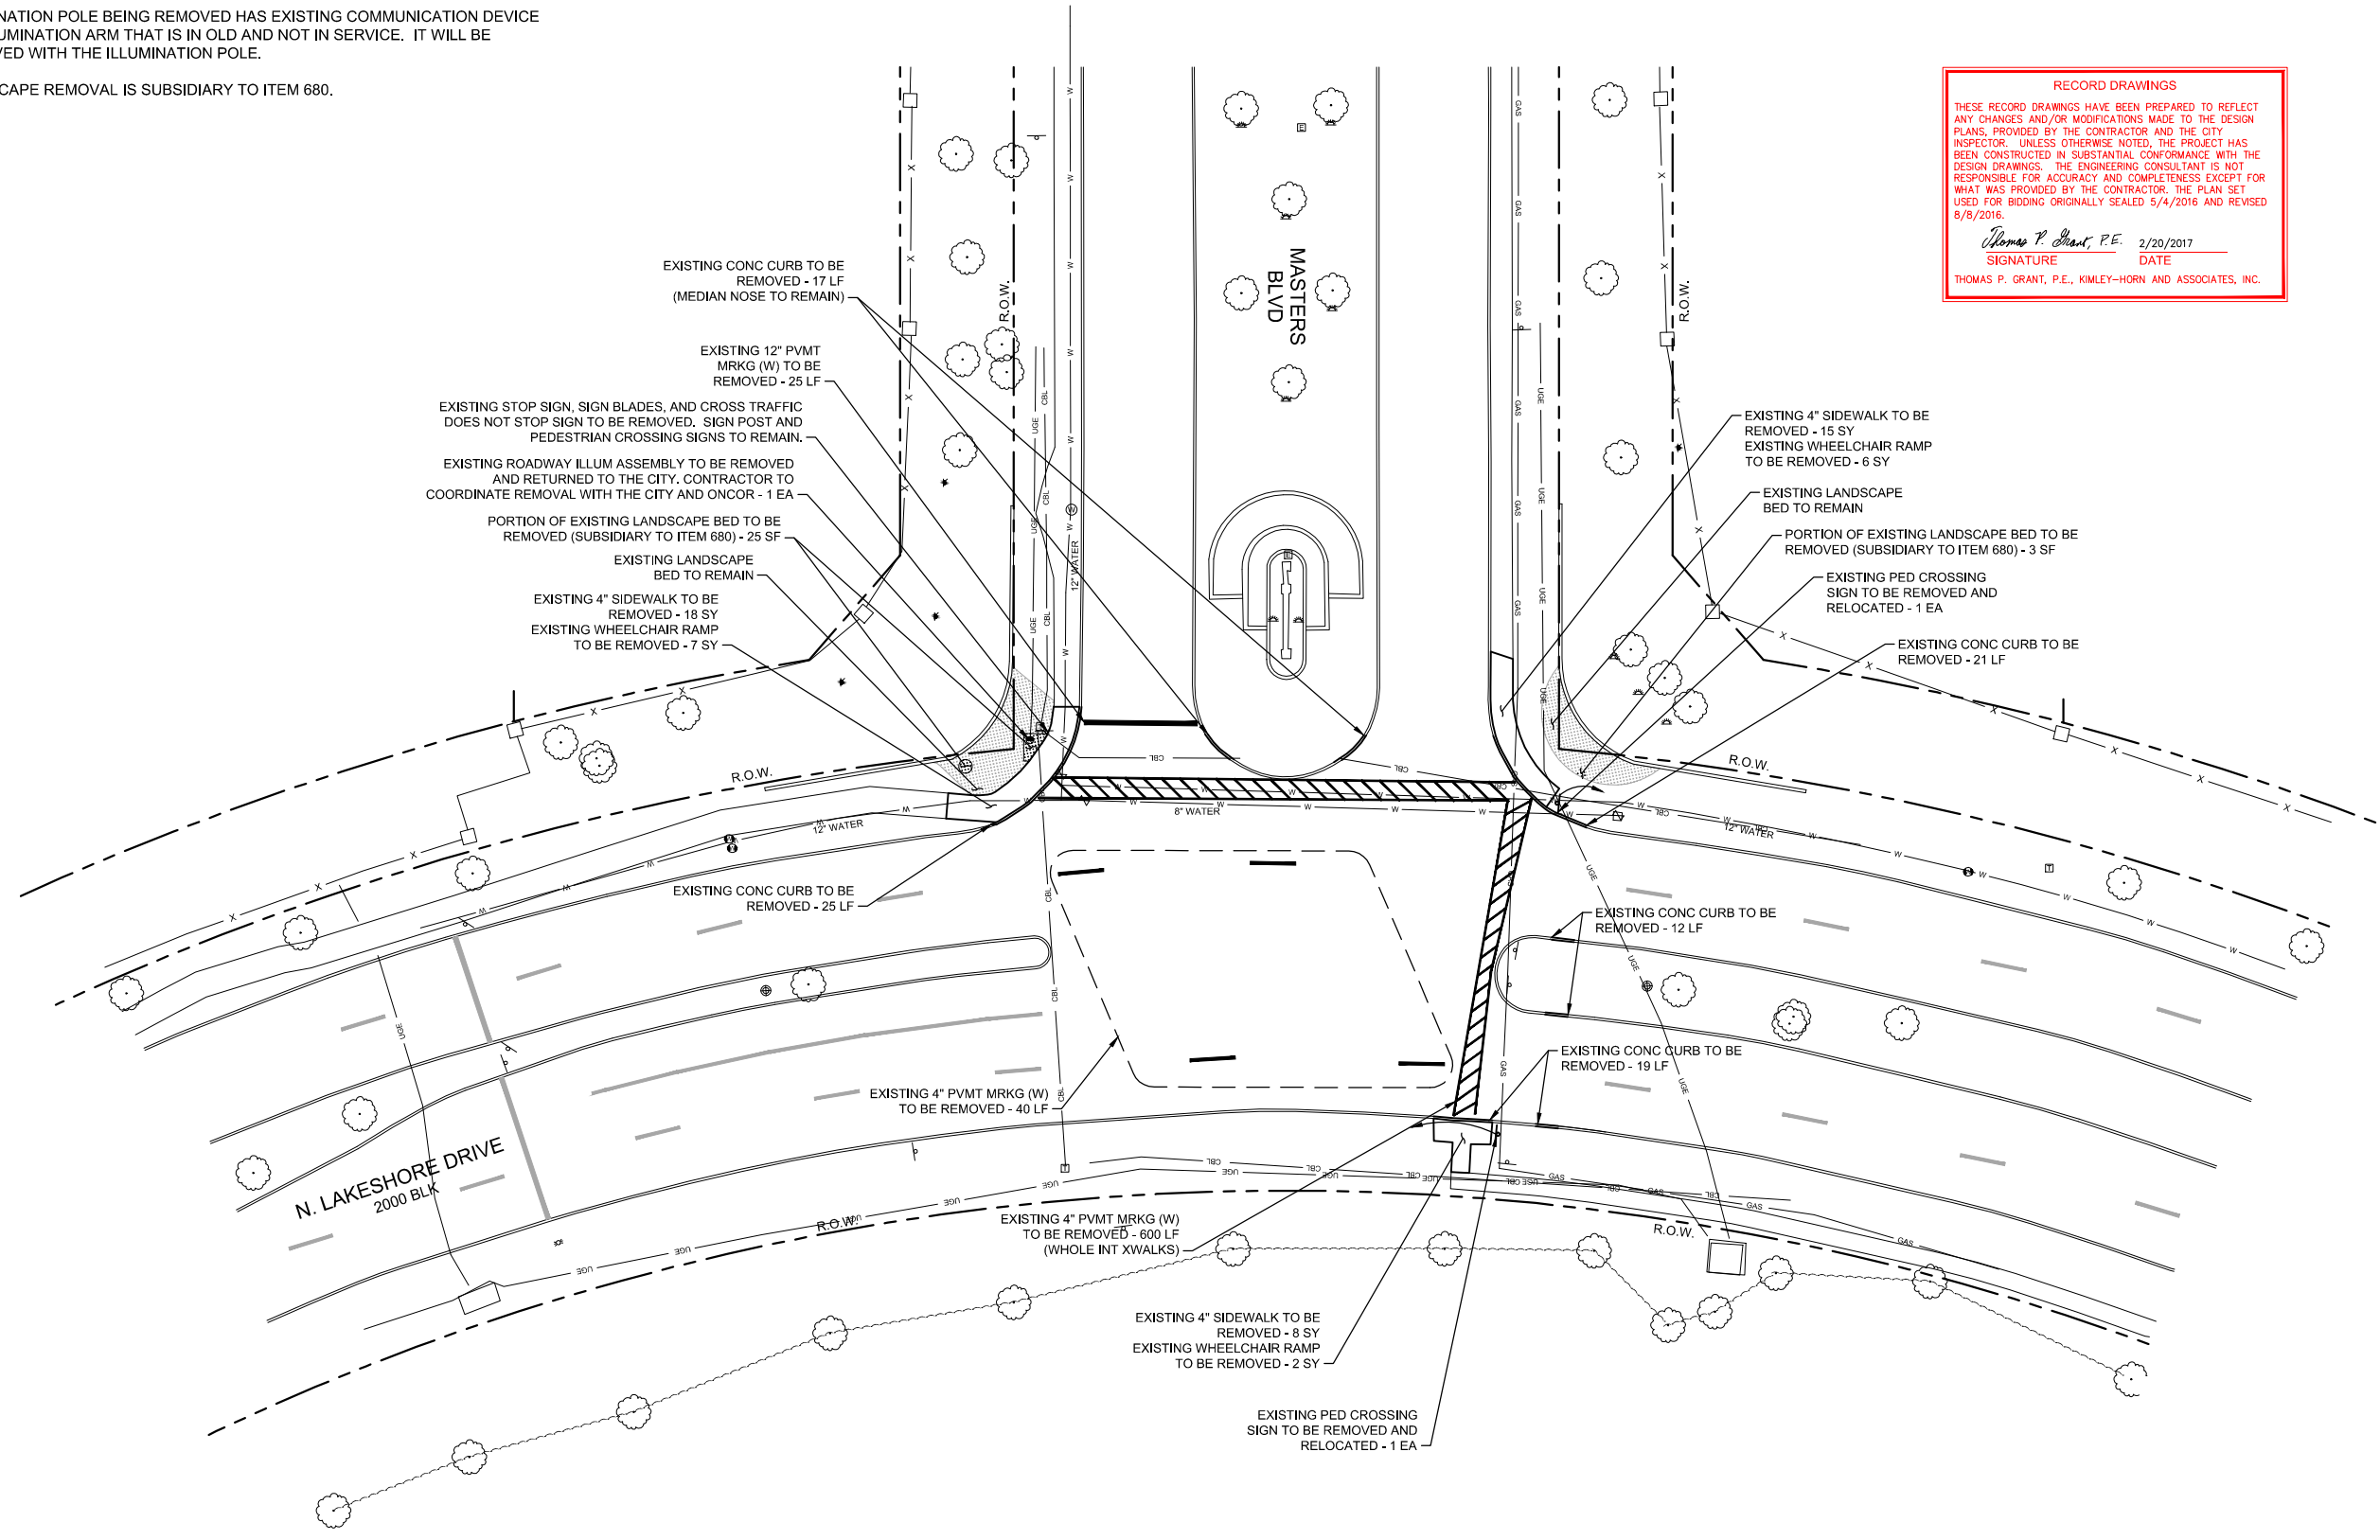

	NO.	REVISIONS	DATE	BY
	2	RECORD DRAWINGS	2/20/2017	TG
2201 WEST ROYAL LANE, SUITE 275, IRVING, TX 75063 PHONE: 214-420-6600 WWW.KIMLEY-HORN.COM © 2017 KIMLEY-HORN AND ASSOCIATES, INC. Texas Registered Engineering Firm # F-528				
KHA PROJECT	DATE	SCALE	DESIGNED BY	DRAWN BY
064420914	FEBRUARY 20, 2017	AS SHOWN	LAS	SMR/JWR
			CHECKED BY	TFG
CITY OF ROCKWALL LAKESHORE AT MASTERS				
TRAFFIC SIGNAL INTERSECTION REMOVALS LAYOUT				
SHEET NUMBER				
5				

CIP NO. 2015-15

Plotted By: yehorovich, Brendan, Sheet Set: ##, Layout: PERMANENT TRAFFIC SIGNAL LAYOUT, February 20, 2017, 11:30:53am, K:\LAC-PTD\Project\064420914-lakeshore signal design_rockwall\CAD\plan\sheet\Layout_Sheet.dwg
 This document, together with the concepts and designs presented herein, is intended only for the specific purpose and client for which it was prepared. Release of any information contained herein without written authorization and adaptation by Kimley-Horn and Associates, Inc. shall be without liability to Kimley-Horn and Associates, Inc.

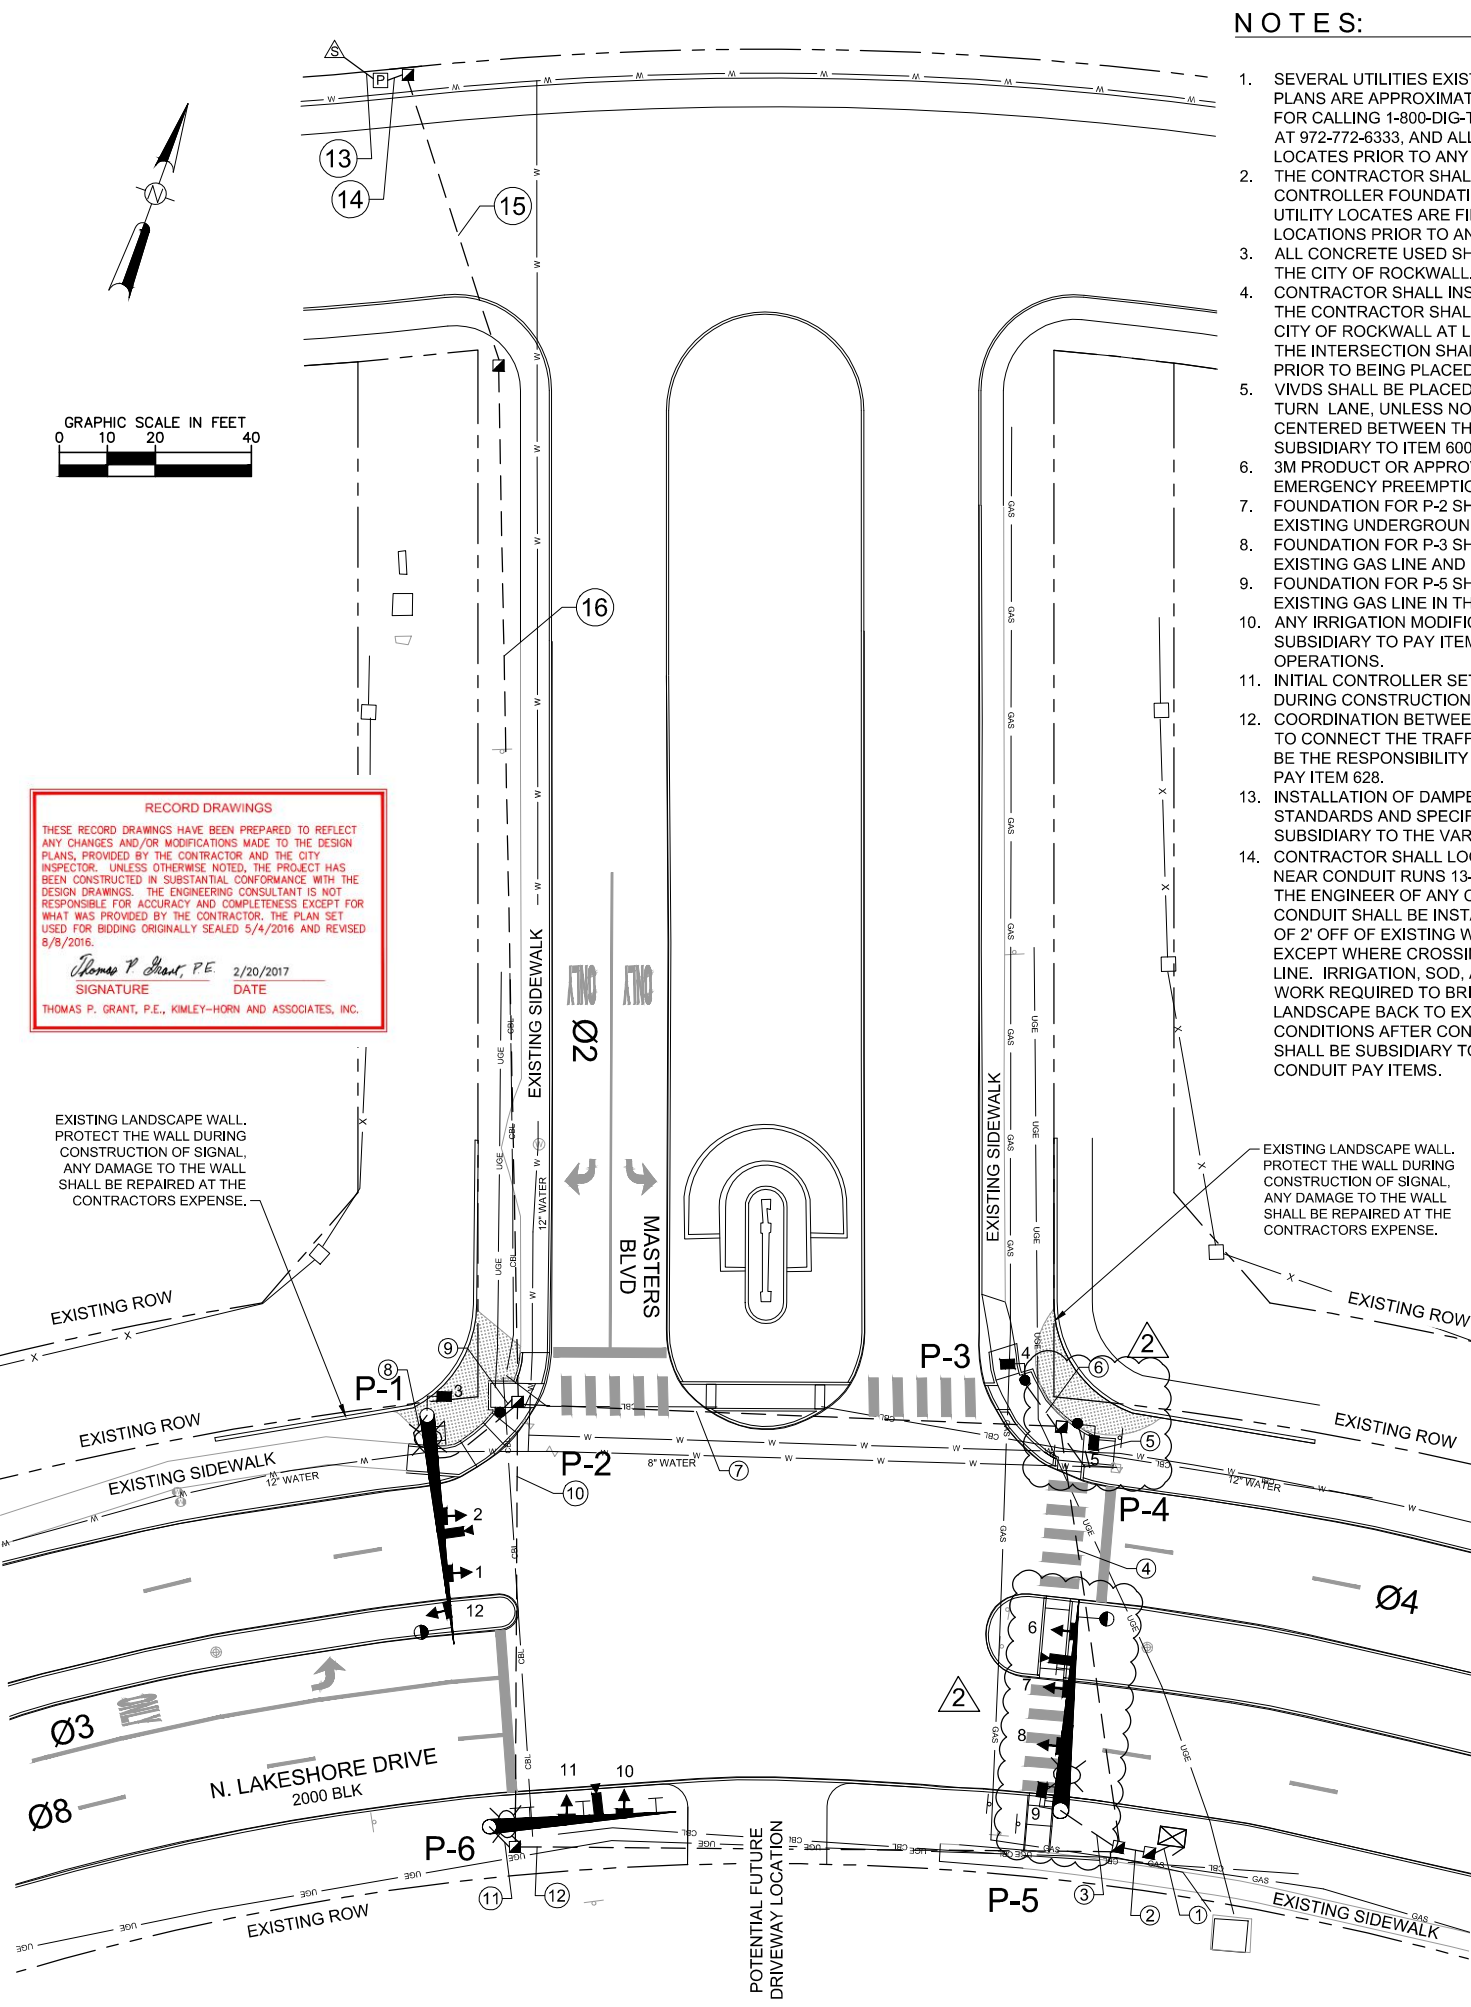

RECORD DRAWINGS
 THESE RECORD DRAWINGS HAVE BEEN PREPARED TO REFLECT ANY CHANGES AND/OR MODIFICATIONS MADE TO THE DESIGN PLANS, PROVIDED BY THE CONTRACTOR AND THE CITY INSPECTOR. UNLESS OTHERWISE NOTED, THE PROJECT HAS BEEN CONSTRUCTED IN SUBSTANTIAL CONFORMANCE WITH THE DESIGN DRAWINGS. THE ENGINEERING CONSULTANT IS NOT RESPONSIBLE FOR ACCURACY AND COMPLETENESS EXCEPT FOR WHAT WAS PROVIDED BY THE CONTRACTOR. THE PLAN SET USED FOR BIDDING ORIGINALLY SEALED 5/4/2016 AND REVISED 8/8/2016.
 Thomas P. Grant, P.E. 2/20/2017
 SIGNATURE DATE
 THOMAS P. GRANT, P.E., KIMLEY-HORN AND ASSOCIATES, INC.

EXISTING LANDSCAPE WALL. PROTECT THE WALL DURING CONSTRUCTION OF SIGNAL. ANY DAMAGE TO THE WALL SHALL BE REPAIRED AT THE CONTRACTORS EXPENSE.


NOTES:

- SEVERAL UTILITIES EXIST IN THE AREA AND ALL UTILITIES SHOWN ON THE PLANS ARE APPROXIMATE. THE CONTRACTOR SHALL BE RESPONSIBLE FOR CALLING 1-800-DIG-TESS, BILLY CHAFFIN AT THE CITY OF ROCKWALL AT 972-772-6333, AND ALL AFFECTED UTILITY COMPANIES FOR UTILITY LOCATES PRIOR TO ANY DRILLING OR EXCAVATION ON THE PROJECT.
- THE CONTRACTOR SHALL STAKE ALL SIGNAL POLE LOCATIONS, CONTROLLER FOUNDATION LOCATION, AND PULL-BOX LOCATIONS AFTER UTILITY LOCATES ARE FINALIZED. THE CITY MUST APPROVE THESE LOCATIONS PRIOR TO ANY DRILLING OR EXCAVATION ON THE PROJECT.
- ALL CONCRETE USED SHALL BE SULFATE RESISTANT AND APPROVED BY THE CITY OF ROCKWALL.
- CONTRACTOR SHALL INSTALL LUMINAIRE FIXTURES WITH LED FIXTURES. THE CONTRACTOR SHALL NOTIFY BILLY CHAFFIN AT 942-772-6333 AT THE CITY OF ROCKWALL AT LEAST 48 HOURS PRIOR TO THE SIGNAL TURN-ON. THE INTERSECTION SHALL REMAIN IN 3-WAY FLASH FOR AT LEAST 3 DAYS PRIOR TO BEING PLACED IN STOP-AND-GO OPERATION.
- VIVDS SHALL BE PLACED ON LANE LINE BETWEEN THROUGH AND LEFT TURN LANE, UNLESS NO TURN LANE IS PRESENT, THEN IT SHALL BE CENTERED BETWEEN THE THRU LANES. THIS WORK IS CONSIDERED SUBSIDIARY TO ITEM 6002.
- 3M PRODUCT OR APPROVED EQUAL SHALL BE USED FOR OPTICOM EMERGENCY PREEMPTION.
- FOUNDATION FOR P-2 SHALL BE HAND-DUG TO LOCATE AND AVOID EXISTING UNDERGROUND COMMUNICATION LINES IN THE AREA.
- FOUNDATION FOR P-3 SHALL BE HAND-DUG TO LOCATE AND AVOID EXISTING GAS LINE AND POWER LINE IN THE AREA.
- FOUNDATION FOR P-5 SHALL BE HAND-DUG TO LOCATE AND AVOID EXISTING GAS LINE IN THE AREA.
- ANY IRRIGATION MODIFICATIONS REQUIRED SHALL BE PERFORMED SUBSIDIARY TO PAY ITEM TS 69 TO MAINTAIN CURRENT IRRIGATION OPERATIONS.
- INITIAL CONTROLLER SETTINGS SHALL BE PROVIDED BY THE ENGINEER DURING CONSTRUCTION.
- COORDINATION BETWEEN THE CONTRACTOR AND THE POWER PROVIDER TO CONNECT THE TRAFFIC SIGNAL TO THE ELECTRICAL SERVICE SHALL BE THE RESPONSIBILITY OF THE CONTRACTOR AND IS SUBSIDIARY TO PAY ITEM 628.
- INSTALLATION OF DAMPENERS ON MAST ARMS SHALL FOLLOW TXDOT STANDARDS AND SPECIFICATIONS FOR MOUNTING, AND SHALL BE SUBSIDIARY TO THE VARIOUS 686 PAY ITEMS.
- CONTRACTOR SHALL LOCATE ALL UTILITIES NEAR CONDUIT RUNS 13-16 AND INFORM THE ENGINEER OF ANY CONFLICTS. CONDUIT SHALL BE INSTALLED A MINIMUM OF 2' OFF OF EXISTING WATER LINES EXCEPT WHERE CROSSING THE WATER LINE. IRRIGATION, SOD, AND ANY OTHER WORK REQUIRED TO BRING THE LANDSCAPE BACK TO EXISTING CONDITIONS AFTER CONDUIT IS INSTALLED SHALL BE SUBSIDIARY TO THE VARIOUS CONDUIT PAY ITEMS.


EXISTING LANDSCAPE WALL. PROTECT THE WALL DURING CONSTRUCTION OF SIGNAL. ANY DAMAGE TO THE WALL SHALL BE REPAIRED AT THE CONTRACTORS EXPENSE.

LEGEND:

- PROPOSED STEEL POLE & MAST ARM
- PROPOSED SIGNAL HEAD & NUMBER
- PEDESTRIAN SIGNAL & NUMBER
- PROPOSED TYPE C GROUND BOX WITH APRON
- PROPOSED CONTROLLER CABINET AND FOUNDATION
- PROPOSED PEDESTAL SERVICE
- EXISTING ELECTRIC SERVICE
- CONDUIT RUN NUMBER
- PHASE NUMBER
- POLE NUMBER
- RIGHT OF WAY
- PROPOSED OPTICOM DETECTOR
- PROPOSED VIDEO DETECTION CAMERA
- PROPOSED LUMINAIRE (LED)
- EXISTING GROUND MT. SIGN
- TRAFFIC SIGN
- ILSN SIGN
- FIRE HYDRANT
- PROPOSED CONDUIT RUN
- WOOD POLE (PP=POWER POLE)

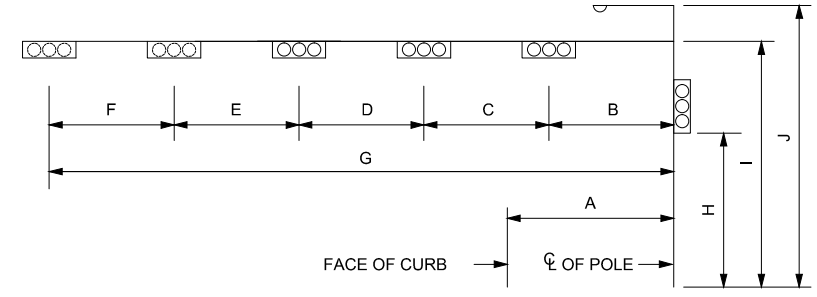


PHASING SEQUENCE

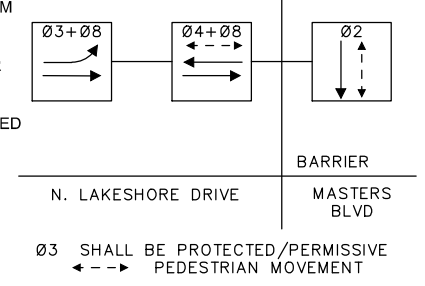

ITEM 624 GROUND BOX SUMMARY

TYPE	STATUS	EACH
C W/ APRON	INSTALL	7

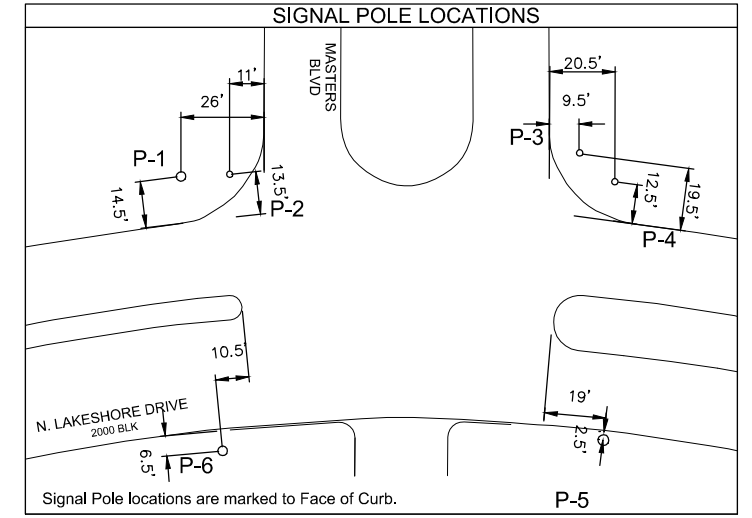

SIGNAL HEAD AND POLE PLACEMENT (FT)


POLE NUMBER	STATUS	A	B	C	D	E	F	G	H	I	J	NO. OF HEADS	8' LUM ARM	FND. TYPE	FND. DEPTH (FT)
P-1	I	14.5'	21'	12'	7.5'	-	-	48'	10	19	30	3	1	36-A	13
P-2	I	PUSH BUTTON STATION										-	-	24-A	4
P-3	I	PEDESTAL POLE										-	-	24-A	6
P-4	I	PEDESTAL POLE										-	-	24-A	6
P-5	I	7'	13.5'	12'	12'	-	-	44'	10	19	30	3	1	36-A	13
P-6	I	6.5'	16'	12'	-	-	-	40'	-	19	30	2	1	36-A	13

ALL SIGNAL POLE FOUNDATIONS SHALL BE PAID FOR BY THE VARIOUS DRILLED SHAFT PAY ITEMS

ITEM 682 SIGNAL HEADS WITH LED LAMPS

SIGNAL HEAD NO.	STATUS	SIGNAL HEAD TYPE	12" SIGNAL INDICATION			LOUVER	VEH SIG SEC(EA)	PED SIG SEC(EA)
			BACKPLATE					
			3 SEC(EA)	4 SEC(EA)	5 SEC(EA)			
1,2,7,8,10,11,12	I	H3	7			21		
6	I	H4FYA		1		4		
3,4,5,9	I	PED					4	
TOTAL INSTALL			7	1		25	4	

BACKPLATES SHALL BE BLACK AND VENTED ALUMINUM
I = INSTALL

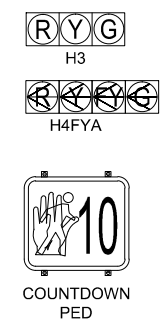

Kimley >>> Horn

2201 WEST ROYAL LANE, SUITE 275, IRVING, TX 75063
 PHONE: 214-420-6600
 WWW.KIMLEY-HORN.COM
 © 2017 KIMLEY-HORN AND ASSOCIATES, INC.
 Texas Registered Engineering Firm # F-528

NO.	REVISIONS	DATE	BY
1	SIGNAGE AND ELECT SERVICE	8/8/16	LS
2	RECORD DRAWINGS	2/20/2017	TG

CITY OF ROCKWALL
TRAFFIC SIGNAL PERMANENT TRAFFIC SIGNAL LAYOUT

KHA PROJECT: 064420914
 DATE: FEBRUARY 20, 2017
 SCALE: AS SHOWN
 DESIGNED BY: LAS
 DRAWN BY: SMR/JWR
 CHECKED BY: TPG


SHEET NUMBER
6

CIP NO. 2015-15

Plotted By: yehorovich, Brendan - Sheet Set: ### - Layout: SUMMARY CHARTS - February 20, 2017 11:31:06am - K:\LAC-IP\TO\Project\064420914-lakeshore signal design_rckwall\CAD\plan\summary\SUMMARY CHARTS.dwg
 This document, together with the concepts and designs presented herein, is intended only for the specific purpose and client for which it was prepared. Reuse of any information contained herein without written authorization and adaptation by Kimley-Horn and Associates, Inc. shall be without liability to Kimley-Horn and Associates, Inc.

SUMMARY OF CONDUIT AND CABLES																			
RUN NUMBER	CONDUIT STATUS	ITEM 618 SIZE/TYPE CONDUIT (FT) SCHEDULE 40						ITEM 620 ELECTRICAL CONDUCTORS				VIVDS COAXIAL CABLE	OPTICOM CABLE	ITEM 684 ELECTRICAL CONDUCTORS			LENGTH OF RUN	RUN NUMBER	
		2" PVC (TRENCH)	2" PVC (BORE)	3" PVC (TRENCH)	3" PVC (BORE)	4" PVC (TRENCH)	4" PVC (BORE)	CABLE STATUS	NO. 4 XHHW WIRE	NO. 6 BARE WIRE	NO. 8 XHHW WIRE (LUM)			NO. 8 XHHW WIRE (ILSN)	2 COND. #12 AWG	10 COND. #14 AWG			20 COND. #14 AWG
1A	I					10	I					1			4	2	3	10	1A
1B	I					10	I					2	2					10	1B
1C	I	10					I	3										10	1C
1D	I	10					I											10	1D
2A	I					10	I					1			4	2	3	10	2A
2B	I					10	I					2	2					10	2B
2C	I	10					I											10	2C
2D	I	10					I	3										10	2D
3	I			15			I		1	2	2	1	1	1		1	15	3	
4A	I					20	I					1	1		3	2	1	90	4A
4B	I	20	65				I					1	1					90	4B
5	I			10			I								1	1		10	5
6	I			25			I								1	1		25	6
7A	I					20	I	105				1	1	1			1	115	7A
7B	I	20	105				I					1	1					115	7B
8	I			35			I			4	4	1	1				1	35	8
9	I			10			I							1				10	9
10A	I					20	I	75				1						95	10A
10B	I	20	75				I					1						95	10B
10C	I	20	75				I	3	1	2	2							95	10C
11	I			10			I			4	4	1					1	10	11
12A	I					110	I	20				2	2	1			1	130	12A
12B	I	110	20				I					3	1					130	12B
12C	I	110	20				I			3	1							130	12C
13	I	15					I	3										15	13
14	I	10					I	3	1	2	2							10	14
15	I			60			I	3	1	2	2							60	15
16	I	220					I	3	1	2	2							220	16
CABLE TOTALS (LF)								1714	1,656	1,272	1,272	520	328	584	285	524			

- NOTES:
- STATUS IS "I" INSTALL OR "E" EXISTING OR "F" FUTURE
 - WIRE QUANTITIES IN THE ABOVE TABLES ARE INCREASED 8' PER RUN FOR CONDUIT AND 8' PER RUN TO ACCOUNT FOR STUB UP REQUIREMENTS AND TO PROVIDE 2' SPARE CABLE AT EACH END
 - OPTICOM AND VIVDS WIRING IS SUPPLIED AND INSTALLED BY THE CONTRACTOR.

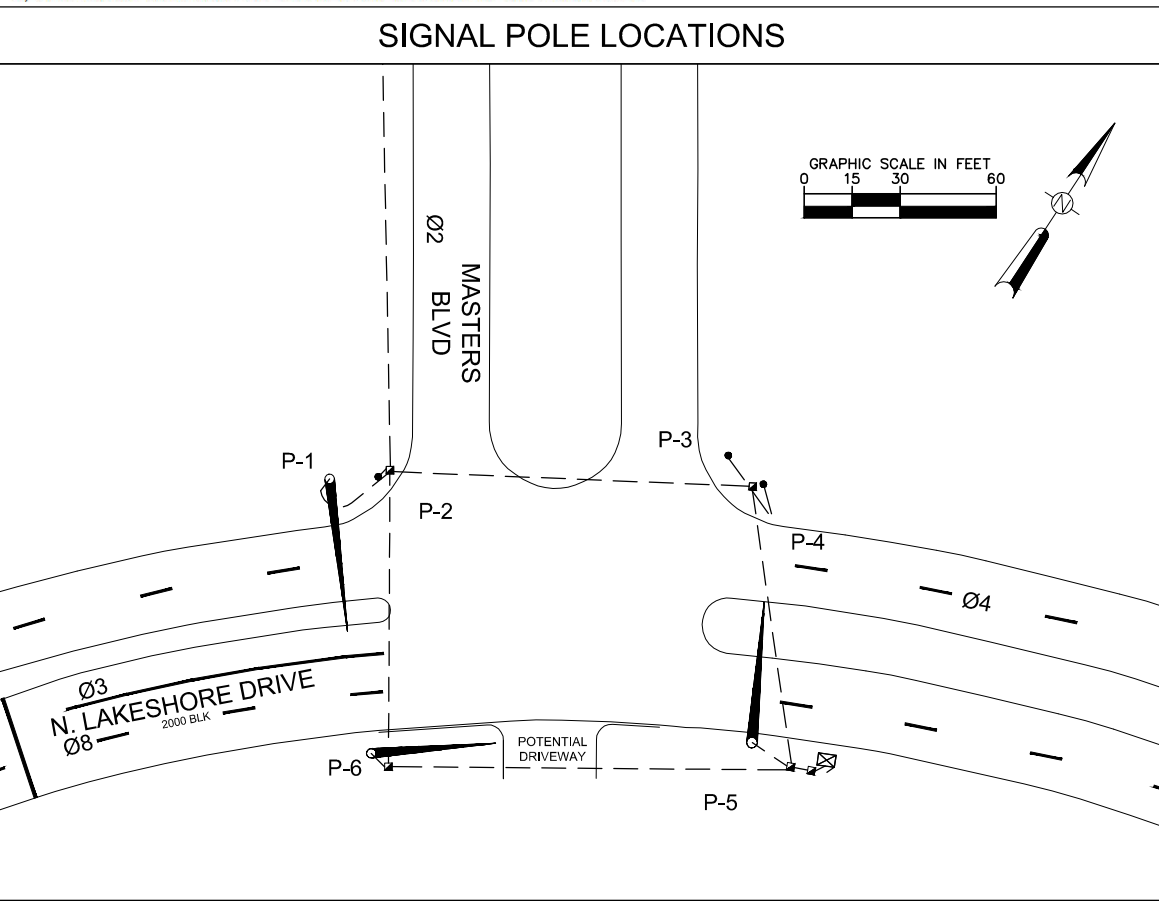

RECORD DRAWINGS
 THESE RECORD DRAWINGS HAVE BEEN PREPARED TO REFLECT ANY CHANGES AND/OR MODIFICATIONS MADE TO THE DESIGN PLANS, PROVIDED BY THE CONTRACTOR AND THE CITY INSPECTOR. UNLESS OTHERWISE NOTED, THE PROJECT HAS BEEN CONSTRUCTED IN SUBSTANTIAL CONFORMANCE WITH THE DESIGN DRAWINGS. THE ENGINEERING CONSULTANT IS NOT RESPONSIBLE FOR ACCURACY AND COMPLETENESS EXCEPT FOR WHAT WAS PROVIDED BY THE CONTRACTOR. THE PLAN SET USED FOR BIDDING ORIGINALLY SEALED 5/4/2016 AND REVISED 8/8/2016.
Thomas P. Grant, P.E. 2/20/2017
 SIGNATURE DATE
 THOMAS P. GRANT, P.E., KIMLEY-HORN AND ASSOCIATES, INC.

CONDUIT LENGTHS ADJUSTED TO MATCH ADJUSTED GROUND BOX LOCATION. NO FINAL QUANTITIES HAVE BEEN ADJUSTED.

CABLE TERMINATION CHART						
CNDR COLOR	CABLE 1 FROM P-1 TO CNTRL 20 CNDR	CABLE 2 FROM P-3 TO CNTRL 10 CNDR	CABLE 3 FROM P-4 TO CNTRL 10 CNDR	CABLE 4 FROM P-5 TO CNTRL 20 CNDR	CABLE 5 FROM P-6 TO CNTRL 20 CNDR	
1	BLACK	SPARE	SPARE	SPARE	SH 6 ←Y	SPARE
2	WHITE	S. COMMON	S. COMMON	S. COMMON	S. COMMON	S. COMMON
3	RED	SH 1,2 R	SPARE	SPARE	SH 7,8 R	SH 10,11 R
4	GREEN	SH 1,2 G	SPARE	SPARE	SH 7,8 G	SH 10,11 G
5	ORANGE	SH 1,2 Y	SPARE	SPARE	SH 7,8 Y	SH 10,11 Y
6	BLUE	SPARE	SH 4 DW	SPARE	SH 6 ←G	SPARE
7	WHITE/ BLACK	SPARE	SH 4 W	SPARE	SPARE	SPARE
8	RED/ BLACK	SPARE	SPARE	SH 5 DW	SH 9 DW	SPARE
9	GREEN/ BLACK	SPARE	SPARE	SH 5 W	SH 9 W	SPARE
10	ORANGE/ BLACK	SPARE	SPARE	SPARE	SPARE	SPARE
11	BLUE/BLACK	SPARE			SPARE	SPARE
12	BLACK/WHITE	SPARE			SPARE	SPARE
13	RED/WHITE	SPARE			SH 6 ←R	SPARE
14	GREEN/WHITE	SH 3 W			SPARE	SPARE
15	BLUE/WHITE	SH 4 DW			SPARE	SPARE
16	BLACK/RED	SH 12 Y			SPARE	SPARE
17	WHITE/RED	SPARE			SPARE	SPARE
18	ORANGE/RED	SPARE			SH 6 ←FY	SPARE
19	BLUE/RED	SH 12 G			SPARE	SPARE
20	RED/GREEN	SH 12 R			SPARE	SPARE

NOTE: 2 CONDUCTOR 12 AWG TO BE RUN TO EACH APS PUSH BUTTON STATION
 NOTE: POLE P-2 NOT SHOWN ON CHART, POLE P-2 ONLY HAS 2 CONDUCTOR INSIDE IT FOR THE PUSH BUTTON

ELECTRICAL SERVICE DATA									
ELECTRICAL SERVICE	ELECTRICAL SERVICE DESCRIPTION SEE ED(4)	SERVICE CONDUIT SIZE (RMC)	SERVICE CONDUCTORS NO./SIZE	MAIN DISCONNECT CKT. BKR. POLE/AMP	TWO-POLE CONTACT AMPS	PANELBD/LOADCENTER AMP RATING (MIN.)	CIRCUIT NO.	BRANCH CKT. BRK. POLE/AMPS	KVA LOAD
1	TY D (120/240) 060 (NS) AL (E) PS (U)	2"	3/#4	2P/60	30	100	T.S LUM ILSN	1P/50 2P/15 2P/15	<9.4

CABLE/WIRE INSIDE POLE (FT)						
POLE NUMBER	ITEM 620		ITEM 684 TY-A CABLE		VIVDS CABLE	OPTICOM CABLE
	NO. 12 XHHW	5 CNDR 14 AWG	7 CNDR 14 AWG	2 CNDR 12 AWG		
P-1	150	180			50	45
P-2					5	
P-3		10			5	
P-4		10			5	
P-5	150	100	65		60	45
P-6	150	95			50	
TOTALS	450	395	65	20	160	90

2 CNDR 12 AWG TO BE RUN TO EACH APS PUSH BUTTON STATION

CONDUIT TOTALS (LF)	
2" TRENCH	585
2" BORE	420
3" TRENCH	105
3" BORE	0
4" TRENCH	210
4" BORE	265

PEDESTRIAN DETAILS			
PED INDICATION	LOCATION	STATUS	APS UNITS (EA)
Ø4	P-2, P-3	INSTALL	2
Ø2	P-4, P-5	INSTALL	2
TOTAL			4

KHA PROJECT 064420914
 DATE FEBRUARY 20, 2017
 SCALE AS SHOWN
 DESIGNED BY LAS
 DRAWN BY SMR/JWR
 CHECKED BY TPG

2201 WEST ROYAL LANE, SUITE 275, IRVING, TX 75063
 PHONE: 214-420-6600
 WWW.KIMLEY-HORN.COM
 © 2017 KIMLEY-HORN AND ASSOCIATES, INC.
 Texas Registered Engineering Firm # F-528

REVISIONS
 1 SIGNAGE AND ELECT SERVICE
 2 RECORD DRAWINGS

CIP NO. 2015-15

CITY OF ROCKWALL LAKESHORE AT MASTERS

TRAFFIC SIGNAL SUMMARY CHARTS


SHEET NUMBER

7


Plotted By: yborrough, Brendan, Sheet Set: ##, Layout: SIGNS LAYOUT, February 20, 2017, 10:46:39am, K:\LAC\TPO\Project\064420914\Ireshore_align_design_rockwall\CAD\plan\signs\LA YOU.T.dwg
 This document, together with the concepts and designs presented herein, is intended only for the specific purpose and client for which it was prepared. Reuse of any improper reliance on this document without written authorization and adaptation by Kimley-Horn and Associates, Inc. shall be without liability to Kimley-Horn and Associates, Inc.

LEGEND:


	PROPOSED STEEL POLE & MAST ARM		PEDESTRIAN SIGNAL
	PROPOSED SIGNAL HEAD		OPTICOM DETECTOR
P-2	POLE NUMBER		VIDEO DETECTION CAMERA
---	RIGHT OF WAY		EXISTING GROUND MT. SIGN
AT	TRAFFIC SIGN & DESIGNATION		PROPOSED GROUND MT. SIGN
T	ILSN SIGN		PROPOSED LUMINAIRE (LED)
T	TRAFFIC SIGN		

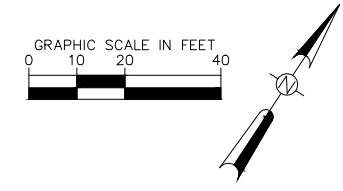

RECORD DRAWINGS
 THESE RECORD DRAWINGS HAVE BEEN PREPARED TO REFLECT ANY CHANGES AND/OR MODIFICATIONS MADE TO THE DESIGN PLANS PROVIDED BY THE CONTRACTOR AND THE CITY INSPECTOR. UNLESS OTHERWISE NOTED, THE PROJECT HAS BEEN CONSTRUCTED IN SUBSTANTIAL CONFORMANCE WITH THE DESIGN DRAWINGS. THE ENGINEERING CONSULTANT IS NOT RESPONSIBLE FOR ACCURACY AND COMPLETENESS EXCEPT FOR WHAT WAS PROVIDED BY THE CONTRACTOR. THE PLAN SET USED FOR BIDDING ORIGINALLY SEALED 5/4/2016 AND REVISED 8/8/2016.
 Thomas P. Grant, P.E. 2/20/2017
 SIGNATURE DATE
 THOMAS P. GRANT, P.E., KIMLEY-HORN AND ASSOCIATES, INC.

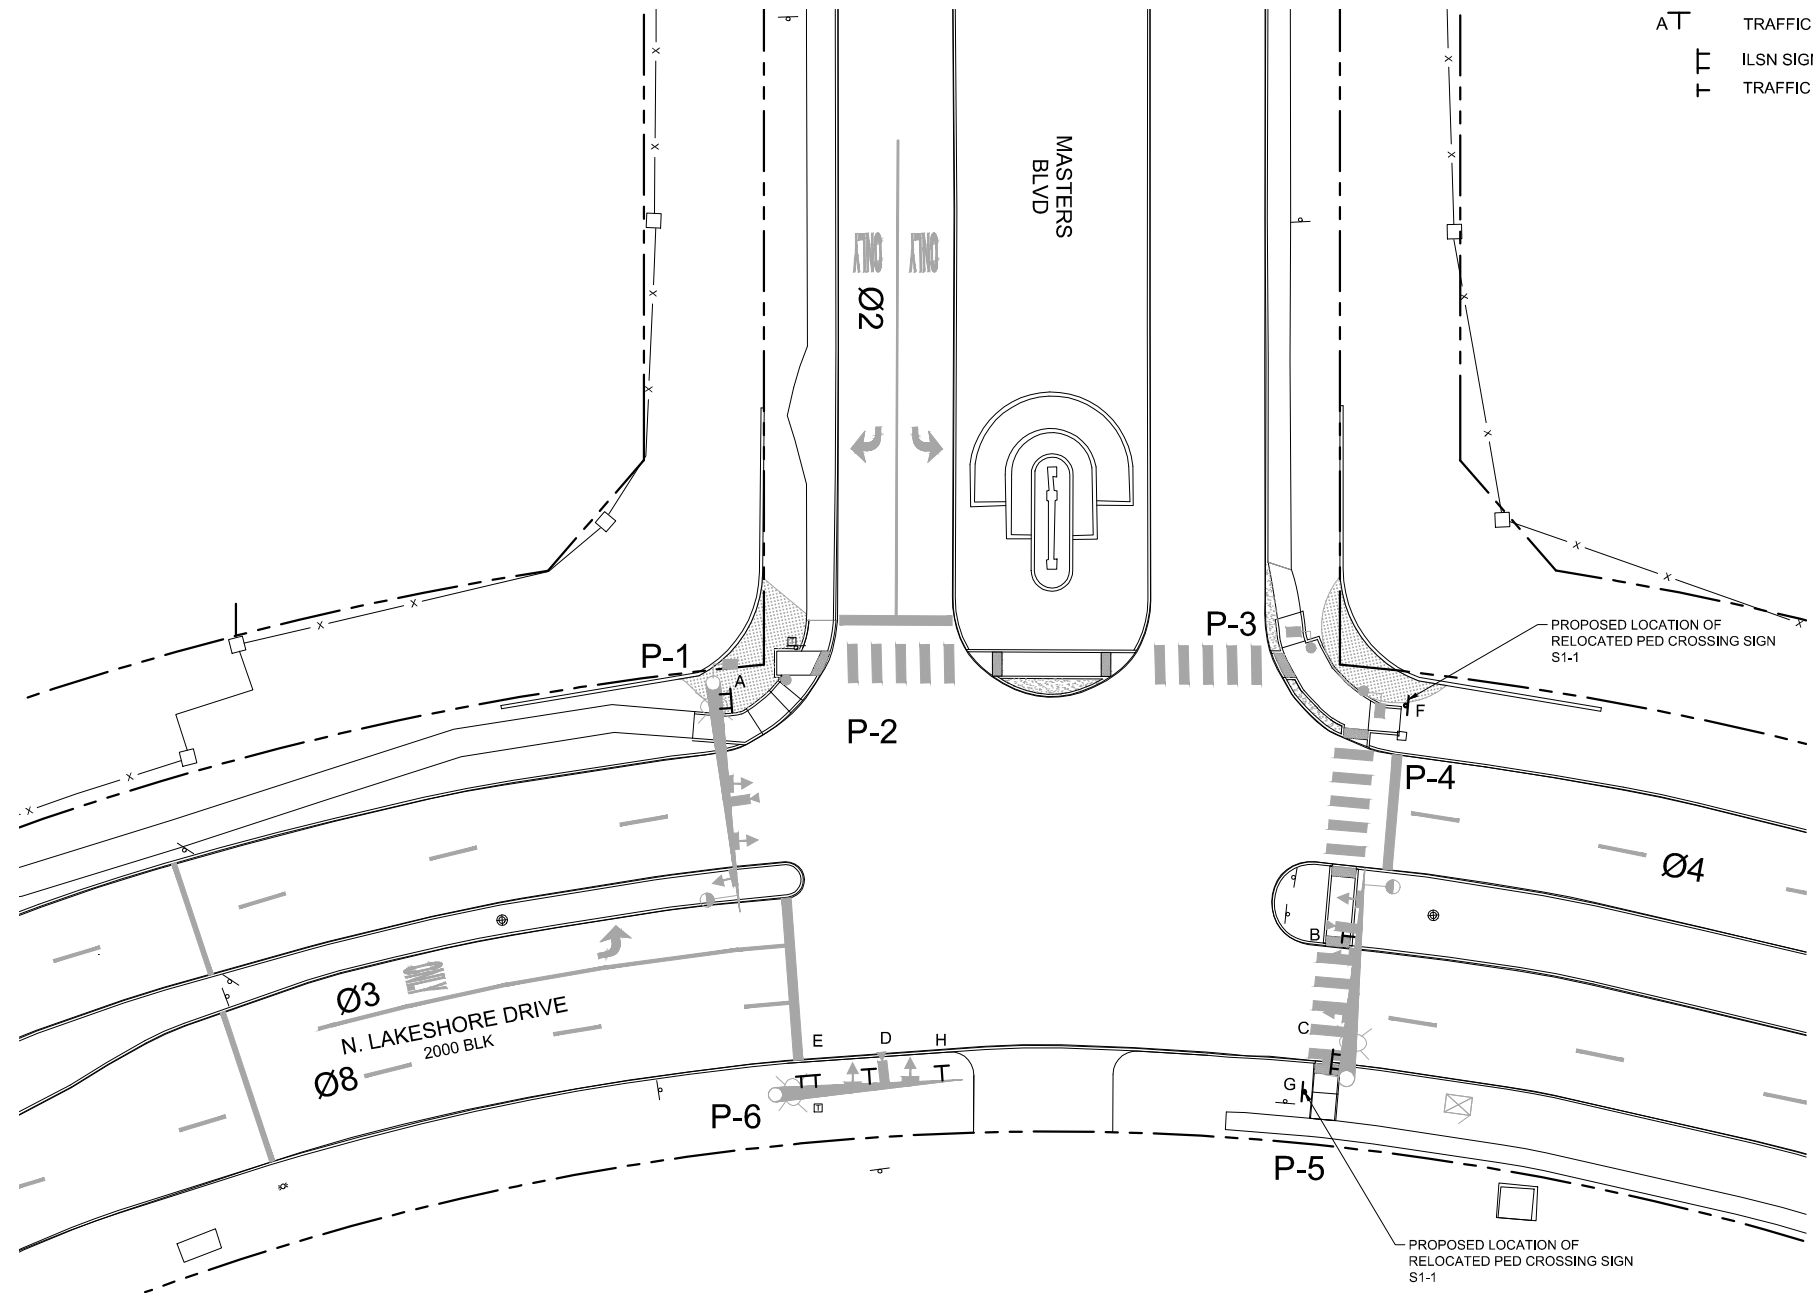

TYPICAL POLE MOUNTED PED PUSH BUTTON SIGNS
 (FURNISHED AND INSTALLED BY CONTRACTOR SUBSIDIARY TO 688 6001)

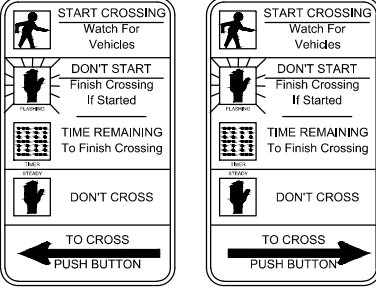

R10-15MOD (L)
(30" x 30")
SIGN "H"



S1-1
(EXISTING)
SIGN "F" & "G"

TRAFFIC SIGNAL SIGNS SUMMARY						
ID	TYPE	LEGEND	REMOVE/RELOCATE QTY.	FURNISH/INSTALL QTY.	STATUS	LOCATION
A	ILSN	STREET NAME (LED)		1	I	P-1 ILSN ARM
B	R10-17T	LEFT TURN ON FYA		1	I	P-5 ARM
C	ILSN	STREET NAME (LED)		1	I	P-5 ILSN ARM
D	R6-2L	LANE ASSIGNMENT SIGN		1	I	P-6 ARM
E	ILSN	STREET NAME (LED)		1	I	P-6 ILSN ARM
F	S1-1	SCHOOL PED CROSSING	1		R/R	GDMT
G	S1-1	SCHOOL PED CROSSING	1		R/R	GDMT
H	R10-15L	TURNING VEHICLES YIELD TO PEDS		1	I	P-6 ARM
INSTALL TOTAL				6		
REMOVE/RELOCATE TOTAL			2			


I - INSTALL R/R = REMOVE AND RELOCATE
 GDMT = GROUND MOUNTED POLE

*CITY TO PROVIDE BLOCK NUMBERS




SIGN "A" & "C" - ILSN*

SIGN "E" - ILSN*

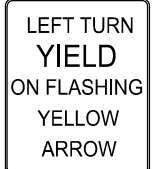

R10-17T
(36" x 42")
SIGN "B"

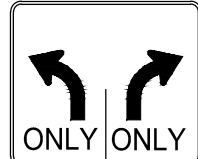

R3-8MOD
(36" x 30")
SIGN "D"

- NOTES:**
- CONTRACTOR SHALL PROVIDE SHOP DRAWINGS FOR LED ILLUMINATED STREET NAME SIGNS PRIOR TO FABRICATION. UPON APPROVAL FROM THE CITY, THE MANUFACTURER MAY CONSTRUCT THE STREET NAME SIGNS

No.	REVISIONS	DATE	BY
1	SIGNAGE AND ELECT SERVICE	8/8/16	LS
2	RECORD DRAWINGS	2/20/2017	TG

Kimley-Horn
 2201 WEST ROYAL LANE, SUITE 275, IRVING, TX 75063
 PHONE: 214-420-6600
 WWW.KIMLEY-HORN.COM
 © 2017 KIMLEY-HORN AND ASSOCIATES, INC.
 Texas Registered Engineering Firm # F-528

KHA PROJECT	064420914
DATE	FEBRUARY 20, 2017
SCALE	AS SHOWN
DESIGNED BY	LAS
DRAWN BY	SMR/JWR
CHECKED BY	TPG

CITY OF ROCKWALL
LAKE SHORE AT MASTERS



TRAFFIC SIGNAL SIGNS LAYOUT

Plotted By: Yehorovich, Brendan - Sheet Set: ### - Layout: STRIPING LAYOUT - February 20, 2017, 10:49:54am - K:\LAC-IT\TO\Project\064420914-Greystone signal design_rctswal\CAD\plan\sheet\STRIPING LAYOUT.dwg
 This document, together with the concepts and designs presented herein, is intended only for the specific purpose and client for which it was prepared. Release of any improper reliance on this document without written authorization and adaptation by Kimley-Horn and Associates, Inc. shall be without liability to Kimley-Horn and Associates, Inc.

RECORD DRAWINGS


THESE RECORD DRAWINGS HAVE BEEN PREPARED TO REFLECT ANY CHANGES AND/OR MODIFICATIONS MADE TO THE DESIGN PLANS, PROVIDED BY THE CONTRACTOR AND THE CITY INSPECTOR. UNLESS OTHERWISE NOTED, THE PROJECT HAS BEEN CONSTRUCTED IN SUBSTANTIAL CONFORMANCE WITH THE DESIGN DRAWINGS. THE ENGINEERING CONSULTANT IS NOT RESPONSIBLE FOR ACCURACY AND COMPLETENESS EXCEPT FOR WHAT WAS PROVIDED BY THE CONTRACTOR. THE PLAN SET USED FOR BIDDING ORIGINALLY SEALED 5/4/2016 AND REVISED 8/8/2016.

Thomas P. Grant, P.E. 2/20/2017
 SIGNATURE DATE
 THOMAS P. GRANT, P.E., KIMLEY-HORN AND ASSOCIATES, INC.






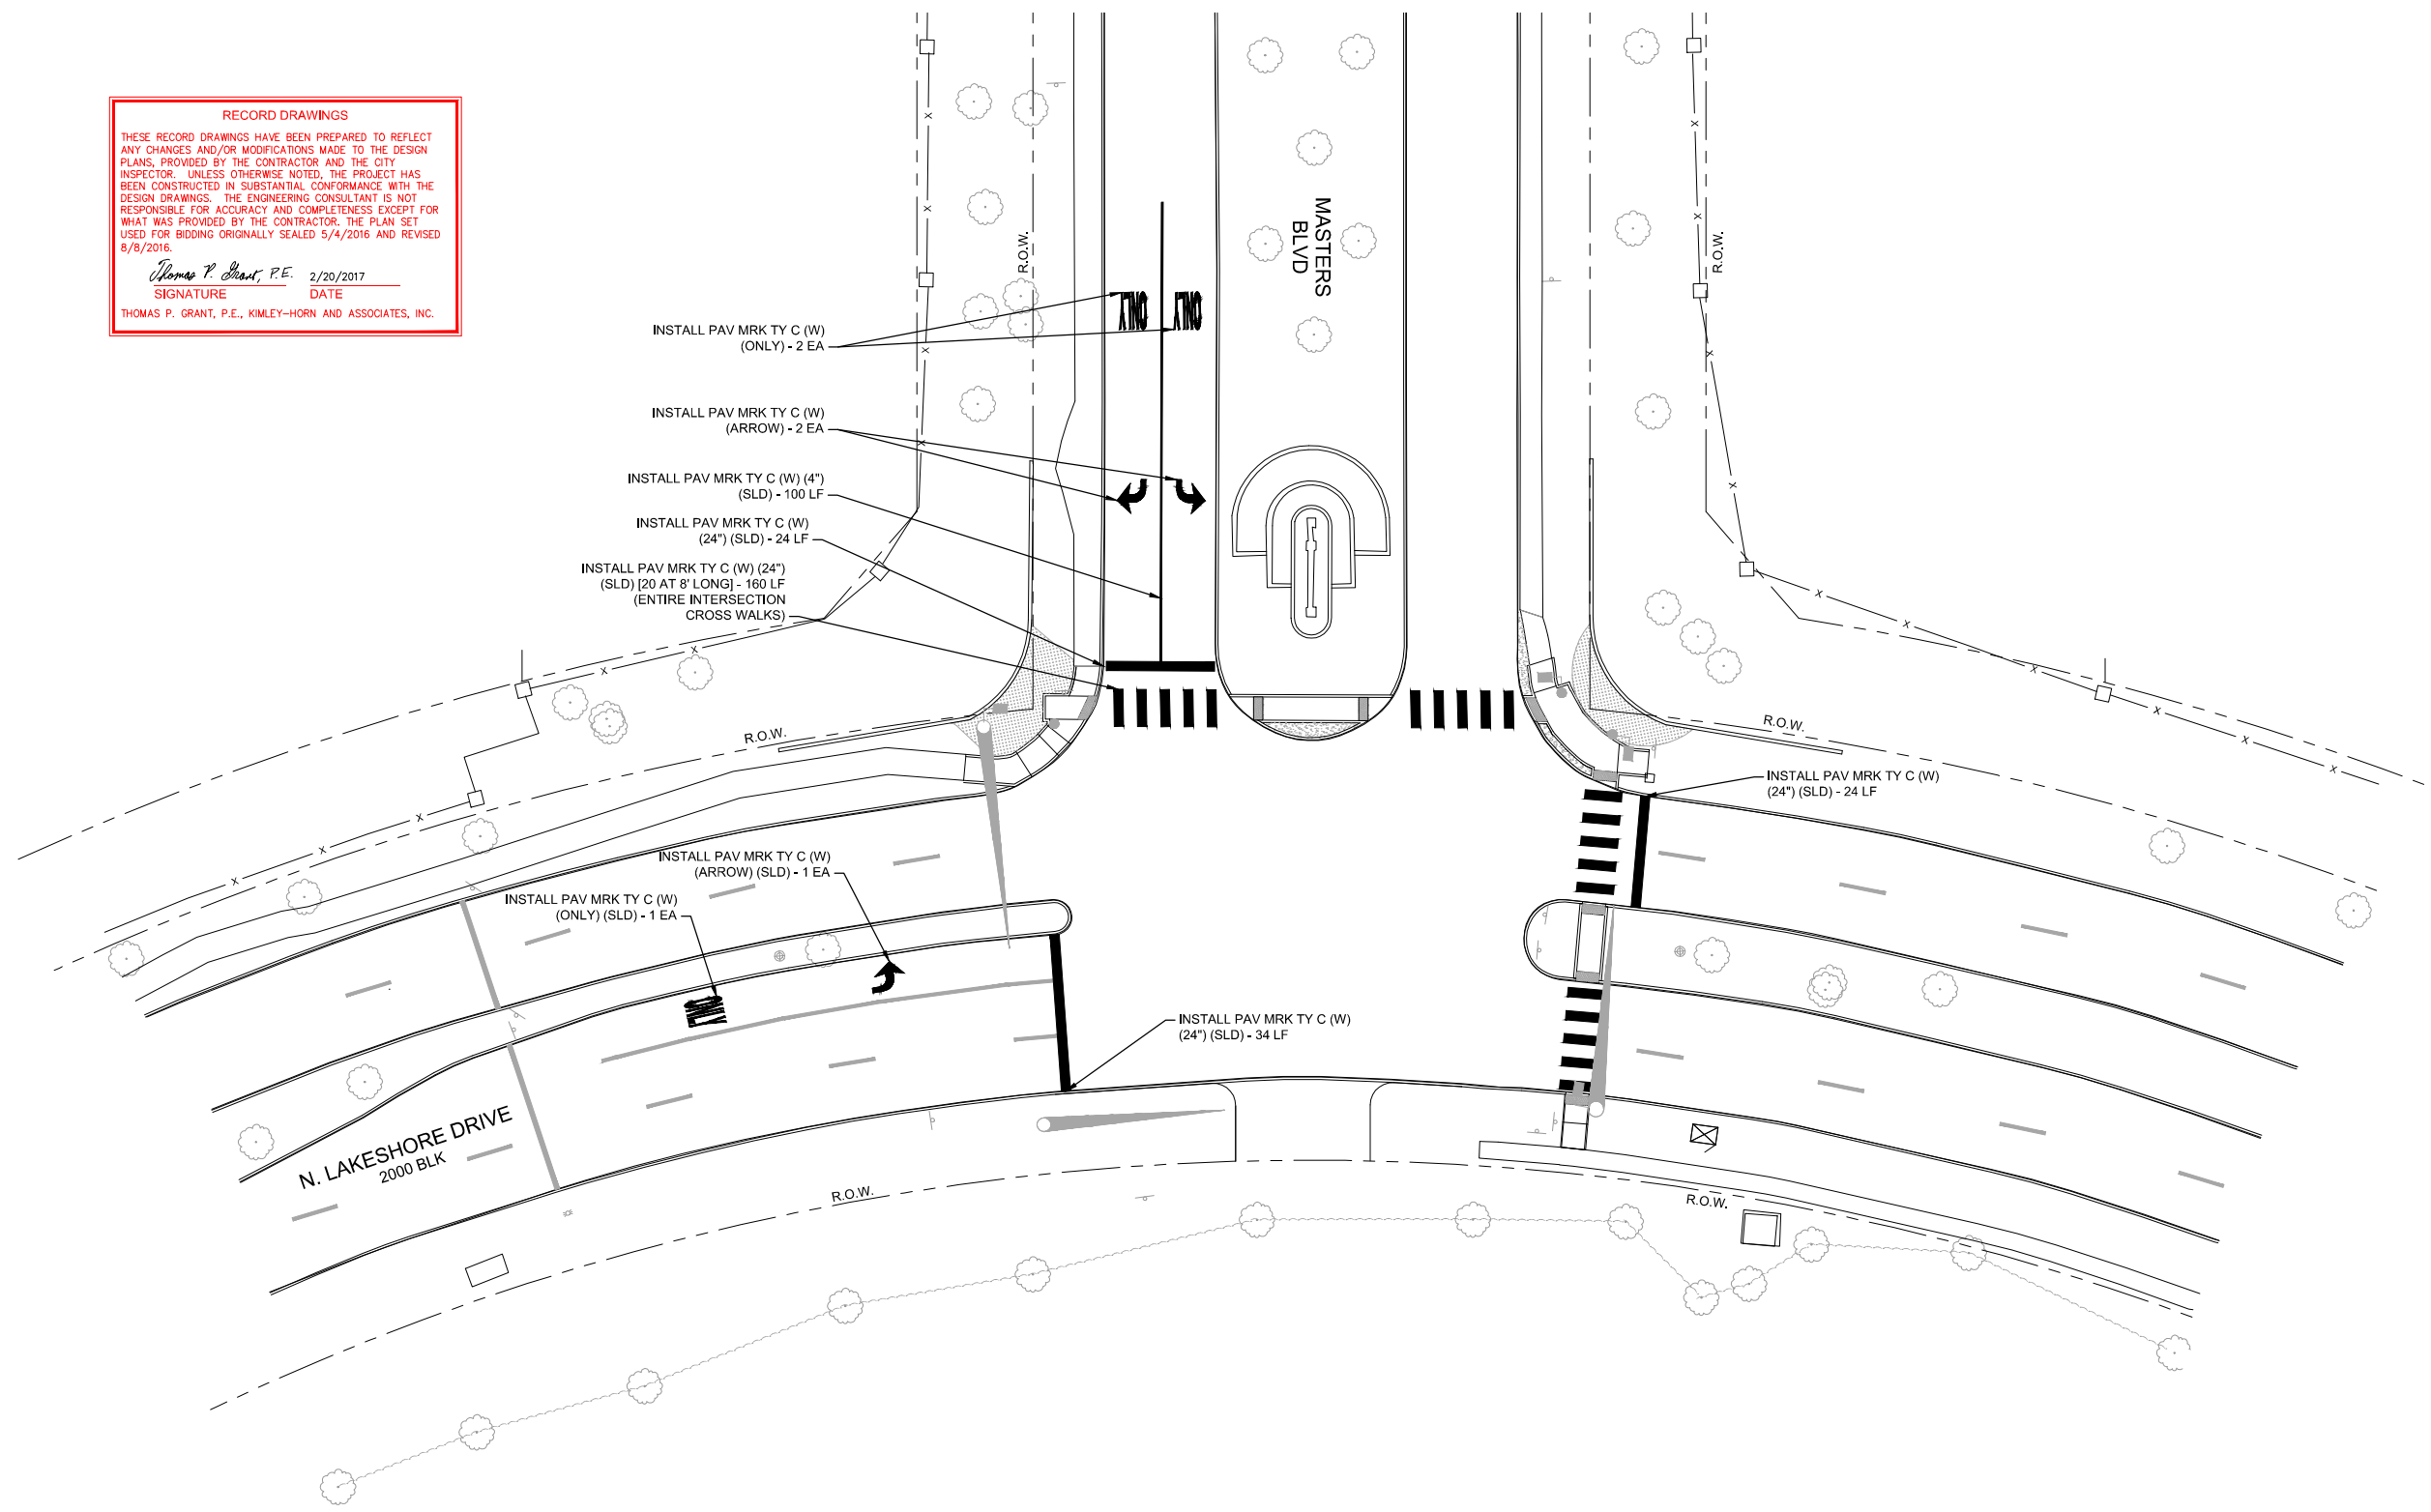
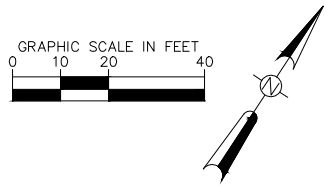


KHA PROJECT 064420914	DATE FEBRUARY 20, 2017	SCALE AS SHOWN	DESIGNED BY LAS	DRAWN BY SMR/JWR	CHECKED BY TPG
CITY OF ROCKWALL LAKESHORE AT MASTERS					
TRAFFIC SIGNAL STRIPING LAYOUT					
SHEET NUMBER 9					
No. 2	REVISIONS RECORD DRAWINGS	DATE 2/20/2017	BY TG		
 2201 WEST ROYAL LANE, SUITE 275, IRVING, TX 75063 PHONE: 214-420-6600 WWW.KIMLEY-HORN.COM © 2017 KIMLEY-HORN AND ASSOCIATES, INC. Texas Registered Engineering Firm # F-528					
CIP NO. 2015-15					

Plotted By: yehorovich, Brendan - Sheet Set: ### Layout: PAVING LAYOUT - February 20, 2017 11:31:24am. K:\AC-IT\TPO\Project\06442014-Irving\signal\design_rockwall\CAD\plan\sheet\PAVING LAYOUT.dwg
 This document, together with the concepts and designs presented herein, is an instrument of service, is intended only for the specific purpose and client for which it was prepared. Reuse of any improper, reliance on this document without written authorization and adaptation by Kimley-Horn and Associates, Inc. shall be without liability to Kimley-Horn and Associates, Inc.

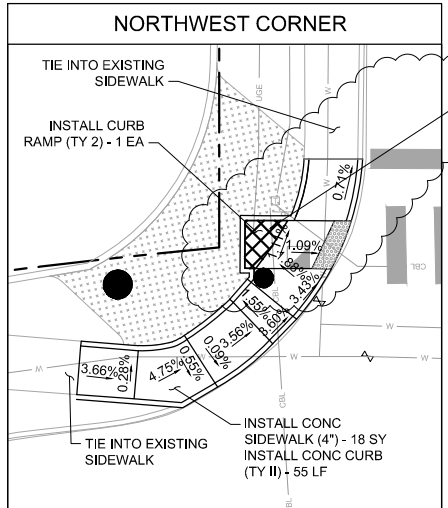

LANDING TO BE BUILT BY CITY FORCES AT A LATER DATE

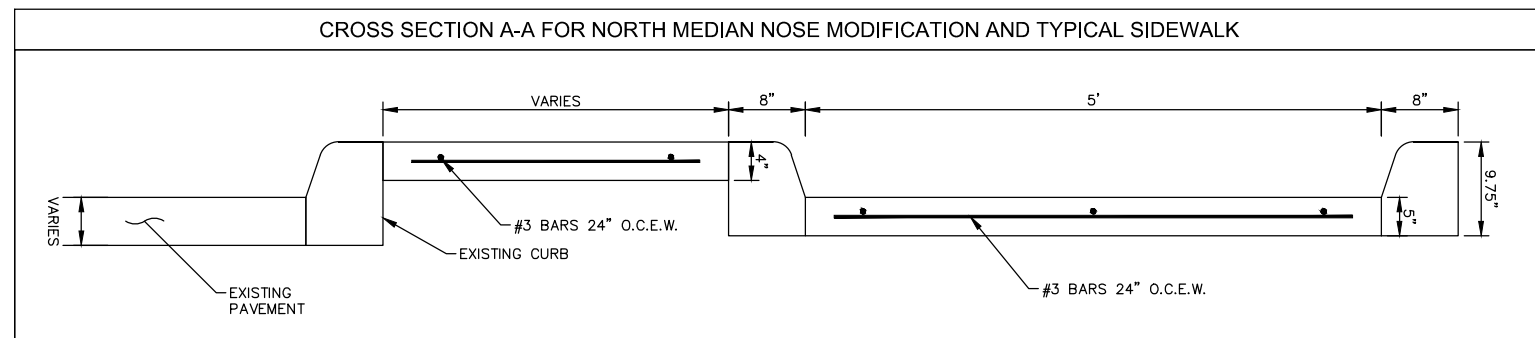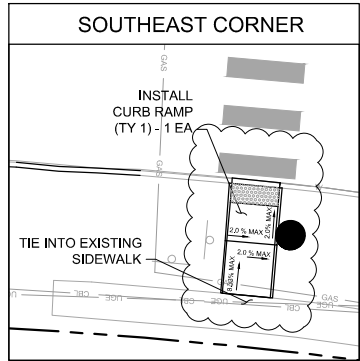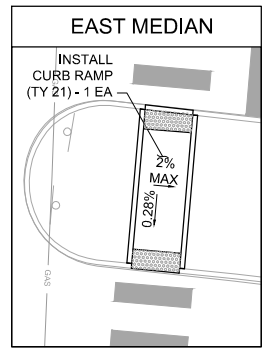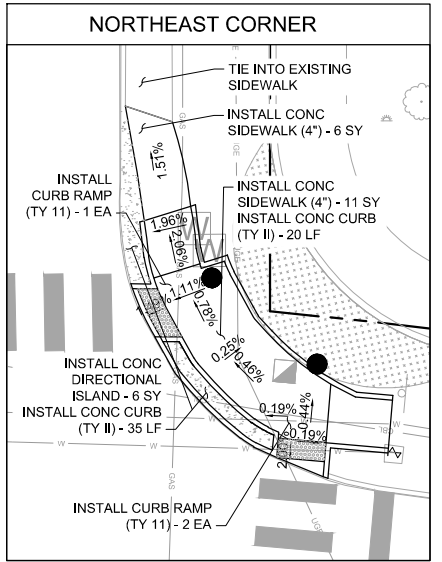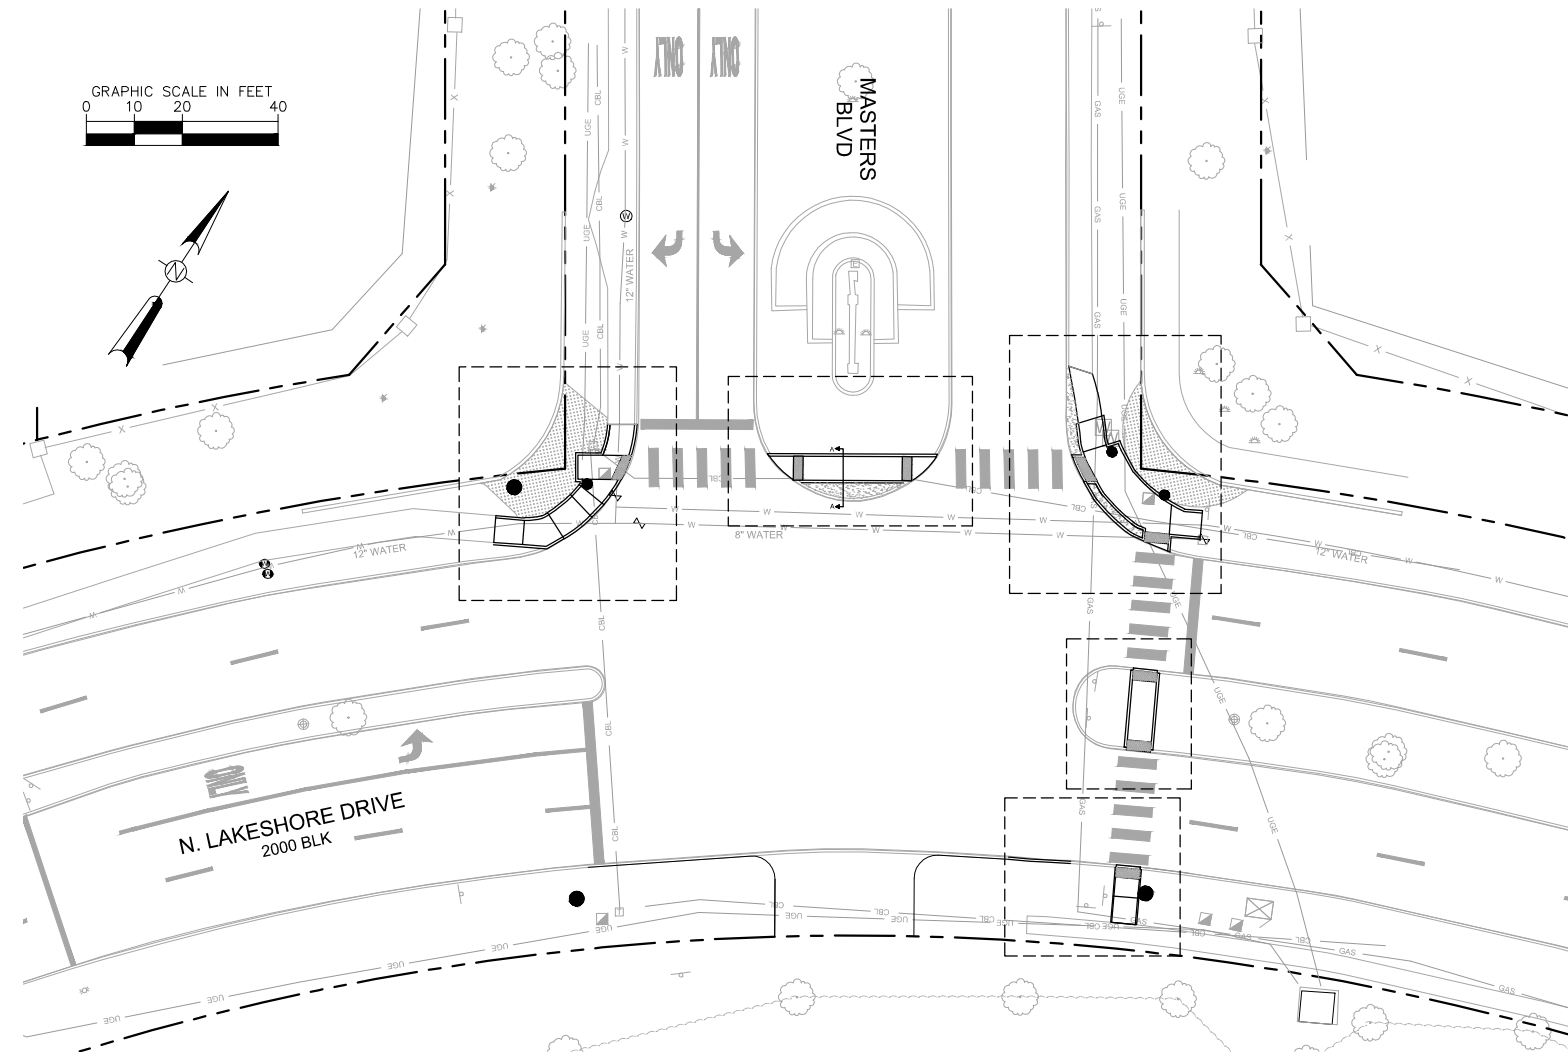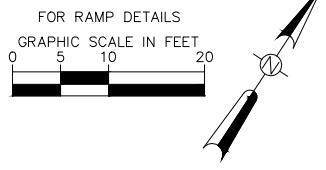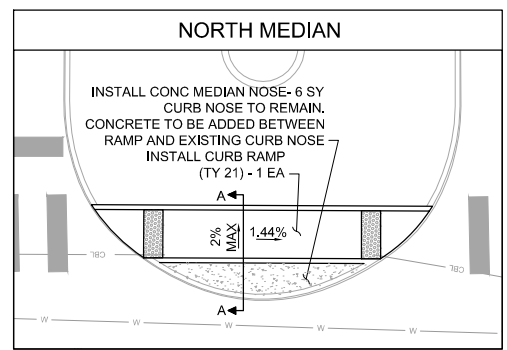

RECORD DRAWINGS

THESE RECORD DRAWINGS HAVE BEEN PREPARED TO REFLECT ANY CHANGES AND/OR MODIFICATIONS MADE TO THE DESIGN PLANS, PROVIDED BY THE CONTRACTOR AND THE CITY INSPECTOR. UNLESS OTHERWISE NOTED, THE PROJECT HAS BEEN CONSTRUCTED IN SUBSTANTIAL CONFORMANCE WITH THE DESIGN DRAWINGS. THE ENGINEERING CONSULTANT IS NOT RESPONSIBLE FOR ACCURACY AND COMPLETENESS EXCEPT FOR WHAT WAS PROVIDED BY THE CONTRACTOR. THE PLAN SET USED FOR BIDDING ORIGINALLY SEALED 5/4/2016 AND REVISED 8/8/2016.

Thomas P. Grant, P.E. 2/20/2017
SIGNATURE DATE
THOMAS P. GRANT, P.E., KIMLEY-HORN AND ASSOCIATES, INC.

- NOTES:**
- ALL CONCRETE USED FOR SIDEWALK, CURBS, AND CURB RAMP SHALL BE MIN 3600 PSI 6.5 SACK MIX. LANDSCAPE IRRIGATION IN THE NW AND NE CORNERS SHALL BE MODIFIED TO ACCOMMODATE THE PROPOSED TRAFFIC SIGNAL EQUIPMENT AND PROPOSED PAVING. THIS INCLUDES BUT IS NOT LIMITED TO RELOCATING DRIP LINES AND RELOCATING WATER BOXES.
 - PREFABRICATED DETECTABLE WARNING PANELS SHALL BE BRICK OR COLONIAL RED. DETECTABLE WARNING PAVERS NOT ALLOWED.

NO.	REVISIONS	DATE	BY
2	RECORD DRAWINGS	2/20/2017	TG

Kimley-Horn

2201 WEST ROYAL LANE, SUITE 275, IRVING, TX 75063
PHONE: 214-420-6600
WWW.KIMLEY-HORN.COM
© 2017 KIMLEY-HORN AND ASSOCIATES, INC.
Texas Registered Engineering Firm # F-528


KHA PROJECT	064420914
DATE	FEBRUARY 20, 2017
SCALE	AS SHOWN
DESIGNED BY	LAS
DRAWN BY	SMR/JWR
CHECKED BY	TPG

CITY OF ROCKWALL LAKESHORE AT MASTERS

TRAFFIC SIGNAL PAVING LAYOUT


DISCLAIMER: The use of this standard is governed by the "Texas Engineering Practice Act". No warranty of any kind is made by TxDOT for any purpose whatsoever. TxDOT assumes no responsibility for the conversion of this standard to other formats or for incorrect results or damages resulting from its use.

TYPICAL LOCATION OF CROSSROAD SIGNS

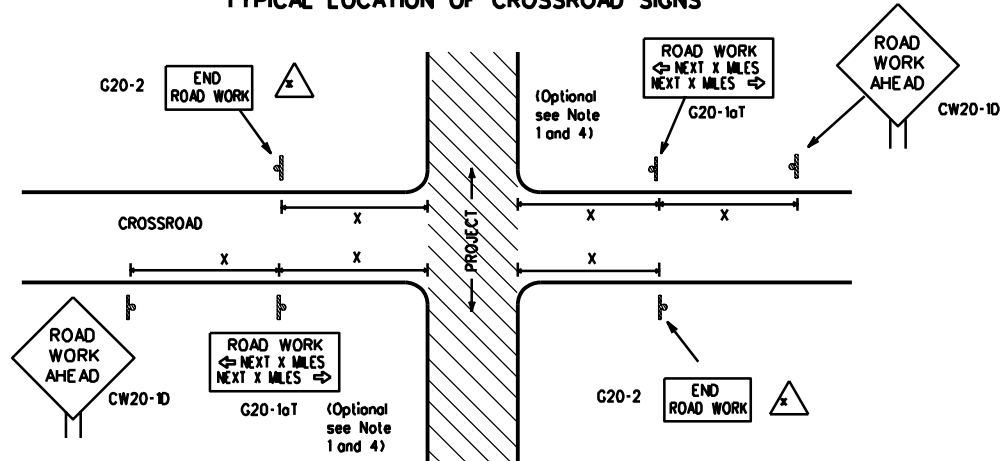

- △ May be mounted on back of "ROAD WORK AHEAD" (CW20-1D) sign with approval of Engineer. (See note 2 below)
- The typical minimum signing on a crossroad approach should be a "ROAD WORK AHEAD" (CW20-1D) sign and a (G20-2) "END ROAD WORK" sign, unless noted otherwise in plans.
 - The Engineer may use the reduced size 36" x 36" ROAD WORK AHEAD (CW20-1D) sign mounted back to back with the reduced size 36" x 18" "END ROAD WORK" (G20-2) sign on low volume crossroads (see Note 4 under "Typical Construction Warning Sign Size and Spacing"). See the "Standard Highway Sign Designs for Texas" manual for sign details. The Engineer may omit the advance warning signs on low volume crossroads. The Engineer will determine whether a road is low volume. This information shall be shown in the plans.
 - Based on existing field conditions, the Engineer/Inspector may require additional signs such as FLAGGER AHEAD, LOOSE GRAVEL, or other appropriate signs. When additional signs are required, these signs will be considered part of the minimum requirements. The Engineer/Inspector will determine the proper location and spacing of any sign not shown on the BC sheets, Traffic Control Plan sheets or the Work Zone Standard Sheets.
 - The "ROAD WORK NEXT X MILES" (G20-1aT) sign shall be required at high volume crossroads to advise motorists of the length of construction in either direction from the intersection. The Engineer will determine whether a roadway is considered high volume.
 - Additional traffic control devices may be shown elsewhere in the plans for higher volume crossroads.
 - When work occurs in the intersection area, appropriate traffic control devices, as shown elsewhere in the plans or as determined by the Engineer/Inspector, shall be in place.

T-INTERSECTION

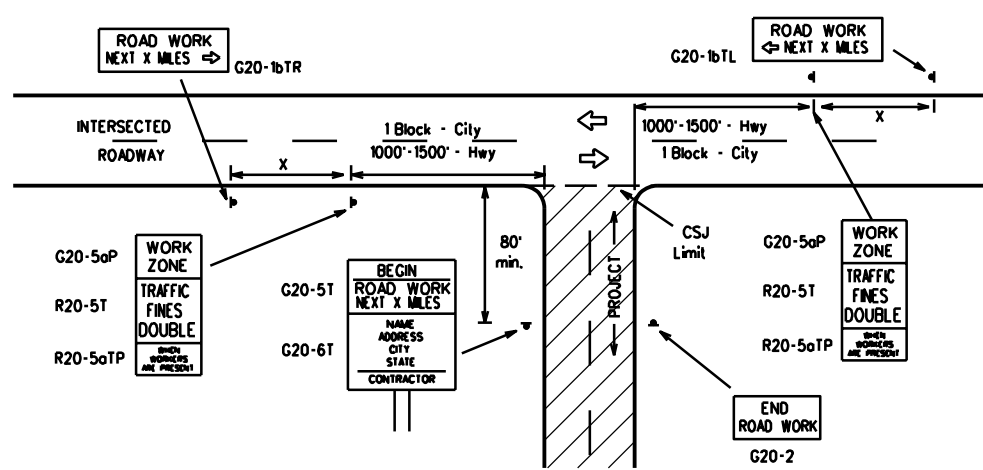

CSJ LIMITS AT T-INTERSECTION

- The Engineer will determine the types and location of any additional traffic control devices, such as a flagger and accompanying signs, or other signs, that should be used when work is being performed at or near an intersection.
- If construction closes the road at a T-intersection the Contractor shall place the "CONTRACTOR NAME" (G20-6T) sign behind the Type 3 Barricades for the road closure (see BC(10) also). The "ROAD WORK NEXT X MILES" left arrow (G20-1bTL) and "ROAD WORK NEXT X MILES" right arrow (G20-1bTR) signs shall be replaced by the detour signing called for in the plans.

TYPICAL CONSTRUCTION WARNING SIGN SIZE AND SPACING 1.5.6

Sign Number or Series	SIZE		SPACING	
	Conventional Road	Expressway/Freeway	Posted Speed MPH	Sign Spacing "X" Feet (Apprx.)
CW20 ⁴	48" x 48"	48" x 48"	30	120
CW21			35	160
CW22			40	240
CW23			45	320
CW25			50	400
CW1, CW2, CW7, CW8, CW9, CW11, CW14	36" x 36"	48" x 48"	55	500 ²
CW3, CW4, CW5, CW6, CW8-3, CW10, CW12	48" x 48"	48" x 48"	60	600 ²
			65	700 ²
			70	800 ²
			75	900 ²
			80	1000 ²
			*	* ³


* For typical sign spacings on divided highways, expressways and freeways, see Part 6 of the "Texas Manual on Uniform Traffic Control Devices" (TMUTCD) typical application diagrams or TCP Standard Sheets.

△ Minimum distance from work area to first Advance Warning sign nearest the work area and/or distance between each additional sign.

GENERAL NOTES


- Special or larger size signs may be used as necessary.
- Distance between signs should be increased as required to have 1500 feet advance warning.
- Distance between signs should be increased as required to have 1/2 mile or more advance warning.
- 36" x 36" "ROAD WORK AHEAD" (CW20-1D) signs may be used on low volume crossroads at the discretion of the Engineer. See Note 2 under "Typical Location of Crossroad Signs".
- Only diamond shaped warning sign sizes are indicated.
- See sign size listing in "TMUTCD", Sign Appendix or the "Standard Highway Sign Designs for Texas" manual for complete list of available sign design sizes.

WORK AREAS IN MULTIPLE LOCATIONS WITHIN CSJ LIMITS

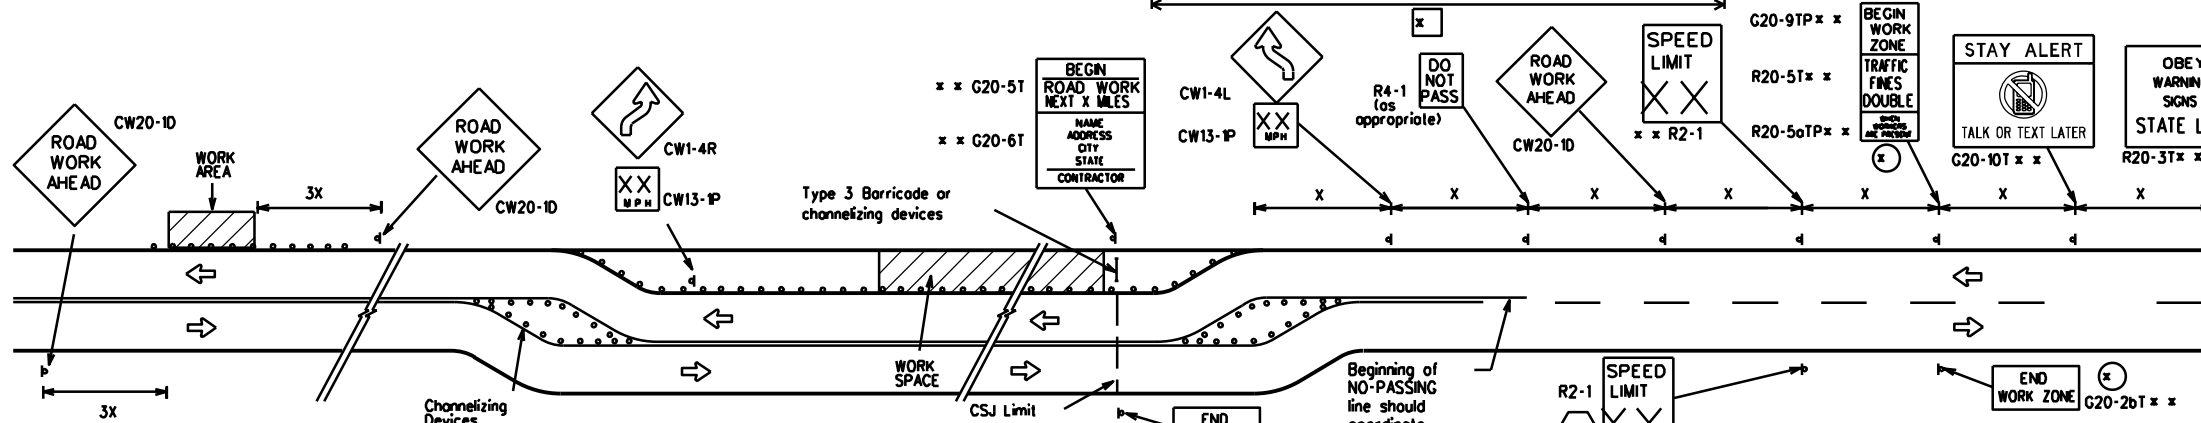


When extended distances occur between minimal work spaces, the Engineer/Inspector should ensure additional "ROAD WORK AHEAD" (CW20-1D) signs are placed in advance of these work areas to remind drivers they are still within the project limits. See the applicable TCP sheets for exact location and spacing of signs and channelizing devices.

SAMPLE LAYOUT OF SIGNING FOR WORK BEGINNING DOWNSTREAM OF THE CSJ LIMITS

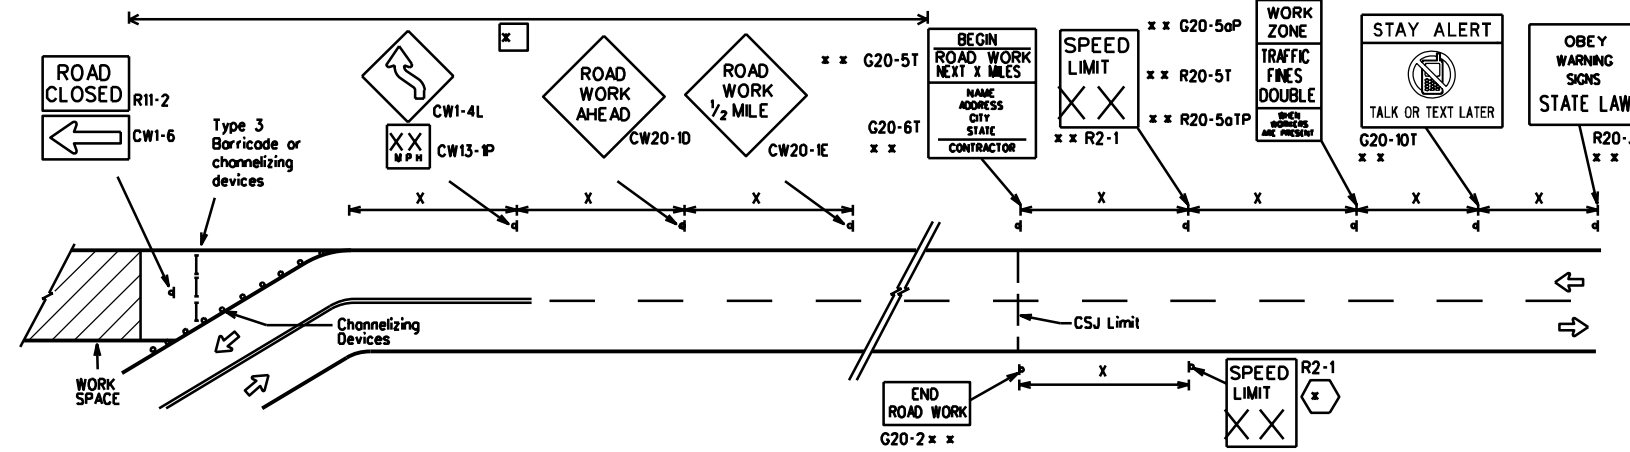

SAMPLE LAYOUT OF SIGNING FOR WORK BEGINNING AT THE CSJ LIMITS

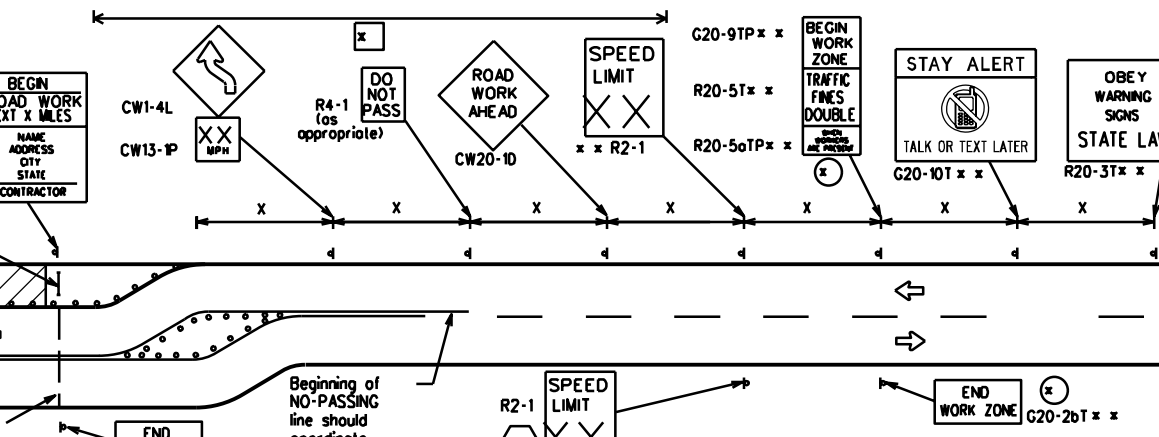

NOTES

The Contractor shall determine the appropriate distance to be placed on the G20-1 series signs and "BEGIN ROAD WORK NEXT X MILES" (G20-5T) sign for each specific project. This distance shall replace the "X" and shall be rounded to the nearest whole mile with the approval of the Engineer. No decimals shall be used.

⊗ The "BEGIN WORK ZONE" (G20-9TP) and "END WORK ZONE" (G20-2bT) shall be used as shown on the sample layout when advance signs are required outside the CSJ Limits. They inform the motorist of entering or leaving a part of the work zone lying outside the CSJ Limits where traffic fines may double if workers are present.

⊗ Required CSJ Limit signing. See Note 10 on BC(1). TRAFFIC FINES DOUBLE signs will not be required on projects consisting solely of mobile operations work.

⊗ Area for placement of "ROAD WORK AHEAD" (CW20-1D) sign and other signs or devices as called for on the Traffic Control Plan.

⊗ Contractor will install a regulatory speed limit sign at the end of the work zone.

LEGEND

—	Type 3 Barricade
○ ○ ○	Channelizing Devices
⊗	Sign
X	See Typical Construction Warning Sign Size and Spacing chart or the TMUTCD for sign spacing requirements.

SHEET 2 OF 12

Texas Department of Transportation Traffic Operations Division Standard


BARRICADE AND CONSTRUCTION PROJECT LIMIT

BC(2)-14

FILE: bc-14.dgn	DN: TxDOT	CK: TxDOT	DW: TxDOT	CK: TxDOT
© TxDOT November 2002	CONT	SECT	JOB	HIGHWAY
REVISIONS	---	---	---	---
9-07 8-14	DIST	COUNTY	SHEET NO.	
7-13	---	---	11	

DATE: FILE:


TYPICAL MINIMUM CLEARANCES FOR LONG TERM AND INTERMEDIATE TERM SIGNS

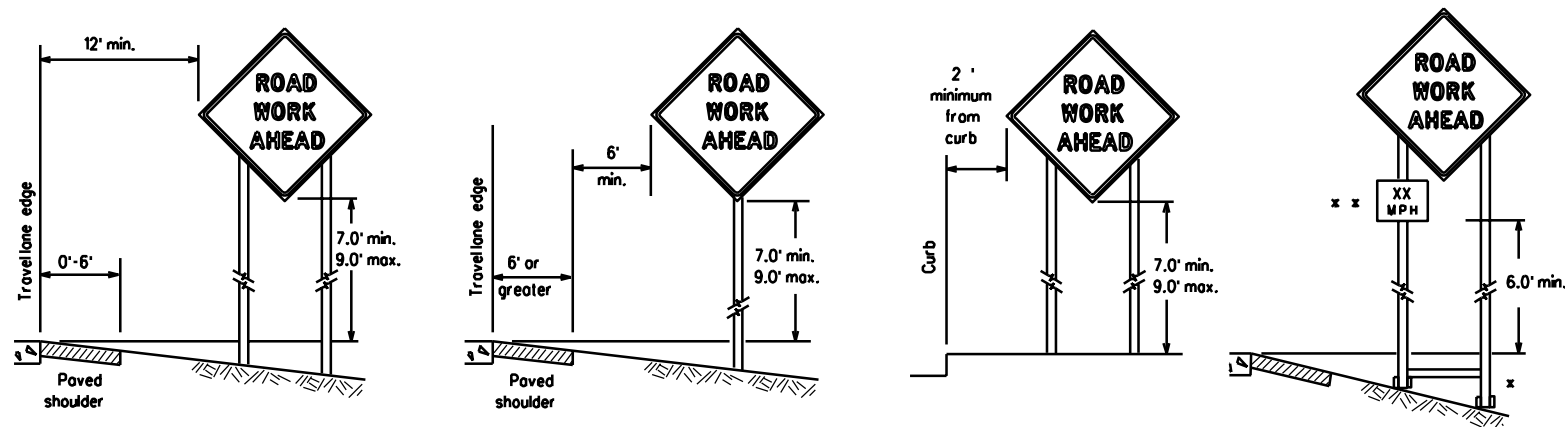

x When placing skid supports on unlevel ground, the leg post lengths must be adjusted so the sign appears straight and plumb. Objects shall NOT be placed under skids as a means of leveling.

x x When plaques are placed on dual-leg supports, they should be attached to the upright nearest the travel lane. Supplemental plaques (advisory or distance) should not cover the surface of the parent sign.

ATTACHMENT FOR SIGN SUPPORTS

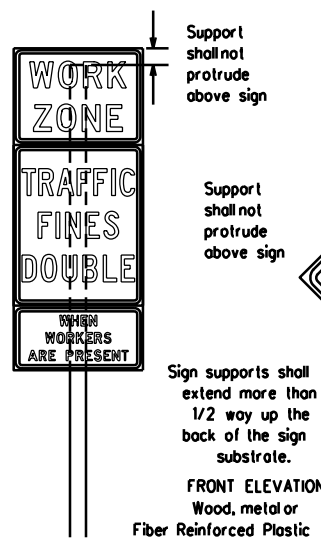

Support shall not protrude above sign


Support shall not protrude above sign

Sign supports shall extend more than 1/2 way up the back of the sign substrate.

FRONT ELEVATION
Wood, metal or
Fiber Reinforced Plastic

Splicing embedded perforated square metal tubing in order to extend post height will only be allowed when the splice is made using four bolts, two above and two below the splice point. Splice must be located entirely behind the sign substrate, not near the base of the support. Splice insert lengths should be at least 5 times nominal post size, centered on the splice and of at least the same gauge material.

Attachment to wooden supports will be by bolts and nuts or screws. Use TxDOT's or manufacturer's recommended procedures for attaching sign substrates to other types of sign supports

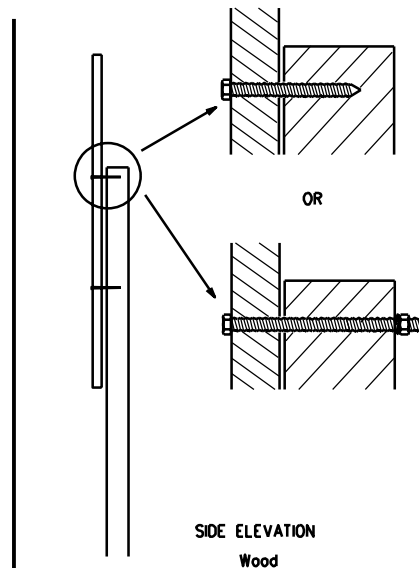

Nois shall NOT be allowed. Each sign shall be attached directly to the sign support. Multiple signs shall not be joined or spliced by any means. Wood supports shall not be extended or repaired by splicing or other means.

GENERAL NOTES FOR WORK ZONE SIGNS

- Contractor shall install and maintain signs in a straight and plumb condition and/or as directed by the Engineer.
 - Wooden sign posts shall be painted white.
 - Barricades shall NOT be used as sign supports.
 - All signs shall be installed in accordance with the plans or as directed by the Engineer. Signs shall be used to regulate, warn, and guide the traveling public safely through the work zone.
 - The Contractor may furnish either the sign design shown in the plans or in the "Standard Highway Sign Designs for Texas" (SHSD). The Engineer/Inspector may require the Contractor to furnish other work zone signs that are shown in the TMUTCD but may have been omitted from the plans. Any variation in the plans shall be documented by written agreement between the Engineer and the Contractor's Responsible Person. All changes must be documented in writing before being implemented. This can include documenting the changes in the Inspector's TxDOT diary and having both the Inspector and Contractor initial and date the agreed upon changes.
 - The Contractor shall furnish sign supports listed in the "Compliant Work Zone Traffic Control Device List" (CWZTCD). The Contractor shall install the sign support in accordance with the manufacturer's recommendations. If there is a question regarding installation procedures, the Contractor shall furnish the Engineer a copy of the manufacturer's installation recommendations so the Engineer can verify the correct procedures are being followed.
 - The Contractor is responsible for installing signs on approved supports and replacing signs with damaged or cracked substrates and/or damaged or marred reflective sheeting as directed by the Engineer/Inspector.
 - Identification markings may be shown only on the back of the sign substrate. The maximum height of letters and/or company logos used for identification shall be 1 inch.
 - The Contractor shall replace damaged wood posts. New or damaged wood sign posts shall not be spliced.
- DURATION OF WORK (as defined by the "Texas Manual on Uniform Traffic Control Devices" Part 6)**
- The types of sign supports, sign mounting height, the size of signs, and the type of sign substrates can vary based on the type of work being performed. The Engineer is responsible for selecting the appropriate size sign for the type of work being performed. The Contractor is responsible for ensuring the sign support, sign mounting height and substrate meets manufacturer's recommendations in regard to crashworthiness and duration of work requirements.
 - Long-term stationary - work that occupies a location more than 3 days.
 - Intermediate-term stationary - work that occupies a location more than one daylight period up to 3 days, or nighttime work lasting more than one hour.
 - Short-term stationary - daytime work that occupies a location for more than 1 hour in a single daylight period.
 - Short, duration - work that occupies a location up to 1 hour.
 - Mobile - work that moves continuously or intermittently (stopping for up to approximately 15 minutes.)

SIGN MOUNTING HEIGHT

- The bottom of Long-term/Intermediate-term signs shall be at least 7 feet, but not more than 9 feet, above the paved surface, except as shown for supplemental plaques mounted below other signs.
- The bottom of Short-term/Short Duration signs shall be a minimum of 1 foot above the pavement surface but no more than 2 feet above the ground.
- Long-term/Intermediate-term Signs may be used in lieu of Short-term/Short Duration signing.
- Short-term/Short Duration signs shall be used only during daylight and shall be removed at the end of the workday or raised to appropriate Long-term/Intermediate sign height.
- Regulatory signs shall be mounted at least 7 feet, but not more than 9 feet, above the paved surface regardless of work duration.

SIZE OF SIGNS

- The Contractor shall furnish the sign sizes shown on BC (2) unless otherwise shown in the plans or as directed by the Engineer.

SIGN SUBSTRATES

- The Contractor shall ensure the sign substrate is installed in accordance with the manufacturer's recommendations for the type of sign support that is being used. The CWZTCD lists each substrate that can be used on the different types and models of sign supports.
- "Mesh" type materials are NOT an approved sign substrate, regardless of the tightness of the weave.
- All wooden individual sign panels fabricated from 2 or more pieces shall have one or more plywood cleat, 1/2" thick by 6" wide, fastened to the back of the sign and extending fully across the sign. The cleat shall be attached to the back of the sign using wood screws that do not penetrate the face of the sign panel. The screws shall be placed on both sides of the splice and spaced at 6" centers. The Engineer may approve other methods of splicing the sign face.

REFLECTIVE SHEETING

- All signs shall be retroreflective and constructed of sheeting meeting the color and retro-reflectivity requirements of DMS-8300 for rigid signs or DMS-8310 for roll-up signs. The web address for DMS specifications is shown on BC(1).
- White sheeting, meeting the requirements of DMS-8300 Type A, shall be used for signs with a white background.
- Orange sheeting, meeting the requirements of DMS-8300 Type B or Type B₁, shall be used for rigid signs with orange backgrounds.

SIGN LETTERS

- All sign letters and numbers shall be clear, and open rounded type uppercase alphabet letters as approved by the Federal Highway Administration (FHWA) and as published in the "Standard Highway Sign Design for Texas" manual. Signs, letters and numbers shall be of first class workmanship in accordance with Department Standards and Specifications.

REMOVING OR COVERING

- When sign messages may be confusing or do not apply, the signs shall be removed or completely covered.
- Long-term stationary or intermediate stationary signs installed on square metal tubing may be turned away from traffic 90 degrees when the sign message is not applicable. This technique may not be used for signs installed in the median of divided highways or near any intersections where the sign may be seen from approaching traffic.
- Signs installed on wooden skids shall not be turned at 90 degree angles to the roadway. These signs should be removed or completely covered when not required.
- When signs are covered, the material used shall be opaque, such as heavy mil black plastic, or other materials which will cover the entire sign face and maintain their opaque properties under automobile headlights at night, without damaging the sign sheeting.
- Burlap shall NOT be used to cover signs.
- Duct tape or other adhesive material shall NOT be affixed to a sign face.
- Signs and anchor stubs shall be removed and holes backfilled upon completion of work.

SIGN SUPPORT WEIGHTS


- Where sign supports require the use of weights to keep from turning over, the use of sandbags with dry, cohesionless sand should be used.
- The sandbags will be tied shut to keep the sand from spilling and to maintain a constant weight.
- Rock, concrete, iron, steel or other solid objects shall not be permitted for use as sign support weights.
- Sandbags should weigh a minimum of 35 lbs and a maximum of 50 lbs.
- Sandbags shall be made of a durable material that tears upon vehicular impact. Rubber (such as tire inner tubes) shall NOT be used.
- Rubber ballasts designed for channelizing devices should not be used for ballast on portable sign supports. Sign supports designed and manufactured with rubber bases may be used when shown on the CWZTCD list.
- Sandbags shall only be placed along or laid over the base supports of the traffic control device and shall not be suspended above ground level or hung with rope, wire, chains or other fasteners. Sandbags shall be placed along the length of the skids to weigh down the sign support.
- Sandbags shall NOT be placed under the skid and shall not be used to level sign supports placed on slopes.

FLAGS ON SIGNS

- Flags may be used to draw attention to warning signs. When used the flag shall be 16 inches square or larger and shall be orange or fluorescent red-orange in color. Flags shall not be allowed to cover any portion of the sign face.

STOP/SLOW PADDLES

- STOP/SLOW paddles are the primary method to control traffic by floggers. The STOP/SLOW paddle size should be 24" x 24" as detailed below.
- When used at night, the STOP/SLOW paddle shall be retroreflectORIZED.
- STOP/SLOW paddles may be attached to a staff with a minimum length of 6' to the bottom of the sign.
- Any lights incorporated into the STOP or SLOW paddle faces shall only be as specifically described in Section 6E.03 Hand Signaling Devices in the TMUTCD.

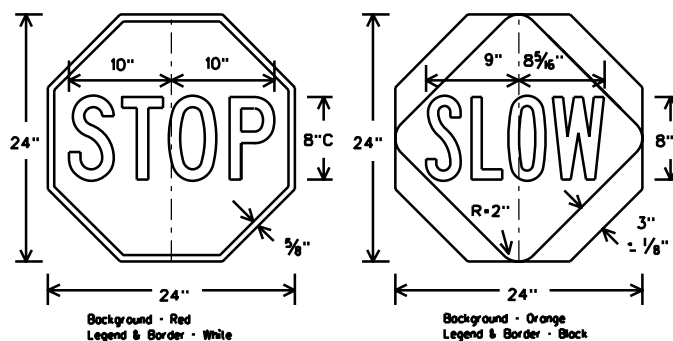

CONTRACTOR REQUIREMENTS FOR MAINTAINING PERMANENT SIGNS WITHIN THE PROJECT LIMITS

- Permanent signs are used to give notice of traffic laws or regulations, call attention to conditions that are potentially hazardous to traffic operations, show route designations, destinations, directions, distances, services, points of interest, and other geographical, recreational, or cultural information. Drivers proceeding through a work zone need the same, if not better route guidance as normally installed on a roadway without construction.
- When permanent regulatory or warning signs conflict with work zone conditions, remove or cover the permanent signs until the permanent sign message matches the roadway condition.
- When existing permanent signs are moved and relocated due to construction purposes, they shall be visible to motorists at all times.
- If existing signs are to be relocated on their original supports, they shall be installed on crashworthy bases as shown on the SMD Standard sheets. The signs shall meet the required mounting heights shown on the BC Sheets or the SMD Standards. This work should be paid for under the appropriate pay item for relocating existing signs.
- If permanent signs are to be removed and relocated using temporary supports, the Contractor shall use crashworthy supports as shown on the BC sheets or the CWZTCD. The signs shall meet the required mounting heights shown on the BC Sheets or the SMD Standards during construction. This work should be paid for under the appropriate pay item for relocating existing signs.
- Any sign or traffic control device that is struck or damaged by the Contractor or his/her construction equipment shall be replaced as soon as possible by the Contractor to ensure proper guidance for the motorists. This will be subsidiary to Item 502.

SHEET 4 OF 12



BARRICADE AND CONSTRUCTION TEMPORARY SIGN NOTES


BC(4)-14

FILE: bc-14.dgn	DN: TxDOT	CK: TxDOT	DW: TxDOT	CK: TxDOT
© TxDOT November 2002	CONT	SECT	JOB	HIGHWAY
REVISIONS	---	---	---	---
9-07 8-14	DIST	COUNTY	SHEET NO.	
7-13	---	---	12	



DISCLAIMER: This standard is governed by the "Texas Engineering Practice Act". No warranty of any kind is made by TxDOT for any purpose whatsoever. TxDOT assumes no responsibility for the conversion of this standard to other formats or for incorrect results or damages resulting from its use.

DATE: FILE:

DISCLAIMER: The use of this standard is governed by the "Texas Engineering Practice Act". No warranty of any kind is made by TxDOT for any purpose whatsoever. TxDOT assumes no responsibility for the conversion of this standard to other formats or for incorrect results or damages resulting from its use.


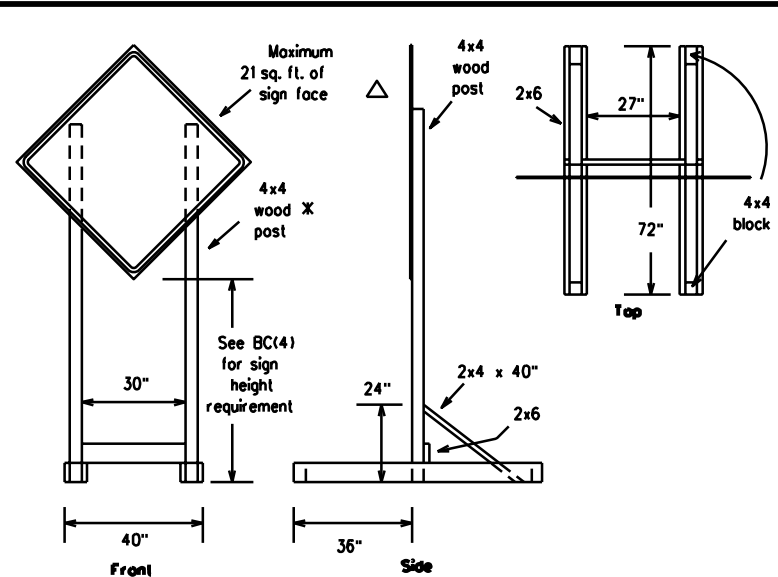


SKID MOUNTED WOOD SIGN SUPPORTS
LONG/INTERMEDIATE TERM STATIONARY - PORTABLE SKID MOUNTED SIGN SUPPORTS □

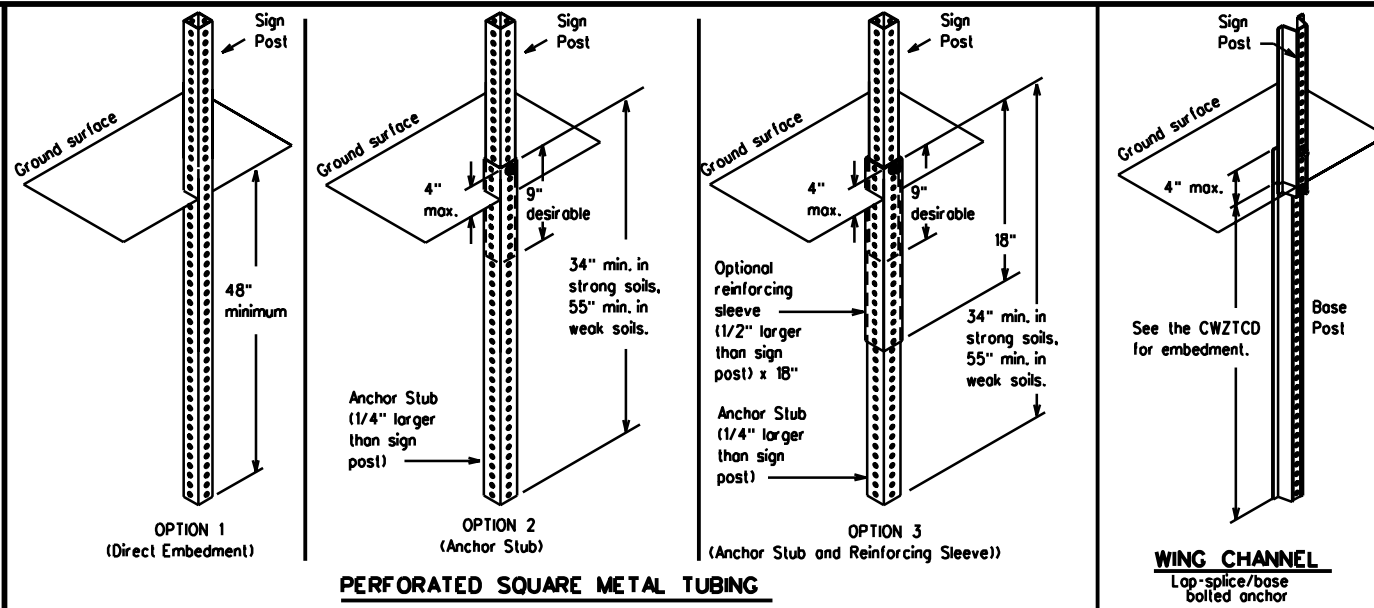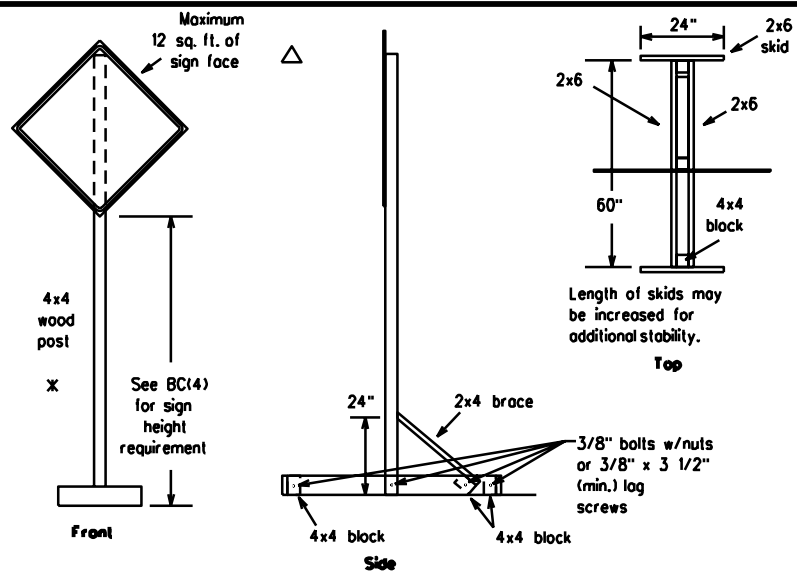


GROUND MOUNTED SIGN SUPPORTS

Refer to the CWZTCD and the manufacturer's installation procedure for each type sign support. The maximum sign square footage shall adhere to the manufacturer's recommendation. Two post installations can be used for larger signs.

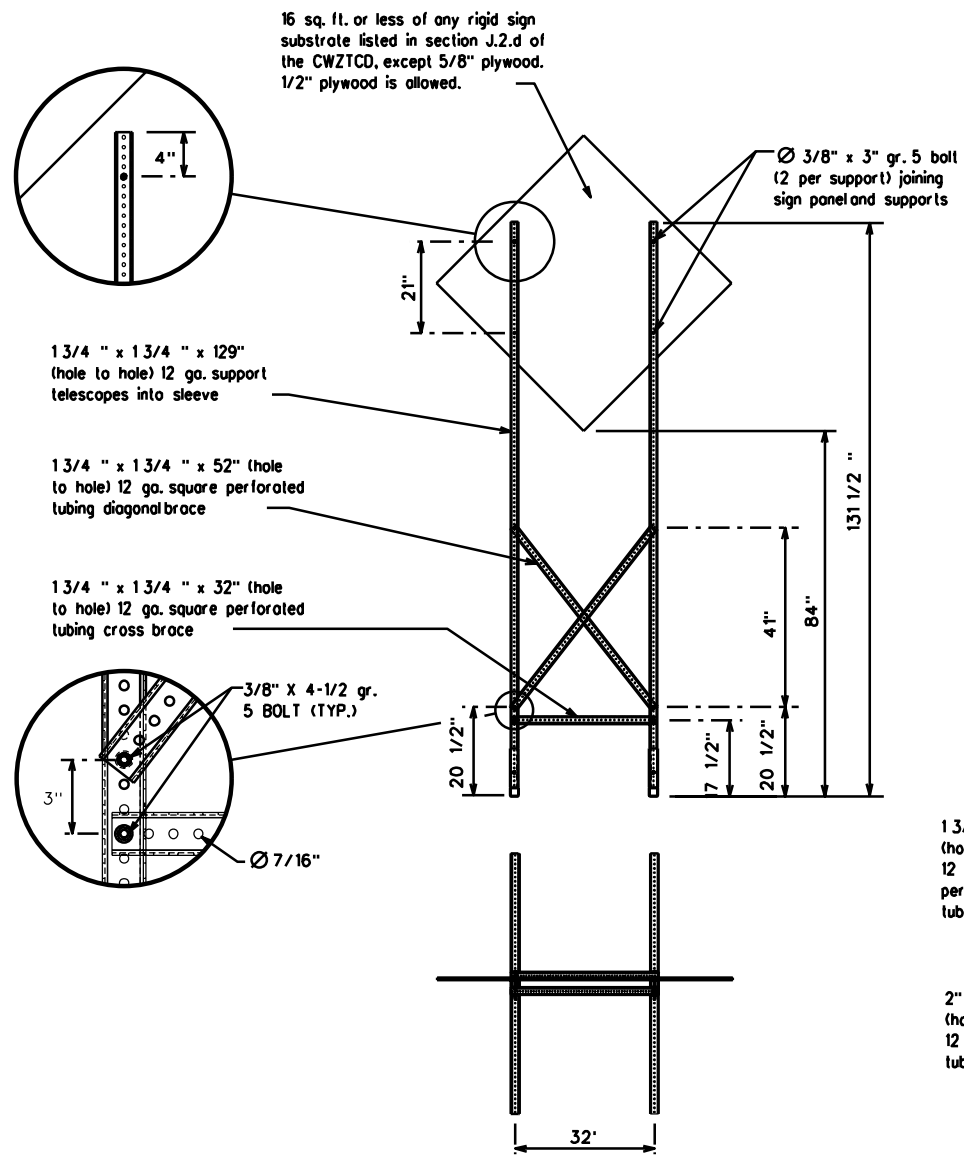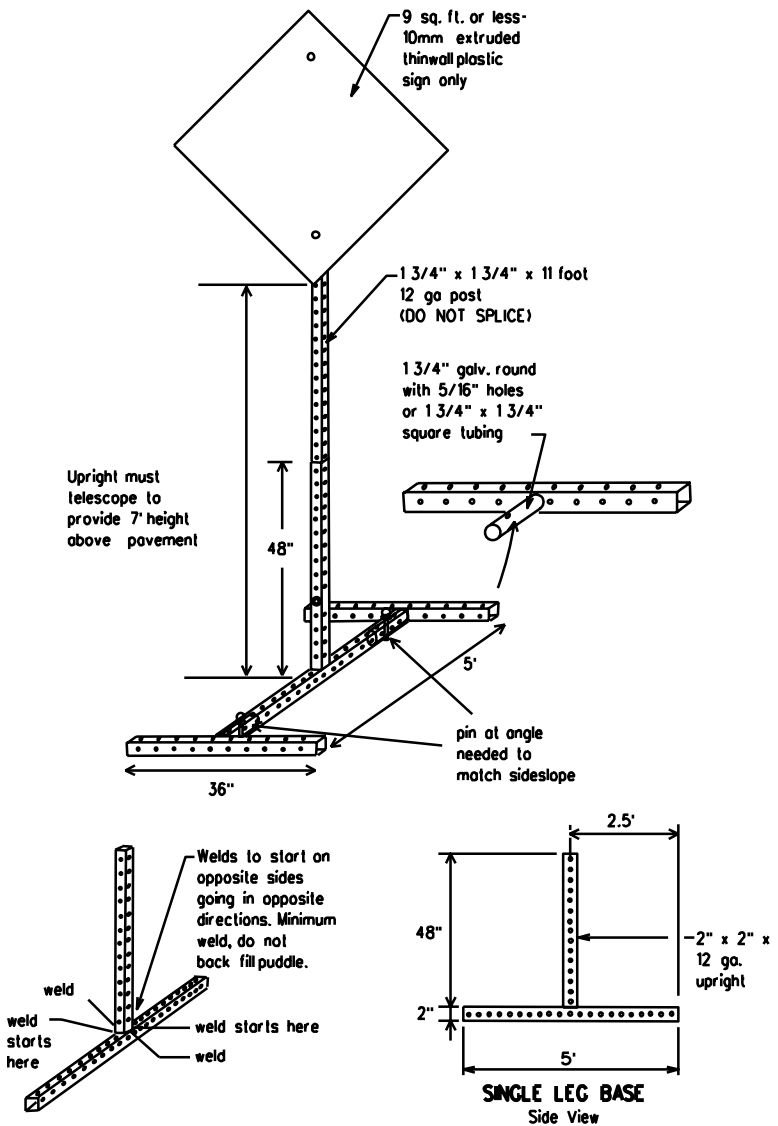

SKID MOUNTED PERFORATED SQUARE STEEL TUBING SIGN SUPPORTS

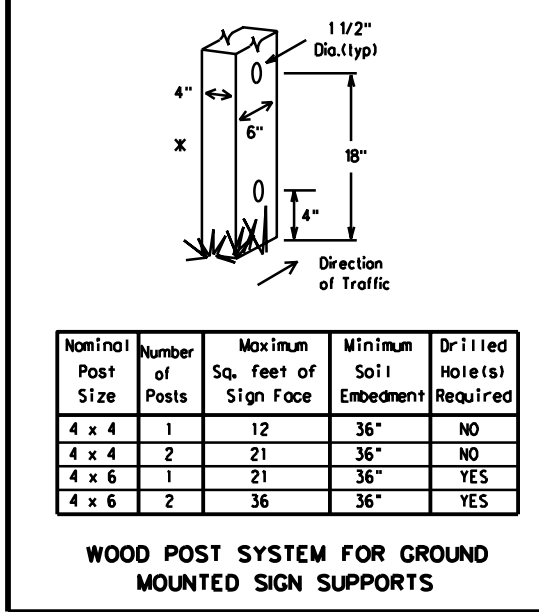

WOOD POST SYSTEM FOR GROUND MOUNTED SIGN SUPPORTS

Nominal Post Size	Number of Posts	Maximum Sq. feet of Sign Face	Minimum Soil Embedment	Drilled Holes(s) Required
4 x 4	1	12	36"	NO
4 x 4	2	21	36"	NO
4 x 6	1	21	36"	YES
4 x 6	2	36	36"	YES

WEDGE ANCHORS
Both steel and plastic Wedge Anchor Systems as shown on the SMD Standard Sheets may be used as temporary sign supports for signs up to 10 square feet of sign face. They may be set in concrete or in sturdy soils if approved by the Engineer. (See web address for "Traffic Engineering Standard Sheets" on BC(1)).

OTHER DESIGNS
MORE DETAILS OF APPROVED LONG/INTERMEDIATE AND SHORT TERM SUPPORTS CAN BE FOUND ON THE CWZTCD LIST. SEE BC(1) FOR WEBSITE LOCATION.

- GENERAL NOTES**
- Nails may be used in the assembly of wooden sign supports, but 3/8" bolts with nuts or 3/8" x 3 1/2" lag screws must be used on every joint for final connection.
 - No more than 2 sign posts shall be placed within a 7 ft. circle, except for specific materials noted on the CWZTCD List.
 - When project is completed, all sign supports and foundations shall be removed from the project site. This will be considered subsidiary to Item 502.

- See BC(4) for definition of "Work Duration."
- ✕ Wood sign posts MUST be one piece. Splicing will NOT be allowed. Posts shall be painted white.
- △ See the CWZTCD for the type of sign substrate that can be used for each approved sign support.

BARRICADE AND CONSTRUCTION TYPICAL SIGN SUPPORT

BC(5)-14

FILE: bc-14.dgn	DN: TxDOT	CK: TxDOT	DW: TxDOT	CK: TxDOT
© TxDOT November 2002	CONT	SECT	JOB	HIGHWAY
REVISIONS	---	---	---	---
9-07 8-14	DIST	COUNTY	SHEET NO.	
7-13	---	---	13	

DATE: FILE:

DISCLAIMER: The use of this standard is governed by the "Texas Engineering Practice Act". No warranty of any kind is made by TxDOT for any purpose whatsoever. TxDOT assumes no responsibility for the conversion of this standard to other formats or for incorrect results or damages resulting from its use.

GENERAL NOTES

- For long term stationary work zones on freeways, drums shall be used as the primary channelizing device.
- For intermediate term stationary work zones on freeways, drums should be used as the primary channelizing device but may be replaced in tangent sections by vertical panels, or 42" two-piece cones. In tangent sections one-piece cones may be used with the approval of the Engineer but only if personnel are present on the project at all times to maintain the cones in proper position and location.
- For short term stationary work zones on freeways, drums are the preferred channelizing device but may be replaced in tapers, transitions and tangent sections by vertical panels, two-piece cones or one-piece cones as approved by the Engineer.
- Drums and all related items shall comply with the requirements of the current version of the "Texas Manual on Uniform Traffic Control Devices" (TMUTCD) and the "Compliant Work Zone Traffic Control Devices List" (CWZTCD).
- Drums, bases, and related materials shall exhibit good workmanship and shall be free from objectionable marks or defects that would adversely affect their appearance or serviceability.
- The Contractor shall have a maximum of 24 hours to replace any plastic drums identified for replacement by the Engineer/Inspector. The replacement device must be an approved device.

GENERAL DESIGN REQUIREMENTS

Pre-qualified plastic drums shall meet the following requirements:



- Plastic drums shall be a two-piece design; the "body" of the drum shall be the top portion and the "base" shall be the bottom.
- The body and base shall lock together in such a manner that the body separates from the base when impacted by a vehicle traveling at a speed of 20 MPH or greater but prevents accidental separation due to normal handling and/or air turbulence created by passing vehicles.
- Plastic drums shall be constructed of lightweight flexible, and deformable materials. The Contractor shall NOT use metal drums or single piece plastic drums as channelization devices or sign supports.
- Drums shall present a profile that is a minimum of 18 inches in width at the 36 inch height when viewed from any direction. The height of drum unit (body installed on base) shall be a minimum of 36 inches and a maximum of 42 inches.
- The top of the drum shall have a built-in handle for easy pickup and shall be designed to drain water and not collect debris. The handle shall have a minimum of two widely spaced 9/16 inch diameter holes to allow attachment of a warning light, warning reflector unit or approved compliant sign.
- The exterior of the drum body shall have a minimum of four alternating orange and white retroreflective circumferential stripes not less than 4 inches nor greater than 8 inches in width. Any non-reflectORIZED space between any two adjacent stripes shall not exceed 2 inches in width.
- Bases shall have a maximum width of 36 inches, a maximum height of 4 inches, and a minimum of two footholds of sufficient size to allow base to be held down while separating the drum body from the base.
- Plastic drums shall be constructed of ultra-violet stabilized, orange, high-density polyethylene (HDPE) or other approved material.
- Drum body shall have a maximum unballasted weight of 11 lbs.
- Drum and base shall be marked with manufacturer's name and model number.

RETROREFLECTIVE SHEETING

- The stripes used on drums shall be constructed of sheeting meeting the color and retroreflectivity requirements of Departmental Materials Specification DMS-8300, "Sign Face Materials." Type A reflective sheeting shall be supplied unless otherwise specified in the plans.
- The sheeting shall be suitable for use on and shall adhere to the drum surface such that, upon vehicular impact, the sheeting shall remain adhered in place and exhibit no delaminating, cracking, or loss of retroreflectivity other than that loss due to abrasion of the sheeting surface.


BALLAST

- Unballasted bases shall be large enough to hold up to 50 lbs. of sand. This base, when filled with the ballast material, should weigh between 35 lbs (minimum) and 50 lbs (maximum). The ballast may be sand in one to three sandbags separate from the base, sand in a sand-filled plastic base, or other ballasting devices as approved by the Engineer. Stacking of sandbags will be allowed, however height of sandbags above pavement surface may not exceed 12 inches.
- Bases with built-in ballast shall weigh between 40 lbs. and 50 lbs. Built-in ballast can be constructed of an integral crumb rubber base or a solid rubber base.
- Recycled truck tire sidewalls may be used for ballast on drums approved for this type of ballast on the CWZTCD list.
- The ballast shall not be heavy objects, water, or any material that would become hazardous to motorists, pedestrians, or workers when the drum is struck by a vehicle.
- When used in regions susceptible to freezing, drums shall have drainage holes in the bottoms so that water will not collect and freeze becoming a hazard when struck by a vehicle.
- Ballast shall not be placed on top of drums.
- Adhesives may be used to secure base of drums to pavement.

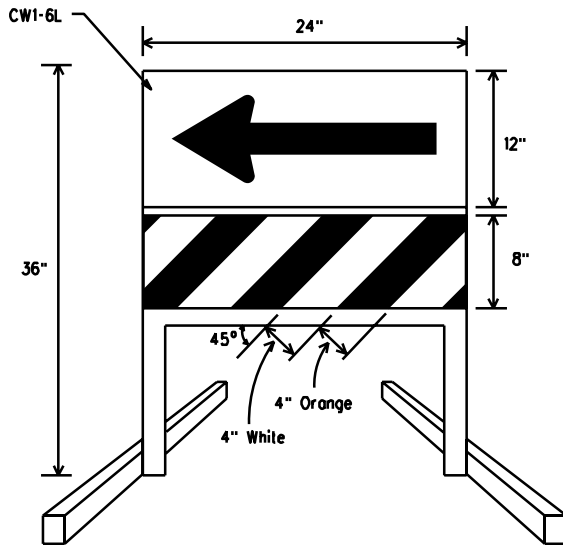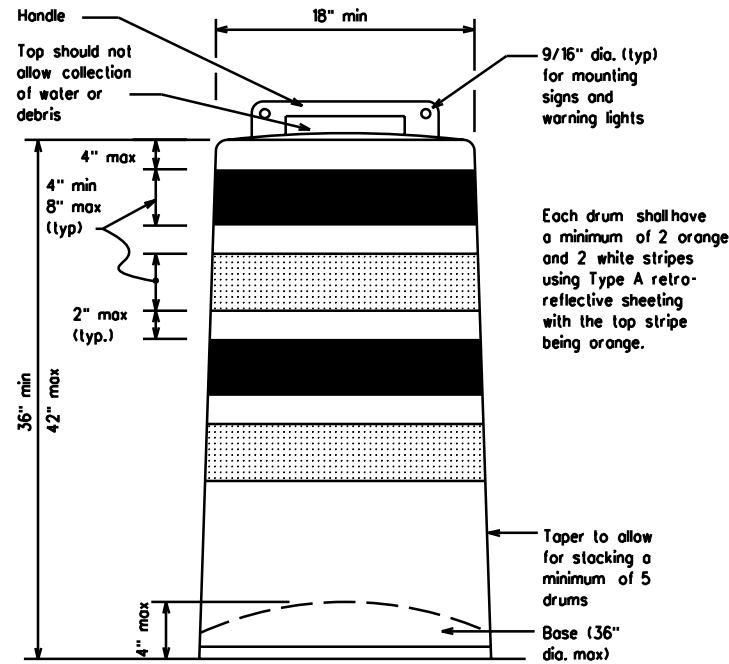


DIRECTION INDICATOR BARRICADE

- The Direction Indicator Barricade may be used in tapers, transitions, and other areas where specific directional guidance to drivers is necessary.
- If used, the Direction Indicator Barricade should be used in series to direct the driver through the transition and into the intended travel lane.
- The Direction Indicator Barricade shall consist of One-Direction Large Arrow (CWI-6) sign in the size shown with a black arrow on a background of Type B or Type C Orange retroreflective sheeting above a rail with Type A retroreflective sheeting in alternating 4" white and orange stripes sloping downward at an angle of 45 degrees in the direction road users are to pass. Sheeting types shall be as per DMS 8300.
- Double arrows on the Direction Indicator Barricade will not be allowed.
- Approved manufacturers are shown on the CWZTCD List. Ballast shall be as approved by the manufacturers instructions.

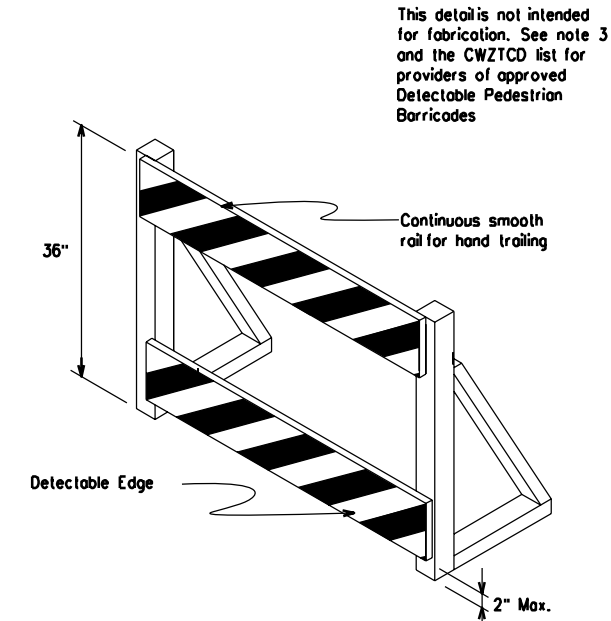


DETECTABLE PEDESTRIAN BARRICADES

- When existing pedestrian facilities are disrupted, closed, or relocated in a TTC zone, the temporary facilities shall be detectable and include accessibility features consistent with the features present in the existing pedestrian facility.
- Where pedestrians with visual disabilities normally use the closed sidewalk, a device that is detectable by a person with a visual disability traveling with the aid of a long cane shall be placed across the full width of the closed sidewalk.
- Detectable pedestrian barricades similar to the one pictured above, longitudinal channelizing devices, some concrete barriers, and wood or chain link fencing with a continuous detectable edging can satisfactorily delineate a pedestrian path.
- Tape, rope, or plastic chain strung between devices are not detectable, do not comply with the design standards in the "Americans with Disabilities Act Accessibility Guidelines for Buildings and Facilities (ADAAG)" and should not be used as a control for pedestrian movements.
- Warning lights shall not be attached to detectable pedestrian barricades.
- Detectable pedestrian barricades may use 8" nominal barricade rails as shown on BC(10) provided that the top rail provides a smooth continuous rail suitable for hand trailing with no splinters, burrs, or sharp edges.

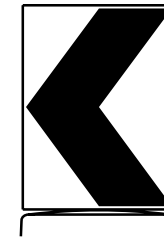

18" x 24" Sign
(Maximum Sign Dimension)
Chevron CW1-8, Opposing Traffic Lane Divider, Driveway sign D70a, Keep Right R4 series or other signs as approved by Engineer

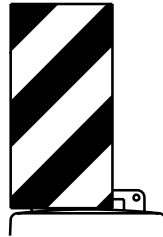

12" x 24" Vertical Panel
mount with diagonals sloping down towards travel way

Plywood, Aluminum or Metal sign substrates shall NOT be used on plastic drums

SIGNS, CHEVRONS, AND VERTICAL PANELS MOUNTED ON PLASTIC DRUMS

- Signs used on plastic drums shall be manufactured using substrates listed on the CWZTCD.
- Chevrons and other work zone signs with an orange background shall be manufactured with Type B or Type C Orange sheeting meeting the color and retroreflectivity requirements of DMS-8300, "Sign Face Material," unless otherwise specified in the plans.
- Vertical Panels shall be manufactured with orange and white sheeting meeting the requirements of DMS-8300 Type A Diagonal stripes on Vertical Panels shall slope down toward the intended traveled lane.
- Other sign messages (text or symbolic) may be used as approved by the Engineer. Sign dimensions shall not exceed 18 inches in width or 24 inches in height, except for the R9 series signs discussed in note 8 below.
- Signs shall be installed using a 1/2 inch nominal and nut, two washers, and one locking washer for each connection.
- Mounting bolts and nuts shall be fully engaged and adequately torqued. Bolts should not extend more than 1/2 inch beyond nuts.
- Chevrons may be placed on drums on the outside of curves, on merging tapers or on shifting tapers. When used in these locations they may be placed on every drum or spaced not more than on every third drum. A minimum of three (3) should be used at each location called for in the plans.
- R9-9, R9-10, R9-11 and R9-11a Sidewalk Closed signs which are 24 inches wide may be mounted on plastic drums, with approval of the Engineer.

SHEET 8 OF 12




BARRICADE AND CONSTRUCTION CHANNELIZING DEVICES

BC(8)-14

FILE: bc-14.dgn	DN: TxDOT	CK: TxDOT	DW: TxDOT	CK: TxDOT
© TxDOT November 2002	CONT	SECT	JOB	HIGHWAY
REVISIONS	---	---	---	---
4-03 7-13	DIST	COUNTY	SHEET NO.	
9-07 8-14	---	---	14	


DATE:
FILE:

DISCLAIMER: The use of this standard is governed by the "Texas Engineering Practice Act". No warranty of any kind is made by TxDOT for any purpose whatsoever. TxDOT assumes no responsibility for the conversion of this standard to other formats or for incorrect results or damages resulting from its use.

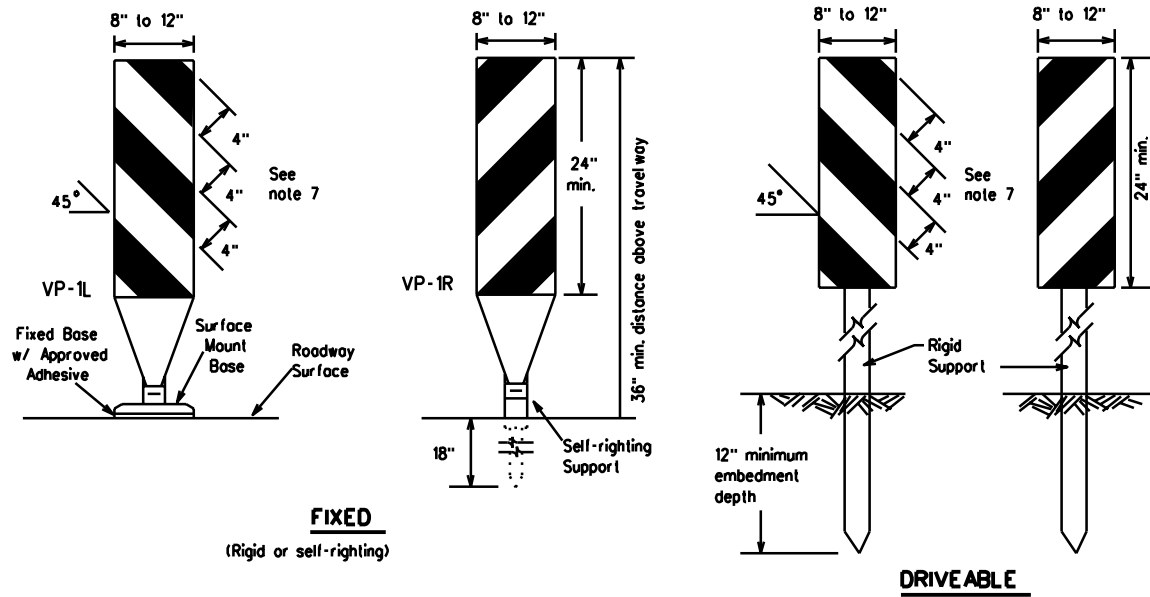

FIXED
(Rigid or self-righting)


DRIVEABLE

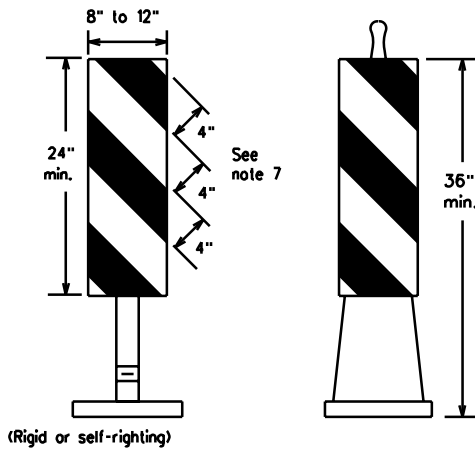

PORTABLE


VERTICAL PANELS (VPs)

- Vertical Panels (VPs) are normally used to channelize traffic or divide opposing lanes of traffic.
- VPs may be used in daytime or nighttime situations. They may be used at the edge of shoulder drop-offs and other areas such as lane transitions where positive daytime and nighttime delineation is required. The Engineer/Inspector shall refer to the Roadway Design Manual Appendix B "Treatment of Pavement Drop-offs in Work Zones" for additional guidelines on the use of VP's for drop-offs.
- VP's should be mounted back to back if used at the edge of cuts adjacent to two-way two lane roadways. Stripes are to be reflective orange and reflective white and should always slope downward toward the travel lane.
- VP's used on expressways and freeways or other high speed roadways, may have more than 270 square inches of retroreflective area facing traffic.
- Self-righting supports are available with portable base. See "Compliant Work Zone Traffic Control Devices List" (CWZTCD).
- Sheeting for the VP's shall be retroreflective Type A conforming to Departmental Material Specification DMS-8300, unless noted otherwise.
- Where the height of reflective material on the vertical panels is 36 inches or greater, a panel stripe of 6 inches shall be used.

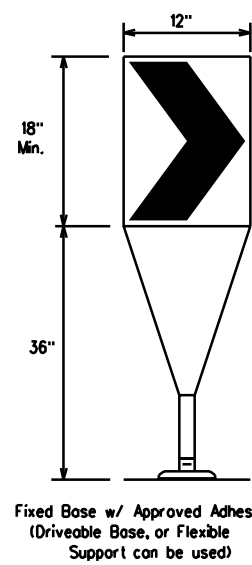

- The chevron shall be a vertical rectangle with a minimum size of 12 by 18 inches.
- Chevrons are intended to give notice of a sharp change of alignment with the direction of travel and provide additional emphasis and guidance for vehicle operators with regard to changes in horizontal alignment of the roadway.
- Chevrons, when used, shall be erected on the outside of a sharp curve or turn, or on the far side of an intersection. They shall be in line with and at right angles to approaching traffic. Spacing should be such that the motorist always has three in view, until the change in alignment eliminates its need.
- To be effective, the chevron should be visible for at least 500 feet.
- Chevrons shall be orange with a black nonreflective legend. Sheeting for the chevron shall be retroreflective Type B or Type C conforming to Departmental Material Specification DMS-8300, unless noted otherwise. The legend shall meet the requirements of DMS-8300.
- For Long Term Stationary use on tapers or transitions on freeways and divided highways self-righting chevrons may be used to supplement plastic drums but not to replace plastic drums.

CHEVRONS

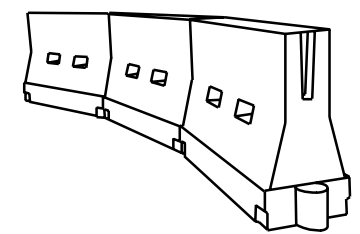

LONGITUDINAL CHANNELIZING DEVICES (LCD)

- LCDs are crashworthy, lightweight, deformable devices that are highly visible, have good target value and can be connected together. They are not designed to contain or redirect a vehicle on impact.
- LCDs may be used instead of a line of cones or drums.
- LCDs shall be placed in accordance to application and installation requirements specific to the device, and used only when shown on the CWZTCD list.
- LCDs should not be used to provide positive protection for obstacles, pedestrians or workers.
- LCDs shall be supplemented with retroreflective delineation as required for temporary barriers on BC(7) when placed roughly parallel to the travel lanes.
- LCDs used as barricades placed perpendicular to traffic should have at least one row of reflective sheeting meeting the requirements for barricade rails as shown on BC(10) placed near the top of the LCD along the full length of the device.

WATER BALLASTED SYSTEMS USED AS BARRIERS

- Water ballasted systems used as barriers shall not be used solely to channelize road users, but also to protect the work space per the appropriate NCHRP 350 crashworthiness requirements based on roadway speed and barrier application.
- Water ballasted systems used to channelize vehicular traffic shall be supplemented with retroreflective delineation or channelizing devices to improve daytime/nighttime visibility. They may also be supplemented with pavement markings.
- Water ballasted systems used as barriers shall be placed in accordance to application and installation requirements specific to the device, and used only when shown on the CWZTCD list.
- Water ballasted systems used as barriers should not be used for a merging taper except in low speed (less than 45 MPH) urban areas. When used on a taper in a low speed urban area, the taper shall be delineated and the taper length should be designed to optimize road user operations considering the available geometric conditions.
- When water ballasted systems used as barriers have blunt ends exposed to traffic, they should be attenuated as per manufacturer recommendations or flared to a point outside the clear zone.

If used to channelize pedestrians, longitudinal channelizing devices or water ballasted systems must have a continuous detectable bottom for users of long cones and the top of the unit shall not be less than 32 inches in height.

HOLLOW OR WATER BALLASTED SYSTEMS USED AS LONGITUDINAL CHANNELIZING DEVICES OR BARRIERS

GENERAL NOTES

- Work Zone channelizing devices illustrated on this sheet may be installed in close proximity to traffic and are suitable for use on high or low speed roadways. The Engineer/Inspector shall ensure that spacing and placement is uniform and in accordance with the "Texas Manual on Uniform Traffic Control Devices" (TMUTCD).
- Channelizing devices shown on this sheet may have a driveable, fixed or portable base. The requirement for self-righting channelizing devices must be specified in the General Notes or other plan sheets.
- Channelizing devices on self-righting supports should be used in work zone areas where channelizing devices are frequently impacted by errant vehicles or vehicle related wind gusts making alignment of the channelizing devices difficult to maintain. Locations of these devices shall be detailed elsewhere in the plans. These devices shall conform to the TMUTCD and the "Compliant Work Zone Traffic Control Devices List" (CWZTCD).
- The Contractor shall maintain devices in a clean condition and replace damaged, nonreflective, faded, or broken devices and bases as required by the Engineer/Inspector. The Contractor shall be required to maintain proper device spacing and alignment.
- Portable bases shall be fabricated from virgin and/or recycled rubber. The portable bases shall weigh a minimum of 30 lbs.
- Pavement surfaces shall be prepared in a manner that ensures proper bonding between the adhesives, the fixed mount bases and the pavement surface. Adhesives shall be prepared and applied according to the manufacturer's recommendations.
- The installation and removal of channelizing devices shall not cause detrimental effects to the final pavement surfaces, including pavement surface discoloration or surface integrity. Driveable bases shall not be permitted on final pavement surfaces. The Engineer/Inspector shall approve all application and removal procedures of fixed bases.

Posted Speed x	Formula	Minimum Desirable Taper Lengths x x			Suggested Maximum Spacing of Channelizing Devices	
		10' Offset	11' Offset	12' Offset	On a Taper	On a Tangent
30	L = WS ² / 60	150'	165'	180'	30'	60'
35		205'	225'	245'	35'	70'
40		265'	295'	320'	40'	80'
45	L = WS	450'	495'	540'	45'	90'
50		500'	550'	600'	50'	100'
55		550'	605'	660'	55'	110'
60		600'	660'	720'	60'	120'
65		650'	715'	780'	65'	130'
70		700'	770'	840'	70'	140'
75		750'	825'	900'	75'	150'
80		800'	880'	960'	80'	160'

x x Taper lengths have been rounded off.
L=Length of Taper (FT.) W=Width of Offset (FT.)
S=Posted Speed (MPH)

SUGGESTED MAXIMUM SPACING OF CHANNELIZING DEVICES AND MINIMUM DESIRABLE TAPER LENGTHS

SHEET 9 OF 12




BARRICADE AND CONSTRUCTION CHANNELIZING DEVICES

BC(9)-14

FILE: bc-14.dgn	DN: TxDOT	CK: TxDOT	DW: TxDOT	CK: TxDOT
© TxDOT November 2002	CONT	SECT	JOB	HIGHWAY
REVISIONS	---	---	---	---
9-07 8-14	DIST	COUNTY	SHEET NO.	
7-13	---	---	15	





DATE:
FILE:

OPPOSING TRAFFIC LANE DIVIDERS (OTLD)

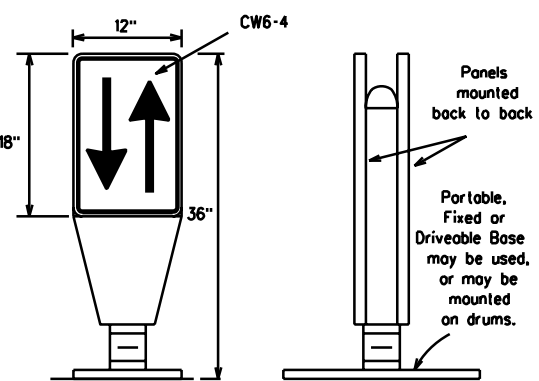



- Opposing Traffic Lane Dividers (OTLD) are delineation devices designed to convert a normal one-way roadway section to two-way operation. OTLD's are used on temporary centerlines. The upward and downward arrows on the sign's face indicate the direction of traffic on either side of the divider. The base is secured to the pavement with an adhesive or rubber weight to minimize movement caused by a vehicle impact or wind gust.
- The OTLD may be used in combination with 42" cones or VPs.
- Spacing between the OTLD shall not exceed 500 feet. 42" cones or VPs placed between the OTLD's should not exceed 100 foot spacing.
- The OTLD shall be orange with a black non-reflective legend. Sheeting for the OTLD shall be retroreflective Type B or Type C conforming to Departmental Material Specification DMS-8300, unless noted otherwise. The legend shall meet the requirements of DMS-8300.

PAVEMENT MARKING PATTERNS

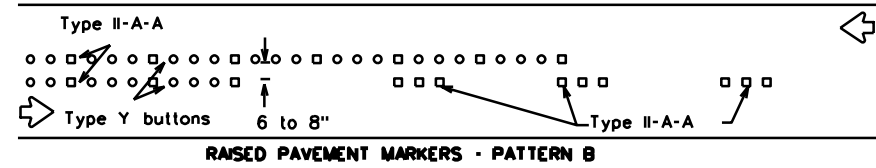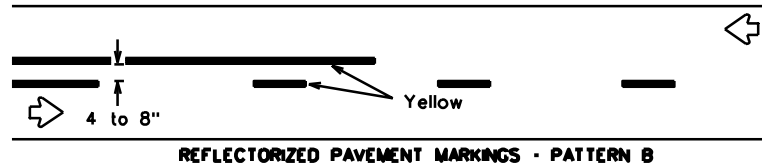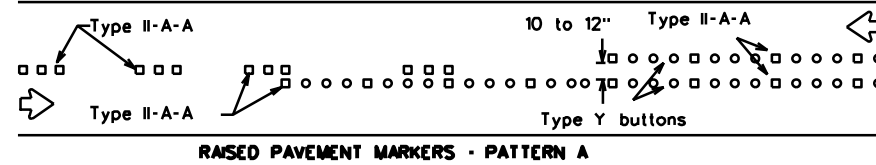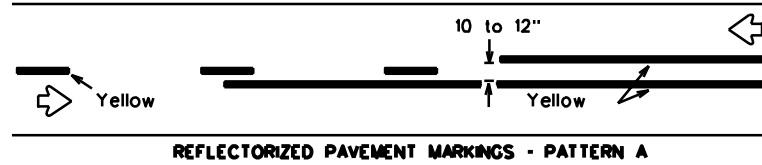



Pattern A is the TXDOT Standard, however Pattern B may be used if approved by the Engineer. Prefabricated markings may be substituted for reflectorized pavement markings.

CENTER LINE & NO-PASSING ZONE BARRIER LINES FOR TWO-LANE, TWO-WAY HIGHWAYS

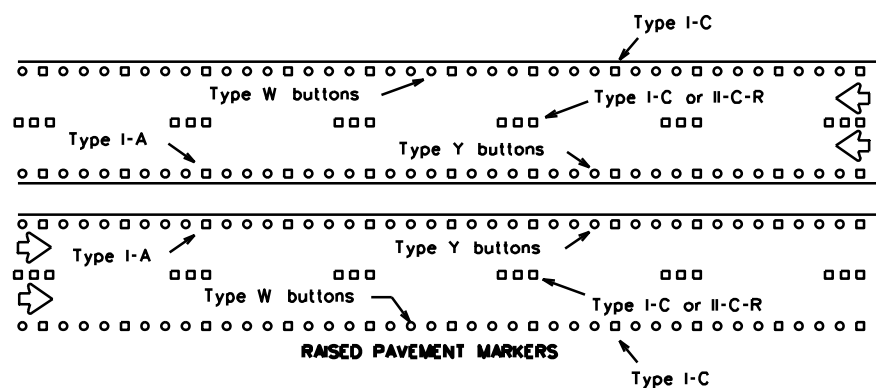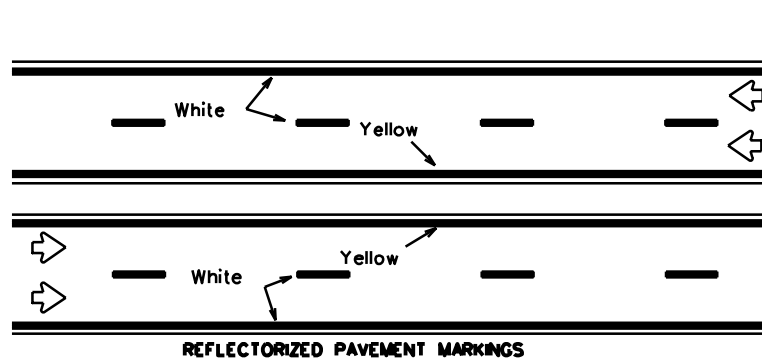



Prefabricated markings may be substituted for reflectorized pavement markings.

EDGE & LANE LINES FOR DIVIDED HIGHWAY

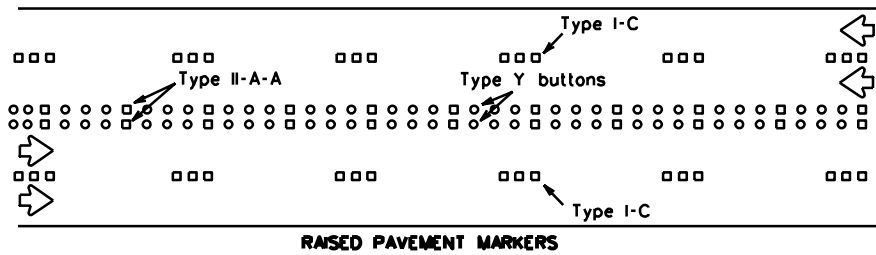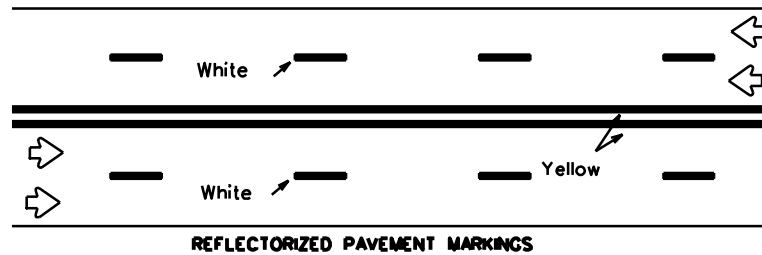

Prefabricated markings may be substituted for reflectorized pavement markings.


LANE & CENTER LINES FOR MULTILANE UNDIVIDED HIGHWAYS

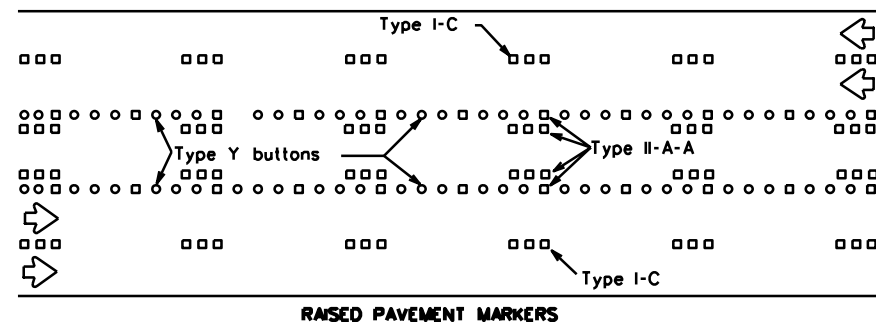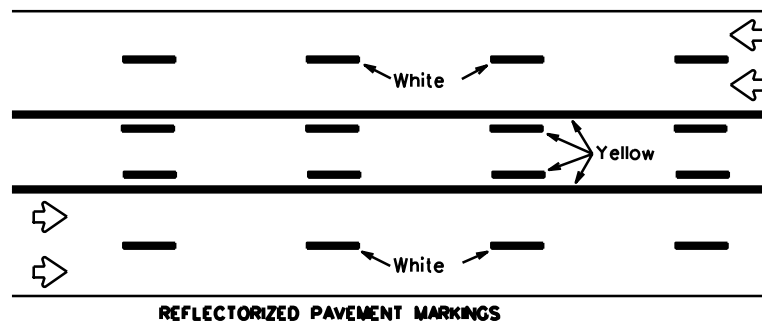




Prefabricated markings may be substituted for reflectorized pavement markings.

TWO-WAY LEFT TURN LANE


STANDARD WORK ZONE PAVEMENT MARKINGS DETAILS

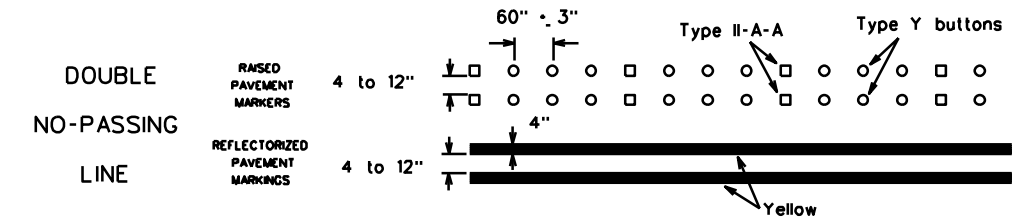

SOLID LINES

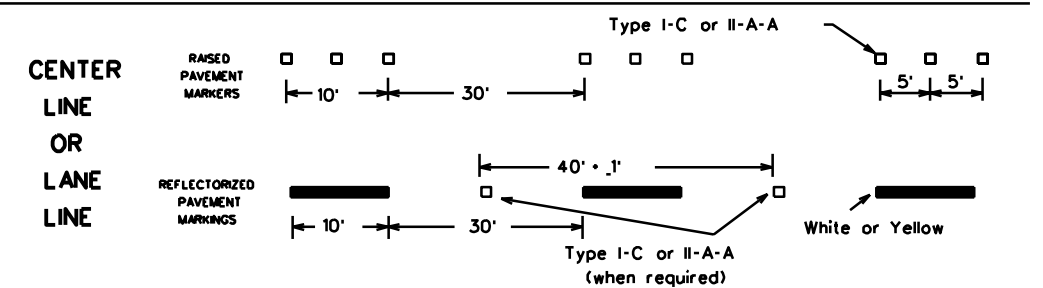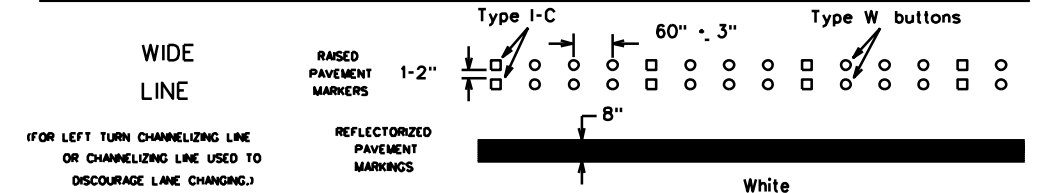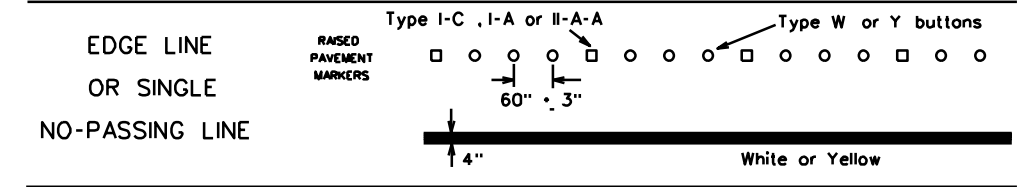


BROKEN LINES

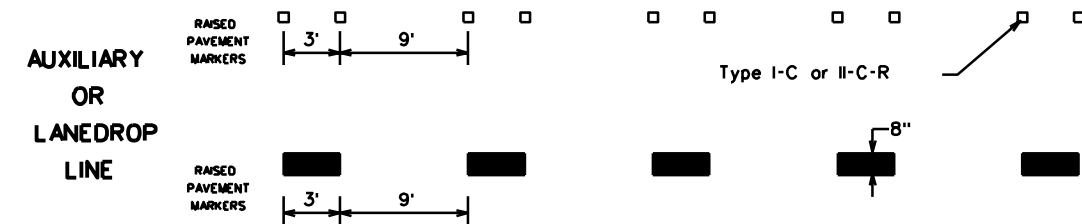

REMOVABLE MARKINGS WITH RAISED PAVEMENT MARKERS

If raised pavement markers are used to supplement REMOVABLE markings, the markers shall be applied to the top of the tape at the approximate mid length of tape used for broken lines or at 20 foot spacing for solid lines. This allows an easier removal of raised pavement markers and tape.

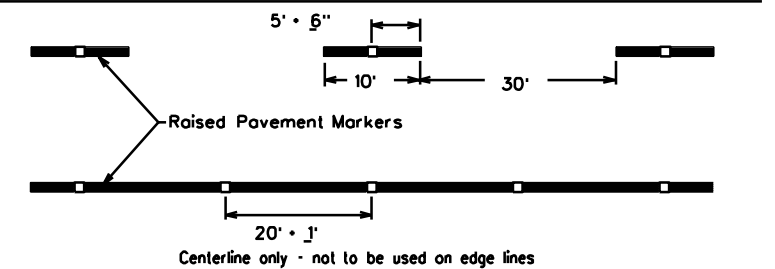

SHEET 12 OF 12



BARRICADE AND CONSTRUCTION PAVEMENT MARKING PATTERNS

BC(12)-14

Raised pavement markers used as standard pavement markings shall be from the approved products list and meet the requirements of Item 672 "RAISED PAVEMENT MARKERS."


FILE: bc-14.dgn	DN: TxDOT	CK: TxDOT	DW: TxDOT	CK: TxDOT
© TxDOT February 1998	CONT	SECT	JOB	HIGHWAY
REVISIONS	---	---	---	---
1-97 9-07				
2-98 7-13				
11-02 8-14				
	DIST	COUNTY	SHEET NO.	
	---	---	16	

DISCLAIMER: The use of this standard is governed by the "Texas Engineering Practice Act". No warranty of any kind is made by TxDOT for any purpose whatsoever. TxDOT assumes no responsibility for the conversion of this standard to other formats or for incorrect results or damages resulting from its use.


DATE: FILE:

DISCLAIMER: The use of this standard is governed by the "Texas Engineering Practice Act". No warranty of any kind is made by TxDOT for any purpose whatsoever. TxDOT assumes no responsibility for the conversion of this standard to other formats or for incorrect results or damages resulting from its use.


DATE: FILE:

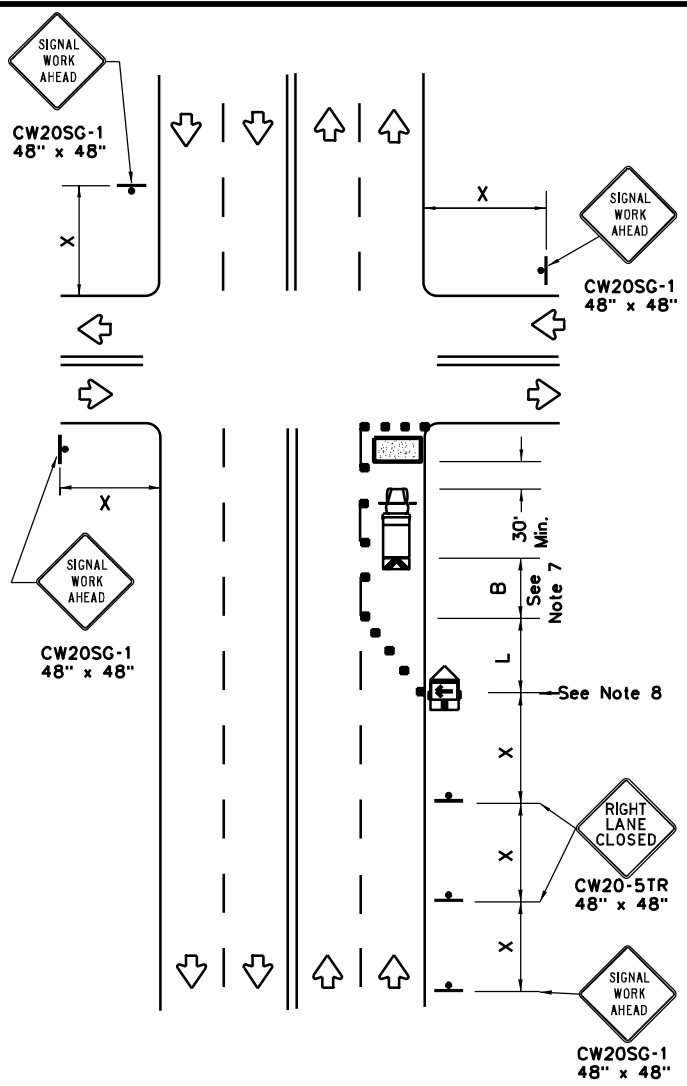

NEAR SIDE LANE CLOSURE
SHORT DURATION OR SHORT TERM STATIONARY

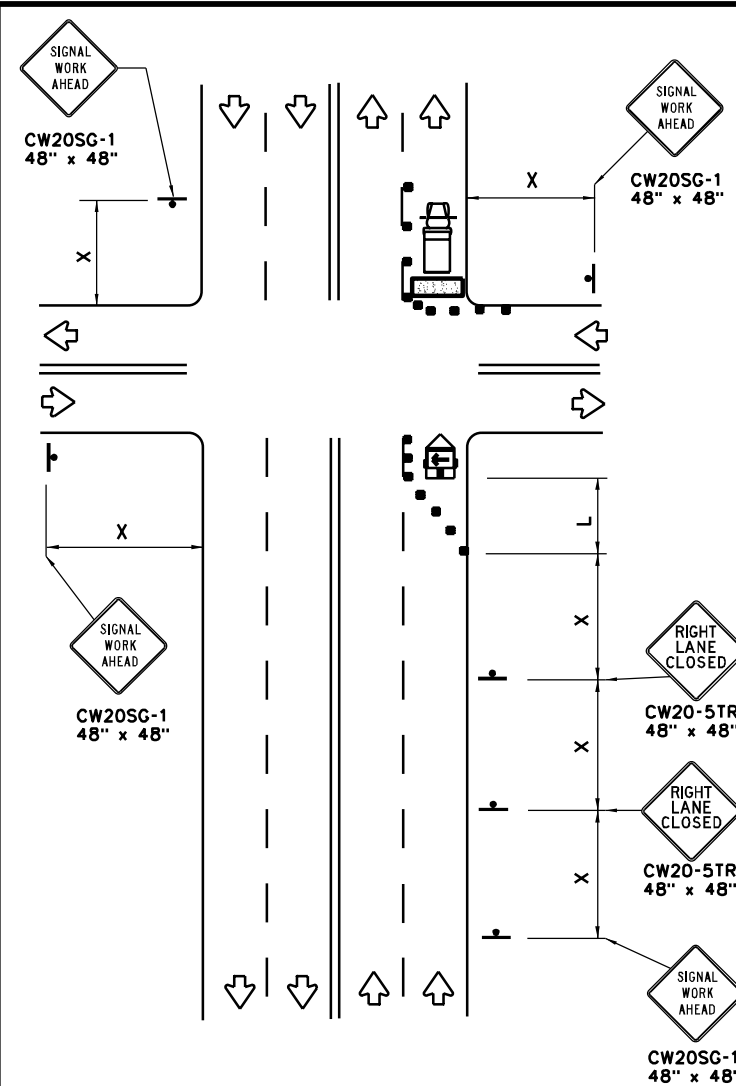

FAR SIDE RIGHT LANE CLOSURE
SHORT DURATION OR SHORT TERM STATIONARY

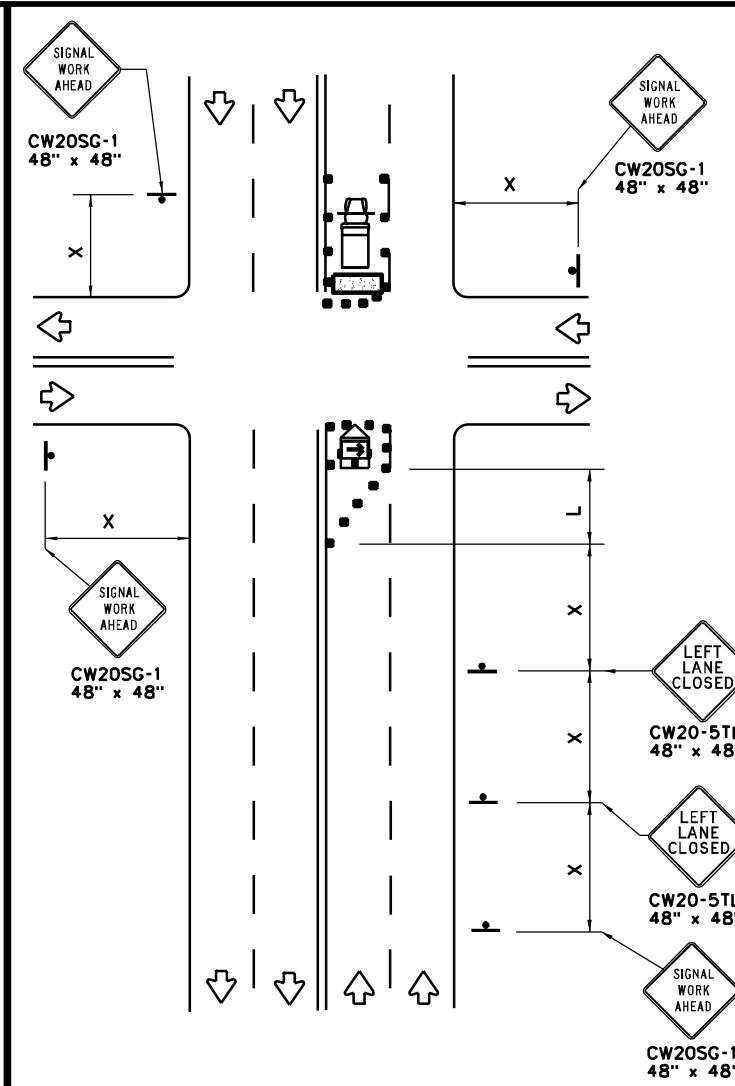


FAR SIDE LEFT LANE CLOSURE
SHORT DURATION OR SHORT TERM STATIONARY

LEGEND			
	Type 3 Barricade		Channelizing Devices
	Heavy Work Vehicle		Truck Mounted Attenuator (TMA)
	Trailer Mounted Flashing Arrow Board		Portable Changeable Message Sign (PCMS)
	Sign		Traffic Flow
	Flag		Flagger


Posted Speed x	Formula	Minimum Desirable Taper Lengths x x			Suggested Maximum Spacing of Channelizing Devices		Minimum Sign Spacing "x" Distance	Suggested Longitudinal Buffer Space "B"
		10' Offset	11' Offset	12' Offset	On a Taper	On a Tangent		
30	$L = \frac{WS^2}{60}$	150'	165'	180'	30'	60'	120'	90'
35		205'	225'	245'	35'	70'	160'	120'
40		265'	295'	320'	40'	80'	240'	155'
45	L - WS	450'	495'	540'	45'	90'	320'	195'
50		500'	550'	600'	50'	100'	400'	240'
55		550'	605'	660'	55'	110'	500'	295'
60		600'	660'	720'	60'	120'	600'	350'
65		650'	715'	780'	65'	130'	700'	410'
70		700'	770'	840'	70'	140'	800'	475'
75		750'	825'	900'	75'	150'	900'	540'

x Conventional Roads Only
 x x Taper lengths have been rounded off.
 L=Length of Taper(FT) W=Width of Offset(FT) S=Posted Speed(MPH)

WORKERS IN BUCKET TRUCKS SHALL NOT WORK ABOVE OPEN LANES OF TRAFFIC.

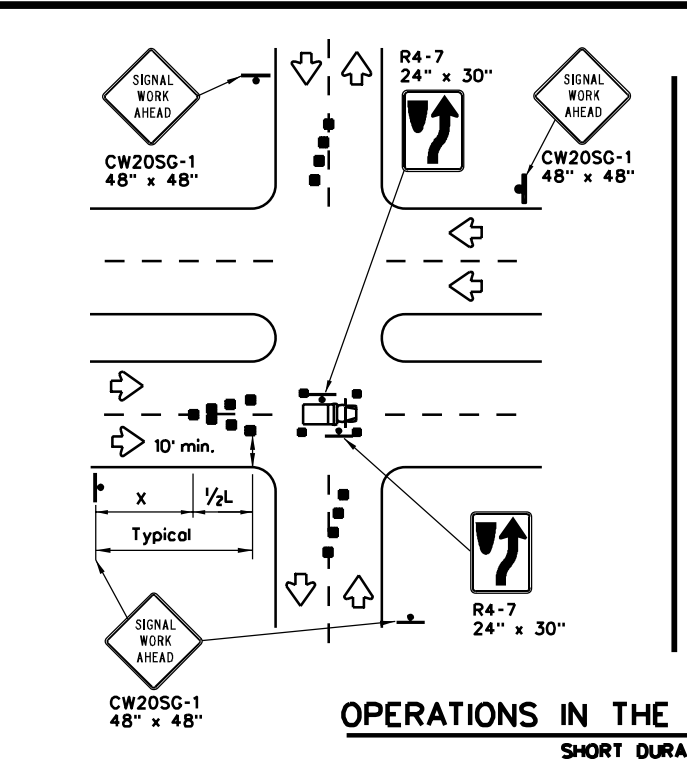

OPERATIONS IN THE INTERSECTION
SHORT DURATION

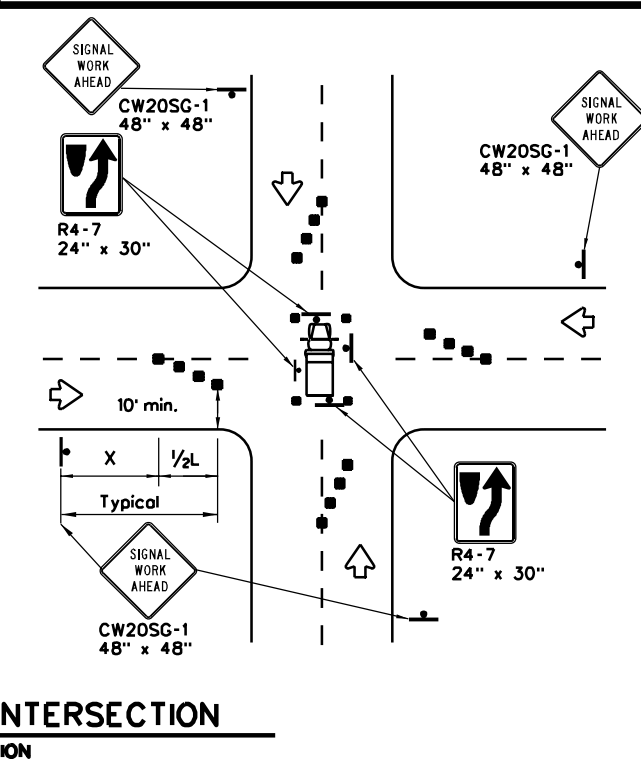

GENERAL NOTES


- The minimum size channelizing device is the 28" cone. 42" Two-piece cones, drums, vertical panels or barricades will be required when the device must be left unattended at night.
- Obstructions or hazards at the work area shall be clearly marked and delineated at all times.
- Flaggers and Flagger Symbol (CW20-7) signs may be required according to field conditions.
- Vehicles parked in roadway shall be equipped with at least two high intensity rotating, flashing, oscillating or strobe type lights.
- High level warning devices (flag trees) may be used at corners of the vehicle.
- When work operations are performed on existing signals, the signals may be placed in flashing red mode when approved by the engineer. If existing signals do not have power, All-Way Stop (R1-1 and R1-3P) signs may be implemented when approved by the engineer.
- For Short-Term Stationary work the buffer space "B" from the above table should be used if field conditions permit. For Short Duration (less than 1 hour) any buffer space provided will enhance the safety of the setup.
- The arrow board at this location may be omitted for Short Duration work if the work vehicle has an arrow board in operation. As an option, the arrow board may be placed at the end of the taper in the closed lane if space is not available at the beginning of the taper.
- Signs and devices for the NEAR SIDE LANE CLOSURE may be altered for a left lane closure by using a LEFT LANE CLOSED (CW20-5TL) and adding channelizing devices on the centerline to protect the work space from opposing traffic.

TRAFFIC SIGNAL WORK TYPICAL DETAILS

WZ(BTS-1)-13

FILE: wzbts-13.dgn	DN: TxDOT	CK: TxDOT	DW: TxDOT	CK: TxDOT
© TxDOT April 1992	CONT	SECT	JOB	HIGHWAY
REVISIONS
2-98 10-99 7-13	DIST	COUNTY	SHEET NO.	
4-98 3-03	17	

DISCLAIMER: The use of this standard is governed by the "Texas Engineering Practice Act". No warranty of any kind is made by TxDOT for any purpose whatsoever. TxDOT assumes no responsibility for the conversion of this standard to other formats or for incorrect results or damages resulting from its use.

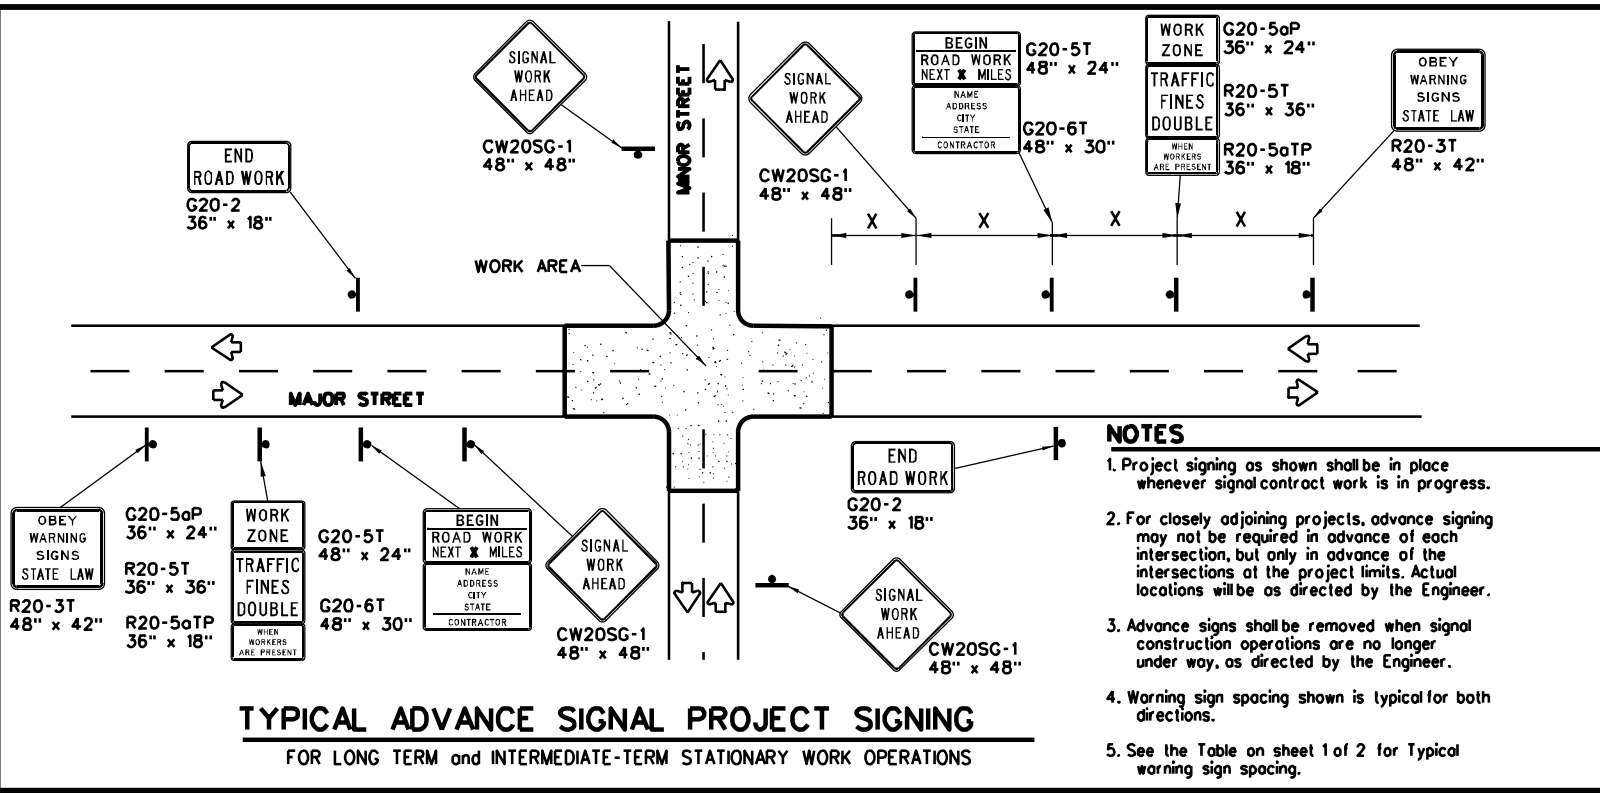

GENERAL NOTES FOR WORK ZONE SIGNS

- Signs shall be installed and maintained in a straight and plumb condition.
- Wooden sign posts shall be painted white.
- Barricades shall NOT be used as sign supports.
- Nails shall NOT be used to attach signs to any support.
- All signs shall be installed in accordance with the plans or as directed by the Engineer.
- The Contractor shall furnish the sign design shown in the plans or in the "Standard Highway Sign Designs for Texas" (SHSD).
- The Contractor shall furnish sign supports and substrates listed in the "Compliant Work Zone Traffic Control Device List" (CWZTCD), installed as per the manufacturer's recommendations.
- Temporary signs that have damaged or cracked substrates and/or damaged or marred reflective sheeting shall be replaced as directed by the Engineer.
- Identification markings may be shown only on the back of the sign substrate. The maximum height of letters and/or company logos used for identification shall be 1".
- Damaged wood posts shall be replaced. Splicing wood posts will not be allowed.

DURATION OF WORK

- Work zone durations are defined in Part 6, Section 6G.02 of the Texas Manual on Uniform Traffic Control Devices (TMUTCD).

SIGN MOUNTING HEIGHT

- Sign height of Long-term/Intermediate-term warning signs shall be as shown on Figure 6F-1 of the TMUTCD.
- Sign height of Short-term/Short Duration warning signs shall be as shown on Figure 6F-2 of the TMUTCD.
- Regulatory signs shall be mounted at least 7 feet, but not more than 9 feet, above the paved surface regardless of work duration.

REMOVING OR COVERING

- When sign messages may be confusing or do not apply, the signs shall be removed or completely covered, unless otherwise approved by the Engineer.
- When signs are covered, the material used shall be opaque, such as heavy mil black plastic, or other materials which will cover the entire sign face and maintain their opaque properties under automobile headlights at night without damaging the sign sheeting. Burlap, or heavy materials such as plywood or aluminum shall not be used to cover signs.
- Duct tape or other adhesive material shall NOT be affixed to a sign face.
- Signs and anchor stubs shall be removed and holes backfilled upon completion of the work.

REFLECTIVE SHEETING

- All signs shall be retroreflective and constructed of sheeting meeting the requirements of the DMS and color usage table shown on this sheet.

SIGN SUPPORT WEIGHTS

- Weights used to keep signs from turning over should be sandbags filled with dry, cohesionless material.
- The sandbags will be tied shut to keep the sand from spilling and to maintain a constant weight.
- Rock, concrete, iron, steel or other solid objects will not be permitted for use as sign support weights.
- Sandbags should weigh a minimum of 35 lbs and a maximum of 50 lbs.
- Sandbags shall be made of a durable material that tears upon vehicular impact. Rubber, such as tire inner tubes, shall not be used.
- Rubber ballasts designed for channelizing devices should not be used for ballast on portable sign supports. Sign supports designed and manufactured with rubber bases may be used when shown on the CWZTCD list.
- Sandbags shall only be placed along or laid over the base supports of the traffic control device and shall not be suspended above ground level or hung with rope, wire, chains or other fasteners. Sandbags shall be placed along the length of the skids to weigh down the sign support.
- Sandbags shall NOT be placed under the skid and shall not be used to level sign supports placed on slopes.

LEGEND




	Sign
	Channelizing Devices
	Type 3 Barricade

DEPARTMENTAL MATERIAL SPECIFICATIONS

SIGN FACE MATERIALS	DMS-8300
FLEXIBLE ROLL-UP REFLECTIVE SIGNS	DMS-8310

COLOR	USAGE	SHEETING MATERIAL
ORANGE	BACKGROUND	TYPE B _{FL} OR TYPE C _{FL} SHEETING
WHITE	BACKGROUND	TYPE A SHEETING
BLACK	LEGEND & BORDERS	ACRYLIC NON-REFLECTIVE SHEETING

Only pre-qualified products shall be used. A copy of the "Compliant Work Zone Traffic Control Devices List" (CWZTCD) describes pre-qualified products and their sources and may be found at the following web address:
http://www.txdot.gov/txdot_library/publications/construction.htm

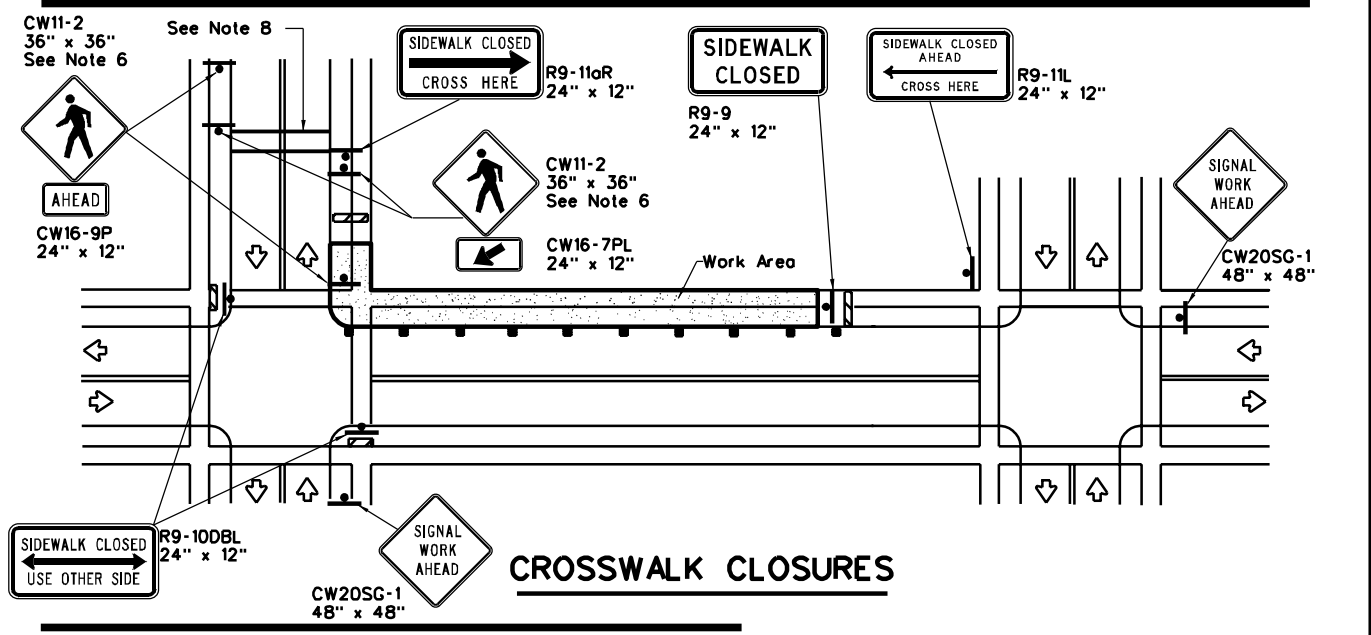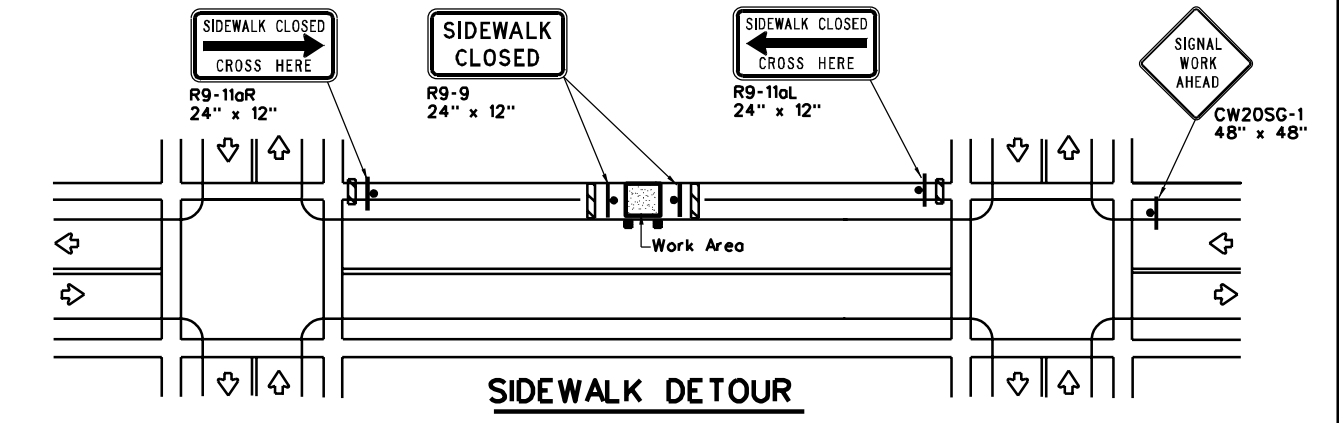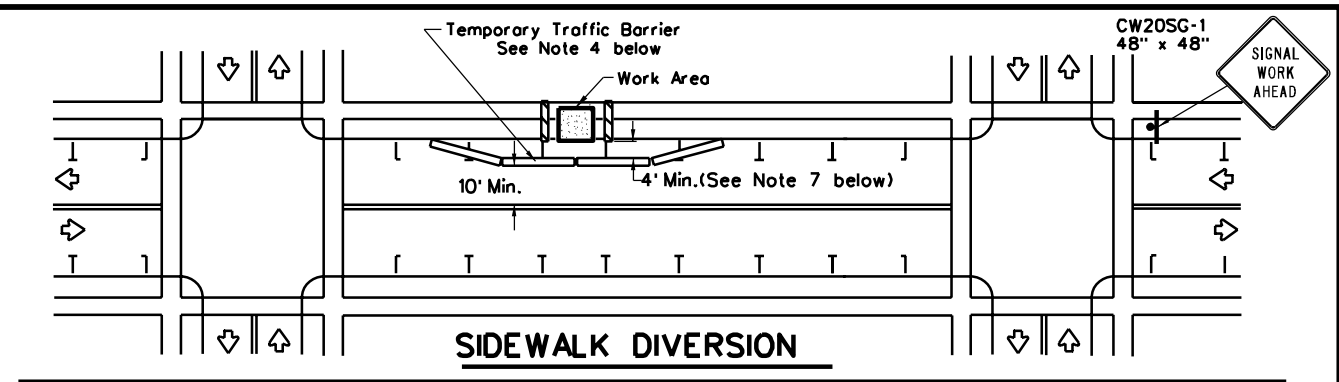

PEDESTRIAN CONTROL




- Holes, trenches or other hazards shall be adequately protected by covering, delineating or surrounding the hazard with orange plastic pedestrian fencing or longitudinal channelizing devices, or as directed by the Engineer.
- "CROSSWALK CLOSURES" as detailed above will require the Engineer's approval prior to installation.
- R9 series signs shown may be placed on supports detailed on the BC standards or CWZTCD list, or when fabricated from approved lightweight plastic substrates, they may be mounted on top of a plastic drum at or near the location shown.
- For speeds less than 45 mph longitudinal channelizing devices may be used instead of traffic barriers when approved by the Engineer. Attenuation of blunt ends and installation of water filled devices shall be as per BC(9) and manufacturer's recommendations.
- Location of devices are for general guidance. Actual device spacing and location must be field adjusted to meet actual conditions.
- Where pedestrians with visual disabilities normally use the closed sidewalk Detectable Pedestrian Barricades should be used instead of the Type 3 Barricades shown.
- The width of existing sidewalk should be maintained if practical.
- Pavement markings for mid-block crosswalks shall be paid for under the appropriate bid items.
- When crosswalks or other pedestrian facilities are closed or relocated, temporary facilities shall be detectable and shall include accessibility features consistent with the features present in the existing pedestrian facility.



TRAFFIC SIGNAL WORK BARRICADES AND SIGNS

WZ(BTS-2)-13





FILE: wzbts-13.dgn	DN: TxDOT	CK: TxDOT	DW: TxDOT	CK: TxDOT
© TxDOT April 1992	CONT	SECT	JOB	HIGHWAY
REVISIONS	---	---	---	---
2-98 10-99 7-13	DIST	COUNTY	SHEET NO.	
4-98 3-03	---	---	18	

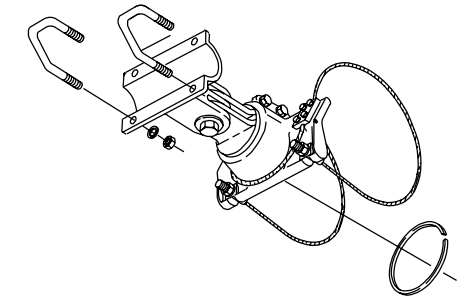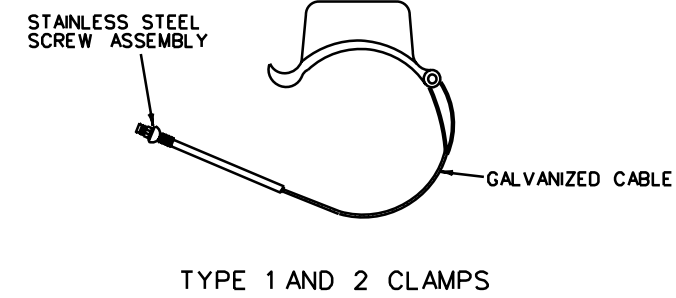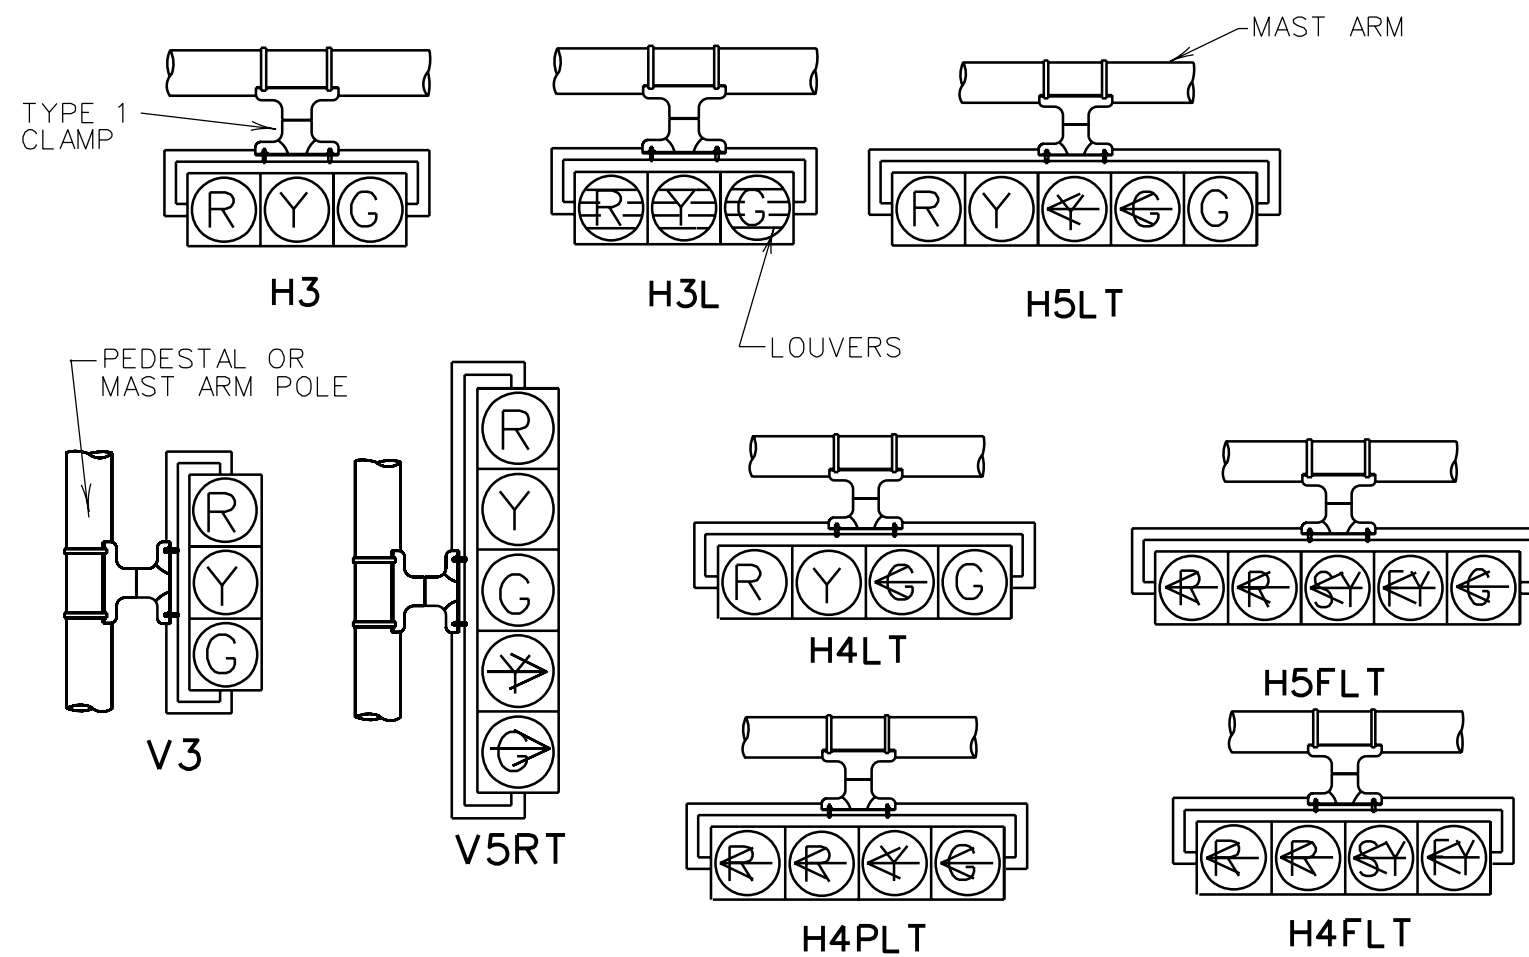

SHALL BE INSTALLED WHEN ROTATION ABOUT THE HORIZONTAL AND VERTICAL AXES ARE NEEDED.

NOTES:

1. VEHICLE SIGNAL HEADS SHALL BE MOUNTED WITH TYPE 1 CLAMP AND APPROPRIATE TUBING.
2. ALL POLE MOUNTED VEHICLE HEADS SHALL BE INSTALLED ON THE AWAY-FROM-TRAFFIC SIDE OF THE PEDESTAL OR MAST ARM POLE.
3. THE SIGNAL HEADS SHOWN ARE NOT MEANT TO REFLECT ALL POSSIBLE SIGNAL HEADS, BUT ARE REPRESENTATIVE OF SIGNAL HEADS COMMONLY IN USE. SEE THE TRAFFIC SIGNAL LAYOUT FOR REQUIRED SIGNAL HEADS, AND THE NUMBER AND ORIENTATION OF LOUVERS.

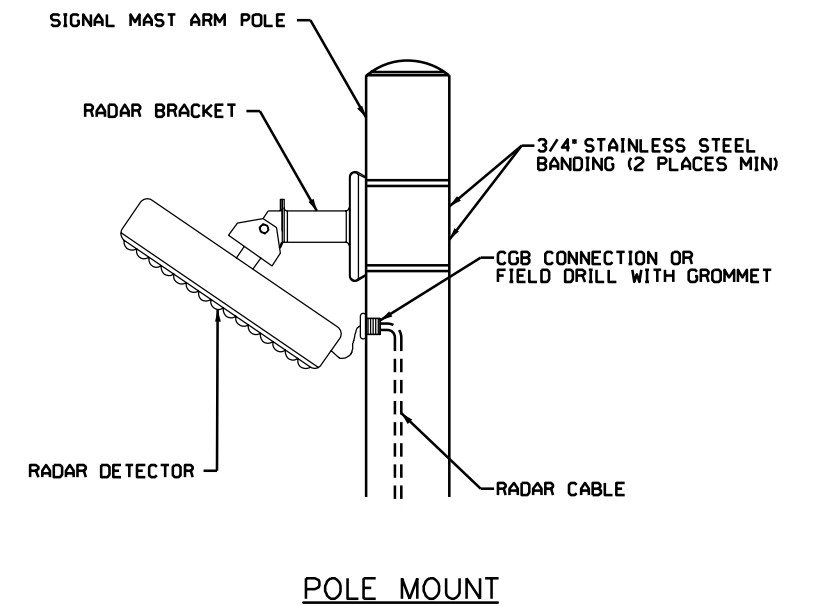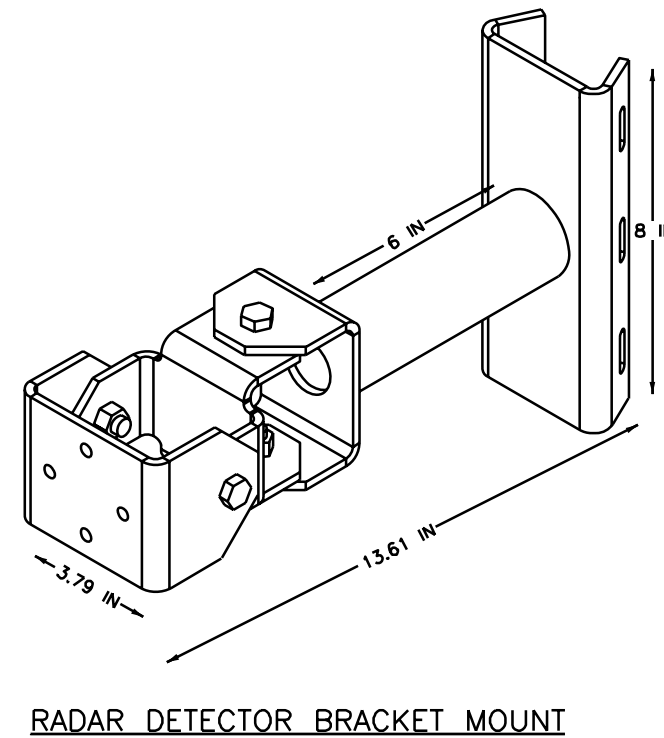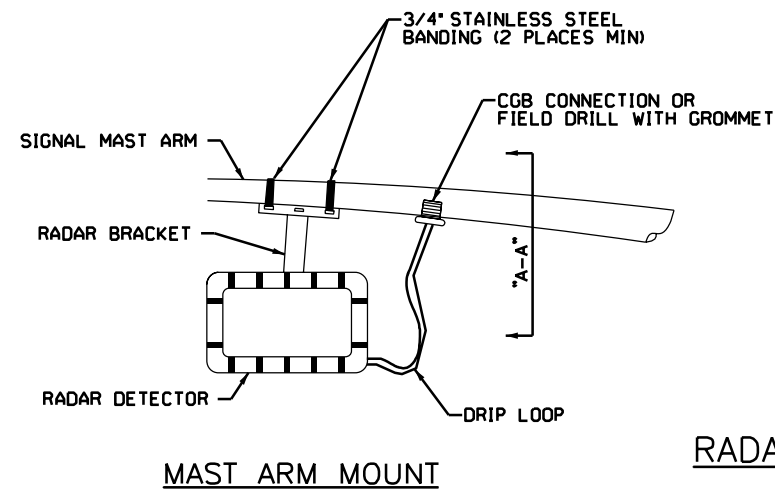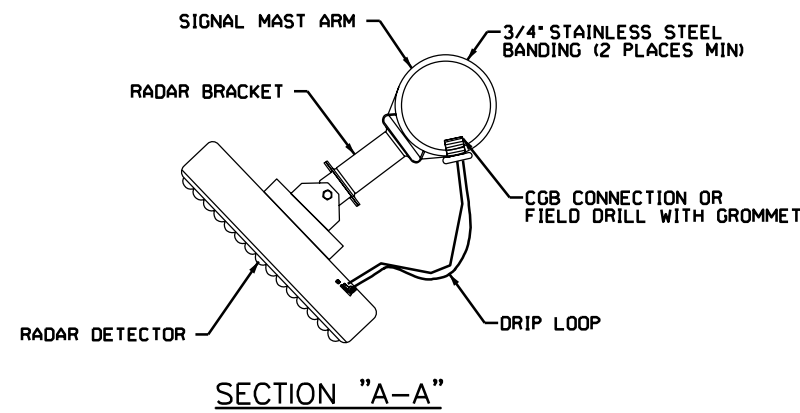


RADAR DETECTION INSTALLATION


TRAFFIC SIGNAL HEAD AND RADAR INSTALLATION DETAILS

© TXDOT 2015
DALLAS DISTRICT STANDARD


FED. DIV. NO.	FEDERAL AID PROJECT NO.	SHEET NO.
6	(SEE TITLE SHEET)	19
STATE	STATE DIST.	COUNTY
TEXAS
COUNT.	SECT.	JOB HIGHWAY NO.
...

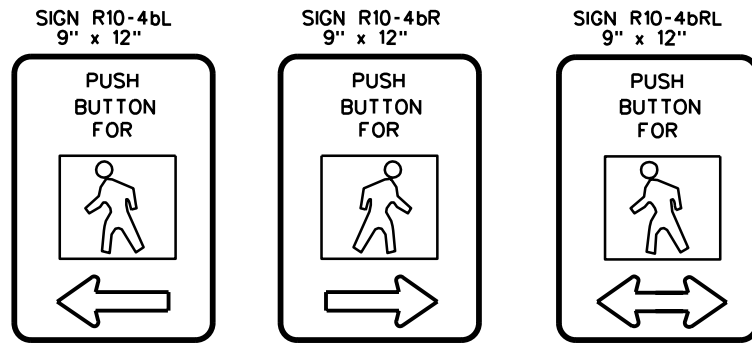


PEDESTRIAN PUSHBUTTON SIGN DETAILS

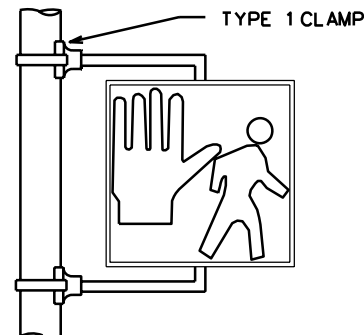


PEDESTRIAN SIGNAL HEAD MOUNTING FOR ONE PEDESTRIAN SIGNAL HEAD 152A

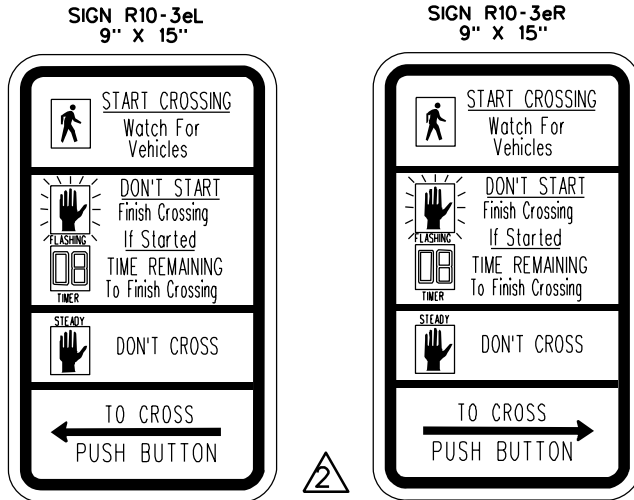


COUNTDOWN PEDESTRIAN PUSHBUTTON SIGN DETAILS

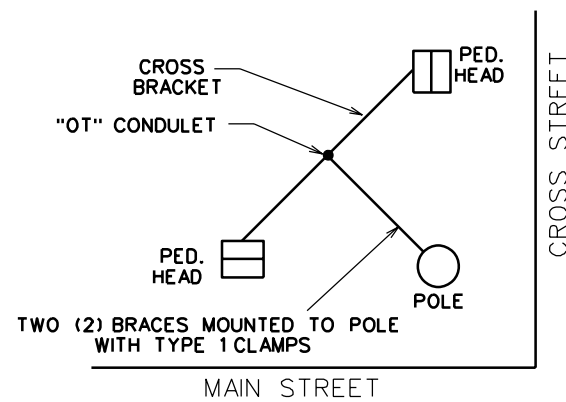

PEDESTRIAN SIGNAL HEAD MOUNTING FOR TWO PEDESTRIAN SIGNAL HEADS 143C


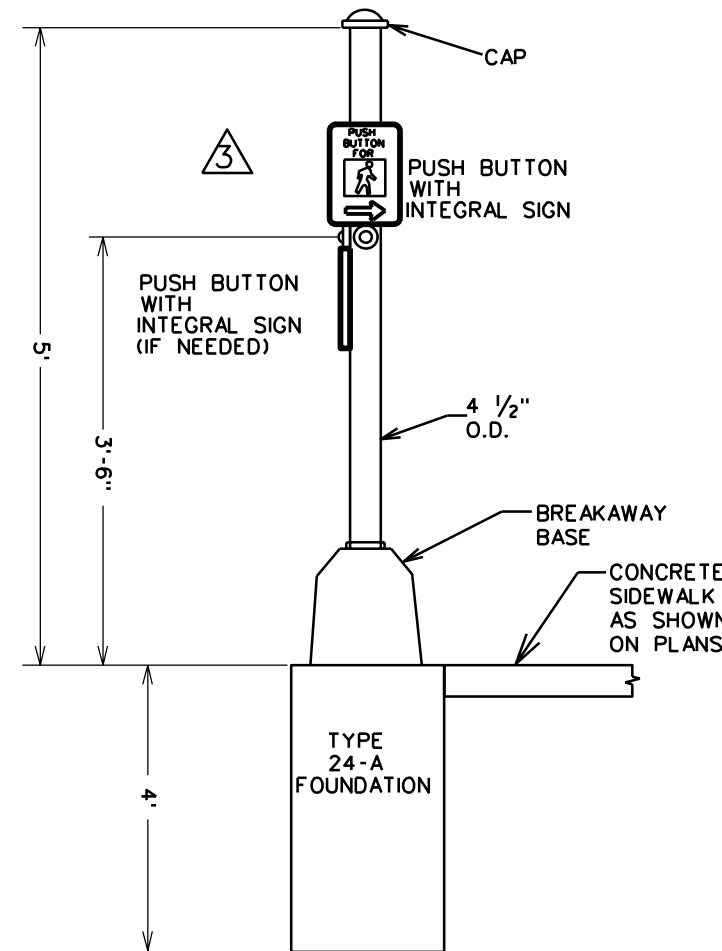


PEDESTRIAN PUSH BUTTON POLE

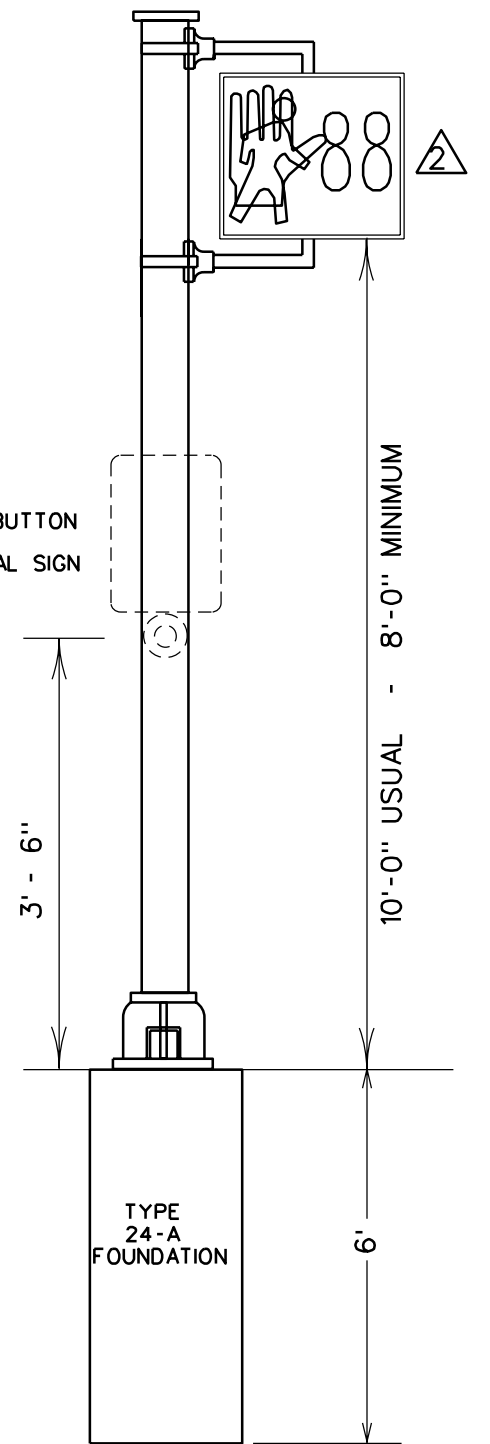

PEDESTAL POLE

NOTE: CLAM SHELL MOUNTING HARDWARE MAY BE USED INSTEAD OF MOUNTING HARDWARE SHOWN ABOVE, AS APPROVED BY THE ENGINEER. ICC P/N 4805 OR McCAIN QUICKMOUNT OR APPROVED EQUAL.

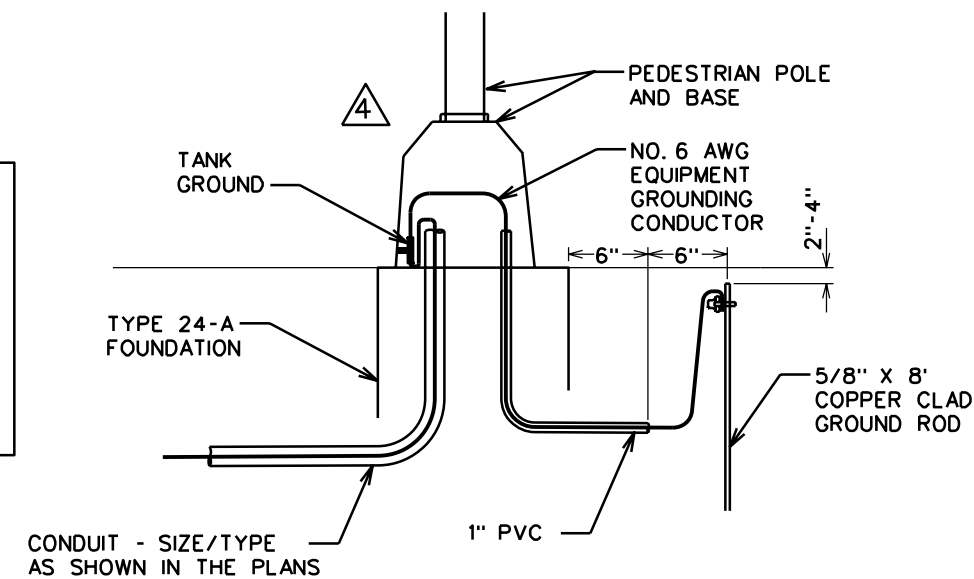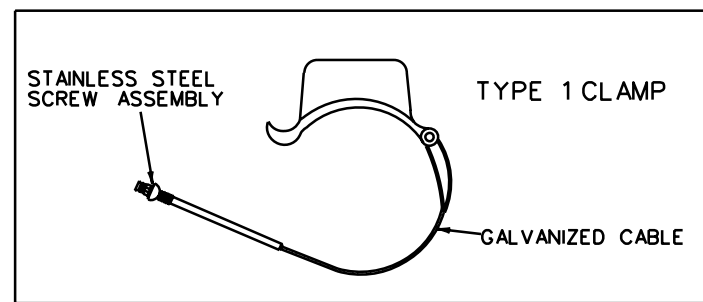

PEDESTRIAN PUSH BUTTON POLE GROUNDING DETAILS

NOTE: THE POLES ON THIS DRAWING ARE SHOWN AS AN EXAMPLE ONLY. POLES OF SIMILAR DESIGN FOR ANY CROSS SECTION WHICH MEET THE SPECIFICATIONS AND REQUIREMENTS SHOWN ON THESE DRAWINGS AND ARE APPROVED BY THE ENGINEER WILL BE DEEMED ACCEPTABLE.

- NOTES:
1. PEDESTRIAN SIGNAL HEADS SHALL BE MOUNTED WITH TYPE 1 CLAMPS AND APPROPRIATE TUBING.
 2. ALL PEDESTRIAN SIGNAL HEADS SHALL BE INSTALLED ON THE AWAY-FROM-TRAFFIC SIDE OF THE PEDESTAL OR MAST ARM POLE.
 3. ALL WIRING FOR PEDESTRIAN SIGNALS SHALL BE TOTALLY ENCLOSED WITHIN THE SIGNAL MOUNTING HARDWARE.
 4. ALL PEDESTRIAN SIGNAL HEADS AND PUSH BUTTON SIGNS SHALL DISPLAY THE SYMBOLIZED MESSAGES SHOWN ABOVE.

DALLAS DISTRICT STANDARD

FED. DIV. NO.	PROJECT NO.	SHEET NO.
6	(SEE TITLE SHEET)	20
STATE	STATE	COUNTY
TEXAS
CONV.	SECT.	JOB HIGHWAY NO.
...

PEDESTRIAN SIGNAL HEAD IDENTIFICATION

DISCLAIMER: The use of this standard is governed by the "Texas Engineering Practice Act". No warranty of any kind is made by TxDOT for any purpose whatsoever. TxDOT assumes no responsibility for the conversion of this standard to other formats or damages resulting from its use.

Arm Length	ROUND POLES					POLYGONAL POLES					Foundation Type
	D ₈	D ₁₉	D ₂₄	D ₃₀	① thk	D ₈	D ₁₉	D ₂₄	D ₃₀	① thk	
ft.	in.	in.	in.	in.	in.	in.	in.	in.	in.	in.	
20	10.5	7.8	7.1	6.3	.179	11.5	8.5	7.7	6.8	.179	30-A
24	11.0	8.3	7.6	6.8	.179	12.0	9.0	8.2	7.3	.179	30-A
28	11.5	8.8	8.1	7.3	.179	12.5	9.5	8.7	7.8	.179	30-A
32	12.5	9.8	9.1	8.3	.179	12.0	9.0	8.2	7.3	.239	30-A
36	12.0	9.3	8.6	7.8	.239	12.5	9.5	8.7	7.8	.239	36-A
40	12.0	9.3	8.6	7.8	.239	13.5	10.5	9.7	8.8	.239	36-A
44	12.5	9.8	9.1	8.3	.239	14.0	11.0	10.2	9.3	.239	36-A
48	13.0	10.3	9.6	8.8	.239	15.0	12.0	11.2	10.3	.239	36-A

Arm Length	ROUND ARMS					POLYGONAL ARMS				
	L ₁	D ₁	D ₂	① thk	Rise	L ₁	D ₁	② D ₂	① thk	Rise
ft.	ft.	in.	in.	in.		ft.	in.	in.	in.	
20	19.1	6.5	3.8	.179	1'-9"	19.1	7.0	3.5	.179	1'-8"
24	23.1	7.5	4.3	.179	1'-10"	23.1	7.5	3.5	.179	1'-9"
28	27.1	8.0	4.2	.179	1'-11"	27.1	8.0	3.5	.179	1'-10"
32	31.0	9.0	4.7	.179	2'-1"	31.0	9.0	3.5	.179	2'-0"
36	35.0	9.5	4.6	.179	2'-4"	35.0	10.0	3.5	.179	2'-1"
40	39.0	9.5	4.1	.239	2'-8"	39.0	9.5	3.5	.239	2'-3"
44	43.0	10.0	4.1	.239	2'-11"	43.0	10.0	3.5	.239	2'-6"
48	47.0	10.5	4.1	.239	3'-4"	47.0	11.0	3.5	.239	2'-9"


- D₈ • Pole Base O.D.
 - D₁₉ • Pole Top O.D. with no Luminaire and no ILSN
 - D₂₄ • Pole Top O.D. with ILSN w/out Luminaire
 - D₃₀ • Pole Top O.D. with Luminaire
 - D₁ • Arm Base O.D.
 - D₂ • Arm End O.D.
 - L₁ • Shaft Length
 - L • Nominal Arm Length
- ① Thickness shown are minimums, thicker materials may be used.
- ② D₂ may be increased by up to 1" for polygonal arms.

RECORD DRAWINGS

THESE RECORD DRAWINGS HAVE BEEN PREPARED TO REFLECT ANY CHANGES AND/OR MODIFICATIONS MADE TO THE DESIGN PLANS, PROVIDED BY THE CONTRACTOR AND THE CITY INSPECTOR. UNLESS OTHERWISE NOTED, THE PROJECT HAS BEEN CONSTRUCTED IN SUBSTANTIAL CONFORMANCE WITH THE DESIGN DRAWINGS. THE ENGINEERING CONSULTANT IS NOT RESPONSIBLE FOR ACCURACY AND COMPLETENESS EXCEPT FOR WHAT WAS PROVIDED BY THE CONTRACTOR. THE PLAN SET USED FOR BIDDING ORIGINALLY SEALED 5/4/2016 AND REVISED 8/8/2016.

Thomas P. Grant, PE 2/20/2017
SIGNATURE DATE

THOMAS P. GRANT, P.E., KIMLEY-HORN AND ASSOCIATES, INC.

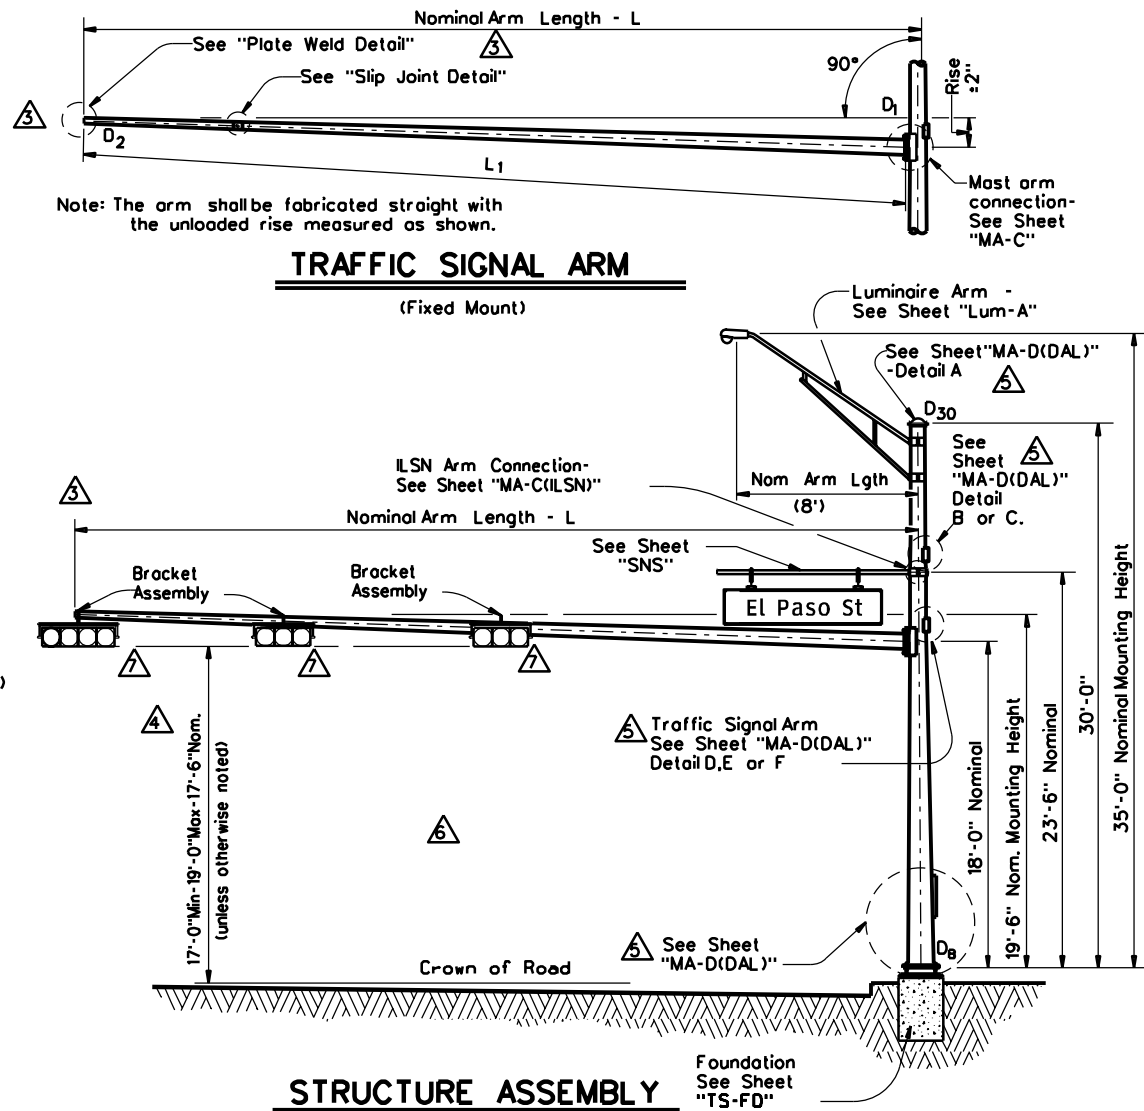

- MODIFICATIONS:**
- ▲ REPLACED CGB CONNECTOR WITH BRACKET ASSEMBLY.(2/12)
 - ▲ ADDITIONAL OPTION.(3/12)
 - ▲ REPLACED TENON DETAIL WITH PLATE WELD DETAIL.(2/12)
 - ▲ REVISED MINIMUM SIGNAL HEIGHT.(3/12)
 - ▲ REPLACED "MA-D" WITH "MA-D(DAL)".(2/12)
 - ▲ REMOVED TABLE OF DIMENSIONS "A".(2/12)
 - ▲ REMOVED CGB CONNECTORS.(2/12)

SHIPPING PARTS LIST						
Ship each pole with the following attached: enlarged hand hole, pole cap, fixed-arm connection bolts and washers and any additional hardware listed in the table.						
Nominal Arm Length	30' Poles With Luminaire		24' Poles With ILSN		19' Poles With No Luminaire and No ILSN	
	Above hardware plus: One (or two if ILSN attached) small hand hole, clamp-on simplex		Above hardware plus one small hand hole		See note above	
ft	Designation	Quantity	Designation	Quantity	Designation	Quantity
20	20L-80		20S-80		20-80	
24	24L-80		24S-80		24-80	
28	28L-80		28S-80		28-80	
32	32L-80		32S-80		32-80	
36	36L-80		36S-80		36-80	
40	40L-80	1	40S-80		40-80	
44	44L-80	1	44S-80		44-80	
48	48L-80	1	48S-80		48-80	

Traffic Signal Arms (1 per Pole)			Ship each arm with the listed equipment attached			
Nominal Arm Length	Type I Arm (1 Signal)	Type II Arm (2 Signals)	Type II Arm (2 Signals)		Type III Arm (3 Signals)	
	1 Bracket Assembly	2 Bracket Assemblies	2 Bracket Assemblies		3 Bracket Assemblies	
ft	Designation	Quantity	Designation	Quantity	Designation	Quantity
20	20I-80					
24	24I-80		24II-80			
28	28I-80		28II-80			
32			32II-80		32III-80	
36			36II-80		36III-80	
40			40II-80	1	40III-80	
44			44II-80		44III-80	1
48					48III-80	1

Luminaire Arms (1 per 30' pole)		
Nominal Arm Length	Quantity	
8' Arm	3	

ILSN Arm (Max. 2 per pole) Ship with clamps, bolts and washers		
Nominal Arm Length	Quantity	
7' Arm		
9' Arm	3	

Anchor Bolt Assemblies (1 per pole)			
Anchor Bolt Diameter	Anchor Bolt Length	Quantity	
3/4"	1-6"	3	
1 1/2"	3'-4"		
1 3/4"	3'-10"	3	

Each anchor bolt assembly consists of the following: Top and Bottom templates, 4 anchor bolts, 8 nuts, 8 flat washers, and 4 nut anchor devices (Type 2) per Standard Drawing "TS-FD".

Templates may be removed for shipment.

*FOR PEDESTAL POLES AND PUSH BUTTON POLES

Texas Department of Transportation


TRAFFIC SIGNAL SUPPORT STRUCTURES

SINGLE MAST ARM ASSEMBLY (80 MPH WIND ZONE)

SMA-80(1)-12(DAL)

© TxDOT August 1995	DN: MS	CK: JSY	DW: MMF	CK: JSY
REVISIONS	CONT	SECT	JOB	HIGHWAY
5-96
11-99	DIST	COUNTY	SHEET NO.	
1-02	21	

DISCLAIMER: The use of this standard is governed by the "Texas Engineering Practice Act". No warranty of any kind is made by TxDOT for any purpose whatsoever. TxDOT assumes no responsibility for the conversion of this standard to other formats or for incorrect results or damages resulting from its use.

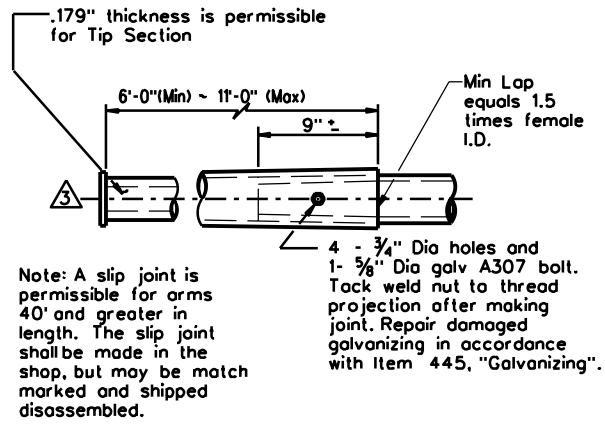

SLIP JOINT DETAIL


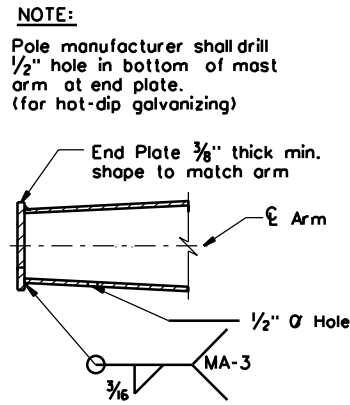


PLATE WELD DETAIL

Stainless steelbands (or Cables) and cast bracket as in "Astro-Brac", "Sky Bracket" or "Easy Bracket" with 1 1/2" Dia Threaded Coupling.

BRACKET ASSEMBLY

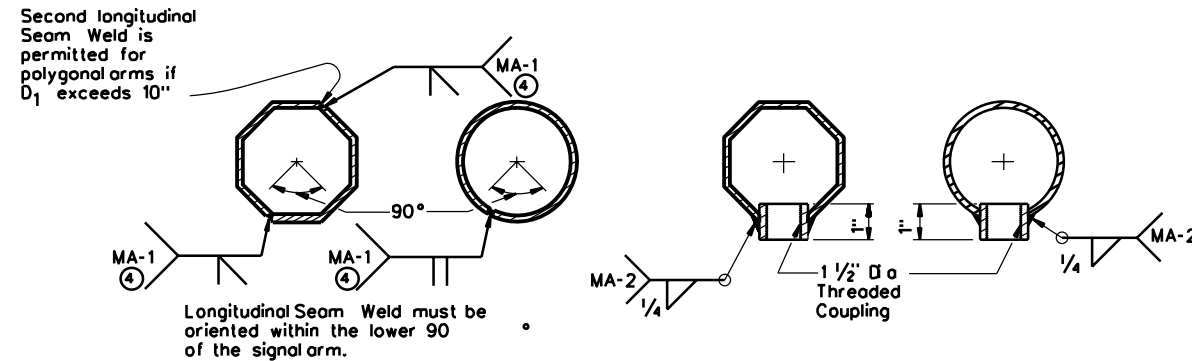

ARM WELD DETAIL

ARM COUPLING DETAILS

④ 60% Min. penetration
100% penetration within
6" of circumferential
base welds.

- ⚠ REPLACED TENON DETAIL WITH PLATE WELD DETAIL(2/12).
- ⚠ REPLACED "MA-D" WITH "MA-D(DAL)"(2/12).

VIBRATION WARNING

Most Arms of SMA and DMA structures and clamp-on Arms of LMA structures of approximately 40 ft or longer are subject to harmonic vertical vibrations in light wind conditions due to the aeroelastic characteristics of a few of the myriads of possible combinations of the following: signal numbers, weights and positions; existence/solidity of backplates; presence of additional attachments to the arm, such as signs and cameras; arm-wind orientation; and arm-pole stiffness.

Such vibrations may cause fatigue damage to the structure and may lead to galloping in moderate wind conditions which may further damage the structure and alarm the public. Tests have indicated that when wind is blowing toward the back side of signal heads having un-vented backplates attached the probability of unacceptable harmonic vibration and/or galloping is rather high.

If backplates are not required for improved visibility they should not be applied to the signal heads or, if they must be applied, they should be vented as a first and inexpensive measure to mitigate vibrations.

The traffic signal mast arms shall be visually inspected in 5 to 20 mph wind conditions after installation of signal heads and any attachments, including any required backplates. If vertical movements with a total excursion (maximum upward excursion to maximum downward excursion) of more than approximately 8" are observed at the arm tip, a damping plate shall be fitted to the arm. See "Damping Plate Mounting Details" on standard sheet, MA-DPD-10.

This visual inspection shall be repeated after each modification of the structure that could affect its aeroelastic response. Excessive vibrations shall not be allowed to continue for more than two days.

GENERAL NOTES:

Design conforms to 1994 AASHTO Standard Specifications for Structural Supports for Highway Signs, Luminaires, and Traffic Signals and Interim Specifications thereto. Design Wind Speed equals 80 mph plus a 1.3 gust factor.

Poles are designed to support one 8'-0" luminaire arm, one 9'-0" internally lighted street name sign and one traffic signal arm with a length as tabulated. The specified luminaire load applied at the end of the luminaire arm equals 60 lbs vertical dead load plus the horizontal wind load on an effective projected area of 1.6 sq ft. The specified internally lighted street name sign load applied 4.5 ft from the centerline of the pole equals 85 lbs vertical dead load plus horizontal wind load on an effective projected area of 11.5 sq ft. The specified signal load applied at the end of the traffic signal arm equals 180 lbs vertical dead load plus the horizontal wind load on an effective projected area of 32.4 sq ft (actual area times drag coefficient).

⚠ See Standard Sheet "MA-D(DAL)" for pole details, "MA-C" for traffic signal arm connection details, "MA-C (ILSN)" for internally lighted street name sign arm connection details, "LUM-A" for luminaire arm and connection details, "SNS" for internally lighted street name sign details, and "TS-FD" for anchor bolt and foundation details. See "MA-C" for material specifications.

Fabrication shall be in accordance with Item 686, "Traffic Signal Pole Assemblies (Steel)" and with the details, dimensions, and weld procedures shown herein. Weld references call for preapproved weld procedures which the Fabricator must obtain prior to fabrication. Materials, fabrication tolerances, and shipping practices shall meet the requirements of this sheet and Item 686, "Traffic Signal Pole Assemblies (Steel)".

Unless otherwise noted, all parts shall be galvanized in accordance with Item 445, "Galvanizing", after fabrication.

Deviation from the details and dimensions shown herein require submission of shop drawings in accordance with Item 441, "Steel Structures". Alternate designs are not acceptable.



**TRAFFIC SIGNAL
SUPPORT STRUCTURES
SINGLE MAST ARM ASSEMBLY
(80 MPH WIND ZONE)
SMA-80(2)-12(DAL)**

© TxDOT August 1995		DN: MS	CK: JSY	DW: MMF	CK: JSY
REVISIONS		CONT	SECT	JOB	HIGHWAY
5-96	1-12
		DIST	COUNTY		SHEET NO.
			22

DISCLAIMER: The use of this standard is governed by the "Texas Engineering Practice Act". No warranty of any kind is made by TxDOT for any purpose whatsoever. TxDOT assumes no responsibility for the conversion of this standard to other formats or for incorrect results or damages resulting from its use.


DATE:
FILE:

FOUNDATION DESIGN TABLE

FDN TYPE	DRILLED SHAFT DIA	REINFORCING STEEL		EMBEDDED DRILLED SHAFT LENGTH-ft ④ ⑤ ⑥			ANCHOR BOLT DESIGN ①			FOUNDATION DESIGN LOAD ②		TYPICAL APPLICATION	
		VERT BARS	SPIRAL & PITCH	TEXAS CONE PENETROMETER N blows/ft			ANCHOR BOLT DIA	F _y (ksi)	BOLT CIR DIA	ANCHOR TYPE	MOMENT K-ft		SHEAR Kips
				10	15	40							
24-A	24"	4- #5	#2 at 12"	5.7	5.3	4.5	¾"	36	12 ¾"	1	10	1	Pedestal pole, pedestal mounted controller.
30-A	30"	8- #9	#3 at 6"	11.3	10.3	8.0	1½"	55	17"	2	87	3	Mast arm assembly. (see Selection Table)
36-A	36"	10- #9	#3 at 6"	13.2	12.0	9.4	1¾"	55	19"	2	131	5	Mast arm assembly. (see Selection Table) 30' strain pole with or without luminaire.
36-B	36"	12- #9	#3 at 6"	15.2	13.6	10.4	2"	55	21"	2	190	7	Mast arm assembly. (see Selection Table) Strain pole taller than 30' & strain pole with mast arm
42-A	42"	14- #9	#3 at 6"	17.4	15.6	11.9	2 ¼"	55	23"	2	271	9	Mast arm assembly. (see Selection Table)

FOUNDATION SELECTION TABLE FOR STANDARD MAST ARM PLUS ILSN SUPPORT ASSEMBLIES (ft)

80 MPH DESIGN WIND SPEED	MAX SINGLE ARM LENGTH	FDN 30-A	FDN 36-A	FDN 36-B	FDN 42-A	
		24' x 24'				
MAXIMUM DOUBLE ARM LENGTH COMBINATIONS	28' x 28'					
	32' x 28'		32' x 32'			
			36' x 36'			
			40' x 36'			
		44' x 28'	44' x 36'			
100 MPH DESIGN WIND SPEED	MAX SINGLE ARM LENGTH		36'	44'		
			24' x 24'			
			28' x 28'			
			32' x 24'			
			32' x 32'			
			36' x 36'			
			40' x 24'	40' x 36'		
			44' x 36'			

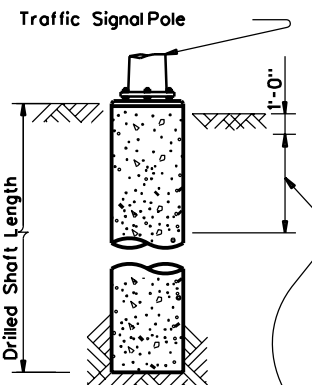


Use average N value over the top third of the embedded shaft. Ignore the top 1' of soil.

ANCHOR BOLT & TEMPLATE SIZES

BOLT DIA IN.	⑦ BOLT LENGTH	TOP THREAD	BOTTOM THREAD	BOLT CIRCLE	R ₂	R ₁
¾"	1'-6"	3"	—	12 ¾"	7 ⅞"	5 ⅝"
1 ½"	3'-4"	6"	4"	17"	10"	7"
1 ¾"	3'-10"	7"	4 ½"	19"	11 ¼"	7 ¾"
2"	4'-3"	8"	5"	21"	12 ½"	8 ½"
2 ¼"	4'-9"	9"	5 ½"	23"	13 ¾"	9 ¼"


⑦ Min dimensions given, longer bolts are acceptable.

- EXAMPLE:
- For 80mph design wind speed, foundation 30-A can support up to a 32' arm with another arm up to 28'
 - For 100mph design wind speed, foundation 36-A can support a single 36' mast arm.

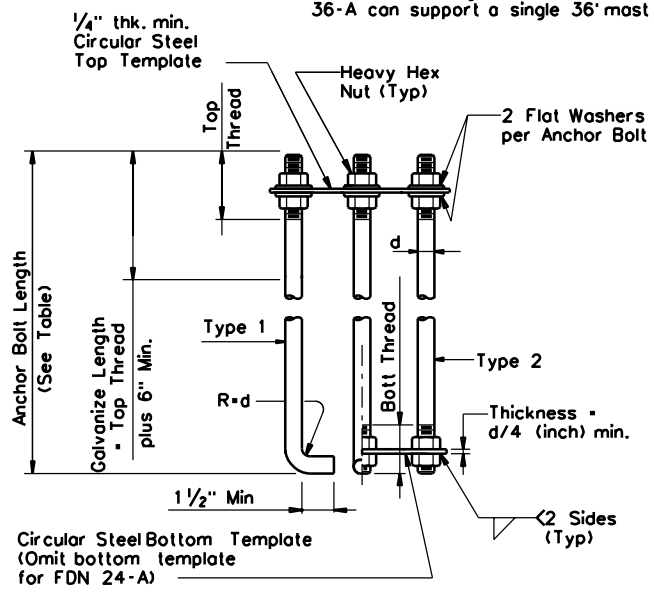


HOOKED ANCHOR (TYPE 1) NUT ANCHOR (TYPE 2) ANCHOR BOLT ASSEMBLY

⑧ Orient anchor bolts orthogonal with the fixed arm direction to ensure that two bolts are in tension under dead load.

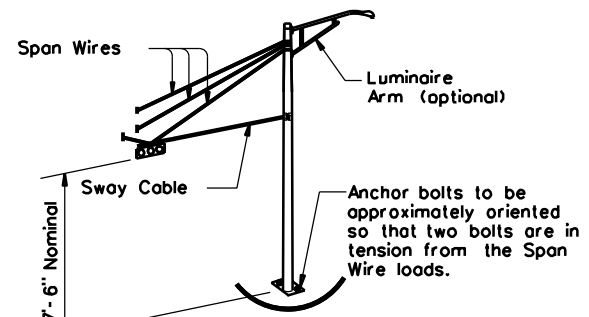

TYPICAL STRAIN POLE ASSEMBLY

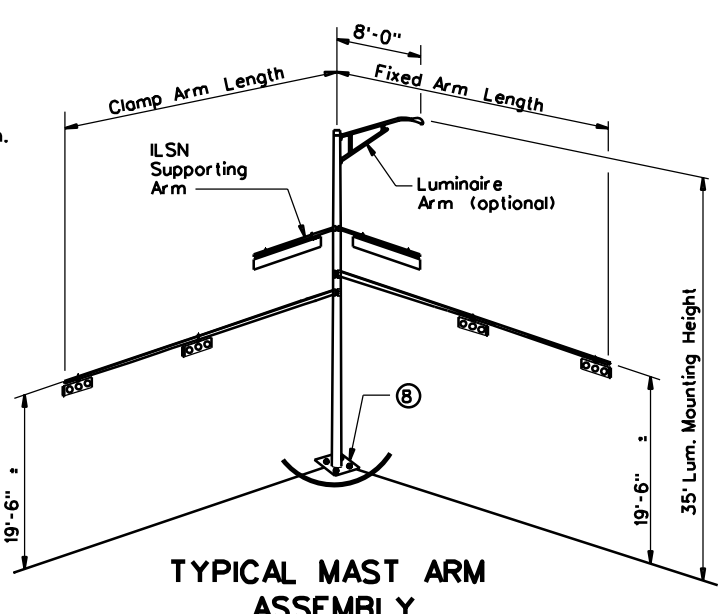



TYPICAL MAST ARM ASSEMBLY

Conduit (See Layout Sheets for diameter. Orient as directed by the Engineer. 1 or 2 required)

Vertical Bars (See Design Table for size & number).

Spiral, 3 flat turns top & 1 flat turn bottom. (See Design Table for size & pitch)

Vertical bars may rest on bottom of drilled hole if material is firm enough to do so when concrete is placed.

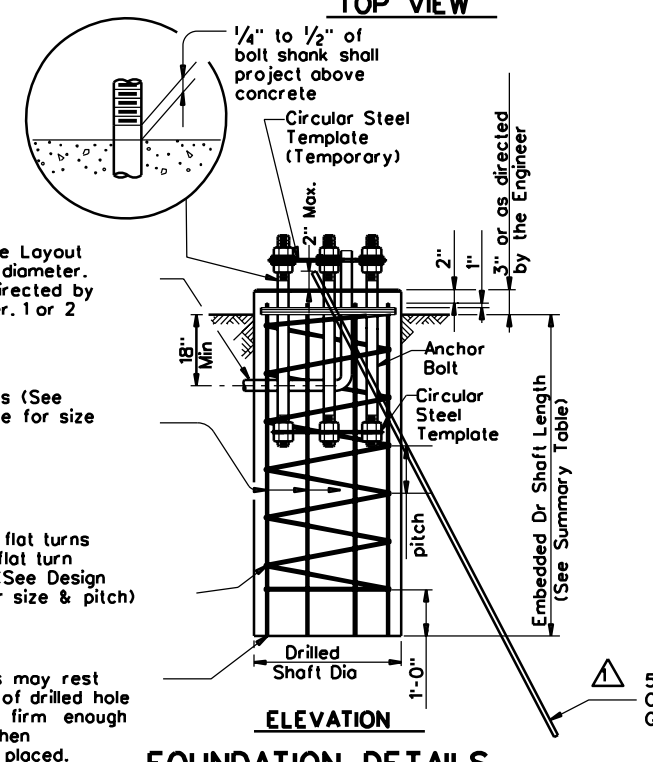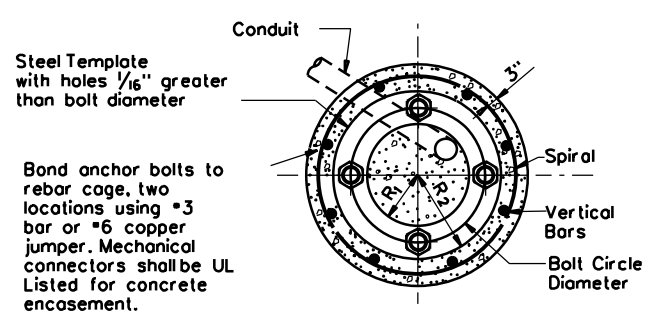

FOUNDATION DETAILS

NOTES:

- Anchor bolt design develops the foundation capacity given under Foundation Design Loads.
- Foundation Design Loads are the allowable moments and shears at the base of the structure.
- Foundations may be listed separately or grouped according to similarity of location and type. Quantities are for the Contractor's information only.
- Field Penetrometer readings at a depth of approximately 3 to 5 feet may be used to adjust shaft lengths.
- If rock is encountered, the Drilled Shaft shall extend a minimum of two diameters into solid rock.
- Decimal lengths in Design Table are to allow interpolation for other penetrometer values. Round to nearest foot for entry into Summary Table.

FOUNDATION SUMMARY TABLE ③

LOCATION IDENTIFICATION	AVG. N BLOW /ft.	FDN TYPE	NO. EA	DRILLED SHAFT LENGTH ⑥ (FEET)				
				24-A	30-A	36-A	36-B	42-A
P-1, P-5, P-6	10	36-A	3			39		
P-2, P-3, P-4	10	24-A	3	16				
TOTAL DRILLED SHAFT LENGTHS				16		39		

RECORD DRAWINGS

THESE RECORD DRAWINGS HAVE BEEN PREPARED TO REFLECT ANY CHANGES AND/OR MODIFICATIONS MADE TO THE DESIGN PLANS, PROVIDED BY THE CONTRACTOR AND THE CITY INSPECTOR. UNLESS OTHERWISE NOTED, THE PROJECT HAS BEEN CONSTRUCTED IN SUBSTANTIAL CONFORMANCE WITH THE DESIGN DRAWINGS. THE ENGINEERING CONSULTANT IS NOT RESPONSIBLE FOR ACCURACY AND COMPLETENESS EXCEPT FOR WHAT WAS PROVIDED BY THE CONTRACTOR. THE PLAN SET USED FOR BIDDING ORIGINALLY SEALED 5/4/2016 AND REVISED 8/8/2016.

Thomas P. Grant, P.E. 2/20/2017
 SIGNATURE DATE
 THOMAS P. GRANT, P.E., KIMLEY-HORN AND ASSOCIATES, INC.

GENERAL NOTES:

- Design conforms to 1994 AASHTO Standard Specifications for Structural Supports for Highway Signs, Luminaires and Traffic Signals and interim revisions thereto.
- Reinforcing steel shall conform to Item 440, "Reinforcing Steel".
- Concrete shall be Class "C".
- Threads for anchor bolts and nuts shall be rolled or cut threads of BUN series up to 2" in diameter or UNC series for all sizes. Bolts and nuts shall have Class 2A and 2B fit tolerances. Galvanized nuts shall be tapped after galvanizing.
- Anchor bolts that are larger than 1" in diameter shall conform to "alloy steel" or "medium-strength mild steel" per Item 449, "Anchor Bolts". Anchor bolts that are 1" in diameter or less shall conform to ASTM A36. Galvanize a minimum of the top end thread length plus 6" for all anchor bolts unless otherwise noted. Exposed washers and exposed nuts shall be galvanized. All galvanizing shall be in accordance with Item 445, "Galvanizing".
- Templates and embedded nuts need not be galvanized. Lubricate and tighten anchor bolts when erecting the structure in accordance with Item 449, "Anchor Bolts".
- Ground rod shall protrude a minimum of 1" and a maximum of 2" above the finish grade of the foundation. Make connections to ground rods according to NEC. Ground rod clamps shall be listed for their intended purpose.

MODIFICATIONS:


- △ ADDED GROUND ROD TO FOUNDATION DETAILS (9/15)



TRAFFIC SIGNAL POLE FOUNDATION TS-FD-12 (DAL)

© TxDOT August 1995	DN: MS	CK: JSY	DW: MAO/MMF	CK: JSY/TEB
REVISIONS	CONT	SECT	JOB	HIGHWAY
---	---	---	---	---
DIST	COUNTY	SHEET NO.		23


DISCLAIMER: The use of this standard is governed by the "Texas Engineering Practice Act". No warranty of any kind is made by TxDOT for any purpose whatsoever. TxDOT assumes no responsibility for the conversion of this standard to other formats or for incorrect results or damages resulting from its use.

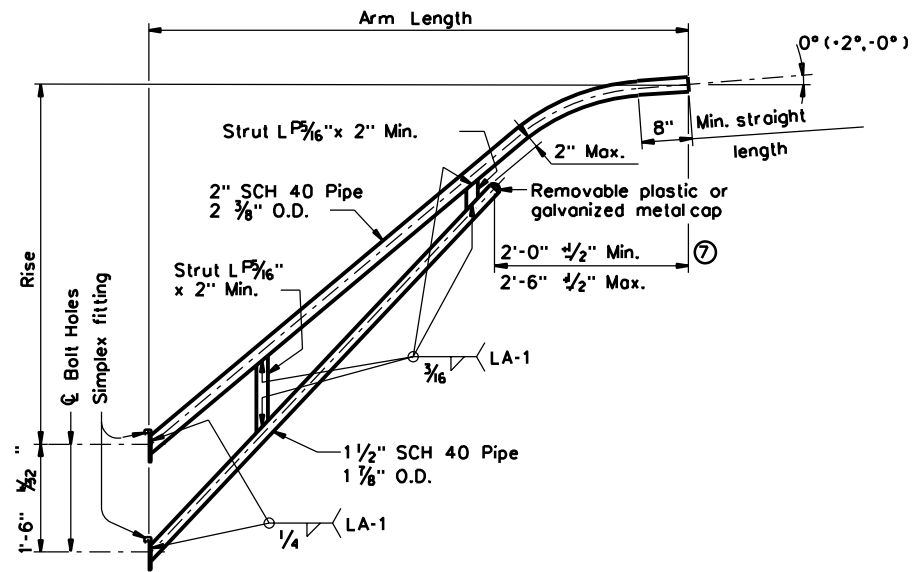


LUMINAIRE ARM

LUMINAIRE ARM DIMENSIONS		
Nominal Arm Length	Arm Length	Rise
4'-0"	3'-6"	2'-6" (1)
6'-0"	5'-6"	5'-6"
8'-0"	7'-6"	5'-6"
10'-0"	9'-6"	5'-6"
12'-0"	11'-6"	5'-6"


MATERIALS	
Pole or Arm Simplex	ASTM A27 Gr 65-35, A148 Gr 80-50, A576 Gr 1021 5 (or) A36 (Arm only)
Arm Pipes	ASTM A53 Gr A or B, A500 Gr B, A501, A 1008 HSLAS-F Gr 50 6 (or) A1011 HSLAS-F Gr 50 6 (or)
Arm Struts and Gusset Plates 4	ASTM A36, A572 Gr 50 (or) A588
Misc.	ASTM designations as noted

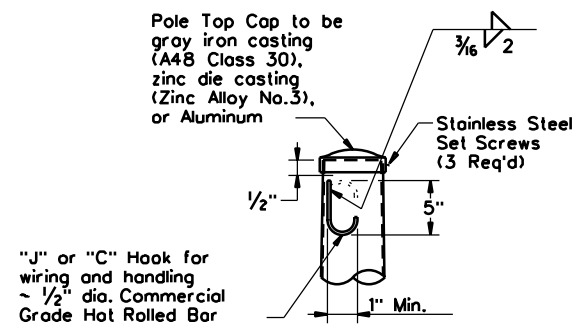


POLE TOP

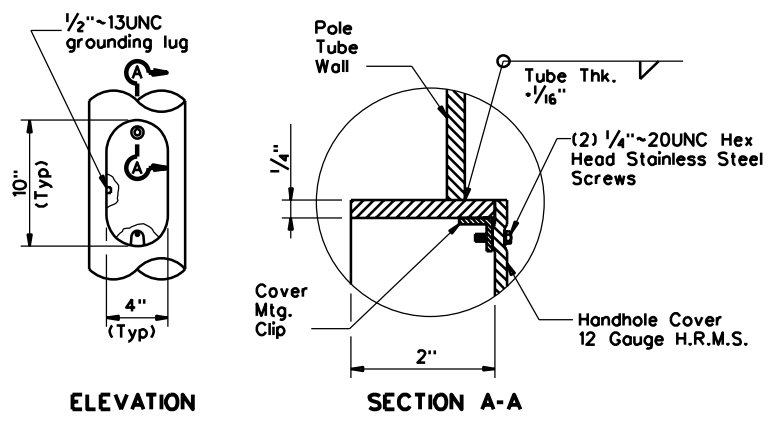


HANDHOLE

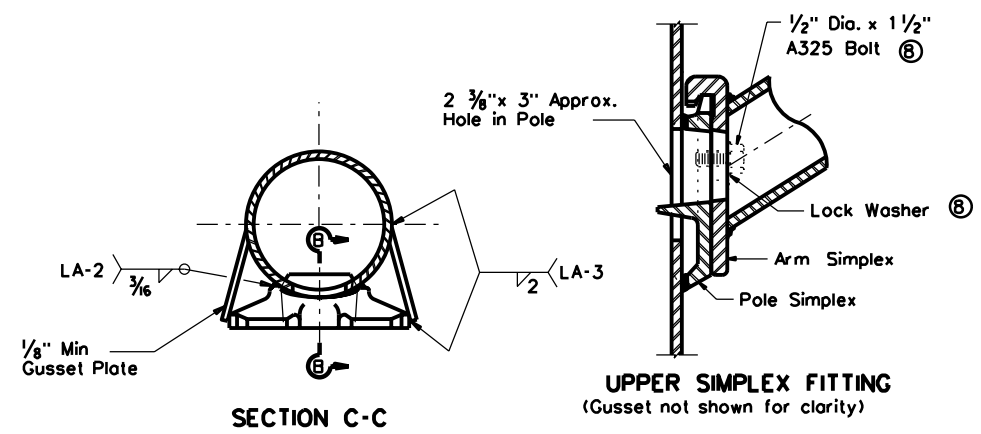

UPPER SIMPLEX FITTING
(Gusset not shown for clarity)

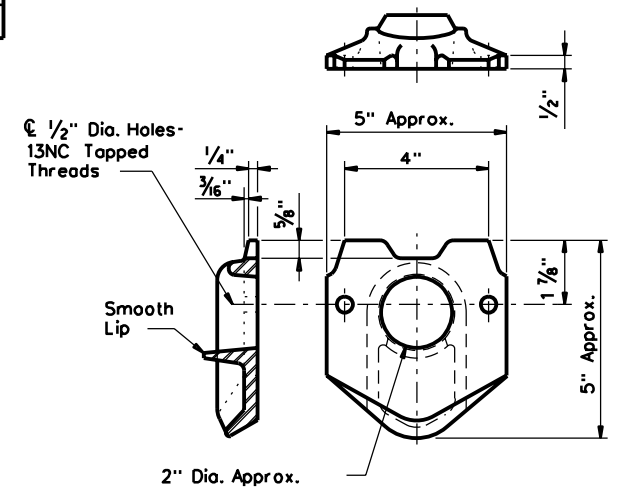


POLE SIMPLEX DETAIL

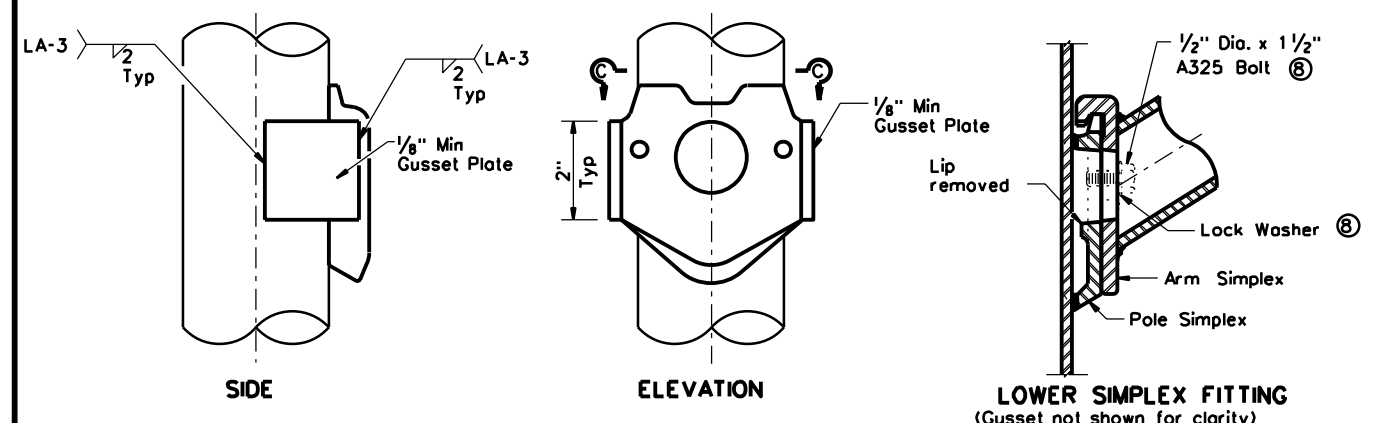

LOWER SIMPLEX FITTING
(Gusset not shown for clarity)

SIMPLEX ATTACHMENT DETAIL

SECTION B-B

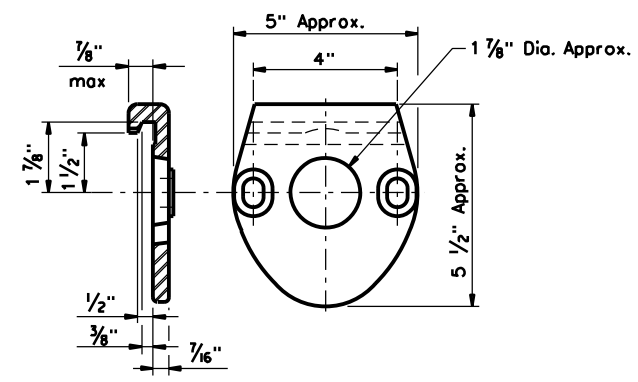

ARM SIMPLEX DETAIL

ARM ASSEMBLY FABRICATION TOLERANCES TABLE	
DIMENSION	TOLERANCE
Arm Length	±.3"
Arm Rise	±.13 /4" in 10 ft
Arm Diameter	±.3/16"
Overall length or width	±.1/4"
Thickness	±.1/4", -1/16"
Deviation from flat	1/8" in 12"
Spacing between holes	±.3/32"
Bolt hole size	±.1/16"
Strut location in truss arms	±.1 /2"

- (4) Any of the materials listed for plates may be used where the drawings do not specify a particular ASTM designation.
- (5) A576 must be suitable for forging and also meet minimum tensile strength of 65 ksi, minimum yield of 35 ksi, and elongation in 2 inches of 22 percent.
- (6) A572, A1008 HSLAS-F, and A1011 HSLAS-F materials may have higher yield strengths but shall not have less elongation than the grade indicated.
- (7) Dimensional limits are given to show acceptable variation in design. All of a Fabricator's production of a particular arm length shall have the same dimensions within specified tolerances.
- (8) Each pole simplex fitting shall be supplied with 2 bolts and 2 lock washers of the size specified. The bolts and lock washers shall be secured to the pole with the other hardware items called for in the plans.
- (9) Proposed deviations in arm simplex dimensions or materials must be submitted to the Department for approval.
- (10) Luminaire mounting heights are based on assumed 5'-6" luminaire arm rise.

Texas Department of Transportation
Traffic Operations Division




ROADWAY ILLUMINATION POLES

RIP(3)-11

© TxDOT January 2007	DN: TxDOT	CK: TxDOT	DW: TxDOT	CK: TxDOT
REVISIONS	CONT	SECT	JOB	HIGHWAY
---	---	---	---	---
DIST	COUNTY	SHEET NO.		25
---	---	---		---

DISCLAIMER: The use of this standard is governed by the "Texas Engineering Practice Act". No warranty of any kind is made by TxDOT for any purpose whatsoever. TxDOT assumes no responsibility for the conversion of this standard to other formats or for incorrect results or damages resulting from its use.

TOP VIEW
(Slab & Base)

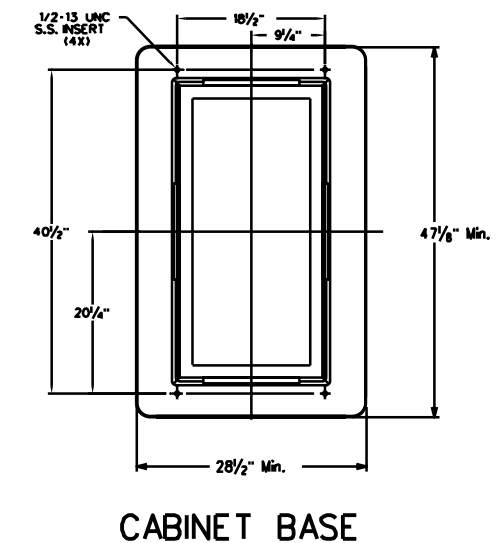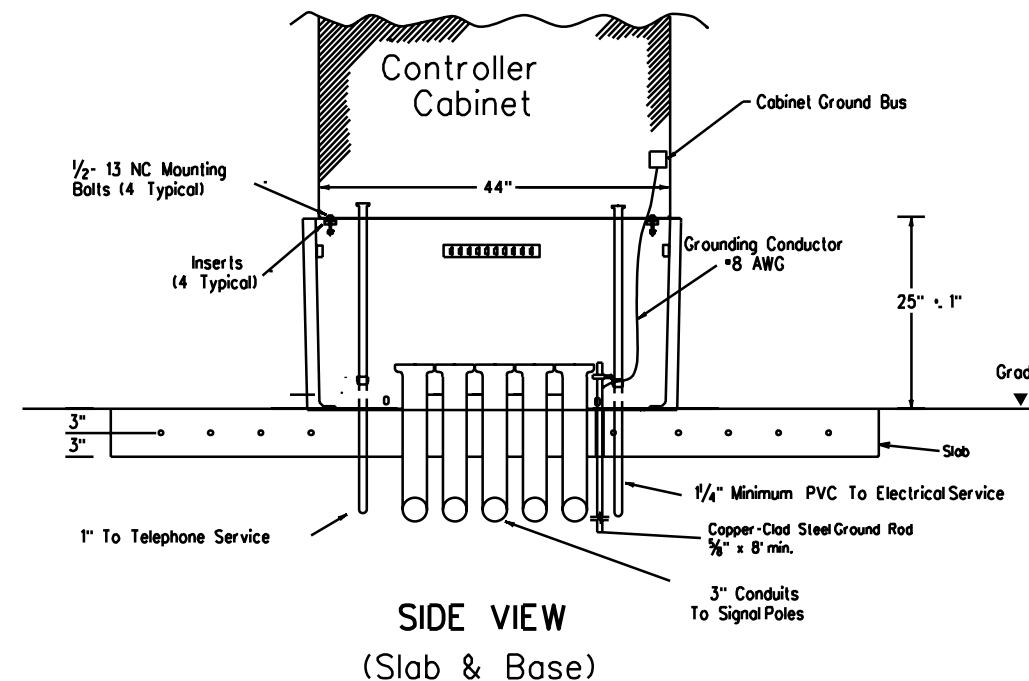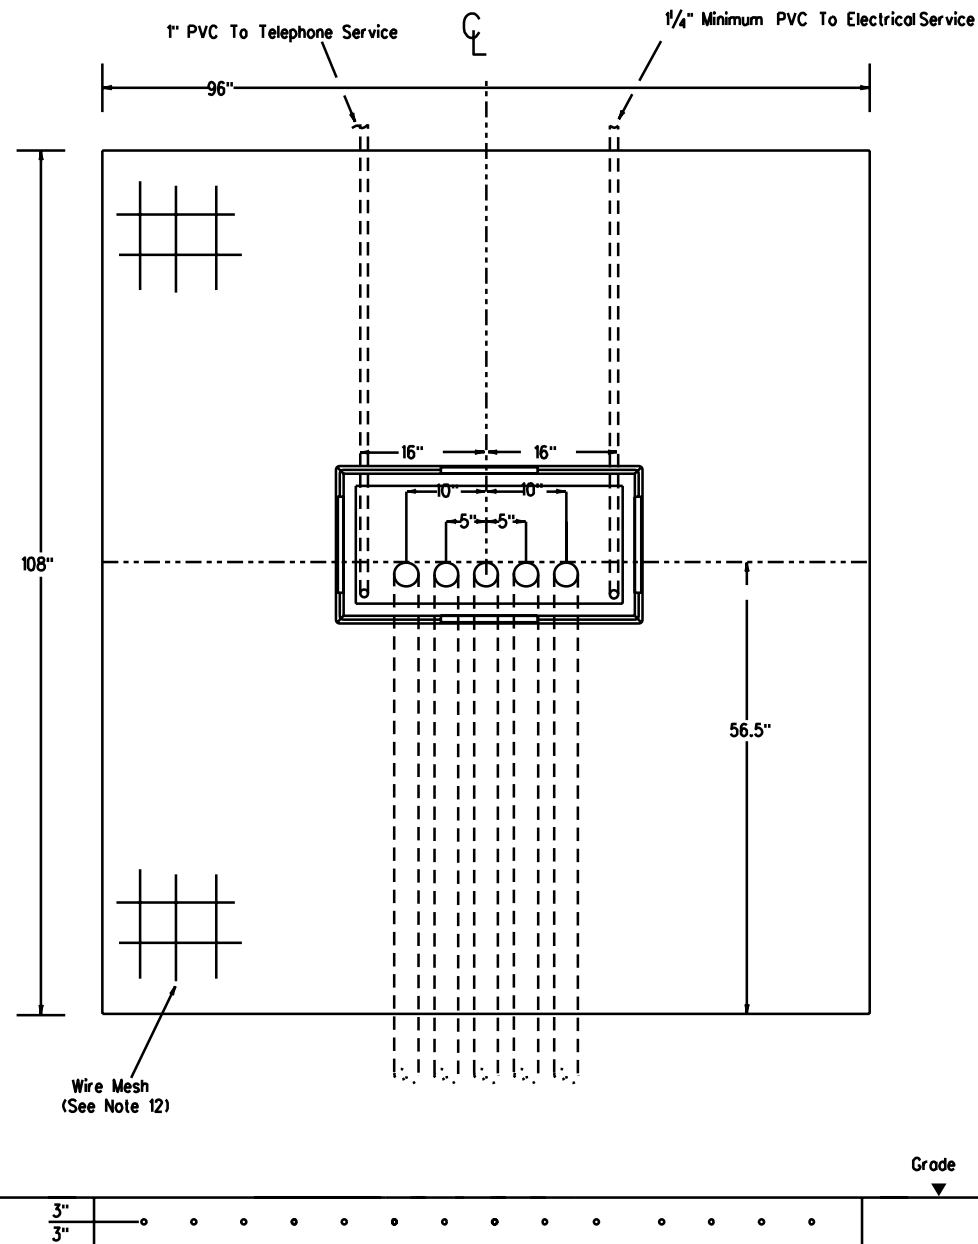

TRAFFIC SIGNAL CONTROLLER BASE:

- Provide a traffic signal controller base (cabinet base) manufactured of polymer concrete material consisting of calcareous and siliceous stone, glass fibers and thermoset polyester resin. The polymer concrete cabinet base must be reinforced on the inside of the cabinet base with fiberglass matting. Provide one of the following bases: Armocast Part # A6001848X24, Quazite Model # PG3048Z709, or other as approved by TxDOT Traffic Operation Division.
 - The polymer concrete material must have a minimum compressive strength of 10,300 pounds per square inch (psi), minimum flexural strength of 3600 psi, and minimum shear strength of 3600 psi.
 - The polymer concrete cabinet base must conform to the dimensions shown and must accommodate a standard TxDOT basemount cabinet.
 - Supply the cabinet base with four 1/2"-13 UNC stainless steel inserts for attachment of the cabinet to the base. Inserts must withstand a minimum torque of 50 ft-lb and a minimum straight pull out strength of 750 lbs.
 - Provide the cabinet base with 4 cable racks mounted one on each side of the base 2" to 7" from the top edge of the base. Unless approved otherwise, cable racks must be 1-1/2 x 3/8 x 3/8 inch steel channel with eight T-slots spaced at 1-1/2 inches. The cable racks must easily accommodate the insertion of tie wraps to attach field wiring to the racks to serve as strain relief. Secure cable racks to the base using 1/2"-13 UNC stainless steel screws and inserts.
 - The cabinet base, when secured to the concrete slab with controller cabinet attached, must withstand a minimum wind load of 125 mph or a 850 lb force applied at 49" above the bottom of the base without causing the base or cabinet to come out of their anchored position or cause any permanent deformation. The manufacturer must supply certification by an independent testing laboratory or sealed by a Texas Licensed Professional Engineer. Provide the cabinet base with hardware for attachment to a concrete slab.
 - The traffic signal base must be permanently marked either by impress or by permanent ink with the manufacturer's model number and name or logo.
 - Seal the base to the concrete with a silicone caulk bead and fastened to the slab per manufacturer's instructions.
- CONCRETE SLAB:
- Traffic signal controller pad must be a portland cement concrete slab poured in place, must conform to the dimensions shown, and must be level.

- Bond a #8 AWG copper ground wire and an 8 ft ground rod bonded to the reinforcing mesh by a suitable UL Listed clamp and terminated to the cabinet grounding bus for the purpose of providing a local ground for the electrical grounding conductor. The electrical grounding conductor specified in Item 680-3.A.4 is required and must be terminated to the cabinet ground bus.
 - Install a PVC sleeve to prevent the ground rod from direct embedment in the slab.
 - Provide welded wire mesh 6X6-W2.9 X W2.9 for reinforcement. Provide joints and splices in the mesh with a minimum 6-inch overlap. Center the mesh between top and bottom and provide a minimum 3 inch cover on the edges.
 - Provide Class B concrete minimum for the slab in accordance with Item 421. Construct the slab in accordance with Item 531.
- CONDUITS:
- Stub up and run 3-inch conduits through the slab to the various traffic signal poles and ground boxes as shown on the layouts. Install the number of conduits as shown on layouts plus two additional 3 inch conduits for future use. Terminate the conduits with a bushing between 2 and 4-inches above the slab.
 - Extend conduits for future use at least 18-inches from the edge of the slab, terminate underground with a coupling, and cap and seal so that the seal can be removed without damaging the coupling. This must also apply to unused telephone conduit.
 - Stub up two separate conduits through the slab from the electrical and telephone services. Run the conduit for the electrical feed directly to the electrical service enclosure. Run the conduit for the telephone line directly to the telephone service, usually located on the same pole as the electrical service. Telephone must not under any circumstance share a conduit with any other function.
 - Terminate electric and telephone conduits above the slab with a coupling. After the base is installed, extend the conduits above the top of the base and secure to the base using a steel one-hole strap or similar suitable substitute.
- CONTROLLER CABINET:
- Anchor the controller cabinet to the base using four stainless steel 1/2-13 NC bolts.
 - The silicone caulk bead specified in Item 680.3.B must be RTV 133.
- PAYMENT:
- Bid TS-CF as subsidiary to Item 680.

Texas Department of Transportation
Traffic Operations Division

TRAFFIC SIGNAL
CONTROLLER CABINET
BASE AND PAD


TS-CF-04

© TxDOT October 2000	DN:	CK:	DW:	CK:	
12-04	REVISIONS	CONT	SECT	JOB	HIGHWAY
		---	---	---	---
		DIST	COUNTY	SHEET NO.	
		---	---	26	

DATE:
FILE:


DISCLAIMER: The use of this standard is governed by the "Texas Engineering Practice Act". No warranty of any kind is made by TxDOT for any purpose whatsoever. TxDOT assumes no responsibility for the conversion of this standard to other formats or for incorrect results or damages resulting from its use.

ARM SIZE		A	B	C	D	E	CONN. BOLT DIA.
D ₁	φ	in.	in.	in.	in.	in.	in.
6.5	.179	12	9	9	6	1 3/4	1
7.5	.179	13	9	10	6	1 3/4	1
8.0	.179	14	10	11	7	2	1 1/4
9.0	.179	16	11	13	8	2	1 1/4
9.5	.179	17	12	14	9	2	1 1/4
9.5	.239	18	12	15	9	2	1 1/4
10.0	.239	18	12	15	9	2	1 1/4
10.5	.239	18	13	15	10	3	1 1/2
11.0	.239	18	13	15	10	3	1 1/2

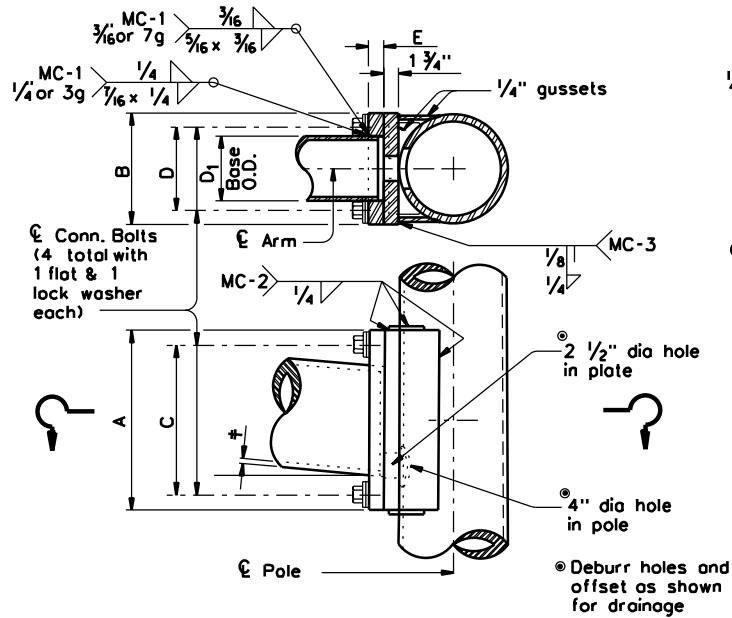


FIXED MOUNT DETAIL 1

ARM SIZE		A	B	C	D	E	CONN. BOLT DIA.
D ₁	φ	in.	in.	in.	in.	in.	in.
7.0	.179	11	11	8	8	1 3/4	1 1/4
7.5	.179	11	11	8	8	1 3/4	1 1/4
8.0	.179	11	11	8	8	2	1 1/4
9.0	.179	13	13	10	10	2	1 1/4
10.0	.179	13	13	10	10	2	1 1/4
9.5	.239	13	13	10	10	2	1 1/4
10.0	.239	14	14	11	11	2	1 1/2
11.0	.239	14	14	11	11	3	1 1/2
11.5	.239	14	14	11	11	3	1 1/2

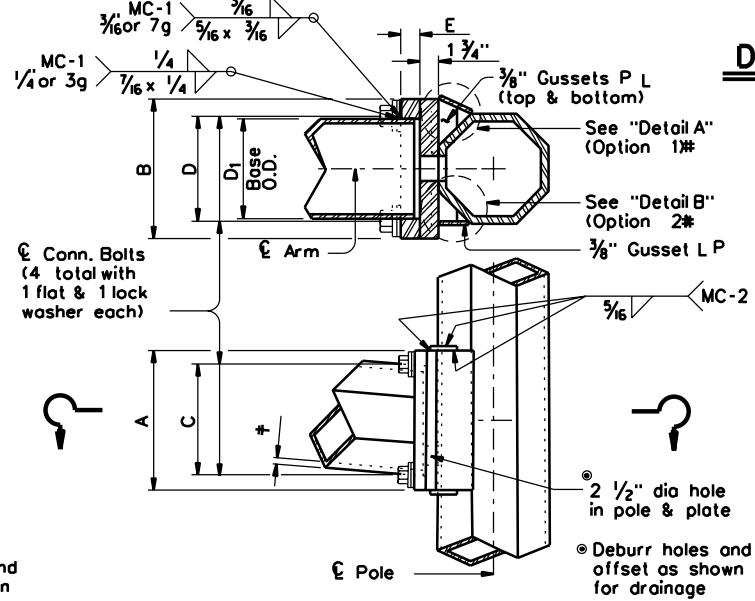


FIXED MOUNT DETAIL 2

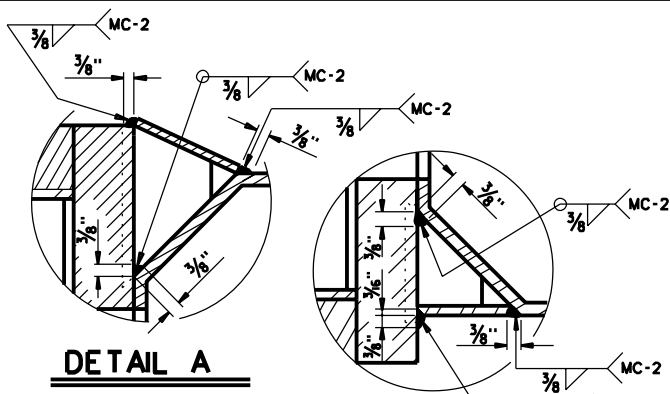

DETAIL A

DETAIL B

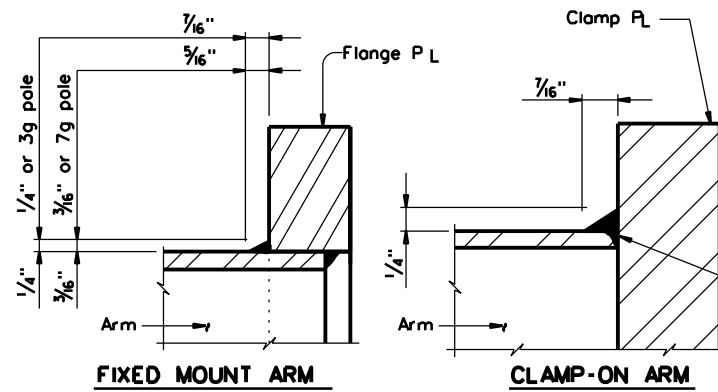


ARM BASE WELD DETAILS


ARM SIZE		A	F	CONN. BOLTS	PIN BOLTS
D ₁	φ	in.	in.	No. Dia	No. Dia
6.5	.179	12	6	4 1	2 3/8
7.5	.179	14	8	4 1	2 5/8
8.0	.179	14	8	4 1	2 5/8
9.0	.179	16	10	4 1	2 5/8
9.5	.179	18	12	4 1 1/4	3 5/8
9.5	.239	18	12	4 1 1/4	3 5/8
10.0	.239	18	12	4 1 1/4	3 5/8

ARM SIZE		A	F	T	CONN. BOLTS	PIN BOLTS
D ₁	φ	in.	in.	in.	No. Dia	No. Dia
7.0	.179	12	6	3/4	4 3/4	2 3/8
7.5	.179	14	8	3/4	4 3/4	2 3/8
8.0	.179	14	8	3/4	4 3/4	2 3/8
9.0	.179	16	10	3/4	4 1	2 3/8
10.0	.179	18	10	3/4	4 1	2 3/8
9.5	.239	18	10	1	6 1	3 3/8
10.0	.239	18	10	1	6 1	3 3/8


ARM SIZE		A	F	CONN. BOLTS	PIN BOLTS
D ₁	φ	in.	in.	No. Dia	No. Dia
6.5	.179	12	6	4 1	2 3/8
7.5	.179	14	8	4 1	2 3/8
8.0	.179	14	8	4 1	2 3/8
9.0	.179	16	10	4 1	2 3/8
9.5	.179	18	12	6 1	3 3/8
9.5	.239	18	12	6 1	3 3/8
10.0	.239	18	12	6 1	3 3/8

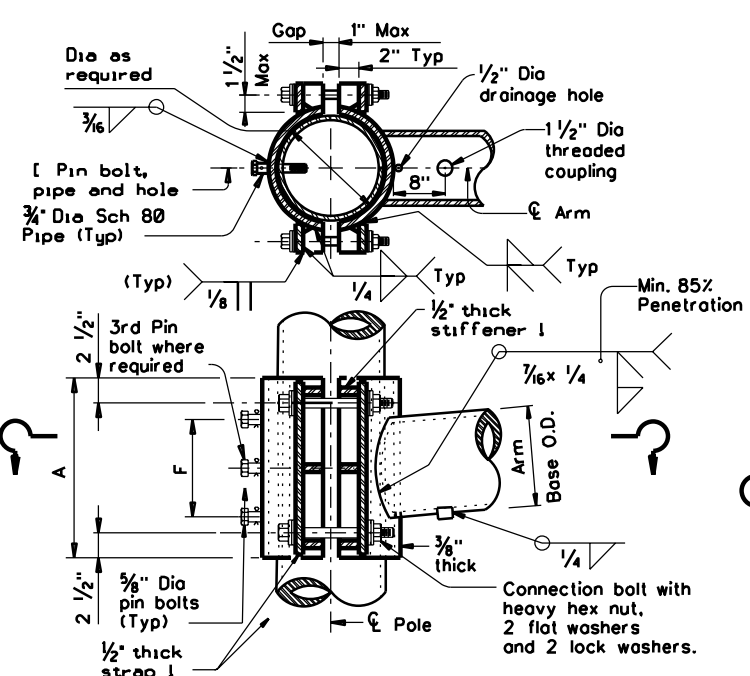

CLAMP-ON DETAIL 1

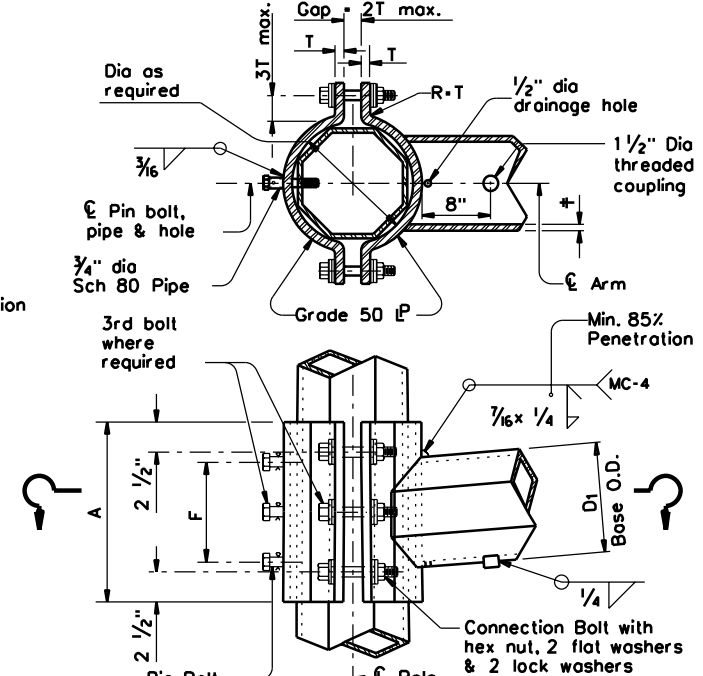

CLAMP-ON DETAIL 2

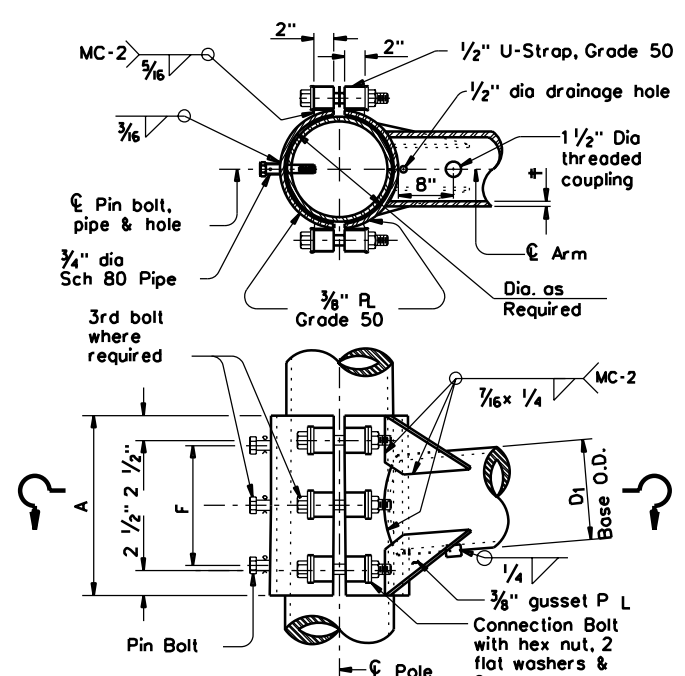

CLAMP-ON DETAIL 3

MATERIALS	
Round Shafts or Polygonal Shafts ①	ASTM A595 Gr.A, A588, A1008 HSLAS Gr.50 Class 2, A1011 HSLAS Gr.50 Class 2, A572 Gr.50 or A1011 SS Gr.50 ②
Plates ①	ASTM A36, A588, or A572 Gr.50
Connection Bolts	ASTM A325 or A449, except where noted
Pin Bolts	ASTM A325
Pipe ①	ASTM A53 Gr.B, A501, A1008 HSLAS-F Gr.50, A1011 HSLAS-F Gr.50
Misc. Hardware	Galvanized steel or stainless steel or as noted

- ① ASTM A572, A1008 HSLAS, A1011 HSLAS, A1008 HSLAS-F, A1011 HSLAS-F or A1011 SS may have higher yield strengths but shall not have less elongation than the grade indicated.
- ② ASTM A1011 SS Gr.50 material shall also have a minimum elongation of 18 percent in 8 inches or 23 percent in 2 inches. Material thickness in excess of those stipulated under A1011 SS will be acceptable providing the material meets all other A1011 SS requirements and the requirements of this item.

GENERAL NOTES:

Clamp-on details are used for the second arm on dualmost arm assemblies. A Maximum 1 1/2" wide vertical slotted hole shall be cut in the front clamp plate to facilitate drainage during galvanizing. The slot shall be centered behind the arm and shall be no longer than the arm diameter minus 1"

Fixed mount details are used for single most arm assemblies and for the first arm on dualmost arm assemblies.

Where duplicate parts occur on a detail, welds shown for one part shall apply to all similar parts on the detail.

Pin bolts are required to prevent rotation of clamp-on arms under design wind forces.

NOTE:

Pin bolts shall be A325 with threads excluded from the shear plane. Pin bolt and 3/4" dia pipe shall have 3/16" dia holes for a 1/8" dia galvanized cotter pin. Back clamp plate shall be furnished with a 3/4" dia hole for each pin bolt. An 1/16" dia hole for the pole after arm orientations have been approved by the Engineer.

Texas Department of Transportation
Traffic Operations Division

STANDARD ASSEMBLY FOR TRAFFIC SIGNAL SUPPORT STRUCTURES

MAST ARM CONNECTIONS

MA-C-12


© TxDOT August 1995

DNF	CK:	DW:	CK:
REVISIONS	CONT	SECT	JOB
...
DIST	COUNTY	SHEET NO.	
...	...	27	


DATE: FILE:

DISCLAIMER: The use of this standard is governed by the "Texas Engineering Practice Act". No warranty of any kind is made by TxDOT for any purpose whatsoever. TxDOT assumes no responsibility for the conversion of this standard to other formats or for incorrect results or damages resulting from its use.


TABLE OF DIMENSIONS for ILSN Support Arm Clamp-on Details 1, 2 and 3						
ILSN ARM SIZE	A		CONN. BOLTS		PIN BOLTS	
	in.	in.	No.	Dia	No.	Dia
3 in. dia Schedule 40 Pipe	10	4	4	3/4	2	5/8

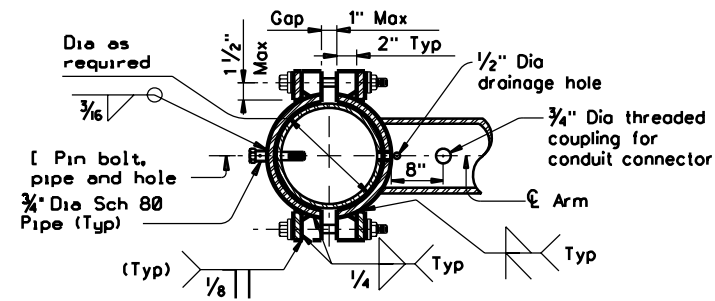


SECTION A-A

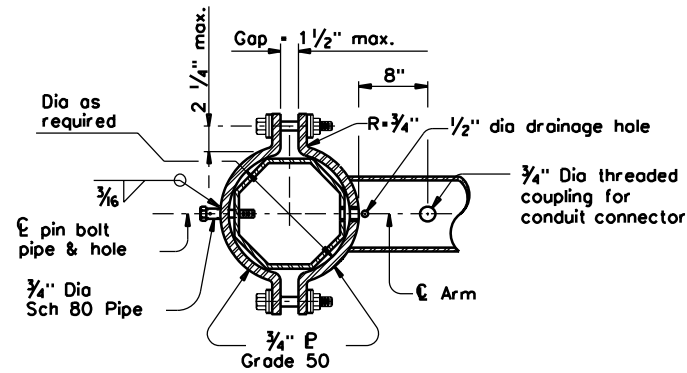


SECTION B-B

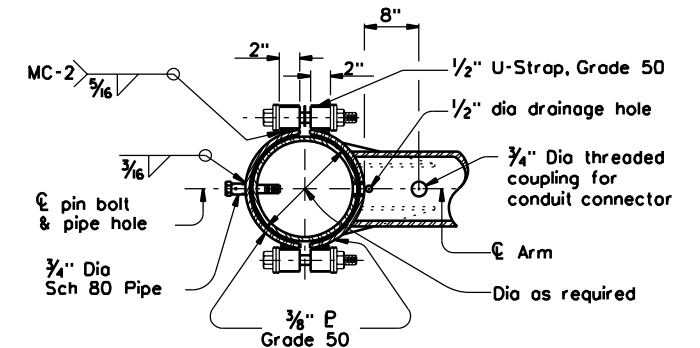


SECTION C-C

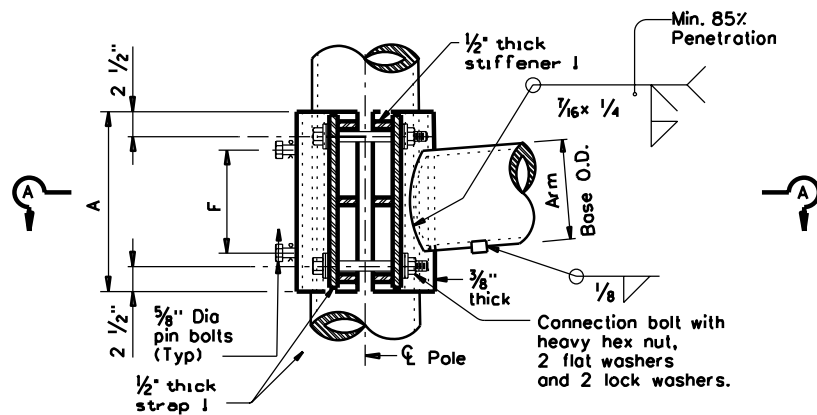

ILSN CLAMP-ON DETAIL 1

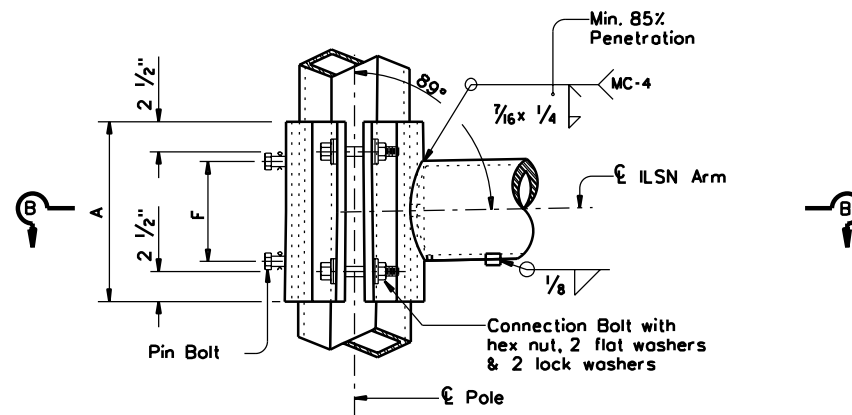

ILSN CLAMP-ON DETAIL 2

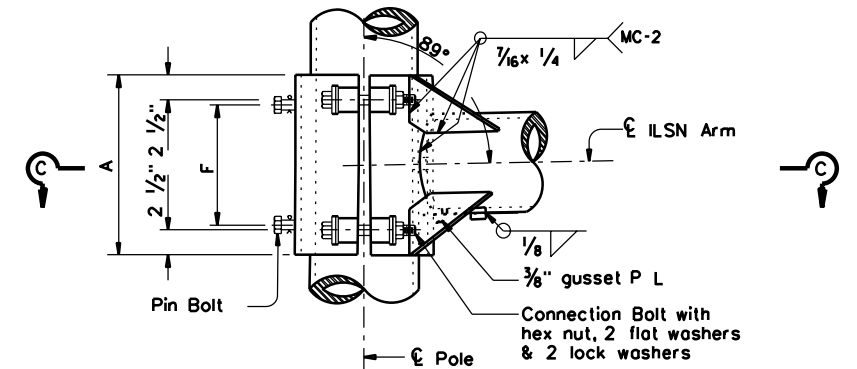

ILSN CLAMP-ON DETAIL 3

GENERAL NOTES:


Clamp-on details shall be used for ILSN support arm assemblies. A 1 1/2 inch diameter hole shall be cut in the front clamp plate for wiring access. A matched hole shall be field drilled through the pole to provide wire access after arm is oriented. Deburr both holes.

Where duplicate parts occur on a detail, welds shown for one part shall apply to all similar parts on the details.

Pin bolts are required to prevent rotation of clamp-on arms under design wind forces.


NOTE:

Pin bolts shall be A325 with threads excluded from the shear plane. Pin bolt and 3/4 inch diameter pipe shall have 3/16 inch diameter holes for a 1/8 inch diameter galvanized cotter pin. Back clamp plate shall be furnished with a 3/4 inch diameter hole for each pin bolt. An 1/16 inch diameter hole for each pin bolt shall be field drilled through the pole after arm orientations have been approved by the Engineer.

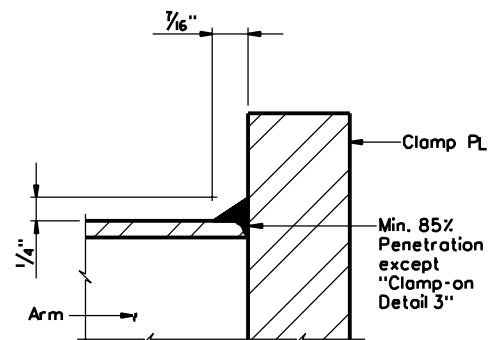

CLAMP-ON ARM

ARM BASE WELD DETAILS

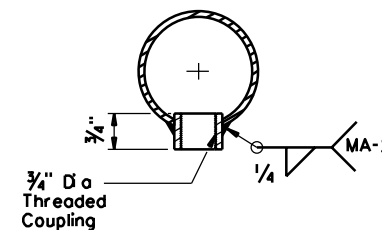


ILSN ARM COUPLING DETAIL

Texas Department of Transportation
Traffic Operations Division
**STANDARD ASSEMBLY
FOR TRAFFIC SIGNAL
SUPPORT STRUCTURES**
MAST-ARM CONNECTIONS
MA-C(ILSN)-12


© TxDOT August 1995	DN: MS	CK: JSY	DW: MMF	CK: JSY
REVISIONS	CONT	SECT	JOB	HIGHWAY
5-96
1-12	DIST	COUNTY	SHEET NO.	
...	28	

DATE: \$DATE\$
FILE: \$FILES\$


DISCLAIMER: The use of this standard is governed by the "Texas Engineering Practice Act". No warranty of any kind is made by TxDOT for any purpose whatsoever. TxDOT assumes no responsibility for the conversion of this standard to other formats or for incorrect results or damages resulting from its use.

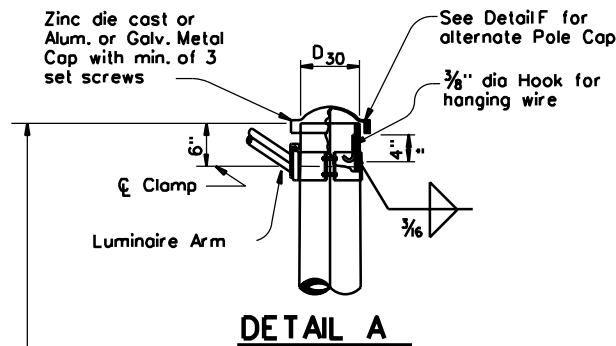


DETAIL A
(for pole with luminaire)

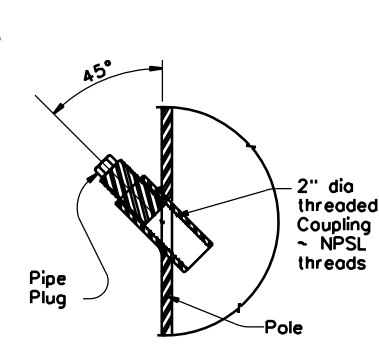

POLE COUPLING DETAIL

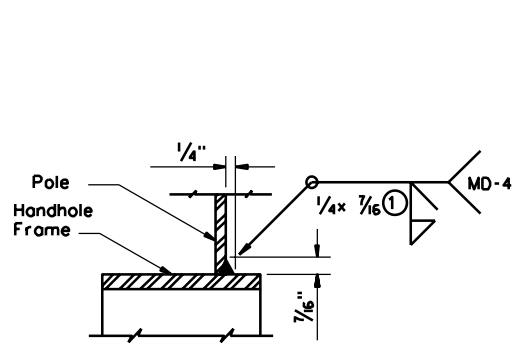


DETAIL G

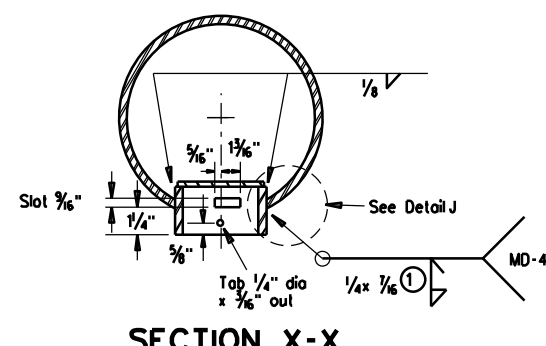


SECTION X-X


Opening for access compartment shall be no more than 1/16 inch wider than the access compartment itself.

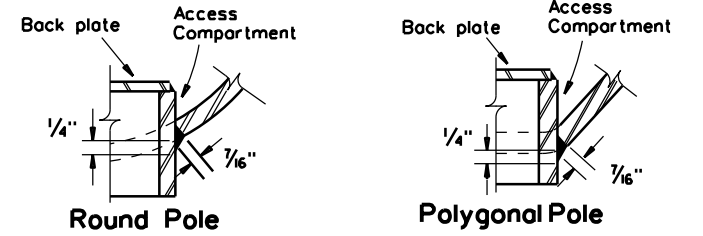


DETAIL J

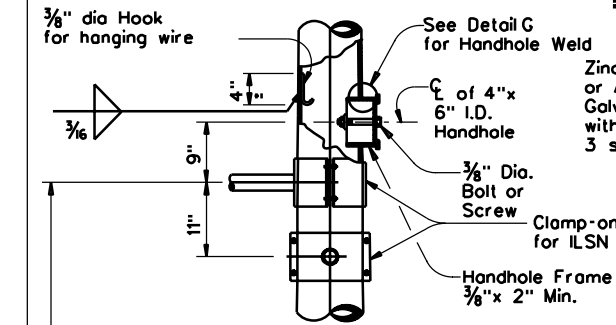


DETAIL B
(if ILSN applied)

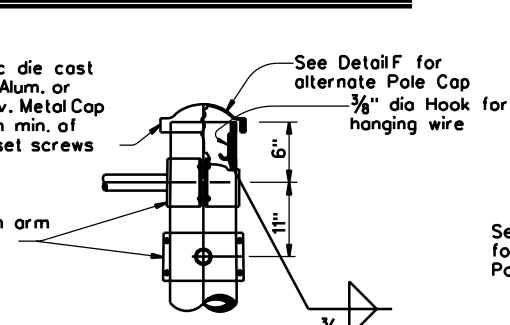


DETAIL C

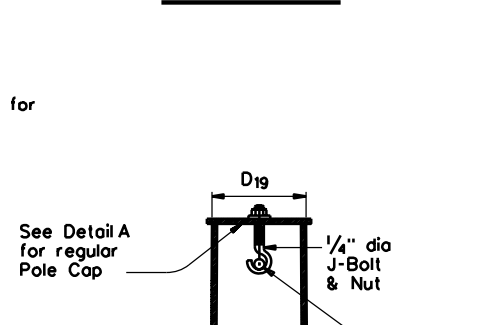

SECTION Y-Y

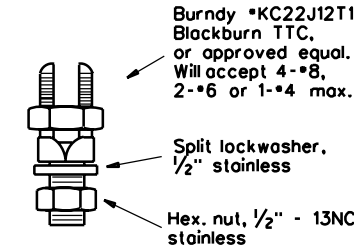


COPPER GROUND CONNECTOR

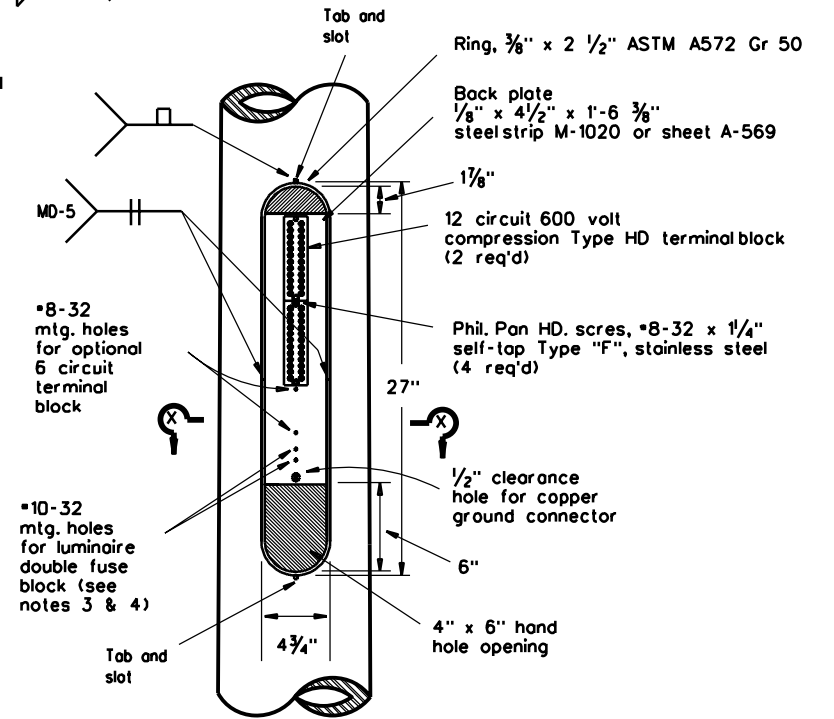


ACCESS COMPARTMENT

NOTES:


1. The cover shall be one piece formed from ABS plastic, shall be a pearl gray color, and shall be suitable for exposure to harsh sunlight and extreme weather. Cover shall latch with two screw latches and shall fit tightly to the enclosure ring to create a rainproof seal. Latch screws shall be 1/4-20 stainless flat socket head screws with tamper proof feature.
2. The pole manufacturer shall provide with each pole a separate kit consisting of: one cover with two latching assemblies, two terminal strips (Marathon #985GP12CU or approved equal), four #8-32 x 1 1/4" self tapping type "F" stainless steel pan head screws, and one ground connector (Blackburn TTC, Burndy KC22J12T13, or Ilco SSS-5). The traffic signal contractor shall install the kit items in the field.
3. The screw hole spacing on the enclosure back plate shall be for two Marathon #985GP12 terminal strips, one Marathon #985GP06CU terminal strip, and one Bussmann #BM6032B fuse block.
4. Install one Bussmann #BM6032B, Littelfuse #L60030M-2C, or Ferraz-Shawmut #30352 fuse block for poles where luminaires are to be installed.

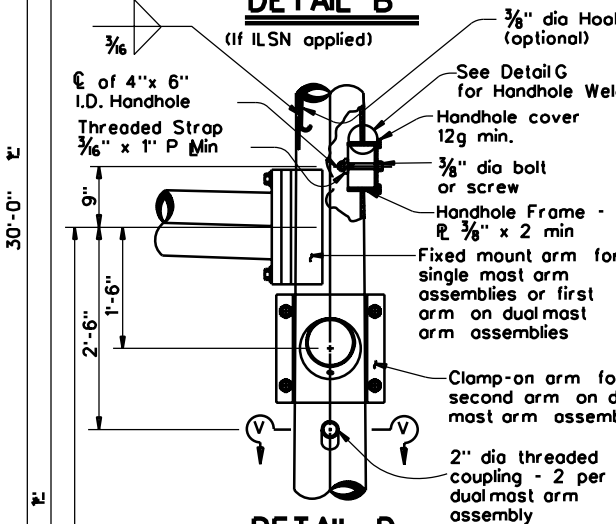


DETAIL D
(for 30" pole with luminaire and ILSN sign)

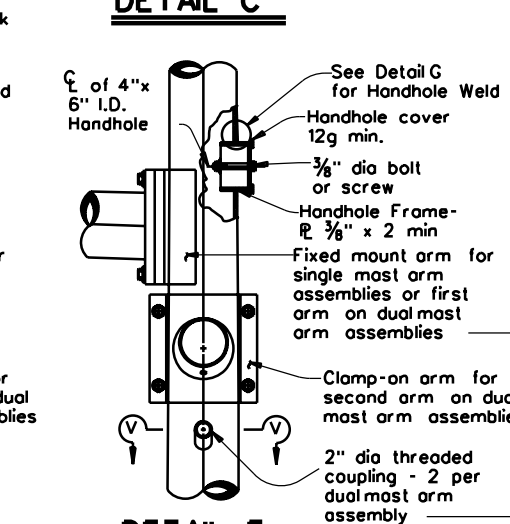

DETAIL E
(for 24" pole with ILSN sign and no luminaire)

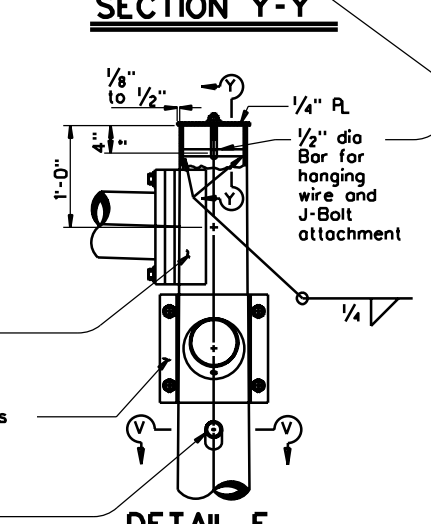


DETAIL F
(for 19" pole with no ILSN sign and no luminaire)

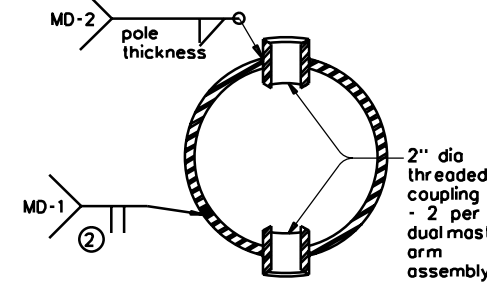


SECTION V-V


Anchor Bolt Diameter	Bolt Hole Diameter	Slot Length	Bolt Circle Diameter	Base Pl Dim. L x T	Adjust. Range
1 1/2"	1 3/4"	3 1/2"	17"	18" x 1 1/2"	13.4°
1 3/4"	2"	4"	19"	20" x 1 3/4"	13.5°
2"	2 1/4"	4 1/2"	21"	22" x 2"	13.6°
2 1/4"	2 1/2"	5"	23"	24" x 2 1/4"	13.7°

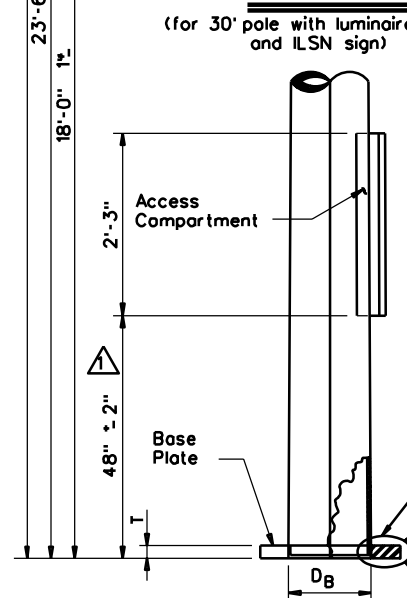

POLE ELEVATION

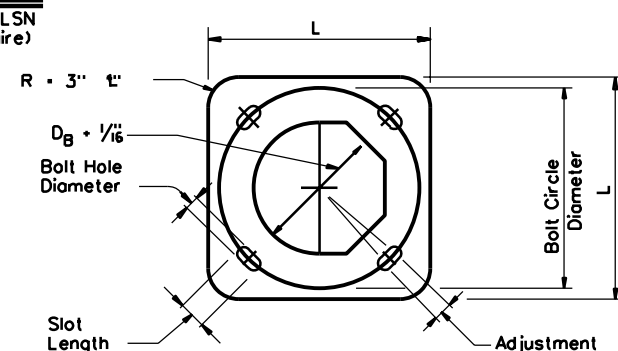

BASE PLATE PLAN

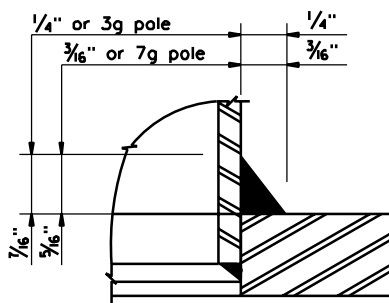

DETAIL H

- ① 85% Min. penetration
- ② 60% Min. penetration 100% penetration within 6" of circumferential base welds.


△ REVISED THE ELEVATION OF ACCESS COMPARTMENT(2/12).




TRAFFIC SIGNAL SUPPORT STRUCTURES MAST ARM POLE DETAILS MA-D-12(DAL)

© TxDOT August 1995	DNF:	CK:	DW:	CK:
REVISIONS	CONT	SECT	JOB	HIGHWAY
8-99 1-2
	DIST	COUNTY		SHEET NO.
		29


DISCLAIMER: The use of this standard is governed by the "Texas Engineering Practice Act". No warranty of any kind is made by TxDOT for any purpose whatsoever. TxDOT assumes no responsibility for the conversion of this standard to other formats or for incorrect results or damages resulting from its use.

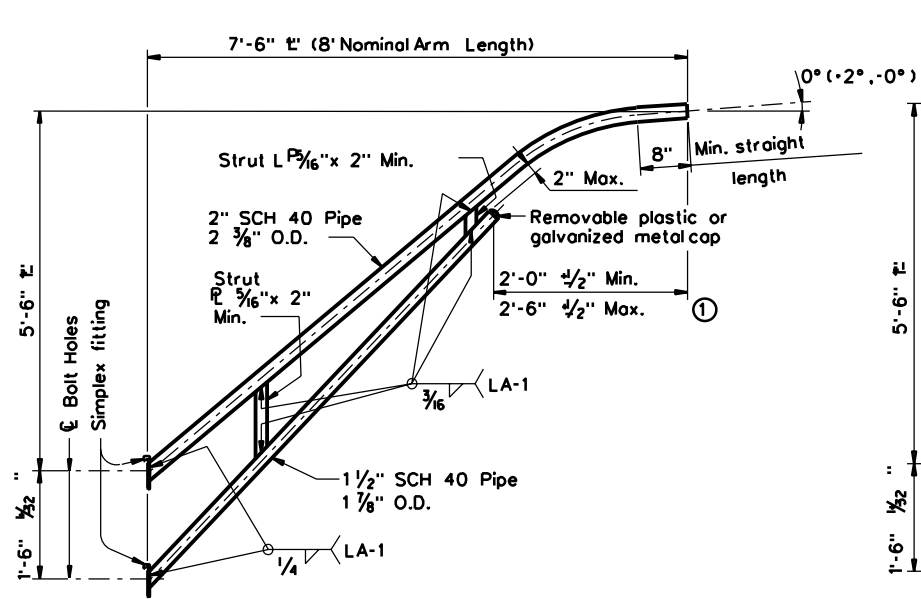

8-FOOT LUMINAIRE ARM

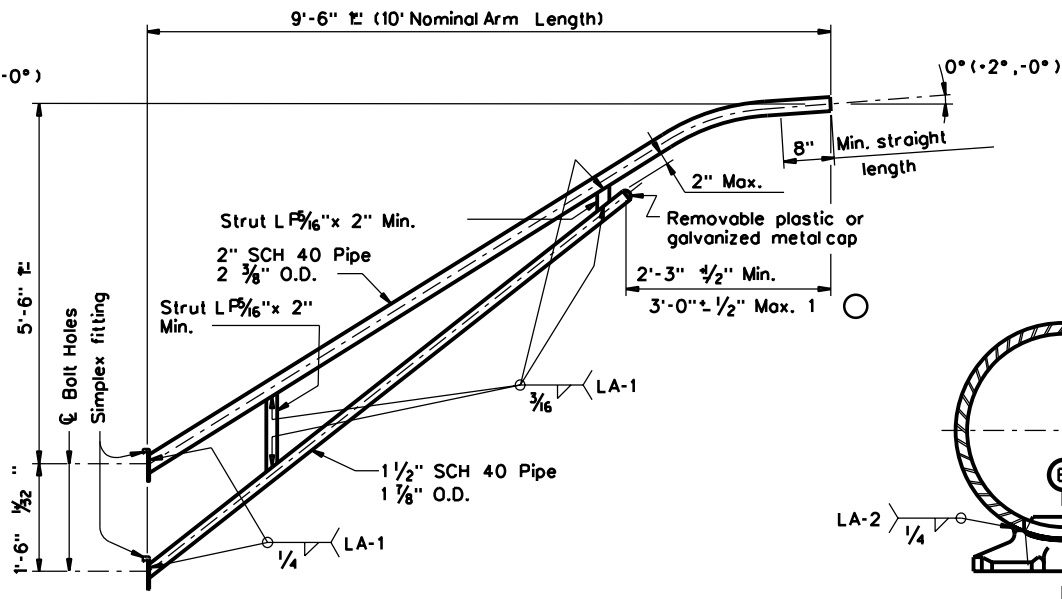

10-FOOT LUMINAIRE ARM

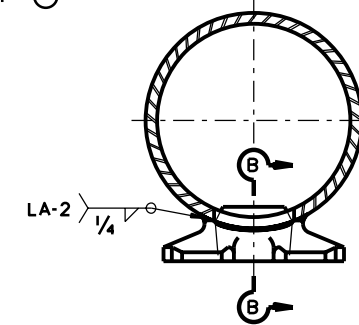

DIRECT ATTACHMENT DETAIL

- ① Dimensional limits are given to show acceptable variation in design. All of a Fabricator's production of a particular arm length shall have the same dimensions within specified tolerances.
- ② Any of the materials listed for plates may be used where the drawings do not specify a particular ASTM designation.
- ③ A576 must be suitable for forging and also meet minimum tensile strength of 65 ksi, minimum yield of 35 ksi, and elongation in 2 inches of 22 percent.
- ④ ASTM A572, A1008 HSLAS-F, and A1011 HSLAS-F may have higher yield strengths but shall not have less elongation than the grade indicated.

GENERAL NOTES:

Design conforms to 1994 AASHTO Standard Specifications for Structural Supports for Highway Signs, Luminaires, and Traffic Signals and Interim Revisions thereto. Design Wind Speed equals 90 mph plus a 1.3 gust factor. Arms are designed to support a 60 lb. luminaire having an effective projected area (actual area times drag coefficient) of 1.6 sq. ft.


Materials and fabrication shall be in accordance with Item 686, "Traffic Signal Pole Assemblies (Steel)" and with the details, dimensions, and weld procedures shown herein. Weld references call for preapproved weld procedures which the Fabricator must obtain prior to fabrication. In the absence of specified Fabrication tolerances, dimensions shall be within the tolerances generally obtainable in normal fabrication practice.

Unless otherwise noted, all parts shall be galvanized after fabrication in accordance with Item 445, "Galvanizing".

Deviation from the details and dimensions shown herein require submission of shop drawings in accordance with Item 441, "Steel Structures". Alternate designs are not acceptable.


Each pole simplex fitting shall be supplied with 2 ASTM A325 bolts and 2 lock washers of the size specified. The bolts and lock washers shall be secured to the pole with the other hardware items called for in the plans. When clamp attachment is specified, the Fabricator shall ship the clamp assembly securely attached to the pole at the location shown on the plans.

If clamp assemblies are ordered without poles, the Fabricator shall ship one upper and one lower clamp assembly together in a single package, including all nuts and washers required for the clamps and simplex fittings.

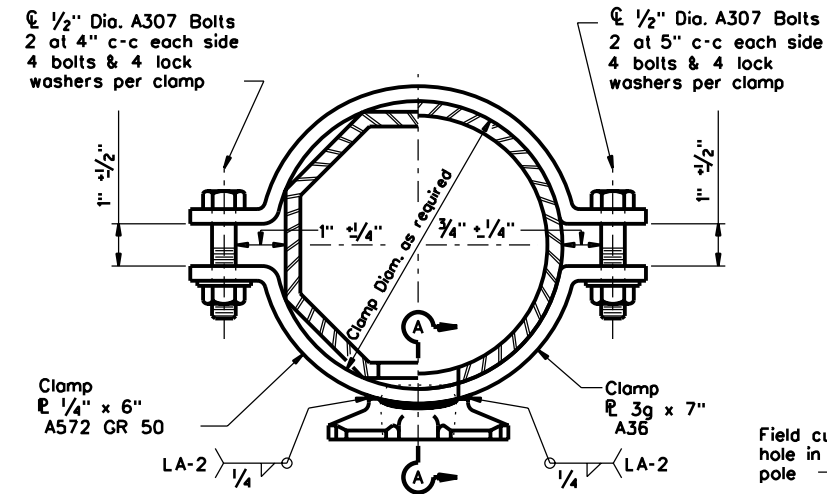


CLAMP ATTACHMENT DETAIL NO.1 (HALF SECTION)


CLAMP ATTACHMENT DETAIL NO.2 (HALF SECTION)

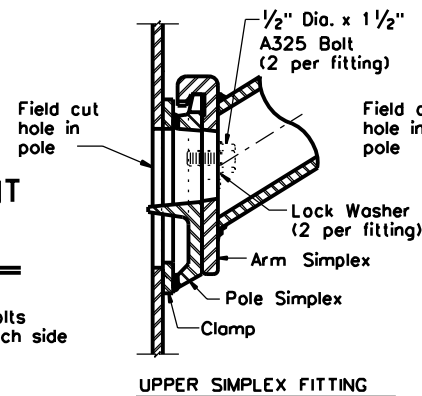


UPPER SIMPLEX FITTING

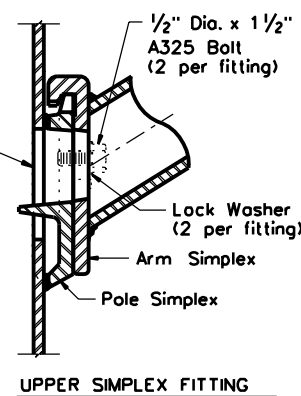

UPPER SIMPLEX FITTING

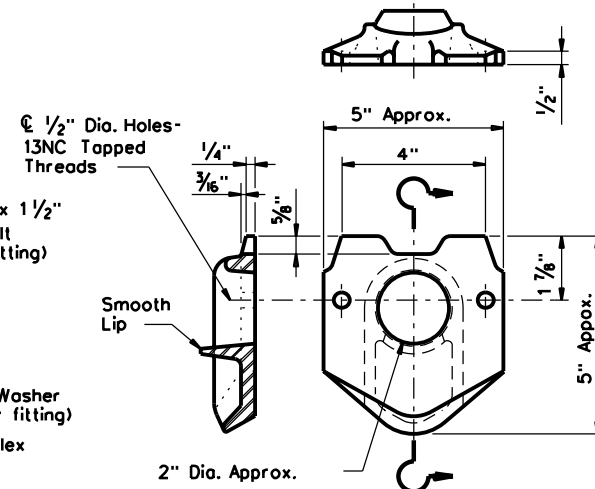


POLE SIMPLEX DETAIL

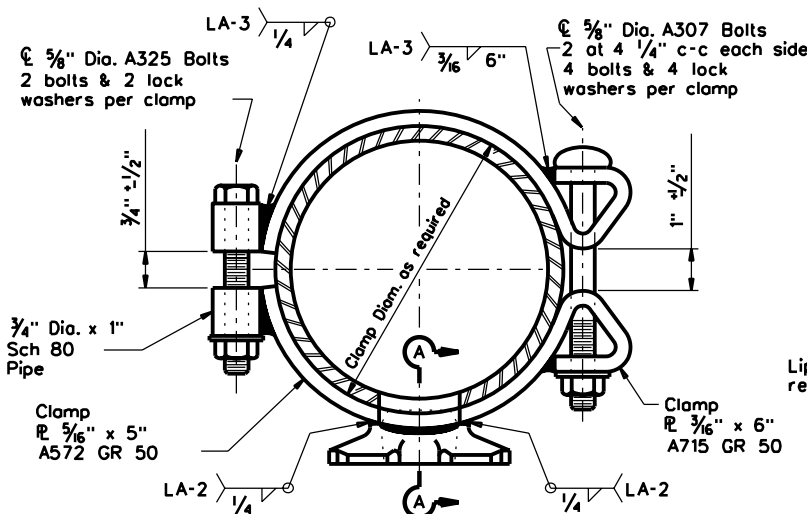


CLAMP ATTACHMENT DETAIL NO.3 (HALF SECTION)


CLAMP ATTACHMENT DETAIL NO.4 (HALF SECTION)

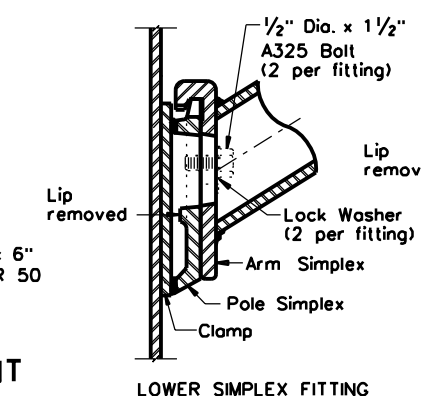

LOWER SIMPLEX FITTING

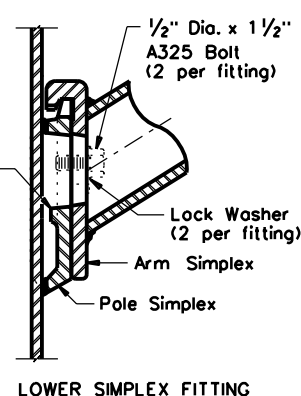

LOWER SIMPLEX FITTING

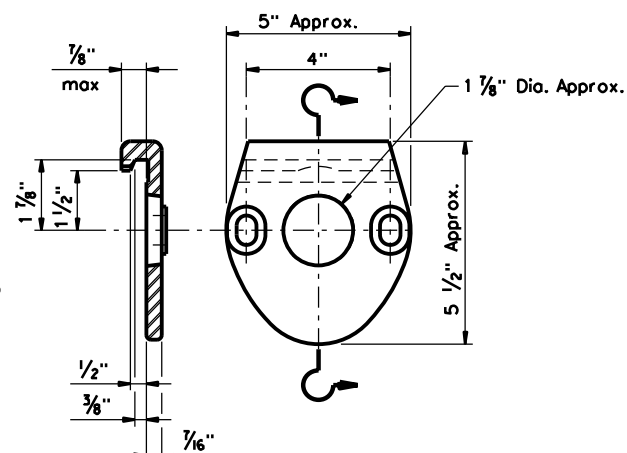

ARM SIMPLEX DETAIL

SECTION A-A

SECTION B-B

Texas Department of Transportation
Traffic Operations Division
STANDARD ASSEMBLY DRAWINGS FOR LUMINAIRE SUPPORT STRUCTURES
ARM DETAILS
LUM-A-12

© TxDOT August 1995		DN:	CK:	DW:	CK:
5-96	1-99	REVISIONS	CONT.	SECT.	JOB
1-97		
			DIST.	COUNTY	SHEET NO.
			30

DATE: FILE:

GENERAL NOTES FOR ALL ELECTRICAL WORK

1. The location of all conduits, junction boxes, ground boxes, and electrical services is diagrammatic and may be shifted to accommodate field conditions.
2. Provide new and unused materials. Ensure that all materials and installations comply with the applicable articles of the National Electrical Code (NEC), TxDOT standards and specifications, National Electrical Manufacturers Association (NEMA), and are listed by Underwriters Laboratories (UL) or a Nationally Recognized Testing Lab (NRTL). NRTLs such as Canadian Standard Association (CSA), Intertek Testing Services NA Inc., or FM Approvals LLC can be considered equivalent to UL. Where reference is made to NEMA listed devices, International Electrotechnical Commission (IEC) listed devices will not be considered an acceptable equal to a NEMA listed device. Acceptable devices may have both a NEMA and IEC listing. Faulty fabrication or poor workmanship in any material, equipment, or installation is justification for rejection. Replace or reinstall rejected material or equipment at no additional cost to the Department.
3. Miscellaneous nuts, bolts and hardware, except for high strength bolts, may be stainless steel when plans specify galvanized, provided the bolt size is 1/2 in. or less in diameter.
4. Provide the following test equipment as required by the Engineer to confirm compliance with the contract and the NEC: voltmeter, ammeter, megohm meter (1000 volt DC), ground resistance tester, torque wrenches, and torque screwdrivers. Ensure all equipment has been properly calibrated within the last year. Provide calibration certification to the Engineer upon request. Operate test equipment during inspection as requested by the Engineer.
5. Install grounding as shown on the plans and in accordance with the NEC. Ensure all metallic conduits; metal poles; luminaires; and metal enclosures are bonded to the equipment grounding conductor. Provide stranded bare copper or green insulated grounding conductors. Ground rods, connectors, and bonding jumpers are subsidiary to the various bid items.
6. When required by the Engineer, notify the Department in writing of materials from the Material Producers List (MPL) intended for use on each project. Prequalified materials are listed on the MPL on TxDOT's website under "Roadway Illumination and Electrical Supplies." No substitutions will be allowed for materials on this list.

CONDUIT

A. MATERIALS

1. Provide conduit, junction boxes, fittings, and hardware as per TxDOT Departmental Material Specification (DMS) 11030 "Conduit" and Item 618 "Conduit" of TxDOT's "Standard Specifications For Construction And Maintenance Of Highways, Streets, And Bridges," latest edition. Provide conduits listed under Item 618 on the MPL under "Roadway Illumination and Electrical Supplies." Provide conduit types according to the descriptive code or as shown on the plans. Do not substitute other types of conduits for those shown. Provide liquidtight flexible metal conduit (LFMC) when flexible conduit is called for on galvanized steel rigid metallic conduit (RMC) systems. Provide liquidtight flexible nonmetallic conduit (LFNC) when flexible conduit is called for on polyvinyl chloride (PVC) systems.
2. Provide galvanized steel RMC for all exposed conduits, unless otherwise shown on the plans. Properly bond all metal conduits.
3. Unless otherwise shown on the plans, provide junction boxes with a minimum size as shown in the following table, which applies to the greatest number of conductors entering the box through one conduit with no more than four conduits per box. When a mixture of conductor sizes is present, count the conductors as if all are of the larger size. For situations not applicable to the table, size junction boxes in accordance with NEC.

AWG	3 CONDUCTORS	5 CONDUCTORS	7 CONDUCTORS
*1	10" x 10" x 4"	12" x 12" x 4"	16" x 16" x 4"
*2	8" x 8" x 4"	10" x 10" x 4"	12" x 12" x 4"
*4	8" x 8" x 4"	10" x 10" x 4"	10" x 10" x 4"
*6	8" x 8" x 4"	8" x 8" x 4"	10" x 10" x 4"
*8	8" x 8" x 4"	8" x 8" x 4"	8" x 8" x 4"

4. Junction boxes with an internal volume of less than 100 cu. in. and supported by entering raceways must have threaded entries or hubs identified for the intended purpose and supported by connection of two or more rigid metal conduits. Secure conduit within 3 ft. of the enclosure or within 18 in. of the enclosure if all conduit entries are on the same side. Mechanically secure all junction boxes with an internal volume greater than 100 cu. inches.
5. Provide hot dipped galvanized cast iron or sand cast aluminum outlet boxes for junction boxes containing only 10 AWG or 12 AWG conductors. Do not use die cast aluminum boxes. Size outlet boxes according to the NEC.
6. Do not use intermediate metal conduit (IMC) or electrical metallic tubing (EMT) unless specifically required by the plan sheets. When EMT is called for, provide junction boxes made from galvanized steel sheeting, listed and approved for outdoor use, unless otherwise noted on the plans. Size all galvanized steel junction boxes in accordance with the NEC. Provide junction boxes for IMC conduit systems that meet the same requirements for junction boxes used with RMC systems.
7. Provide PVC junction boxes intended for outdoor use on PVC conduit systems, unless otherwise noted on the plans.


8. Provide PVC elbows in PVC conduit systems, unless otherwise shown on the plans. Use only a flat, high tensile strength polyester fiber pull tape for pulling conductors through the PVC conduit system. When galvanized steel RMC elbows are specifically called for in the plans and any portion of the RMC elbow is buried less than 18 in., ground the RMC elbow by means of a grounding bushing on a rigid metal extension. Grounding of the rigid metal elbow is not required if the entire RMC elbow is encased in a minimum of 2 in. of concrete. PVC extensions are allowed on these concrete encased rigid metal elbows. RMC or PVC elbows are subsidiary to various bid items.
9. When required, provide High-Density Polyethylene (HDPE) conduit with factory installed internal conductors according to Item 622 "Duct Cable." At the Contractor's request and with approval by the Engineer, substitute HDPE conduit with no conductors for bored schedule 40 or schedule 80 PVC conduit bid under Item 618. Ensure bored HDPE substituted for PVC is schedule 40 and of the same size PVC called for in the plans. Ensure the substituted HDPE meets the requirements of Item 622, except that the conduit is supplied without factory-installed conductors. Make the transition of the HDPE conduit to PVC (or RMC elbow when required) at the bore pit. Provide conduit of the size and schedule as shown on the plans. Do not extend substituted conduit into ground boxes or foundations. Provide PVC or galvanized steel RMC elbows as called for at all ground boxes and foundations.
10. Use two-hole straps when supporting 2 in. and larger conduits. On electrical service poles, properly sized stainless steel or hot dipped galvanized one-hole standoff straps are allowed on the service riser conduit.

B. CONSTRUCTION METHODS


1. Provide and install expansion joint conduit fittings on all structure-mounted conduits at the structure's expansion joints to allow for movement of the conduit. In addition, provide and install expansion joint fittings on all continuous runs of galvanized steel RMC conduit externally exposed on structures such as bridges at maximum intervals of 150 ft. When requested by the project Engineer, supply manufacturer's specification sheet for expansion joint conduit fittings. Repair or replace expansion joint fittings that do not allow for movement at no additional cost to the Department. Provide the method of determining the amount of expansion to the Engineer upon request. Do not use LFMC or LFNC as a substitute for the required expansion conduit fittings.
2. Space all conduit supports at maximum intervals of 5 ft. Install conduit spacers when attaching metal conduit to surface of concrete structures. See "Conduit Mounting Options" on ED(2). Install conduit support within 3 ft. of all enclosures and conduit terminations.
3. Do not attach conduit supports directly to pre-stressed concrete beams except as shown specifically in the plans or as approved by the Engineer.
4. Unless otherwise shown on the plans, jack or bore conduit placed beneath existing roadways, driveways, sidewalks, or after the base or surfacing operation has begun. Backfill and compact the bore pits below the conduit per Item 476 "Jacking, Boring, or Tunneling Pipe or Box" prior to installing conduit or duct cable to prevent bending of the connections.
5. When placing conduit in the sub-grade of new roadways, backfill all trenches with excavated material unless otherwise noted on the plans. When placing conduit in the sub-base of new roadways, backfill all trenches with cement-stabilized base as per requirements of Items 110 "Excavation", 400 "Excavation and Backfill for Structures", 401 "Flowable Backfill", 402 "Trench Excavation Protection", and 403 "Temporary Special Shoring."
6. Provide and place warning tape approximately 10 in. above all trenched conduit as per Item 618.
7. During construction, temporarily cap or plug open ends of all conduit and raceways immediately after installation to prevent entry of dirt, debris and animals. Temporary caps constructed of durable duct tape are allowed. Tightly fix the tape to the conduit opening. Clean out the conduit and prove it clear in accordance with Item 618 prior to installing any conductors.
8. Ensure conduit entry into the top of any enclosure is waterproof by installing conduit sealing hubs or using boxes with threaded bosses. This includes surface mounted safety switches, meter cans, service enclosures, auxiliary enclosures and junction boxes. Grounding bushings on water tight sealing hubs are not required.
9. Fit the ends of all PVC conduit terminations with bushings or bell end fittings. Provide and install a grounding type bushing on all metal conduit terminations.
10. Install a bonding jumper from each grounding bushing to the nearest ground rod, grounding lug, or equipment grounding conductor. Ensure all bonding jumpers are the same size as the equipment grounding conductor. Bonding of conduit used as a casing under roadways for duct cable is not required, if the duct extends the full length through the casing.
11. At all electrical services, install a 6 AWG solid copper grounding electrode conductor.
12. Place conduits entering ground boxes so that the conduit openings are between 3 in. and 6 in. from the bottom of the box. See the ground box detail on sheet ED(4).
13. Seal ends of all conduits with duct seal, expandable foam, or by other methods approved by the Engineer. Seal conduit immediately after completion of conductor installation and pull tests. Do not use duct tape as a permanent conduit sealant. Do not use silicone caulk as a conduit sealant.
14. File smooth the cut ends of all mounting strut and conduit. Before installing, point the field cut ends of all mounting strut and RMC (threaded or non-threaded) with zinc rich paint (94% or more zinc content) to alleviate overspray. Use zinc rich paint to touch up galvanized material as allowed under Item 445 "Galvanizing." Do not paint non-galvanized material with a zinc rich paint as an alternative for materials required to be galvanized.

DISCLAIMER: The use of this standard is governed by the "Texas Engineering Practice Act". No warranty of any kind is made by TxDOT for any purpose whatsoever. TxDOT assumes no responsibility for the conversion of this standard to other formats or for incorrect results or damages resulting from its use.

DATE:
FILE:

 Texas Department of Transportation		Traffic Operations Division Standard	
<h2>ELECTRICAL DETAILS CONDUITS & NOTES</h2>			
<h3>ED(1)-14</h3>			
FILE: ed1-14.dgn	DN:	CK:	DW:
© TxDOT October 2014	CONT	SECT	JOB
REVISIONS	---	---	---
	DIST	COUNTY	SHEET NO.
	---	---	31


DISCLAIMER: The use of this standard is governed by the "Texas Engineering Practice Act". No warranty of any kind is made by TxDOT for any purpose whatsoever. TxDOT assumes no responsibility for the conversion of this standard to other formats or for incorrect results or damages resulting from its use.

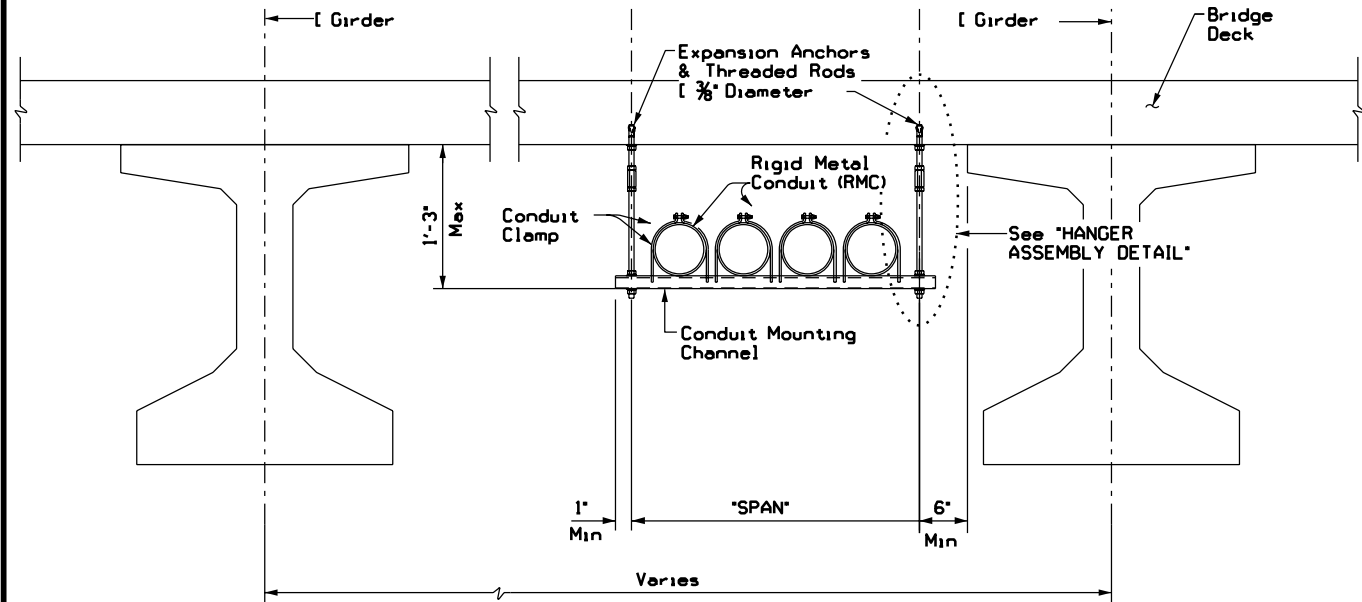

CONDUIT HANGING DETAIL



CONDUIT MOUNTING CHANNEL		
"SPAN"	"W" x "H"	"T"
less than 2'	1 5/8" x 1 3/8"	12 Ga.
2'-0" to 2'-6"	1 5/8" x 1 5/8"	12 Ga.
>2'-6" to 3'-0"	1 5/8" x 2 7/16"	12 Ga.

Channels with round or short slotted hole patterns are allowed, if the load carrying capacity is not reduced by more than 15%.

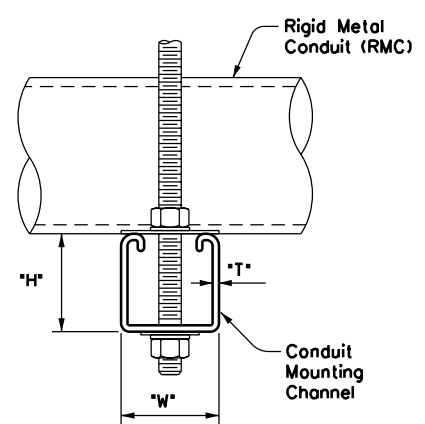


HANGER ASSEMBLY DETAIL

ELECTRIC CONDUIT TO BRIDGE DECK ATTACHMENT

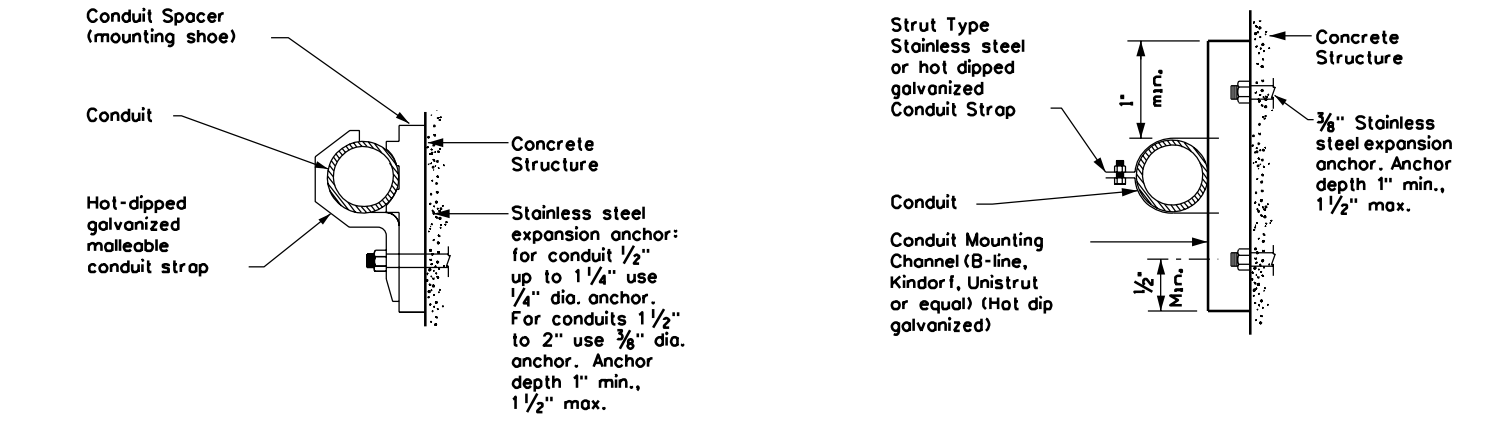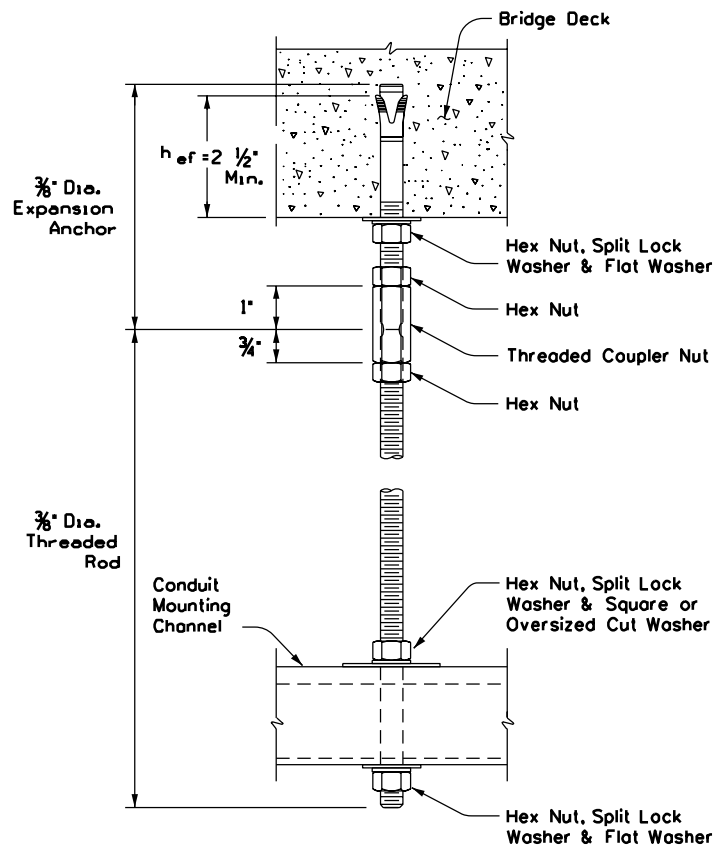

CONDUIT MOUNTING OPTIONS

Attachment to concrete surfaces
See ED(1)B.2

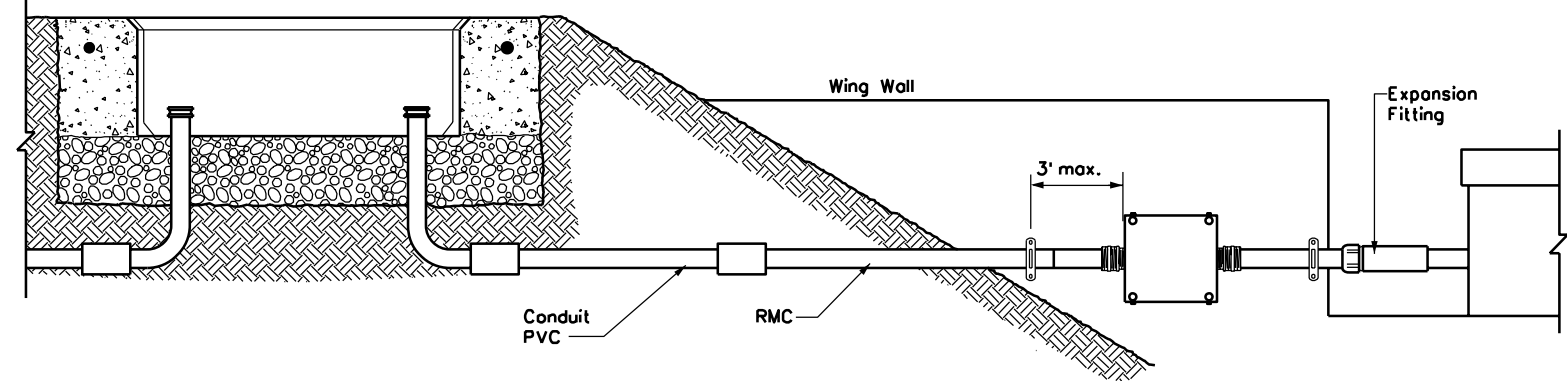

TYPICAL CONDUIT ENTRY TO BRIDGE STRUCTURE DETAIL

EXPANSION ANCHOR NOTES FOR BRIDGE DECK ATTACHMENT

1. Use torque controlled mechanical expansion anchors that are approved for use in cracked concrete by the International Code Council, Evaluation Service (ICC-ES). The chosen anchor product shall have a designated ICC-ES Evaluation Report number, and its approval status shall be maintained on the ICC-ES website under Division 031600 for Concrete Anchors.
2. Unless otherwise approved by the Engineer: do not use adhesive anchors; do not use expansion anchors that are not included in the ICC-ES approval list; and do not use expansion anchors that are only approved for use in uncracked concrete.
3. Use anchors manufactured with stainless steel expansion wedges. Anchors manufactured with carbon steel expansion wedges are not allowed. Anchor bodies can be either zinc-plated carbon steel or stainless steel. For application in marine environment, both the anchor body and expansion wedge shall be stainless steel.
4. Install anchors as shown on the plans and in accordance with the anchor manufacturer's published installation instructions. Arrange a field demonstration test to evaluate the procedures and tools. The test shall be witnessed and approved by the Engineer prior to furnishing anchors on the structure.
5. Prior to hole drilling, use rebar locator to ensure clearing of existing deck strands or reinforcement. Install anchors to ensure a minimum effective embedment depth, (ef) as shown. Increase (ef) as needed to ensure sufficient thread length for proper torqueing and tightening of anchors.
6. Use anchors of minimum 1600 Lbs tensile capacity (minimum of steel, concrete breakout, and concrete pullout strengths as determined by ACI 318 Appendix D) at the required minimum embedment depth (ef). No lateral loads shall be introduced after conduit installation.



ELECTRICAL DETAILS
CONDUIT SUPPORTS

ED(2)-14

FILE: ed2-14.dgn	DN: TxDOT	CK: TxDOT	DW: TxDOT	CK: TxDOT
© TxDOT October 2014	CONT	SECT	JOB	HIGHWAY
REVISIONS	---	---	---	---
	DIST	COUNTY	SHEET NO.	
	---	---	32	

DATE:
FILE:

ELECTRICAL CONDUCTORS

A. MATERIAL INFORMATION

- Provide Type XHHW insulated conductors in accordance with Departmental Material Specification (DMS) 11040 "Conductors" and Item 620 "Electrical Conductors." Provide conductors as listed on the Material Producers List (MPL) on the Department web site under "Roadway Illumination and Electrical Supplies" Item 620. Color code insulated conductors in conformance with the NEC. Identify grounded (neutral) conductors with white insulation. Identify grounding conductors (ground wires) with green insulation or bare conductors. Identify ungrounded (hot) conductors with any color insulation except green, white, or gray. Keep color scheme consistent throughout the wiring system. Identify conductors 6 American Wire Gauge (AWG) and smaller by continuous color jacket. Identify electrical conductors 4 AWG and larger by continuous color jacket or by colored tape. When identifying conductors with colored tape, mark at least 6 in. of the conductor's insulation with half laps of tape.
- Provide a solid copper 6 AWG grounding electrode conductor to bond the electrical service equipment to the concrete encased grounding electrode or the ground rod at the service location. Connect the grounding electrode conductor to the ground rod with a UL listed connector in accordance with DMS 11040. Connect the grounding electrode conductor to the concrete encased grounding electrode as shown in the plans.
- Where two or more circuits are present in one conduit or enclosure, permanently identify the conductors of each branch circuit by attaching a non-metallic tag around both circuit conductors at each accessible location. Provide tags with two straps, large enough to indicate circuit number, letter, or other identification as shown in the plans. Print circuit identification on the tag with a permanent marker.
- Use listed compression or screw type pressure connectors, terminal blocks, or split bolt connectors for splicing as specified in DMS 11040. Use hot melt adhesive tape to fill the gap and seal the ends of heat shrink tubing. Provide UL listed gel-filled insulating splice covers. Splicing materials, insulating materials, breakaway disconnects, splice covers, and fuse holders are subsidiary to various bid items.

B. CONSTRUCTION METHODS

- Use only a flat, high tensile strength polyester fiber pull tape for pulling conductors through the conduit system. After installing conductors in conduit, perform conductor pull test. If a conductor cannot be freely pulled, make any needed alterations or repairs at no additional cost to the department. Perform insulation resistance tests in accordance with Item 620. Coordinate with the Engineer to witness the tests.
- Leave 2 ft. minimum, 3 ft. maximum length for each conductor up to the splice in ground boxes. Leave 3 ft. minimum, 4 ft. maximum length of conductor in ground boxes when pulled through with no splice. Leave 1 ft. minimum, 1.5 ft. maximum length of conductor at enclosures, weatherheads and pole bases.
- Make splices only in junction boxes, ground boxes, pole bases, or electrical enclosures and use only listed compression or screw type pressure connectors, terminal blocks, or split bolt connectors. Insulate splices with heavy wall heat shrink tubing or gel-filled insulating splice covers to provide a watertight splice. Overlap conductor insulation with heat shrink tubing a minimum of 2 in. past both sides of the splice. Where heat shrink tubing may not shrink sufficiently to provide a watertight seal around the individual conductors, prior to heating the tubing, increase the diameter of the conductor insulation using hot melt adhesive tape to provide a watertight seal between the individual conductors and the heat shrink tubing. Ensure the tape extends past the heat shrink tubing. Use hot melt adhesive tape to fill the gap and seal the ends of heat shrink tubing. Heat shrink tubing that appears to have been burned, or overheated, is considered defective and must be replaced.
- Size and install gel-filled insulating splice covers according to manufacturer's specifications when used in place of heat shrink tubing.
- Wire nuts with factory applied waterproof sealant may be used for 8 AWG or smaller conductors in above ground junction boxes, but not in pole bases or ground boxes. Install wire nuts in an upright position to prevent the accumulation of water.
- Support conductors in illumination poles with a J-hook at the top of the pole.
- When terminating conductors, remove the insulation and jacketing material without nicking the individual strands of the conductor. Conductors with nicked individual conductor strands or removed strands will be considered damaged.
- Replace conductors and cables that are damaged beyond repair or that fail an insulation resistance test at no additional cost to the department.
- Do not repair damaged conductors with duct tape, electrical tape, or wire nuts. Use only approved splicing methods.
- Do not terminate more than one conductor under a single connector, unless the connector is rated for multiple conductors. Do not exceed the pressure connector's listing for maximum number and size of conductors allowed.
- Install breakaway connectors on conductors bid under Item 620 whenever those conductors pass through a breakaway support device. Follow manufacturer's instructions when terminating conductors to breakaway connectors. Properly torque threaded connections. Proper terminations are critical to the safe operation of breakaway devices. Trim waterproofing boots on breakaway connectors to fit snugly around the conductor to ensure waterproof connection. Only one conductor may enter a single opening in a boot. Provide waterproof boots with the correct number of openings. Leave unused openings factory sealed. Use prequalified breakaway connectors as shown on the MPL.

- Provide and install a separate stranded equipment grounding conductor (EGC) in all conduits that contain circuit wiring of 50 volts or more. Unless shown elsewhere, size the EGC to be the same size as the largest current carrying conductor contained in the conduit. Ensure all EGCs are bonded together at every accessible location. For traffic signal installations, provide a minimum size 8 AWG EGC. The EGC is paid for under Item 620.

C. TEMPORARY WIRING

- Install temporary conductors and electrical equipment in accordance with the NEC article "Temporary Installations" and Department standard sheets.
- Provide a ground fault circuit interrupter (GFCI) for power outlets for portable electrical equipment, power tools, ice machines, ice storage bins and refrigerators located outdoors at grade. GFCI may be any one of the following: molded cord and plug set, receptacle, or circuit breaker type.
- Use listed wire nuts with factory applied sealant for temporary wiring where approved.
- Enclose conductor splices within a listed enclosure or ground box, or ensure the splices are more than 10 ft. above grade vertically and more than 5 ft. horizontally from any metal structure. Where installing temporary conductors in areas subject to vehicle traffic or mobile construction equipment, ensure the vertical clearance to ground is at least 18 ft. when measured at the lowest point. Ground messenger wires that support power conductors in conformance with the NEC.
- Protect and when necessary repair any existing electrical conduits uncovered during the construction process in a timely manner and in conformance with the NEC.


GROUND RODS & GROUNDING ELECTRODES

A. MATERIAL INFORMATION


- Provide and install a grounding electrode at electrical services. Provide ground rods according to DMS 11040 and the plans. Larger diameter or longer length rods may be called for in some specific locations, see the individual plans sheets. Concrete encased grounding electrodes may be called for in specific locations including electrical service, see individual plan sheets.

B. CONSTRUCTION METHODS


- Furnish auxiliary ground rods for lightning protection and install in soil, concrete, or both, as called for in the plans. For ground rods installed in concrete, ensure the connection of the conductor to the ground rod is readily accessible for inspection or repairs. For ground rods installed in soil, ensure that the upper end is between 2 to 4 in. below finished grade.
- Do not place ground rods in the same drilled hole as a timber pole.
- Install ground rods so the imprinted part number is at the upper end of the rod.
- Remove all non-conductive coatings such as concrete splatter from the rod at the clamp location.
- Route all conductors as short and straight as possible for connection to lightning protection ground rods. When a bend is required, ensure a minimum radius bend of four inches for these conductors.
- Unless otherwise called for in the plans, protect grounding electrode conductors with non-metallic conduit. When protecting grounding electrode conductors with metal conduit, provide and install a grounding type bushing and properly sized bonding jumper on each end of the metal conduit.
- Written authorization is required before installing a ground rod in a horizontal trench for rocky soil or a solid rock bottom.

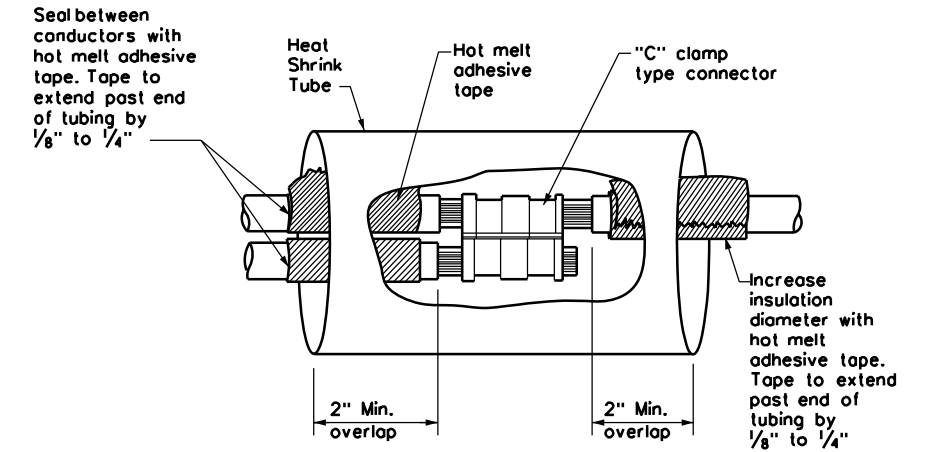

**SPLICE OPTION 1
Compression Type**

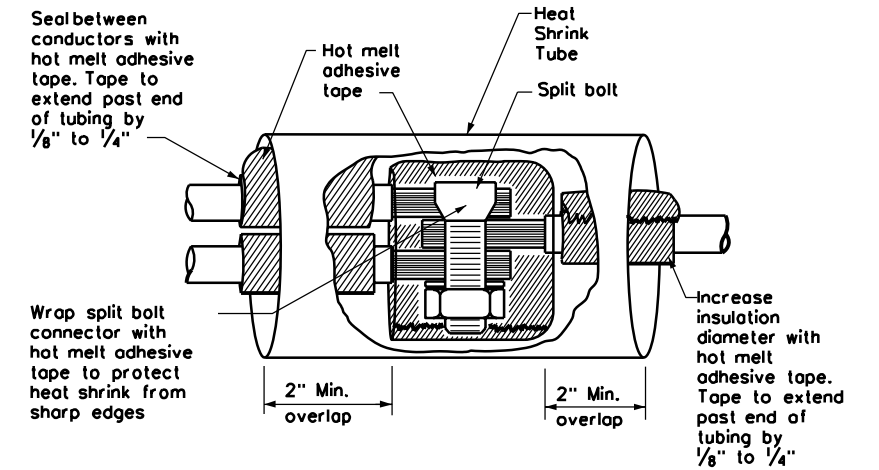

**SPLICE OPTION 2
Split Bolt Type**

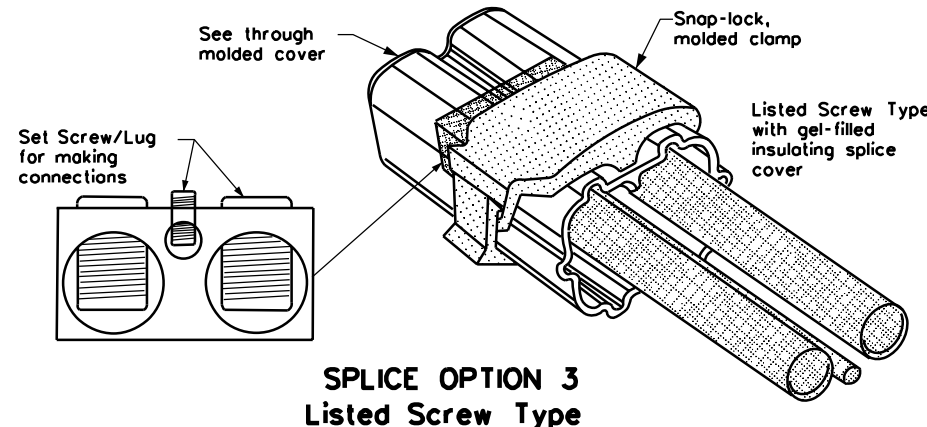


**SPLICE OPTION 3
Listed Screw Type**

DISCLAIMER: The use of this standard is governed by the "Texas Engineering Practice Act". No warranty of any kind is made by TxDOT for any purpose whatsoever. TxDOT assumes no responsibility for the conversion of this standard to other formats or for incorrect results or damages resulting from its use.

DATE:
FILE:

		Traffic Operations Division Standard	
<h2>ELECTRICAL DETAILS CONDUCTORS</h2>			
<h3>ED(3)-14</h3>			
FILE: ed3-14.dgn	DN: TxDOT	CK: TxDOT	OW: TxDOT
© TxDOT October 2014	CONT	SECT	JOB
REVISIONS	---	---	---
	DIST	COUNTY	SHEET NO.
	---	---	33

DISCLAIMER: The use of this standard is governed by the "Texas Engineering Practice Act". No warranty of any kind is made by TxDOT for any purpose whatsoever. TxDOT assumes no responsibility for the conversion of this standard to other formats or for incorrect results or damages resulting from its use.

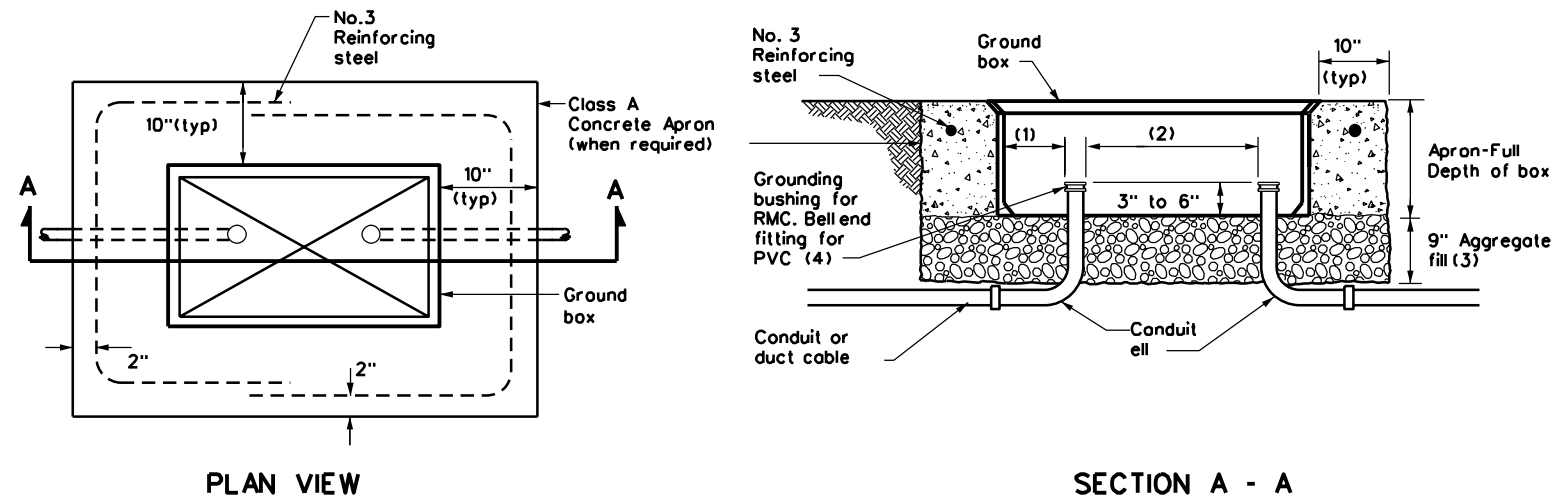


APRON FOR GROUND BOX

- (1) Uniformly space ends of conduits within the ground box. Position ends of conduits so that ground box walls do not interfere with the installation of grounding bushings or bell end fittings.
- (2) Maintain sufficient space between conduits to allow for proper installation of bushing.
- (3) Place aggregate under the box, not in the box. Aggregate should not encroach on the interior volume of the box.
- (4) Install a grounding bushing on the upper end of all RMC terminating in a ground box. Ground RMC elbows when any part of the elbow is less than 18 in. below the bottom of the ground box. Install a PVC bushing or bell end fitting on the upper end of all PVC conduits terminating in a ground box.

GROUND BOX DIMENSIONS	
TYPE	OUTSIDE DIMENSIONS (INCHES) (Width x Length X Depth)
A	12 X 23 X 11
B	12 X 23 X 22
C	16 X 29 X 11
D	16 X 29 X 22
E	12 X 23 X 17

GROUND BOX COVER DIMENSIONS								
TYPE	DIMENSIONS (INCHES)							
	H	I	J	K	L	M	N	P
A, B & E	23 1/4	23	13 3/4	13 1/2	9 7/8	5 1/8	1 3/8	2
C & D	30 1/2	30 1/4	17 1/2	17 1/4	13 1/4	6 3/4	1 3/8	2

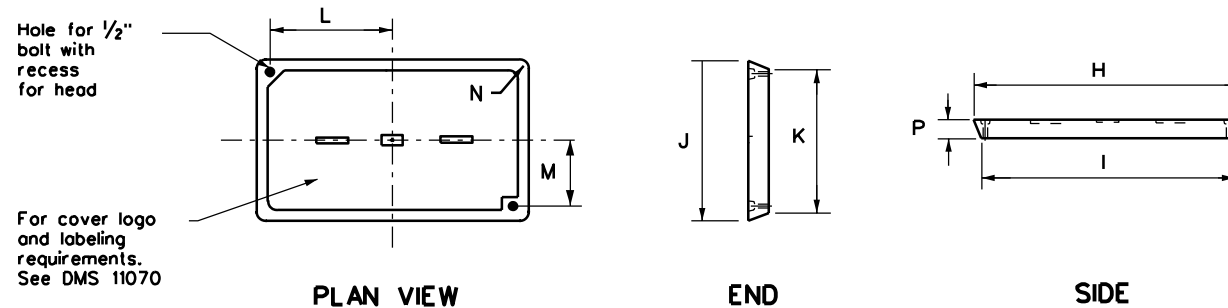

GROUND BOX COVER

GROUND BOXES

A. MATERIALS

1. Provide polymer concrete ground boxes measuring 16x30x24 in. (WxLxD) or smaller in accordance with Departmental Material Specification (DMS) 11070 "Ground Boxes" and Item 624 "Ground Boxes."
2. Provide Type A, B, C, D, and E ground boxes as shown in the plans, and as listed on the Material Producers List (MPL) on the Department web site under "Roadway Illumination and Electrical Supplies," Item 624.

3. Ensure ground box cover is correctly labeled in accordance with DMS 11070.

4. Provide larger ground boxes in accordance with Item 624 and as shown in the plans.

B. CONSTRUCTION METHODS

1. Remove all gravel and dirt from conduit. Cap all conduits prior to placing aggregate and setting ground box. Provide Grade 3 or 4 coarse aggregate as shown in Table 2 of Item 302 "Aggregates for Surface Treatments." Ensure aggregate bed is in place and at least 9 inches deep, prior to setting the ground box. Install ground box on top of aggregate.
2. Cast ground box aprons in place. Reinforcing steel may be field bent. Ensure the depth of concrete for the apron extends from finished grade to the top of the aggregate bed under the box. Ground box aprons, including concrete and reinforcing steel, are subsidiary to ground boxes when called for by descriptive code.
3. Keep bolt holes in the box clear of dirt. Bolt covers down when not working in ground boxes.
4. Install all conduits and ells in a neat and workmanlike manner. Uniformly space conduits so grounding bushings and bell end fittings can easily be installed.
5. Temporarily seal all conduits in the ground box until conductors are installed.
6. Permanently seal conduits immediately after the completion of conductor installation and pull tests. Permanently seal the ends of all conduits with duct seal, expandable foam, or other method as approved. Do not use duct tape as a permanent conduit sealant. Do not use silicone caulk as a sealant.
7. When a ground rod is present in a ground box, bond all equipment grounding conductors together and to the ground rod with listed connectors.
8. When a type B or D ground box is stacked to meet volume requirements, it is allowable to cut an appropriately sized hole for conduit entry in the side wall at least 18 inches below grade.
9. If an existing ground box in the contract has a metal cover, bond the cover to the equipment grounding conductor with a 3 ft. long stranded bonding jumper the same size as the grounding conductor. The bonding jumper is subsidiary to various bid items. Verify existing ground boxes with metal covers are shown on the plans, with notes fully describing the work required.
10. If other ground boxes with metal covers are within the project limits but are not part of the contract, the Engineer may direct the Contractor to bond the metal covers, identifying the specific boxes in writing. This work will be paid for separately.
11. Bond metal ground box covers to the grounding conductor with a tank ground type lug.

				Traffic Operations Division Standard	
<h2>ELECTRICAL DETAILS GROUND BOXES</h2>					
<h3>ED(4)-14</h3>					
FILE: ed4-14.dgn	DN: TxDOT	CK: TxDOT	DW: TxDOT	CK: TxDOT	
© TxDOT October 2014	CONT	SECT	JOB	HIGHWAY	
REVISIONS	---	---	---	---	
	DIST	COUNTY		SHEET NO.	
	---	---		34	

DATE:
FILE:

ELECTRICAL SERVICES NOTES

- Provide new materials. Ensure installation and materials comply with the applicable provisions of the National Electrical Code (NEC) and National Electrical Manufacturers Association (NEMA) standards. Ensure materials Underwriters Laboratories (UL) listed. Provide and install electrical service conduits, conductors, disconnects, contactors, circuit breaker panels, and branch circuit breakers as shown on the Electrical Service Data chart in the plans. Faulty fabrication or poor workmanship in material, equipment, or installation is justification for rejection. Where manufacturers provide warranties and guarantees as a customary trade practice, furnish these to the State.
- Provide electrical services in accordance with Electrical Details standard sheets, Departmental Material Specification (DMS) 11080 "Electrical Services," DMS 11081 "Electrical Services-Type A," DMS 11082 "Electrical Services-Type C," DMS 11083 "Electrical Services-Type D," DMS 11084 "Electrical Services-Type T," DMS 11085 "Electrical Services-Pedestal (PS)", and Item 628 "Electrical Services" of the Standard Specifications. Provide electrical service types A, C, and D, as listed on the Material Producers List (MPL) on the Department web site under "Roadway Illumination and Electrical Supplies," Item 628. Provide other service types as detailed on the plans.
- Provide all work, materials, services, and any incidentals needed to install a complete electrical service as specified in the plans.
- Coordinate with the Engineer and the utility provider for metering and compliance with utility requirements. Primary line extensions, connection charges, meter charges, and other charges by the utility company to provide power to the location are paid for in accordance with Item 628. Get approval for the costs associated with these charges prior to engaging the utility company to do the work. Consult with the utility provider to determine costs and requirements, and coordinate the work as approved.
- The enclosure manufacturer will provide Master Lock Type 2 with brass tumblers keyed #2195 for all custom electrical enclosures. Installing Contractor is to provide Master Lock #2195 Type 2 with brass tumblers for "off the shelf" enclosures. Master Lock #2195 keys and locks become property of the State. Unless otherwise approved, do not energize electrical service equipment until locks are installed.
- Enclosures with external disconnects that de-energize all equipment inside the enclosure do not need a dead front trim. Protect incoming line terminations from incidental contact as required by the NEC.
- When galvanized is specified for nuts, screws, bolts or miscellaneous hardware, stainless steel may be used.
- Provide wiring and electrical components rated for 75°C. Provide red, black, and white colored XHHW service entrance conductors of minimum size 6 American Wire Gauge (AWG). Identify size 6 AWG conductors by continuous color jacket. Identify electrical conductors sized 4 AWG and larger by continuous color jacket or by colored tape. Mark at least 6 inches of the conductor's insulation with half laps of colored tape, when identifying conductors. Ensure each service entrance conductor exits through a separately bushed non-metallic opening in the weatherhead. The lengths of the conductors outside the weatherhead are to be 12 inches minimum, 18 inches maximum, or as required by utility.
- All electrical service conduit and conductors attached to the electrical service including the riser or the elbow below ground are subsidiary to the electrical service. For an underground utility feed, all service conduit and conductors after the elbow, including service conduit and conductors for the utility pole riser when furnished by the Contractor, will be paid for separately.
- Provide rigid metal conduit (RMC) for all conduits on service, except for the 1/2 in. PVC conduit containing the electrical service grounding electrode conductor. Size the service entrance conduit as shown in the plans. Ensure conduit for branch circuit entry to enclosure is the same size as that shown on the layout sheets for branch circuit conduit. Extend all rigid metal conduits a minimum of 6 inches underground and then couple to the type and schedule of the conduit shown on the layout for that particular branch circuit. Install a grounding bushing on the RMC where it terminates in the service enclosure.
- Use of liquidtight flexible metal conduit (LFMC) is allowed between the meter and service enclosure when they are mounted 90 to 180 degrees to each other. Size the LFMC the same size as service entrance conduit. LFMC must not exceed 3 feet in length. Strap LFMC within 1 foot of each end. LFMC less than 12 inches in length need not be strapped. Each end of LFMC must have a grounding bushing or be terminated with a grounding fitting. The LFMC must contain a grounded (neutral) conductor. Ensure any bend in LFMC never exceeds 180 degrees. A pull test is required on all installed conductors, with at least six inches of free conductor movement demonstrated to the satisfaction of the Engineer.
- Ensure all mounting hardware and installation details of services conform to utility company specifications.
- For all electrical service enclosures listed under Item 628 on the MPL, the UL 508 enclosure manufacturers will prepare and submit a schematic drawing unique to each service. Before shipment to the job site, place the applicable laminated schematic drawings and the laminated plan sheet showing the electrical service data chart used to build the enclosure in the enclosure's data pocket. The installing contractor will copy and laminate the actual project plan sheets detailing all equipment and branch circuits supplied by that service. The laminated plan sheets are to be placed in the service enclosure's document pocket. Reduce 11 in. x 17 in. plan sheets to 8 1/2 in. x 11 in. before laminating. If the installation differs from the plan sheets, the installing contractor is to redline plan sheets before laminating.
- When providing an "Off The Shelf" Type D or Type T service, provide laminated plan sheets detailing equipment and branch circuits supplied by that service. Reduce 11 in. x 17 in. plan sheets to 8 1/2 in. x 11 in. before laminating. Deliver these drawings before completion of the work to the Engineer, instead of placing in enclosure that has no door pocket.
- Do not install conduit in the back wall of a service enclosure where it would penetrate the equipment mounting panel inside the enclosure. Provide grounding bushings on all metal conduits, and terminate bonding jumpers to grounding bus. Grounding bushings are not required when the end of the metal conduit is fitted with a conduit sealing hub or threaded boss, such as a meter base hub.

SERVICE ASSEMBLY ENCLOSURE

- Provide threaded hub for all conduit entries into the top of enclosure.
- Type galvanized steel (GS) enclosures may be used for Type C panelboards and for Type D and T services that do not use an enclosure mounted photocell or lighting contactor. Provide GS enclosures in accordance with DMS 11080, 11082, 11083, and 11084.
- Provide aluminum (AL) and stainless steel (SS) enclosures for Types A, C, and D in accordance with DMS 11080, 11081, 11082, 11083, and 11084. Do not paint stainless steel.
- Provide pedestal service (PS) enclosures in accordance with ED(9) and DMS 11080 and 11085. Do not provide GS pedestal services. If GS is shown in the PS descriptive code, provide an AL enclosure.

MAIN DISCONNECT & BRANCH CIRCUIT BREAKERS

- Field drill flange-mounted remote operator handle if needed, to ensure handle is lockable in both the "On" and "Off" positions.
- When the utility company provides a transformer larger than 50 KVA, verify that the available fault current is less than the circuit breaker's ampere interrupting capacity (AIC) rating and provide documentation from the electric utility provider to the Engineer.

PHOTOELECTRIC CONTROL



- Provide photocell as listed on the MPL. Move, adjust, or shield the photocell from stray or ambient night time light to ensure proper operation. Mount photocell facing north when practical. Mount top of pole photocells as shown on Top Mounted Photocell Detail.

* ELECTRICAL SERVICE DATA												
Elec. Service ID	Plan Sheet Number	Electrical Service Description	Service Conduit * Size	Service Conductors No./Size	Safety Switch Amps	Main Ckt. Bkr. Pole/Amps	Two-Pole Contractor Amps	Panelbd/ Loadcenter Amp Rating	Branch Circuit ID	Branch Ckt. Bkr. Pole/Amps	Branch Circuit Amps	KVA Load
SB 183	289	ELC SRV TY A 240/480 100(SS)AL(E)SF(U)	2"	3/2	100	2P/100	100	N/A	Lighting NB	2P/40	26	28.1
									Lighting SB	2P/40	25	
									Underpass	1P/20	15	
NB Access	30	ELC SRV TY D 120/240 060(NS)SS(E)TS(O)	1 1/4"	3/6	N/A	2P/60		100	Sig. Controller	1P/30	23	5.3
								30	Luminaires	2P/20	9	
									CCTV	1P/20	3	
2nd & Main	58	ELC SRV TY T 120/240 000(NS)GS(N)SP(O)	1 1/4"	3/6	N/A	N/A	N/A	70	Flashing Beacon 1	1P/20	4	1.0
									Flashing Beacon 2	1P/20	4	

- * Example only, not for construction. All new electrical services must have electrical service data chart specific to that service as shown in the plans.
- ** Verify service conduit size with utility. Size may change due to utility meter requirements. Ensure conduit size meets the National Electrical Code.

EXPLANATION OF ELECTRICAL SERVICE DESCRIPTIVE CODE

ELEC SERV TY X XXX/XXX XXX (XX) XX (X) XX (X)

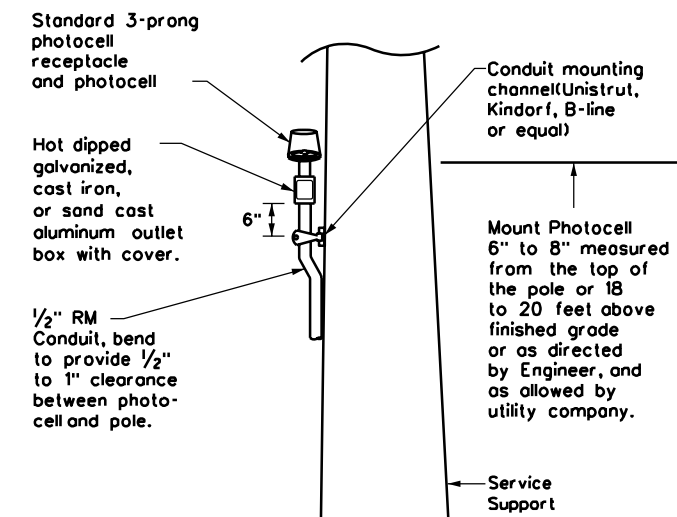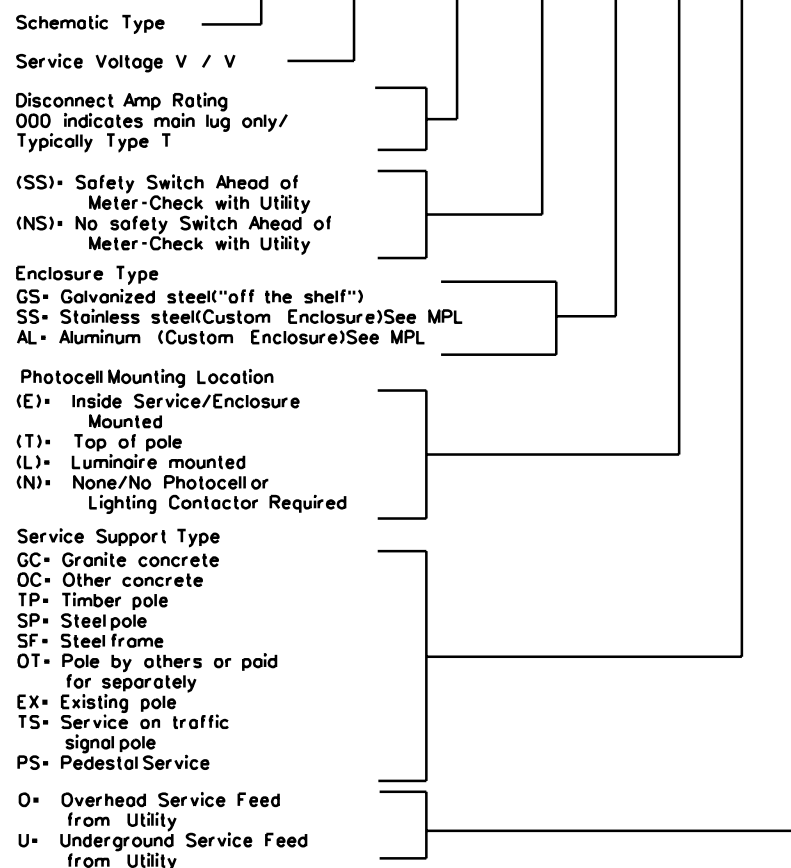

TOP MOUNTED PHOTOCELL

Install conduit strap maximum 3 feet from box. 5 foot maximum spacing between straps supporting conduit.

Texas Department of Transportation Traffic Operations Division Standard

ELECTRICAL DETAILS SERVICE NOTES & DATA


ED(5)-14

FILE: ed5-14.dgn	DN: TxDOT	CK: TxDOT	DW: TxDOT	CK: TxDOT
© TxDOT October 2014	CONT	SECT	JOB	HIGHWAY
REVISIONS	---	---	---	---
	DIST	COUNTY	SHEET NO.	
	---	---	35	


DISCLAIMER: The use of this standard is governed by the "Texas Engineering Practice Act". No warranty of any kind is made by TxDOT for any purpose whatsoever. TxDOT assumes no responsibility for the conversion of this standard to other formats or for incorrect results or damages resulting from its use.

DATE: FILE:


DISCLAIMER: The use of this standard is governed by the "Texas Engineering Practice Act". No warranty of any kind is made by TxDOT for any purpose whatsoever. TxDOT assumes no responsibility for the conversion of this standard to other formats or for incorrect results or damages resulting from its use.

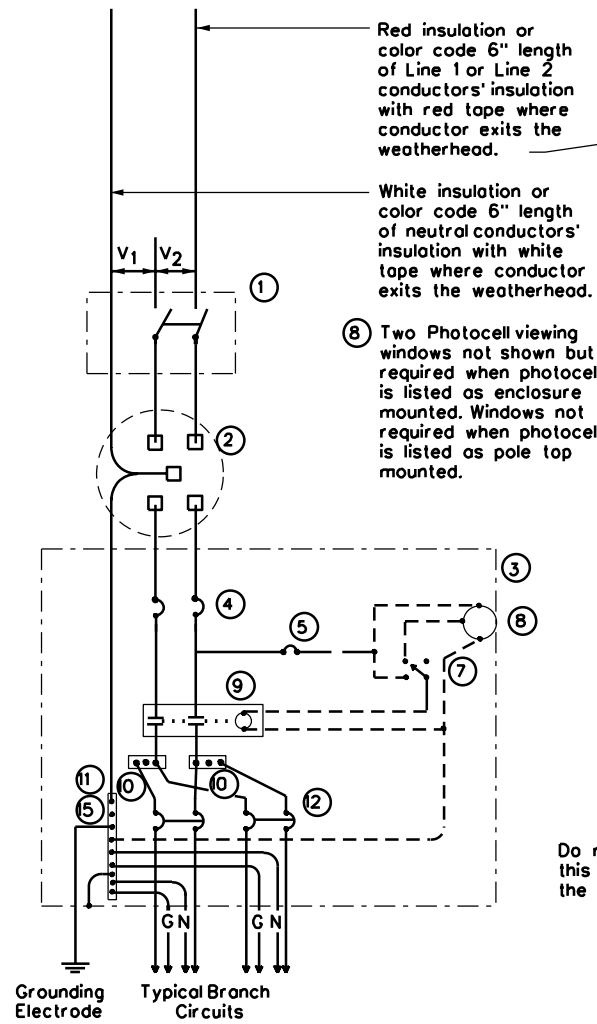


**SCHEMATIC TYPE A
THREE WIRE**

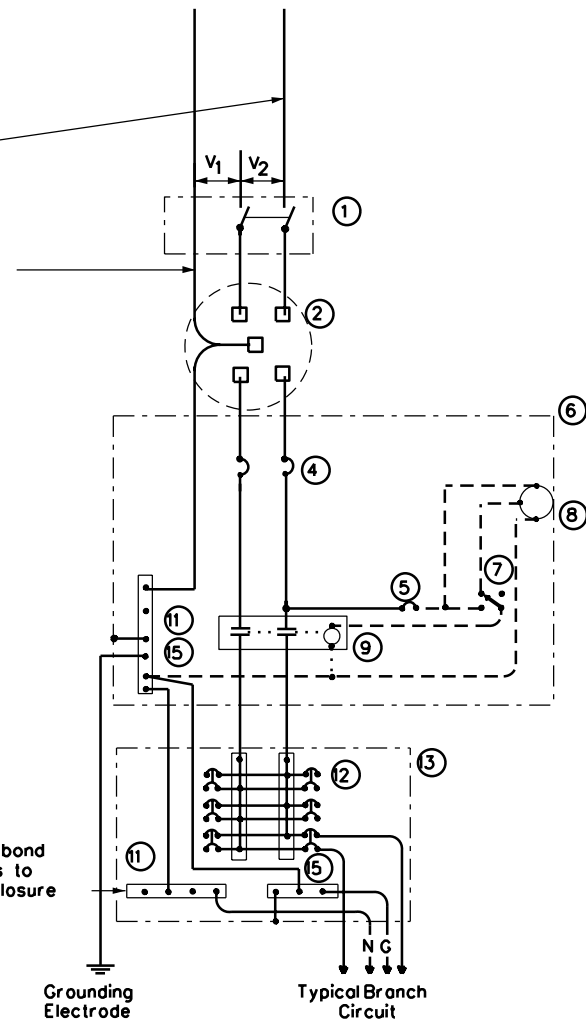

**SCHEMATIC TYPE C
THREE WIRE**

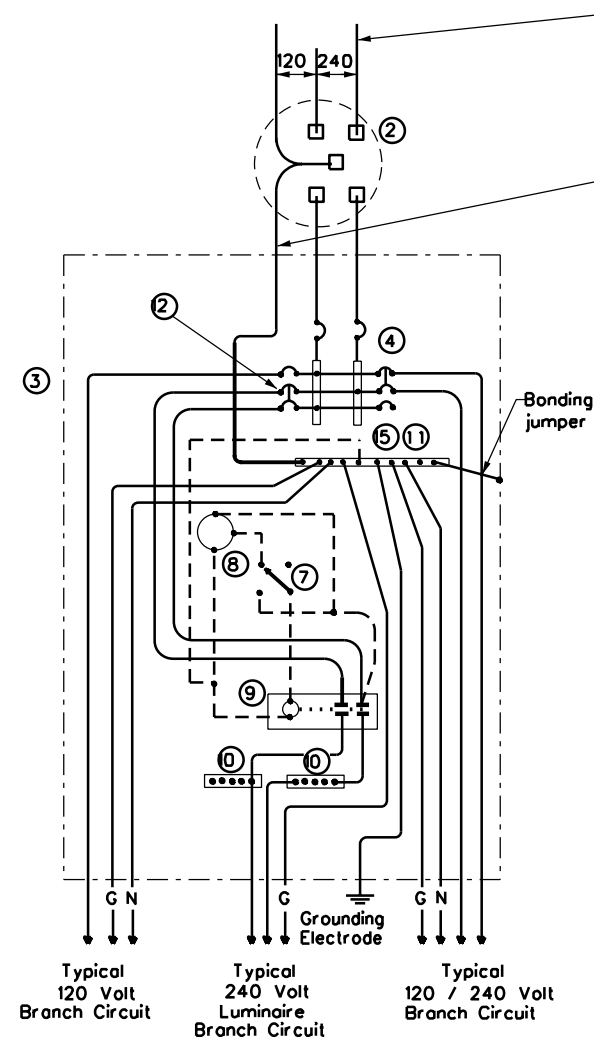

**SCHEMATIC TYPE D - CUSTOM
120/240 VOLTS - THREE WIRE**

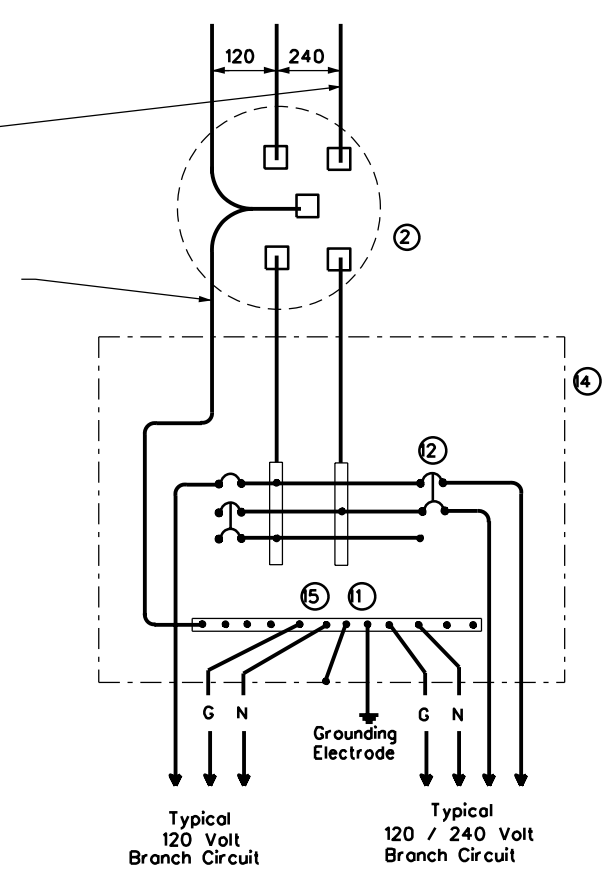

**SCHEMATIC TYPE T
120/240 VOLTS - THREE WIRE**
Galvanized steel-"Buy Off The Shelf"
only. When required install photocell
top of the pole or on luminaire only,
no lighting contractor will be installed.

WIRING LEGEND	
————	Power Wiring
-----	Control Wiring
—N—	Neutral Conductor
—G—	Equipment grounding conductor-always required

SCHEMATIC LEGEND	
1	Safety Switch (when required)
2	Meter (when required-verify with electric utility provider)
3	Service Assembly Enclosure
4	Main Disconnect Breaker (See Electrical Service Data)
5	Circuit Breaker, 15 Amp (Control Circuit)
6	Auxiliary Enclosure
7	Control Station ("H-O-A" Switch)
8	Photo Electric Control (enclosure-mounted shown)
9	Lighting Contactor
10	Power Distribution Terminal Blocks
11	Neutral Bus
12	Branch Circuit Breaker (See Electrical Service Data)
13	Separate Circuit Breaker Panelboard
14	Load Center
15	Ground Bus

		Traffic Operations Division Standard	
ELECTRICAL DETAILS SERVICE ENCLOSURE AND NOTES			
ED(6)-14			
FILE: ed6-14.dgn	DN: TxDOT	CK: TxDOT	DW: TxDOT
© TxDOT October 2014	CONT	SECT	JOB
REVISIONS	---	---	---
	DIST	COUNTY	SHEET NO.
	---	---	36


SUPPORT TYPE STEEL POLE (SP) AND STEEL FRAME (SF)

1. Provide steelpole and steel frame supports as per TxDOT Departmental Material Specification (DMS)11080 "Electrical Services." Mount all equipment and conduit on 12 gauge galvanized steel or stainless steel channel strut, 1 1/2 in. or 1 3/8 in. wide by 1 in. up to 3 3/4 in. deep Unistrut, Kindorf, B-line or equal. Bolt or weld all channel and hardware to vertical members as approved. Do not stack channel. File smooth and point field cut ends of all channel with zinc-rich paint before installing.
2. Provide poles for overhead service with an eyebolt or similar fitting for attachment of the service drop to the pole in conformance with the electric utility provider's specifications.
3. Provide and install galvanized 3/4 in. x 18 in. x 4 in. (dia. x length x hook length) anchor bolts for underground service supports. Provide and install galvanized 3/4 in. x 56 in. x 4 in. anchor bolts for overhead service supports. Ensure anchor bolts have 3 in. of thread, with 3 1/4 in. to 3 1/2 in. of the exposed anchor bolt projecting above finished foundation. Provide and install leveling nuts for all anchor bolts.
4. Bond one of the anchor bolts to the rebar cage with 6 AWG bare stranded copper conductor. Use listed mechanical connectors rated for embedment in concrete. See Inset B.
5. Furnish and install rigid metallic ells in all steel pole and steel frame foundations for all conduits entering the service from underground.
6. Use class C concrete for foundations. Ensure reinforcing steel is Grade 60 with 3" of unobstructed concrete cover.
7. Drill and top steel poles and frames for 1/2 in. X 13 UNC tank ground fitting. For steel pole service supports, provide and install tank ground fitting 4 in. to 6 in. below electrical service enclosure. Provide properly sized hole through the bottom of the enclosure for the service grounding electrode conductor. Ensure electrical service grounding electrode conductor is as short and straight as possible from the enclosure to the tank ground fitting. For steel frame service supports, provide and install tank ground fitting on steel frame post. Install service grounding electrode conductor in a non-metallic conduit or tubing from the enclosure to the steel frame post. Connect electrical service grounding electrode conductor to the tank ground fitting. See steel frame and steelpole details and Inset A for more information. Size service entrance conduit and branch circuit conduit as shown in the plans. For underground conduit runs from the electrical service, extend RMC from the service enclosure to an RMC elbow, and then connect the schedule type and size of conduit shown in the plans. Provide and install grounding bushings where RMC terminates in the enclosure. Grounding bushings are not required when RMC is fitted into a sealing hub or threaded boss.
8. If Steelpole or frame is painted, bond each separate painted piece with a bonding jumper attached to a tapped hole.
9. Provide 1/4" - 20 machine screws for bonding. Do not use sheet metal screws. Remove all non-conductive material at contact points. Terminate bonding jumpers with listed devices. Install minimum size 6 AWG stranded copper bonding jumpers. Make up all threaded bonding connections wrench tight.
10. Avoid contact of the service drop and service entrance conductors with the metal pole to prevent abrasion of the insulated conductors.
11. Shop drawings are not required for service support structure unless specifically stated elsewhere or directed by the Engineer.

DISCLAIMER: The use of this standard is governed by the "Texas Engineering Practice Act". No warranty of any kind is made by TxDOT for any purpose whatsoever. TxDOT assumes no responsibility for the conversion of this standard to other formats or for incorrect results or damages resulting from its use.



White insulation or color code 6" of neutral conductor's insulation with white tape where conductor exits weatherhead.

Red insulation or color code 6" length of Line 1 or Line 2 conductor's insulation with red tape where conductor exits the weatherhead. Conductor slack length, 12" min., 18" max.

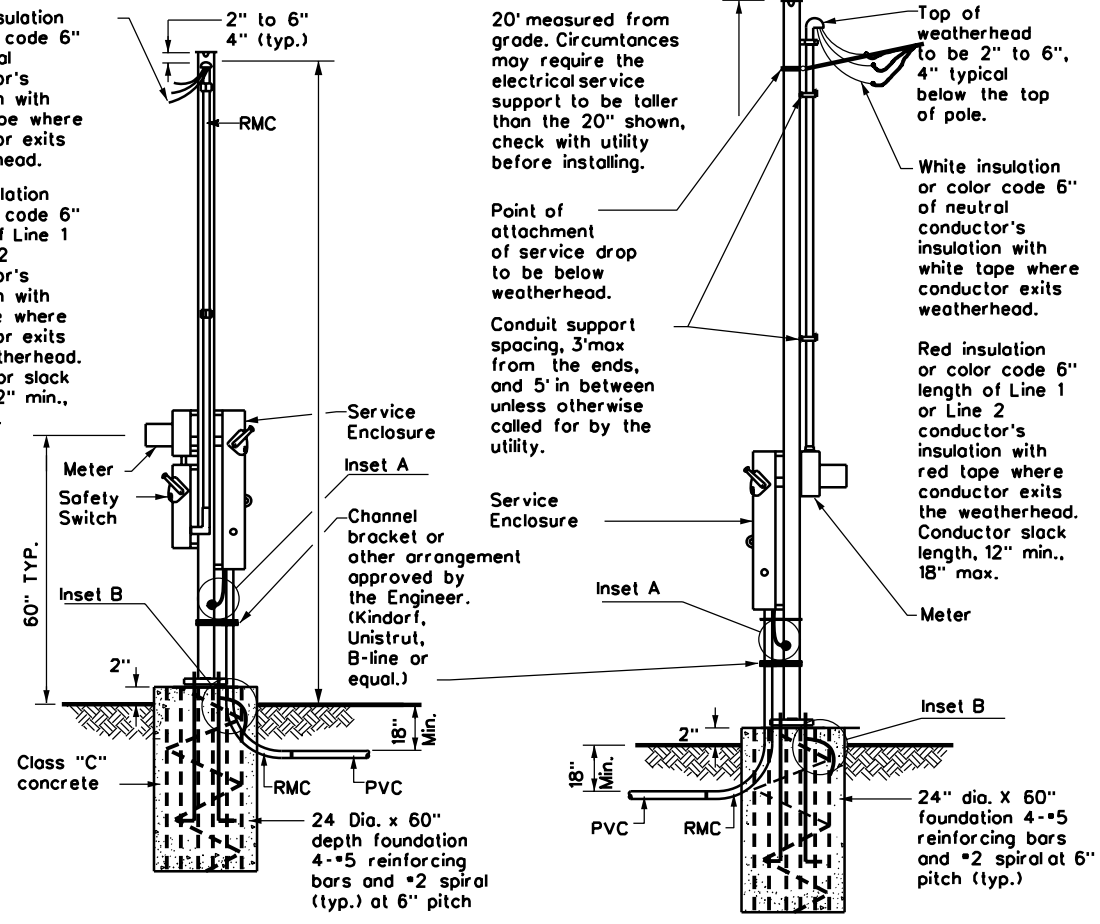


WITH SAFETY SWITCH WITHOUT SAFETY SWITCH
SERVICE SUPPORT TYPE SP (O) - OVERHEAD SERVICE


Drill, top, and thread 1/2" X 13 UNC. Install tank ground fitting, connect electrical service grounding electrode conductor. See Note 7.

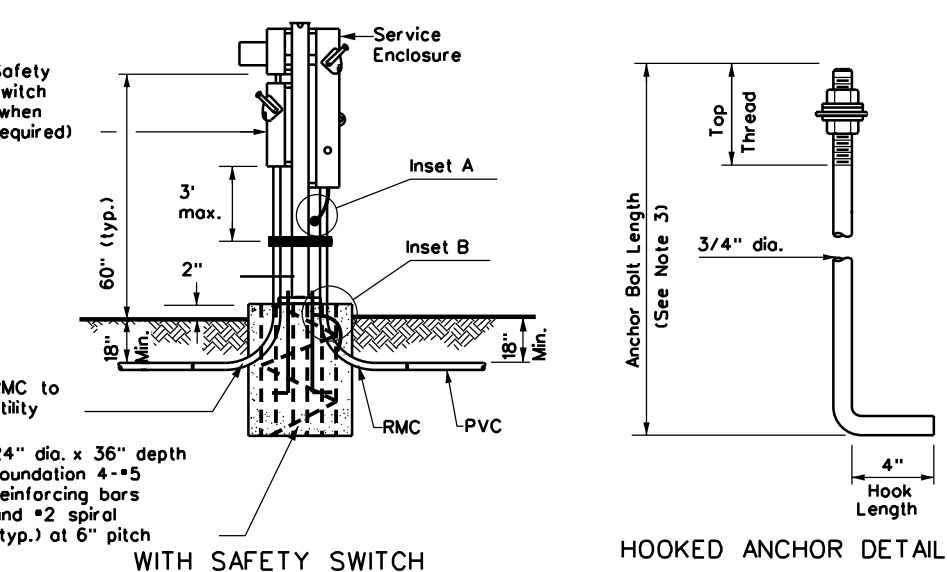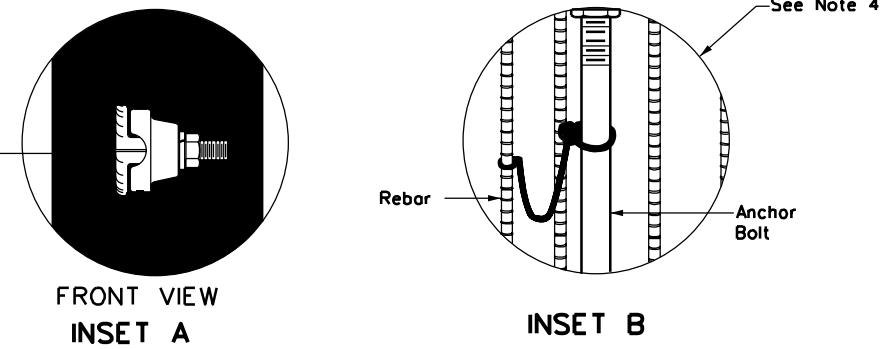


WITH SAFETY SWITCH HOOKED ANCHOR DETAIL
SERVICE SUPPORT TYPE SP(U) - UNDERGROUND SERVICE

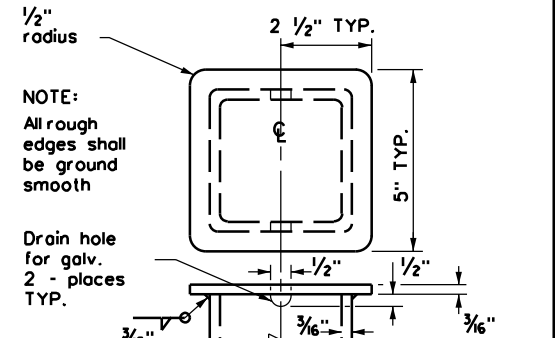


POLE TOP PLATE

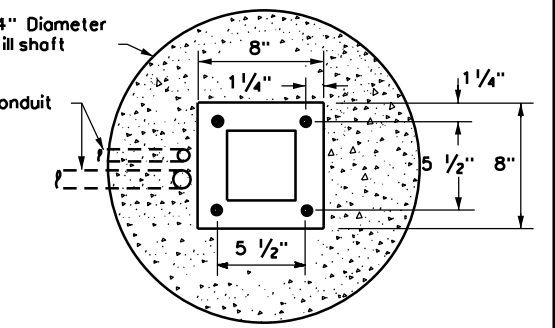


BASE PLATE DETAIL

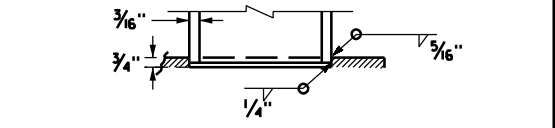

BOTTOM OF POLE

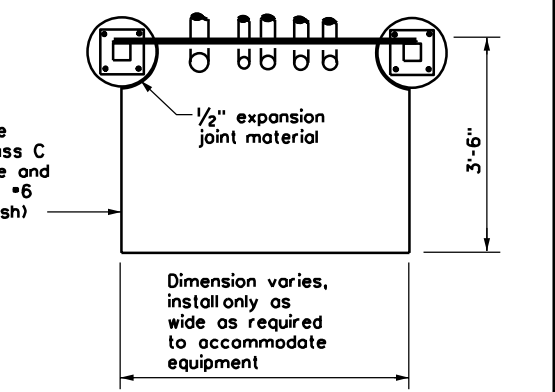

TOP VIEW
SERVICE SUPPORT TYPE SF (O) & SF (U)

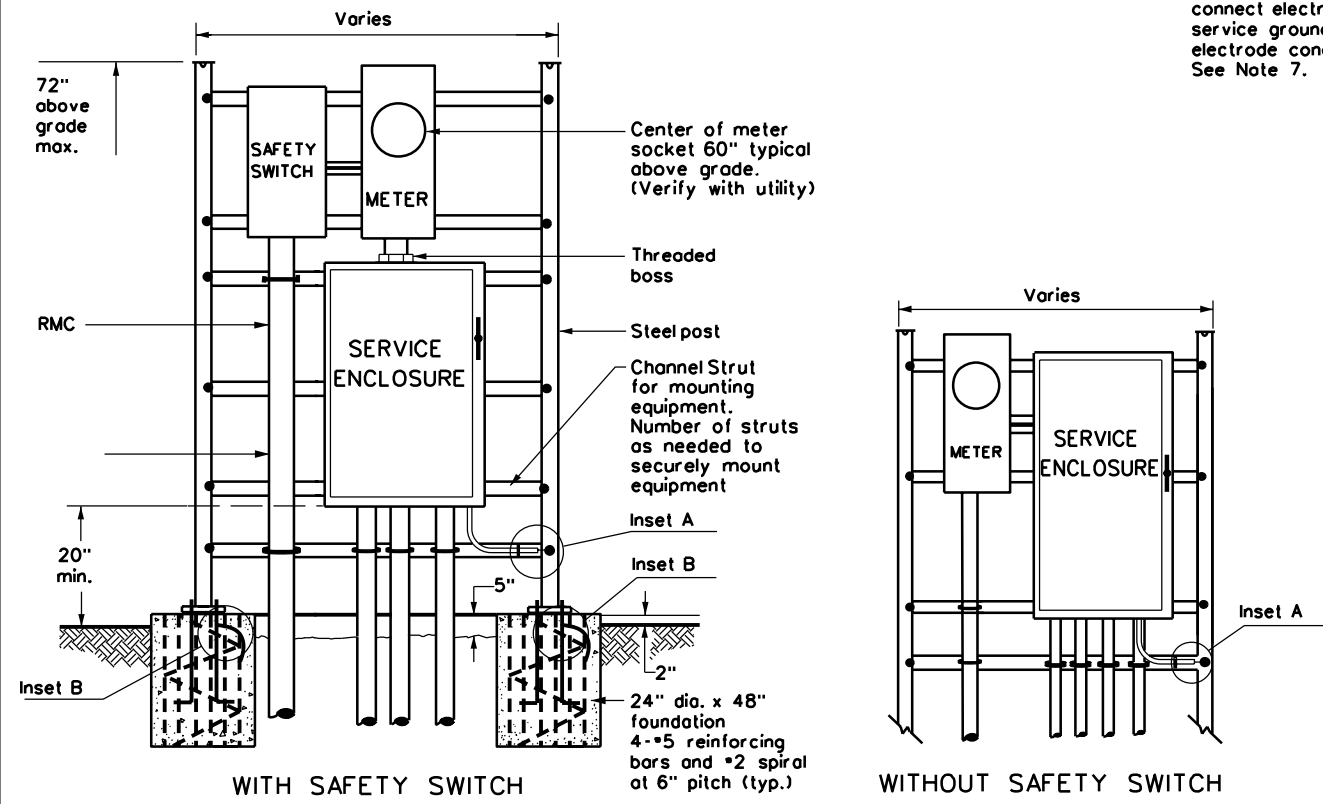

WITH SAFETY SWITCH WITHOUT SAFETY SWITCH
FRONT VIEW
SERVICE SUPPORT TYPE SF(U) - UNDERGROUND SERVICE


Texas Department of Transportation
Traffic Operations Division Standard

**ELECTRICAL DETAILS
SERVICE SUPPORT
TYPES SF & SP
ED(7)-14**

FILE: ed7-14.dgn	DN: TxDOT	CK: TxDOT	DW: TxDOT	CK: TxDOT
©TxDOT October 2014	CONT	SECT	JOB	HIGHWAY
REVISIONS	---	---	---	---
	DIST	COUNTY	SHEET NO.	
	---	---	37	

TRAFFIC SIGNAL NOTES


1. Do not pass luminaire conductors through the signal controller cabinet.
2. Include an equipment grounding conductor in all conduits throughout the electrical system. Bond all exposed metal parts to the grounding conductor.
3. Provide roadway luminaires, when required, in accordance with the material and construction sections of Item 610, "Roadway Illumination Assemblies," except for performance testing of luminaires. Test installed roadway luminaires for proper operation as a part of the associated traffic signal system test.
4. If internally illuminated street name signs are approved for use, ground the fixture to the pole with a 12 AWG green XHHW conductor.
5. Bond anchor bolts to rebar cage in two locations using #3 bars or 6 AWG stranded copper conductors. Use listed mechanical connectors rated for embedment in concrete. See TXDOT standard TS-FD for further details.
6. Drill and tap signal poles for 1/2 in. X 13 UNC tank ground fitting. Provide and install tank ground fitting 4 in. to 6 in. directly below electrical service enclosure. Provide properly sized hole through the bottom of the enclosure for the service grounding electrode conductor. Connect the electrical service grounding electrode conductor to the tank ground fitting. Ensure electrical service grounding electrode conductor is as short and straight as possible from the enclosure to the tank ground fitting. See Inset A detail for further information. Size service entrance conduit and branch circuit conduit as shown in the plans.
7. Mount electrical service enclosure and meter to signal pole with stainless steel bands. Ensure bands are a minimum width of 3/4 in. Secure enclosures to bands using two-bolt brackets. Install brackets near top and bottom of each enclosure. Install properly sized stainless steel washers on each bolt in the enclosure. Band or drill and tap properly sized stand-off straps to signal pole for attaching conduit.
8. Conduct pull tests and insulation resistance tests on all illumination and power conductors as required in Item 620 "Electrical Conductors" and ED(3). To prevent electronics damage, do not conduct insulation resistance tests on traffic signal cables after termination.
9. Lock all enclosures and bolt down all ground box covers before applying power to the signal installation.
10. Terminate conduits entering the top of enclosures with a conduit-sealing hub or threaded boss such as meter hub. Install a grounding bushing on all metal conduits not connected to conduit-sealing hub or threaded boss. Bond the grounding bushing to the ground bus with a bonding jumper. Seal all conduits entering enclosures with duct seal or expanding foam. Do not use silicone to seal conduit ends.
11. For all conduits, ensure the burial depth is a minimum of 18". Ensure the minimum burial depth for conduit placed under a roadway is 24".

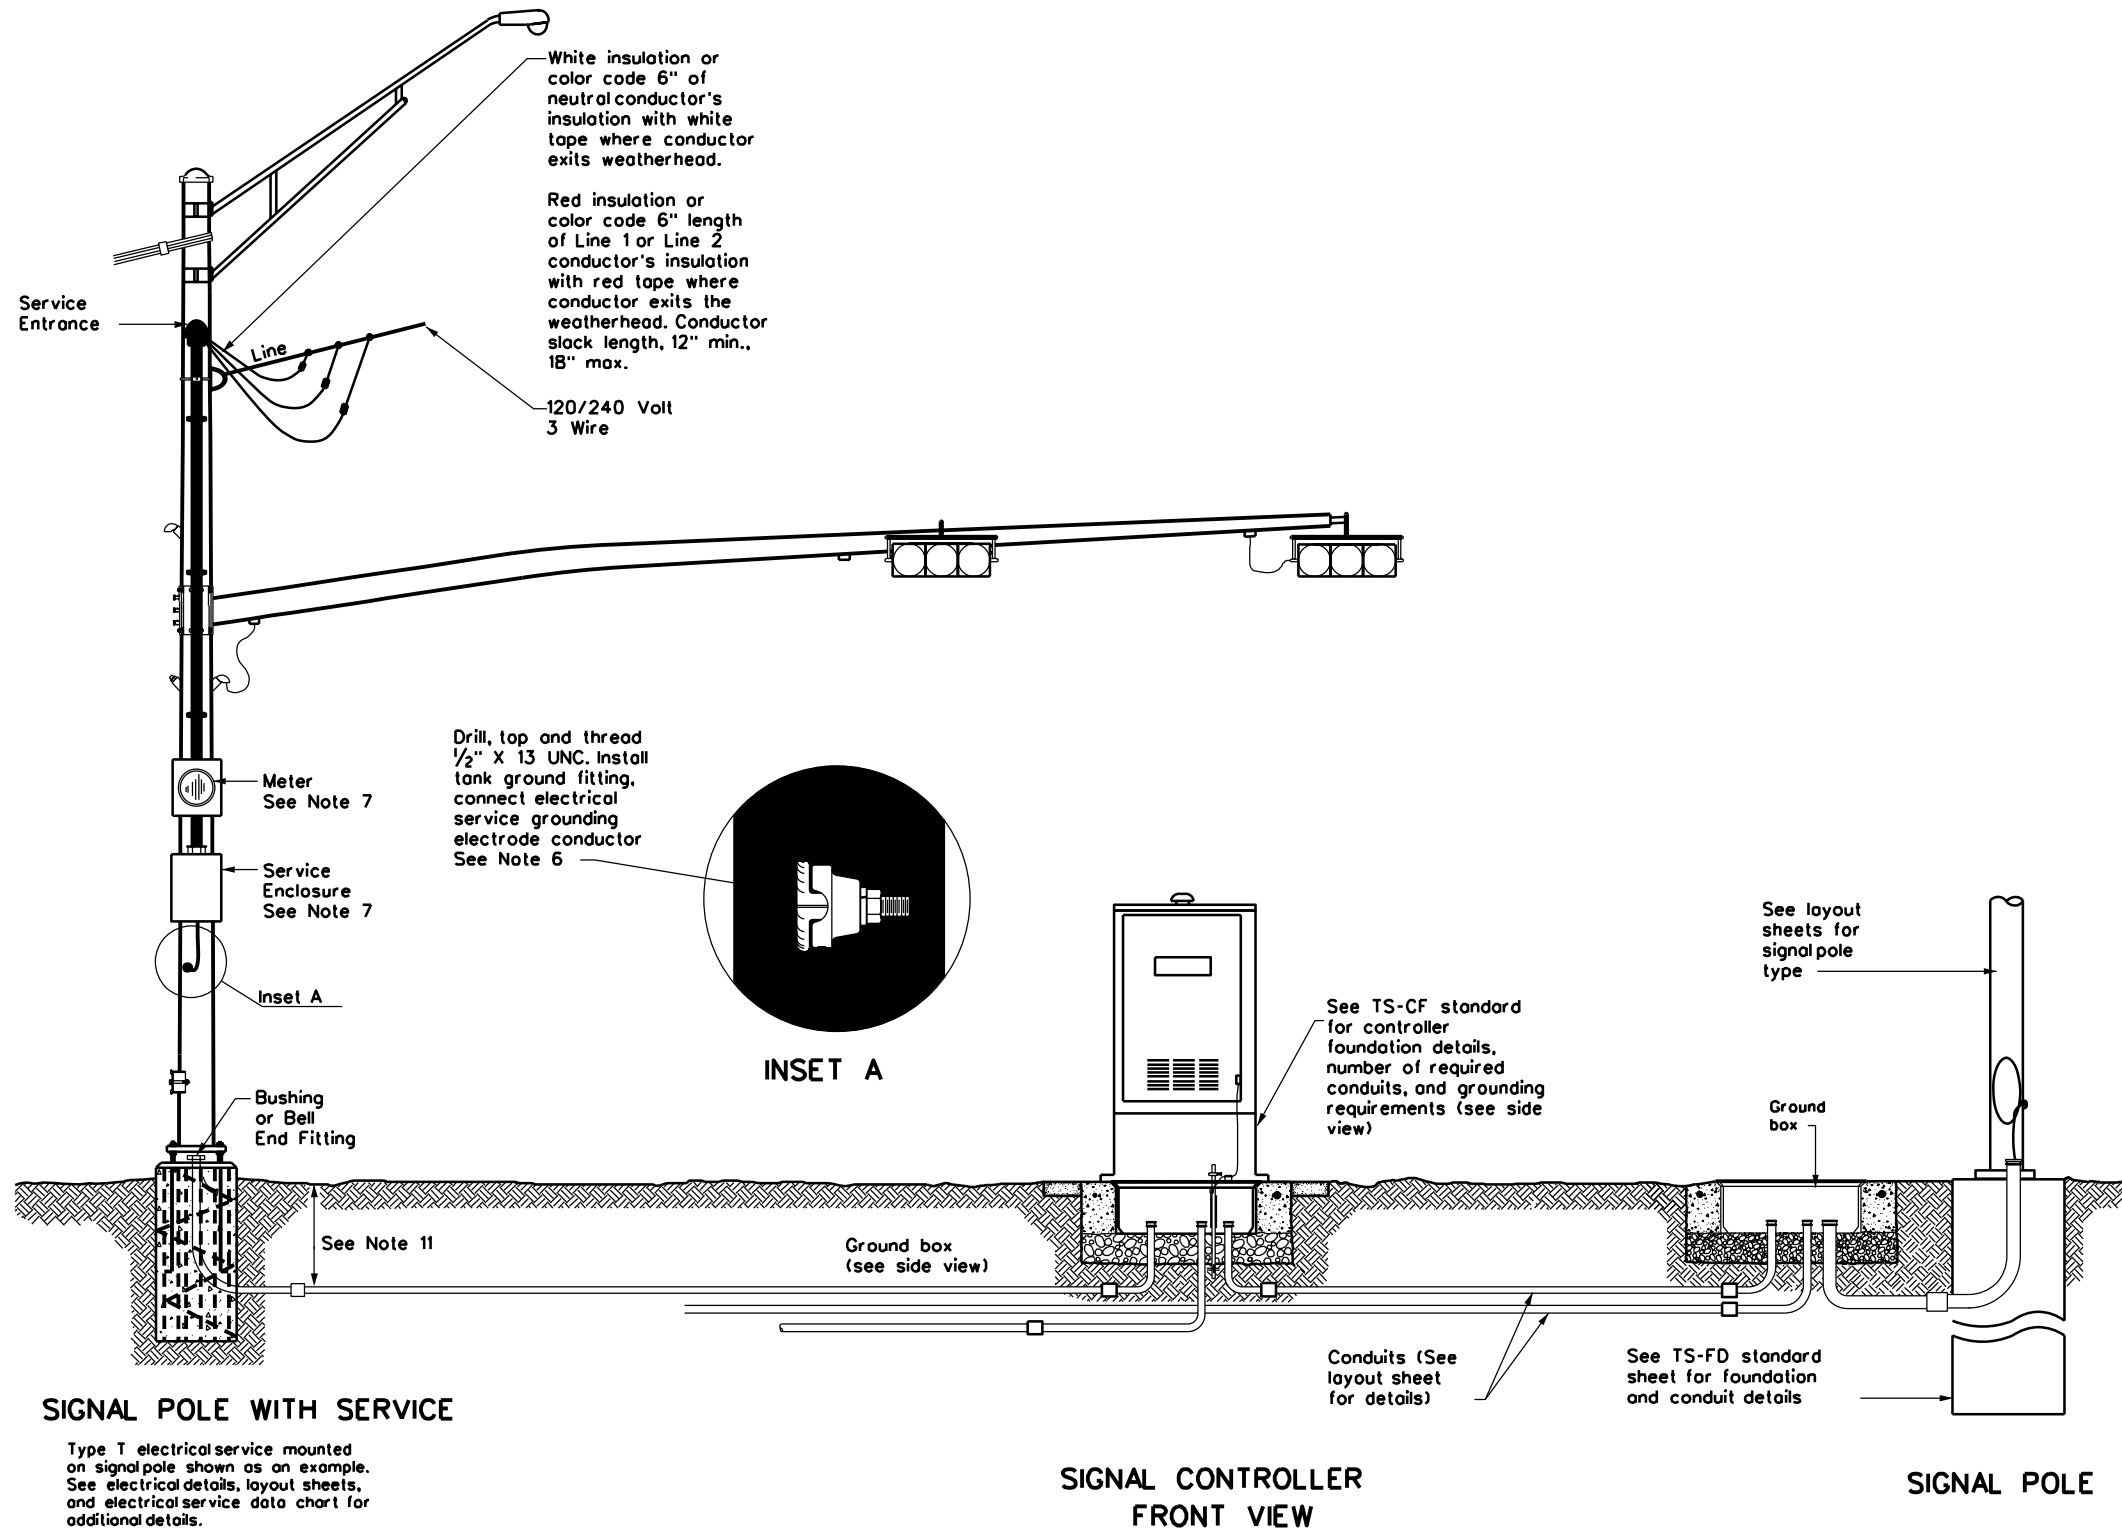

White insulation or color code 6" of neutral conductor's insulation with white tape where conductor exits weatherhead.

Red insulation or color code 6" length of Line 1 or Line 2 conductor's insulation with red tape where conductor exits the weatherhead. Conductor slack length, 12" min., 18" max.

Drill, tap and thread 1/2" X 13 UNC. Install tank ground fitting, connect electrical service grounding electrode conductor See Note 6

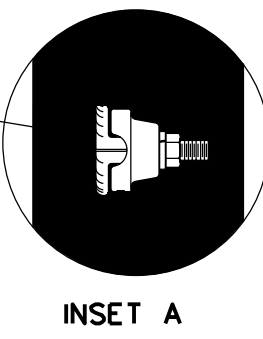


SIGNAL POLE WITH SERVICE

Type T electrical service mounted on signal pole shown as an example. See electrical details, layout sheets, and electrical service data chart for additional details.

SIGNAL CONTROLLER FRONT VIEW

SIGNAL POLE

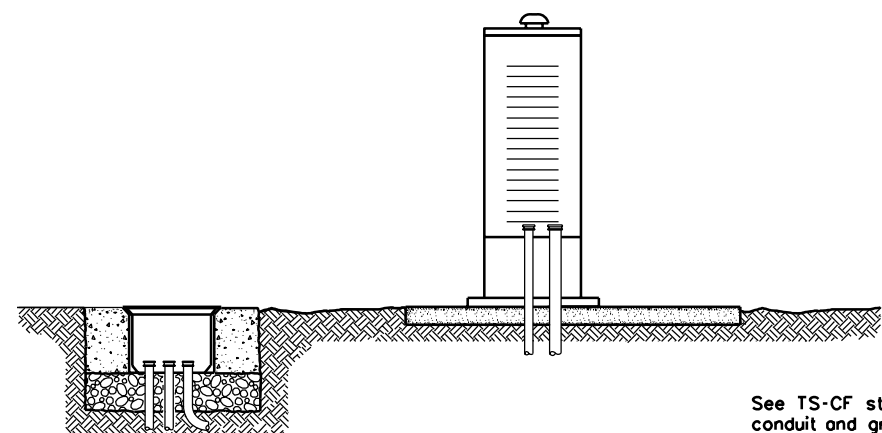

SIGNAL CONTROLLER SIDE VIEW

See TS-CF standard for conduit and grounding requirements. See layout sheets for ground box locations and any additional conduits that are required.

DISCLAIMER: The use of this standard is governed by the "Texas Engineering Practice Act". No warranty of any kind is made by TxDOT for any purpose whatsoever. TxDOT assumes no responsibility for the conversion of this standard to other formats or for incorrect results or damages resulting from its use.

DATE: FILE:




**ELECTRICAL DETAILS
TYPICAL TRAFFIC SIGNAL
SYSTEM DETAILS
ED(8)-14**

FILE: ed8-14.dgn	DN: TxDOT	CK: TxDOT	DW: TxDOT	CK: TxDOT
© TxDOT October 2014	CONT	SECT	JOB	HIGHWAY
REVISIONS	---	---	---	---
	DIST	COUNTY	SHEET NO.	
	---	---	38	


DISCLAIMER: The use of this standard is governed by the "Texas Engineering Practice Act". No warranty of any kind is made by TxDOT for any purpose whatsoever. TxDOT assumes no responsibility for the conversion of this standard to other formats or for incorrect results or damages resulting from its use.

PEDESTAL SERVICE NOTES

1. Manufacture pedestal electrical services in accordance with Departmental Material Specifications (DMS) 11080 "Electrical Services", 11085 "Electrical Services-Pedestal (PS)" and Item 628 "Electrical Services." Provide pedestal electrical services as listed on the Material Producers list (MPL) on the Department's web site under "Roadway Illumination and Electrical Supplies," Item 628. Ensure all mounting hardware and installation details of services meet utility company specifications. Contact the local utility company for approval of pedestal details prior to installing the electrical pedestal service. Submit any changes required by the utility company prior to manufacturing the pedestal enclosure.
2. When a meter socket is required, provide a socket with a minimum 100 amp rating that complies with local utility requirements.
3. Provide Class A or C concrete for pedestal service foundations in accordance with Item 420, "Concrete Substructures," except that concrete will not be paid for directly but is considered subsidiary to Item 628.
4. Provide #4 reinforcing steel for foundations in accordance with Item 440, "Reinforcement for Concrete."
5. Install 1/2 in. X 2 1/16 in. minimum length concrete single expansion type anchors for mounting pedestal enclosure to foundation. Anchor location to match mounting holes in each corner of enclosure. Secure each of the four corners of the pedestal enclosure to the anchors in the foundation with a 1/2 in. galvanized or stainless steel machine thread bolt, a properly sized locknut and a flat washer.
6. Finish top of concrete foundation in a neat and workmanlike manner. If leveling washers are used, ensure no more than 1/8 in. gap at any corner. Do not exceed a maximum dip or rise in the foundation of 1/8 in. per foot. When properly installed, ensure the top of the service enclosure is level front to back and side to side within 1/4 in. Repair rocking or movement of the service enclosure at no additional cost to the department.
7. Do not use liquidtight flexible metal conduit (LFMC) on pedestal type services.
8. Ensure all elbows in the foundation are sized as per utility provider's conduit requirements for underground conduit and feeders. PVC extensions may be installed provided the ends of the rigid metal conduits are more than 2 in. below the top of the concrete foundation. Where extension conduits are metal, grounding bushings must be installed with a bonding jumper properly terminated.

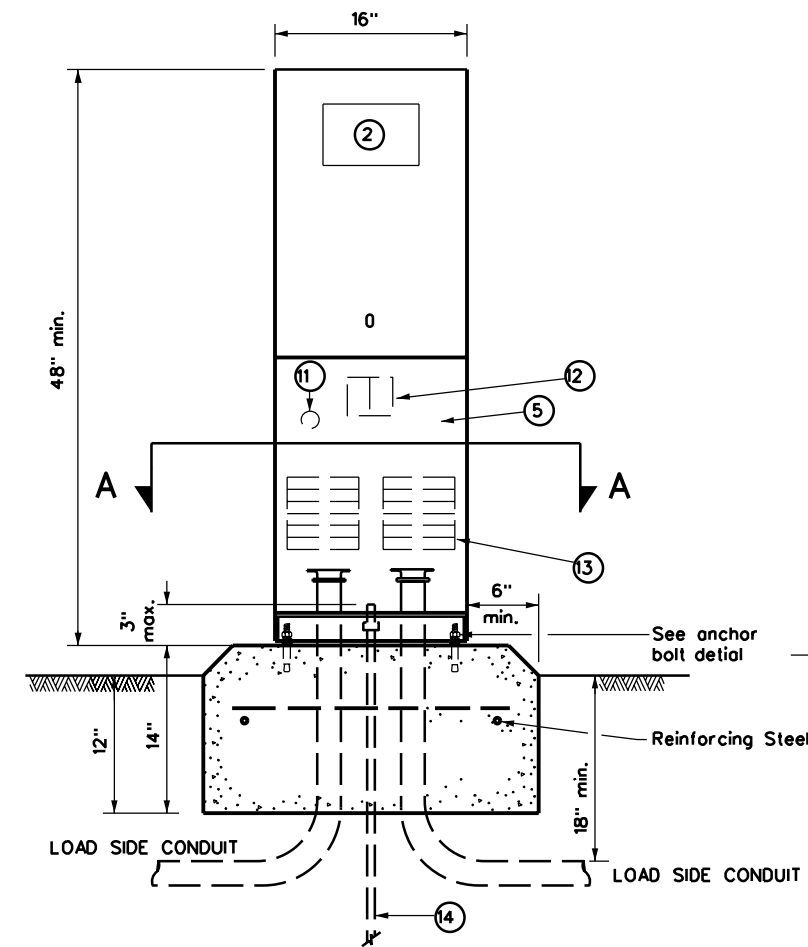


FRONT VIEW

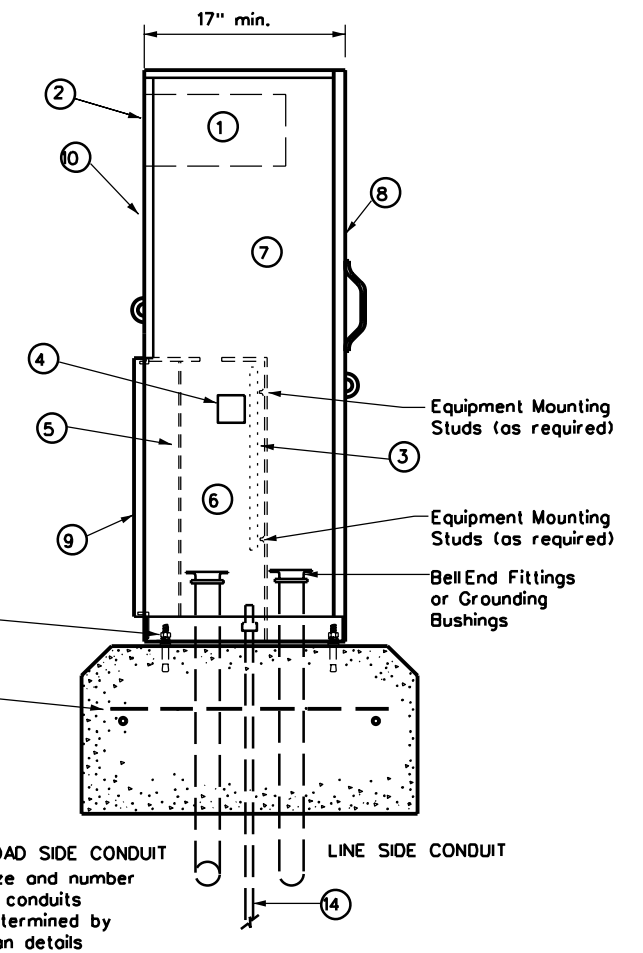

SIDE VIEW

TYPE C shown, TYPE A similar except that TYPE A shall have individual circuit breakers (CB) mounted on an equipment mounting panel. CB Handles shall protrude through hinged deadfront trim.

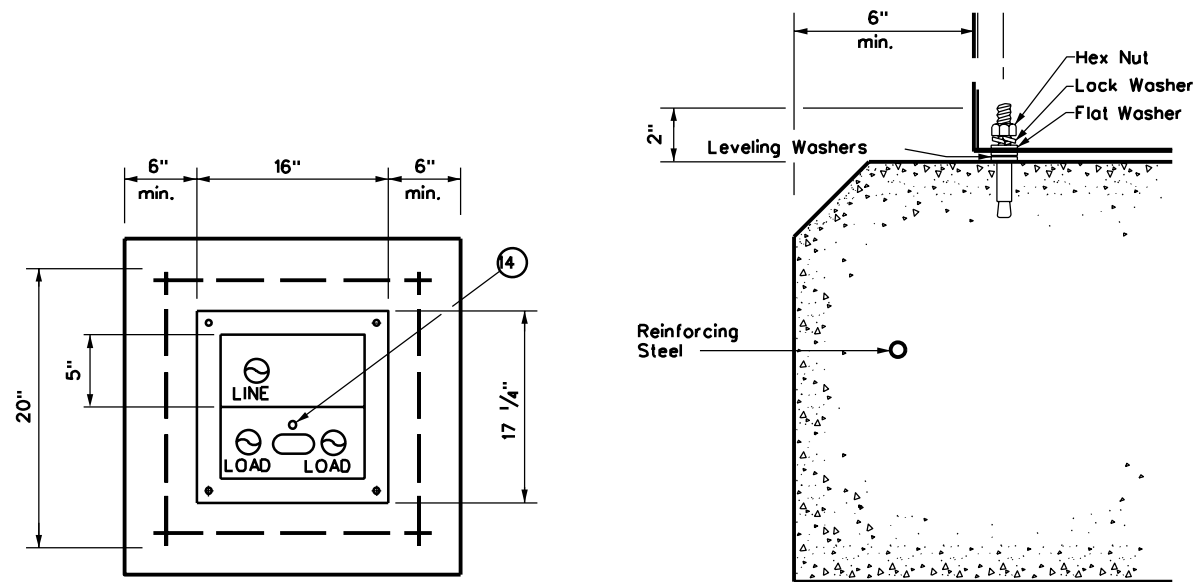

SECTION A-A

ANCHOR BOLT DETAIL

LEGEND


1	Meter Socket, (when required)
2	Meter Socket Window, (when required)
3	Equipment Mounting Panel
4	Photo Electric Control Window, (When required)
5	Hinged Deadfront Trim
6	Load Side Conduit Trim
7	Line Side Conduit Area
8	Utility Access Door, with handle
9	Pedestal Door
10	Hinged Meter Access
11	Control Station (H-O-A Switch)
12	Main Disconnect
13	Branch Circuit Breakers
14	Copper Clad Ground Rod - 5/8" X 10'

		Traffic Operations Division Standard	
ELECTRICAL DETAILS ELECTRICAL SERVICE SUPPORT PEDESTAL SERVICE TYPE PS			
ED(9)-14			
FILE: ed9-14.dgn	DN: TxDOT	CK: TxDOT	DW: TxDOT
© TxDOT October 2014	CONT	SECT	JOB
REVISIONS	---	---	---
	DIST	COUNTY	SHEET NO.
	---	---	39

DATE: FILE:


DISCLAIMER: The use of this standard is governed by the "Texas Engineering Practice Act". No warranty of any kind is made by TxDOT for any purpose whatsoever. TxDOT assumes no responsibility for the conversion of this standard to other formats or for incorrect results or damages resulting from its use.

DATE:
FILE:

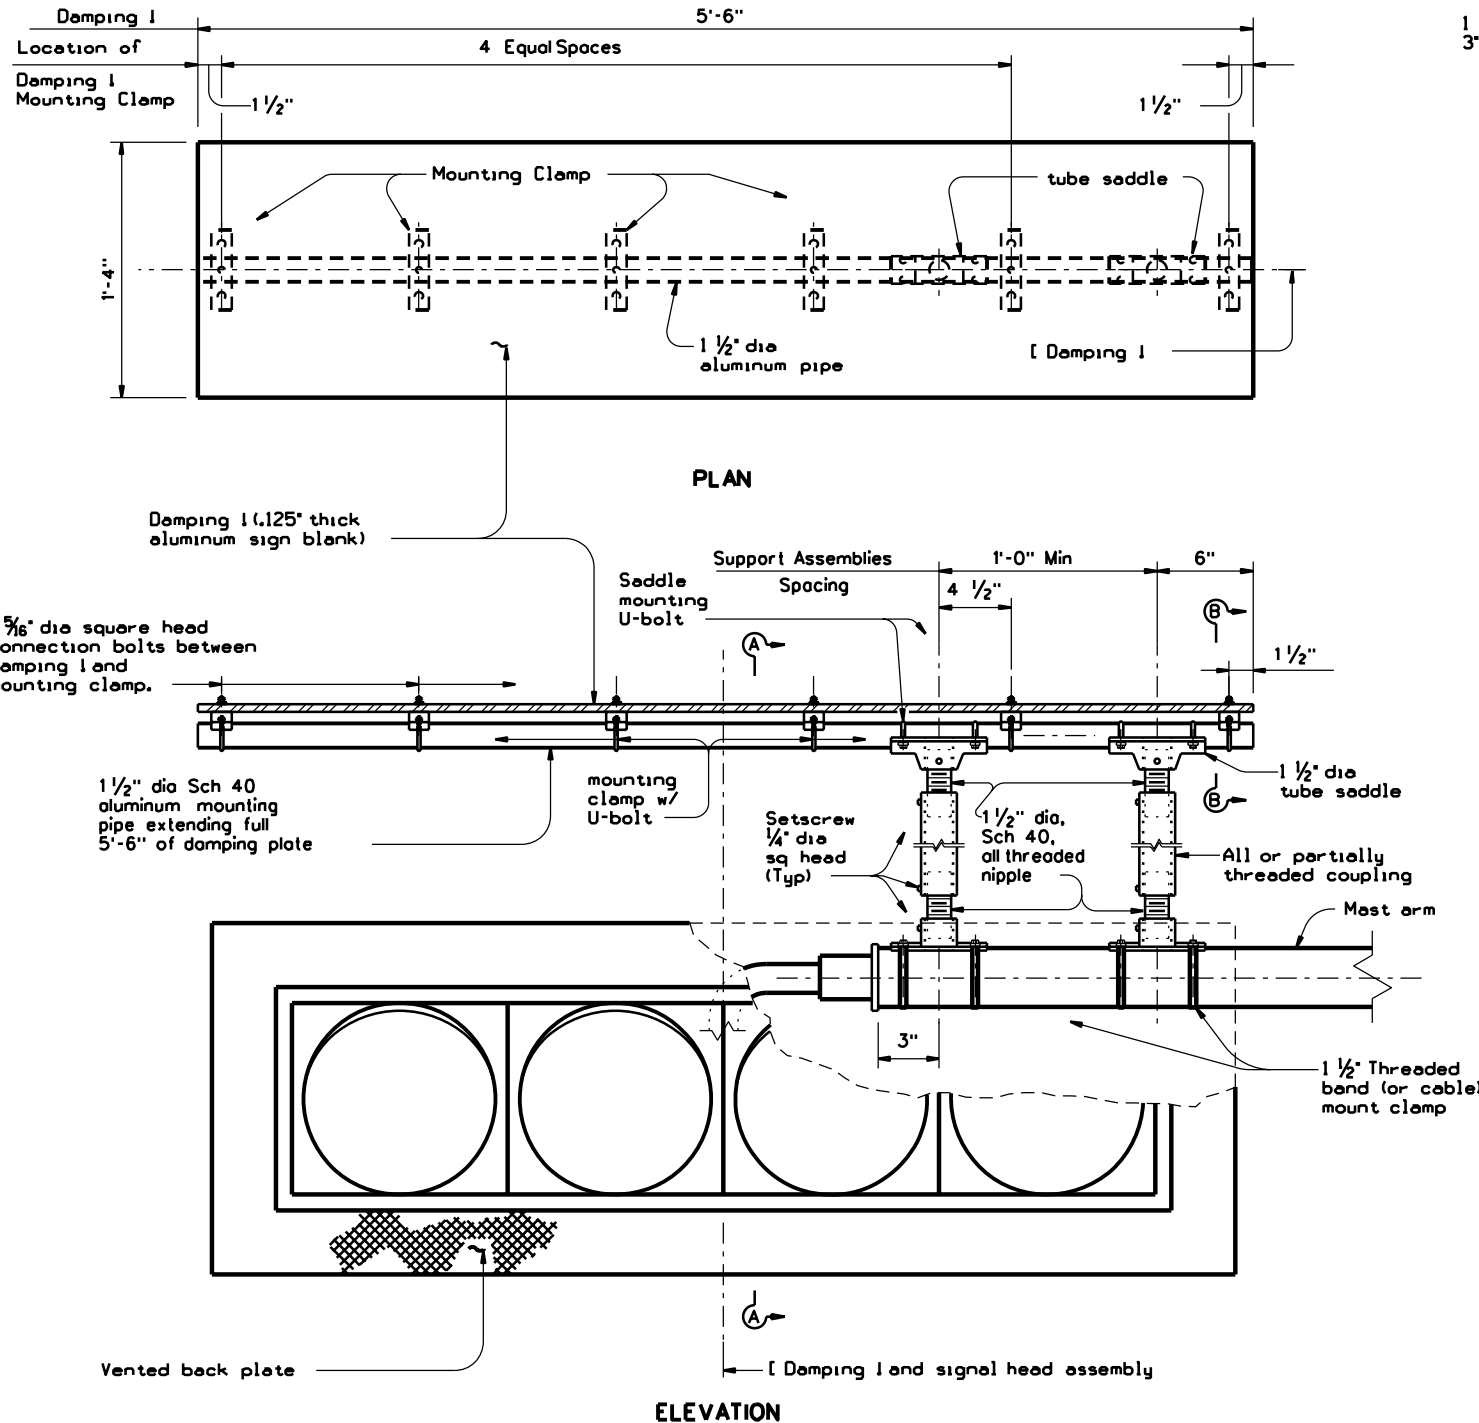


DAMPING PLATE MOUNTING DETAILS

(Showing alternate placement of signal head)

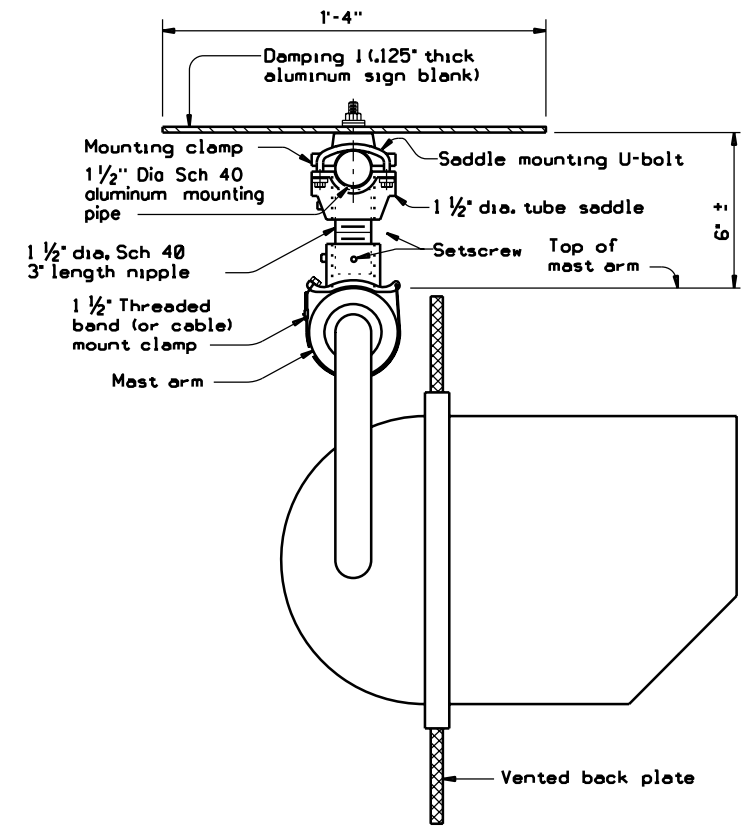

SECTION A-A

(Showing standard placement of signal head)
(Mounting clamp U-bolt is not shown for clarity)

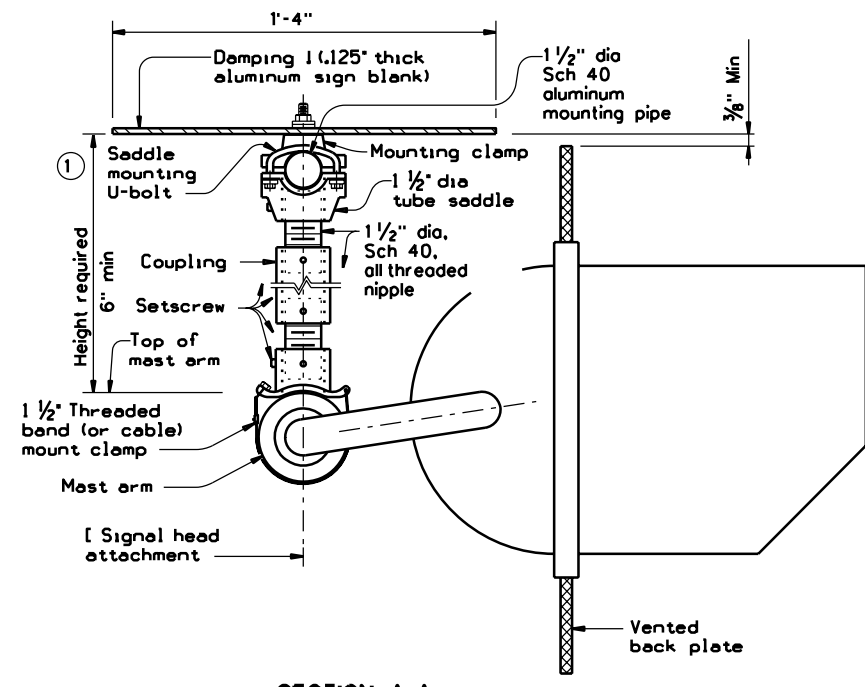

SECTION A-A

(Showing alternate placement of signal head)
(Mounting clamp U-bolt is not shown for clarity)

GENERAL NOTES:


In accordance with the findings of TxDOT sponsored research, the installation of a damping plate in accordance with the details shown here at the end of signal mast arms of SMA and DMA standard structures reduces excessive harmonic vertical vibration, and thus fatigue damage. Any deviation from these details may reduce the effectiveness of this damping device.

Aluminum sign blank for damping plate shall conform to Departmental Material Specifications DMS-7110. Materials for mast arm mounting clamp and tube saddle shall be aluminum castings or aluminum alloys as in accordance with manufacturers' stipulations. Mounting pipe, pipe nipple and coupling shall be aluminum alloy 6061-T6 or 6063-T6. Damping plate mounting clamp and U-bolt assemblies shall conform to Standard sheet SMD(GEN)-08. U-bolts for saddle mounting shall have a minimum yield strength of 36 ksi.

Damping plate shall be mounted horizontally. Position centerline of damping plate to align with centerline of signal head assembly. Vertical clearance between signal head (with or without backing plate) and bottom of damping plate shall be maintained as shown. The attachments shown here are examples only, other supporting details which meet both alignment and vertical clearance requirements are also acceptable.

Unless stipulated by the manufacturers, all steel parts shall be galvanized finish in accordance with Standard Specification Item 445, "Galvanizing".

Contractor shall verify applicable field dimensions before the installation.

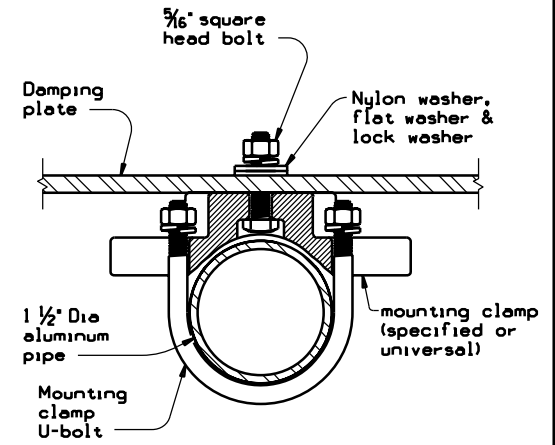

SECTION B-B

(Showing damping plate attachment)

① Recommended supporting assemblies to achieve required height

Height required	One nipple each length	Two nipples each length plus	One coupling each length
6'-6 3/4"	3'	-	-
7'-8 1/2"	4'	-	-
9'-10 1/2"	6'	-	-
11'-15 1/2"	-	4'	5'
16'-24"	-	6'	10'



MAST ARM DAMPING PLATE DETAILS

MA-DPD-12



© TxDOT January 2012

REVISIONS	DNF	CK	DW	CK
CONT	SECT	JOB	HIGHWAY	
---	---	---	---	
DIST	COUNTY	SHEET NO.		
---	---	40		

DISCLAIMER: The use of this standard is governed by the "Texas Engineering Practice Act". No warranty of any kind is made by TxDOT for any purpose whatsoever. TxDOT assumes no responsibility for the conversion of this standard to other formats or for incorrect results or damages resulting from its use.

REQUIREMENTS FOR INDEPENDENT MOUNTED ROUTE SIGNS




SHEETING REQUIREMENTS		
USAGE	COLOR	SIGN FACE MATERIAL
BACKGROUND	WHITE	TYPE A SHEETING
BACKGROUND	ALL OTHERS	TYPE B OR C SHEETING
LEGEND & BORDERS	WHITE	TYPE A SHEETING
LEGEND & BORDERS	BLACK	ACRYLIC NON-REFLECTIVE FILM
LEGEND & BORDERS	ALL OTHERS	TYPE B or C SHEETING

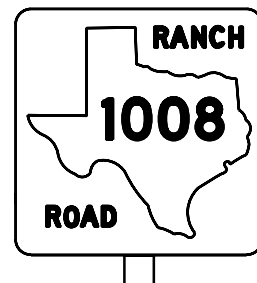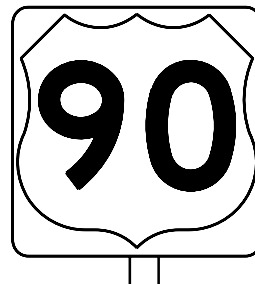

TYPICAL EXAMPLES

REQUIREMENTS FOR BLUE, BROWN & GREEN D AND I SERIES GUIDE SIGNS

SHEETING REQUIREMENTS		
USAGE	COLOR	SIGN FACE MATERIAL
BACKGROUND	ALL	TYPE B OR C SHEETING
LEGEND & BORDERS	WHITE	TYPE D SHEETING
LEGEND, SYMBOLS & BORDERS	ALL OTHERS	TYPE B OR C SHEETING

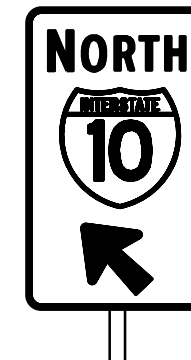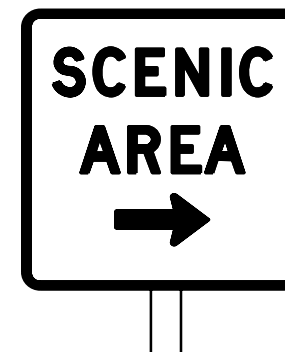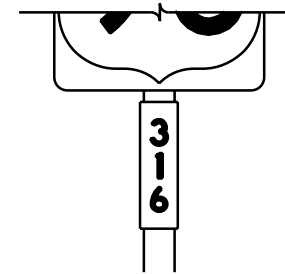

TYPICAL EXAMPLES

GENERAL NOTES

1. Signs to be furnished shall be as detailed elsewhere in the plans and/or as shown on sign tabulation sheet. Standard sign designs and arrow dimensions can be found in the "Standard Highway Sign Designs for Texas" (SHSD).
2. White legend shall use the Clearview Alphabet. The following Clearview fonts shall be used to replace the existing white Federal Highway Administration (FHWA) Standard Highway Alphabets, when not specified in the SHSD, or in the plans.

B	CV-1W
C	CV-2W
D	CV-3W
E	CV-4W
Emod	CV-5WR
F	CV-6W
3. Route sign legend (ie. IH, US, SH and FM shields) shall use the Federal Highway Administration (FHWA) Standard Highway Alphabets B, C, D, E, Emod or F).
4. Lateral spacing between letters and numerals shall conform with the SHSD, and any approved changes thereto. Lateral spacing of legend shall provide a balanced appearance when spacing is not shown.
5. Independent mounted route sign with white or colored legend and borders shall be applied by screening process with transparent color ink, transparent colored overlay film to white background sheeting or cut-out white sheeting to colored background sheeting, or combination thereof. White legend, symbols and borders on all other signs shall be cut-out white sheeting applied to colored background sheeting.
6. Information regarding borders and radii for signs is found in the "Standard Highway Sign Designs for Texas". Dimensions shown and described for borders and corner radii on parent sign are nominal. Borders may vary in width as much as 1/2 inch. Corner radii above 3 inches may vary in width as much as 1 inch. Borders and corner radii within a parent sign must be of matching widths. The sign area outside the corner radius should be trimmed or rounded.
7. Sign substrate shall be any material that meets the Departmental Material Specification requirements of DMS-7110 or approved alternative.
8. Mounting details of roadside signs are shown in the "SMD series" Standard Plan Sheets.

DEPARTMENTAL MATERIAL SPECIFICATIONS	
ALUMINUM SIGN BLANKS	DMS-7110
SIGN FACE MATERIALS	DMS-8300

ALUMINUM SIGN BLANKS THICKNESS	
Square Feet	Minimum Thickness
Less than 7.5	0.080
7.5 to 15	0.100
Greater than 15	0.125

The Standard Highway Sign Designs for Texas (SHSD) can be found at the following website.

<http://www.txdot.gov/>



TYPICAL SIGN REQUIREMENTS

TSR(3)-13

FILE: tsr3-13.dgn	DN: TxDOT	CK: TxDOT	DW: TxDOT	CK: TxDOT
© TxDOT October 2003	CONT	SECT	JOB	HIGHWAY
REVISIONS
12-03 7-13	DIST	COUNTY	SHEET NO.	
9-08	41	


DATE:
 FILE:

DISCLAIMER: The use of this standard is governed by the "Texas Engineering Practice Act". No warranty of any kind is made by TxDOT for any purpose whatsoever. TxDOT assumes no responsibility for the conversion of this standard to other formats or for incorrect results or damages resulting from its use.

DATE: FILE:

REQUIREMENTS FOR RED BACKGROUND REGULATORY SIGNS

(STOP, YIELD, DO NOT ENTER AND WRONG WAY SIGNS)

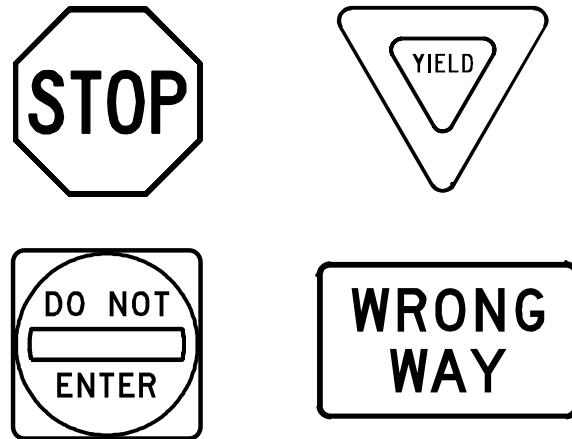

REQUIREMENTS FOR FOUR SPECIFIC SIGNS ONLY

SHEETING REQUIREMENTS		
USAGE	COLOR	SIGN FACE MATERIAL
BACKGROUND	RED	TYPE B OR C SHEETING
BACKGROUND	WHITE	TYPE B OR C SHEETING
LEGEND & BORDERS	WHITE	TYPE B OR C SHEETING
LEGEND	RED	TYPE B OR C SHEETING

REQUIREMENTS FOR WHITE BACKGROUND REGULATORY SIGNS


(EXCLUDING STOP, YIELD, DO NOT ENTER AND WRONG WAY SIGNS)



TYPICAL EXAMPLES

SHEETING REQUIREMENTS		
USAGE	COLOR	SIGN FACE MATERIAL
BACKGROUND	WHITE	TYPE A SHEETING
BACKGROUND	ALL OTHERS	TYPE B OR C SHEETING
LEGEND, BORDERS AND SYMBOLS	BLACK	ACRYLIC NON-REFLECTIVE FILM
LEGEND, BORDERS AND SYMBOLS	ALL OTHER	TYPE B OR C SHEETING

REQUIREMENTS FOR WARNING SIGNS

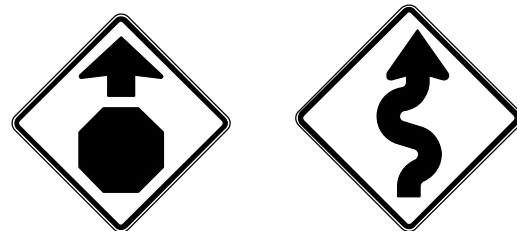

TYPICAL EXAMPLES

SHEETING REQUIREMENTS		
USAGE	COLOR	SIGN FACE MATERIAL
BACKGROUND	FLOURESCENT YELLOW	TYPE B _{FL} OR C _{FL} SHEETING
LEGEND & BORDERS	BLACK	ACRYLIC NON-REFLECTIVE FILM
LEGEND & SYMBOLS	ALL OTHER	TYPE B OR C SHEETING

REQUIREMENTS FOR SCHOOL SIGNS



TYPICAL EXAMPLES

SHEETING REQUIREMENTS		
USAGE	COLOR	SIGN FACE MATERIAL
BACKGROUND	WHITE	TYPE A SHEETING
BACKGROUND	FLOURESCENT YELLOW GREEN	TYPE B _{FL} OR C _{FL} SHEETING
LEGEND, BORDERS AND SYMBOLS	BLACK	ACRYLIC NON-REFLECTIVE FILM
SYMBOLS	RED	TYPE B OR C SHEETING

GENERAL NOTES

- Signs to be furnished shall be as detailed elsewhere in the plans and/or as shown on sign tabulation sheet. Standard sign designs and arrow dimensions can be found in the "Standard Highway Sign Designs for Texas" (SHSD).
- Sign legend shall use the Federal Highway Administration (FHWA) Standard Highway Alphabets (B, C, D, E, Emod or F).
- Lateral spacing between letters and numerals shall conform with the SHSD, and any approved changes thereto. Lateral spacing of legend shall provide a balanced appearance when spacing is not shown.
- Black legend and borders shall be applied by screening process or cut-out acrylic non-reflective black film to background sheeting, or combination thereof.
- White legend and borders shall be applied by screening process with transparent colored ink, transparent colored overlay film to white background sheeting or cut-out white sheeting to colored background sheeting, or combination thereof.
- Colored legend shall be applied by screening process with transparent colored ink, transparent colored overlay film or colored sheeting to background sheeting, or combination thereof.
- Sign substrate shall be any material that meets the Departmental Material Specification requirements of DMS-7110 or approved alternative.
- Mounting details for roadside mounted signs are shown in the "SMD series" Standard Plan Sheets.

ALUMINUM SIGN BLANKS THICKNESS

Square Feet	Minimum Thickness
Less than 7.5	0.080
7.5 to 15	0.100
Greater than 15	0.125

DEPARTMENTAL MATERIAL SPECIFICATIONS

ALUMINUM SIGN BLANKS	DMS-7110
SIGN FACE MATERIALS	DMS-8300

The Standard Highway Sign Designs for Texas (SHSD) can be found at the following website.

<http://www.txdot.gov/>



TYPICAL SIGN REQUIREMENTS

TSR(4)-13


FILE: tsr4-13.dgn	DN: TxDOT	CK: TxDOT	DW: TxDOT	CK: TxDOT
© TxDOT October 2003	CONT	SECT	JOB	HIGHWAY
REVISIONS
12-03 7-13	DIST	COUNTY	SHEET NO.	
9-08	42	

DISCLAIMER
The use of this standard is governed by the "Texas Engineering Practice Act". No warranty of any kind is made by TxDOT for any purpose whatsoever. TxDOT assumes no responsibility for the conversion of this standard to other formats or for incorrect results or damages resulting from its use.


LEVELS DISPLAYED
1 2 3 4 5 6 7 8 9 10 11 12 13 14 15 16
17 18 19 20 21 22 23 24 25 26 27 28 29 30 31 32
33 34 35 36 37 38 39 40 41 42 43 44 45 46 47 48
49 50 51 52 53 54 55 56 57 58 59 60 61 62 63

TYPICAL ATTACHMENT OF ROUTE MARKERS AND "EXIT ONLY" PANELS TO GUIDE SIGNS

SCREW ATTACHMENT

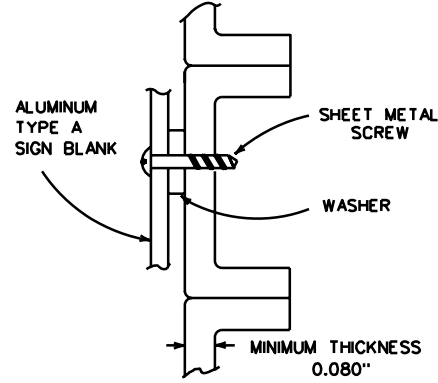


ALUMINUM GUIDE SIGNS
(EXTRUDED ALUMINUM PANELS)

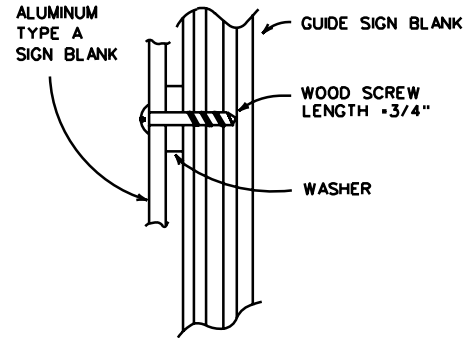


PLYWOOD GUIDE SIGN
(5/8" PLYWOOD)

NUT/BOLT ATTACHMENT

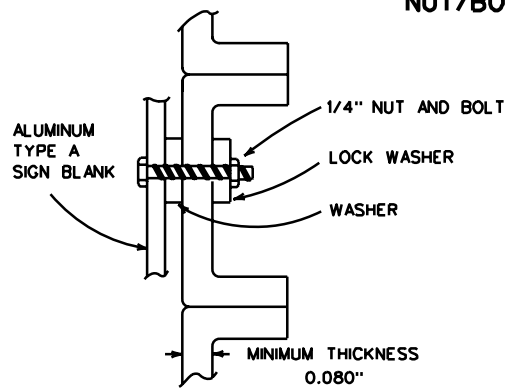


ALUMINUM GUIDE SIGNS
(EXTRUDED ALUMINUM PANELS)

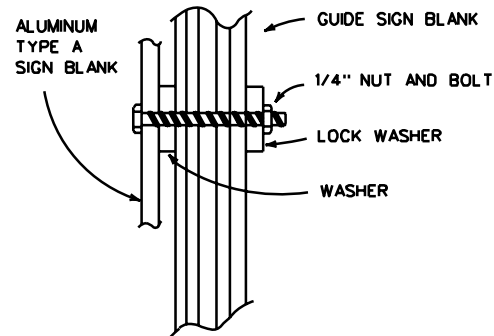


PLYWOOD GUIDE SIGN
(5/8" PLYWOOD)

DIRECT ATTACHMENT

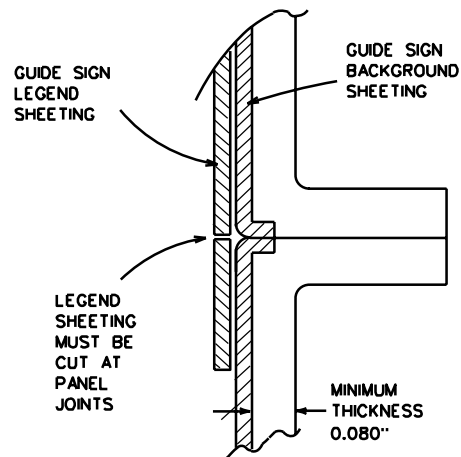

GUIDE SIGN LEGEND
(APPLIED DIRECTLY TO EXTRUDED ALUMINUM PANELS)

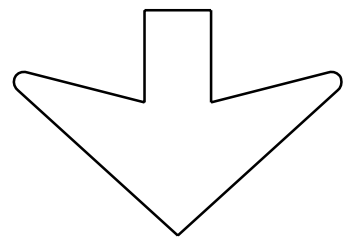


Type C
"Down" arrow

Arrow dimensions are shown in the "Standard Highway Sign Designs for Texas" manual.


The Standard Highway Sign Designs for Texas (SHSD) can be found at the following website.
<http://ftp.dot.state.tx.us/pub/txdot-info/tr/shsd/Navigate.pdf>

SIGN BLANK PUNCHING DETAILS FOR ROUTE MARKERS WHEN ATTACHED TO GUIDE SIGN

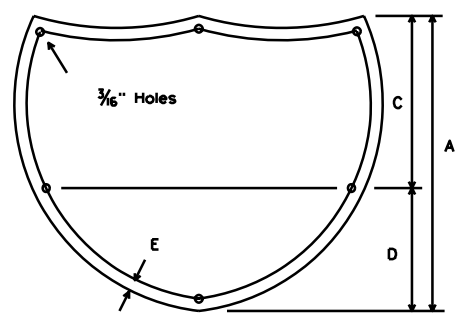


INTERSTATE ROUTE MARKERS

A	C	D	E
36	21	15	1 1/2
48	28	20	1 3/4

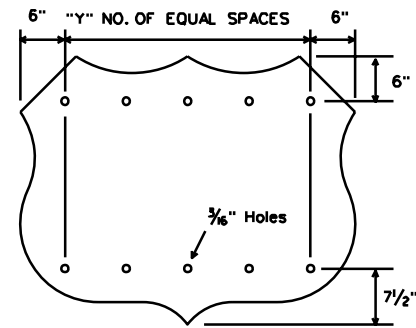

U.S. ROUTE MARKERS

Sign Size	"Y"
24x24	2
30x24	3
36x36	3
45x36	4
48x48	4
60x48	5


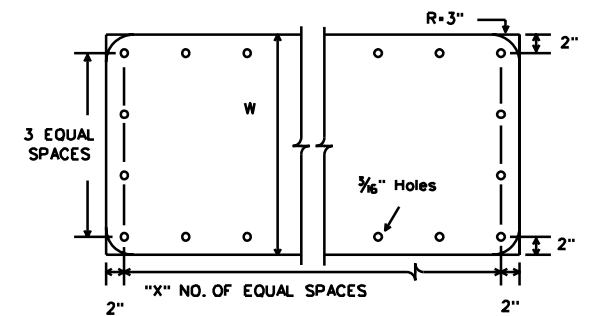


STATE ROUTE MARKERS


No. of Digits	W	X
4	24	4
4	36	5
4	48	6
3	24	3
3	36	4
3	48	5

ARROW DETAILS

for Large Ground-Mounted and Overhead Guide Signs

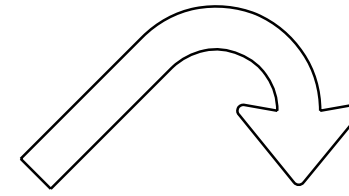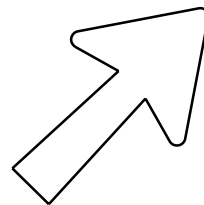

E3 and E3a

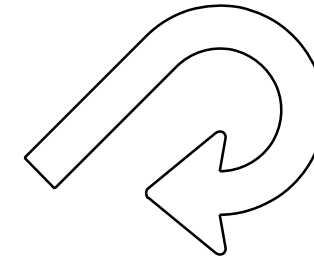


E4 and E4a

TYPE	LETTER SIZE
A-1	10.67" U/L and 10" Caps
A-2	13.33" U/L and 12" Caps
A-3	16" U/L
B-1	10.67" U/L and 10" Caps
B-2	13.33" U/L and 12" Caps
B-3	16" U/L


CODE	USED ON SIGN NO.
E-3 & E-4	E5-3 and E5-4
E-3a & E-4a	E5-3a and E5-4a

ARROW DETAILS

for Distance and Destination Signs

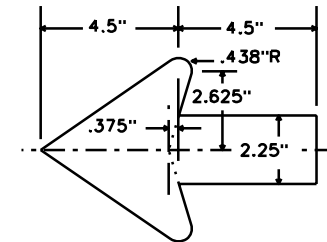

Standard 2.25" arrow
to be used with
6 inch letters.

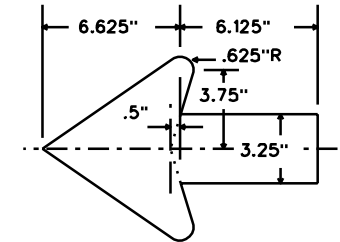

Standard 3.25" arrow
to be used with
8 inch letters.

12/03 Revision

Modify details of arrows.

STANDARD PLANS
Texas Department of Transportation
Traffic Operations Division

TYPICAL SIGN REQUIREMENTS

TSR(6)-03

REVISED	DATE	BY	DESCRIPTION	SHEET
12-03	October 2003	DIV- BAS	FEDERAL AID PROJECT	43
			COUNTY	
			CONTROL	
			SECTION	
			JOB	
			HIGHWAY	

DISCLAIMER
 The use of this standard is governed by the "Texas Engineering Practice Act". No warranty of any kind is made by TxDOT for any purpose whatsoever. TxDOT assumes no responsibility for the conversion of this standard to other formats or for incorrect results or damages resulting from its use.

LEVELS DISPLAYED
 1 2 3 4 5 6 7 8 9 10 11 12 13 14 15 16
 ACC: 17 18 19 20 21 22 23 24 25 26 27 28 29 30 31 32
 33 34 35 36 37 38 39 40 41 42 43 44 45 46 47 48
 49 50 51 52 53 54 55 56 57 58 59 60 61 62 63

SIGN SUPPORT DESCRIPTIVE CODES

(Descriptive Codes correspond to project estimate and quantities sheets)

SM RD SGN ASSM TY XXXXX(X)XX(X-XXXX)

Post Type

- FRP • Fiberglass Reinforced Plastic Pipe (see SMD(FRP))
- TWT • Thin-Walled Tubing (see SMD(TWT))
- 10BWC • 10 BWC Tubing (see SMD(SLIP-1) to (SLIP-3))
- S80 • Schedule 80 Pipe (see SMD(SLIP-1) to (SLIP-3))

Number of Posts (1 or 2)


Anchor Type

- UA • Universal Anchor - Concreted (see SMD(FRP) and (TWT))
- UB • Universal Anchor - Bolted down (see SMD(FRP) and (TWT))
- WS • Wedge Anchor Steel (see SMD(TWT))
- WP • Wedge Anchor Plastic (see SMD(TWT))
- SA • Slipbase - Concreted (see SMD(SLIP-1) to (SLIP-3))
- SB • Slipbase - Bolted Down (see SMD(SLIP-1) to (SLIP-3))

Sign Mounting Designation

- P • Prefab. "Plain" (see SMD(SLIP-1) to (SLIP-3), (TWT), (FRP))
- T • Prefab. "T" (see SMD(SLIP-1) to (SLIP-3), (TWT))
- U • Prefab. "U" (see SMD(SLIP-1) to (SLIP-3))
- IF REQUIRED
- TEXT or 2EXT • Number of Extensions (see SMD(SLIP-1) to (SLIP-3), (TWT))
- BM • Extruded Wind Beam (see SMD(SLIP-1) to (SLIP-3))
- WC • 1.12 "/ft Wing Channel (see SMD(SLIP-1) to (SLIP-3))
- EXAL • Extruded Aluminum Sign Panels (see SMD(SLIP-3))


REQUIRED CLEARANCE FOR BREAKAWAY SUPPORT

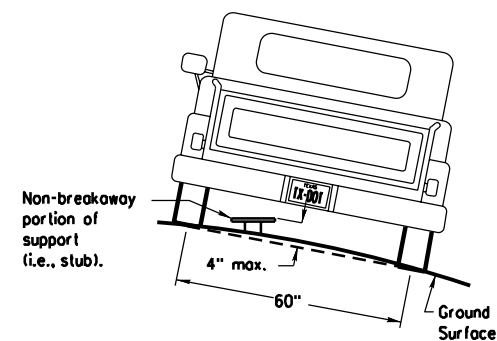

To avoid vehicle undercarriage snagging, any substantial remains of a breakaway support, when it is broken away, should not project more than 4 inches above a 60-inch chord (i.e., typical space between wheelpaths).


SIGN LOCATION

PAVED SHOULDERS

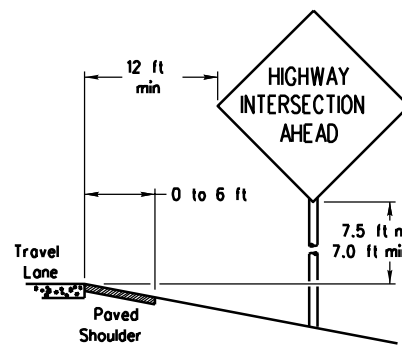

LESS THAN 6 FT. WIDE


When the shoulder is 6 ft. or less in width, the sign must be placed at least 12 ft. from the edge of the travel lane.

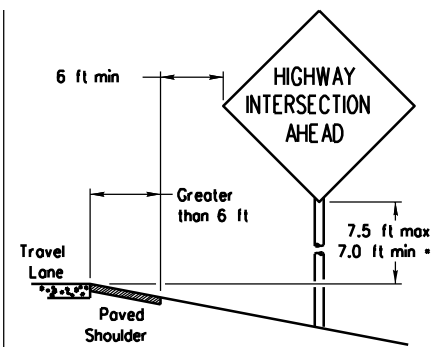

GREATER THAN 6 FT. WIDE


When the shoulder is greater than 6 ft in width, the sign must be placed at least 6 ft. from the edge of the shoulder.

T-INTERSECTION

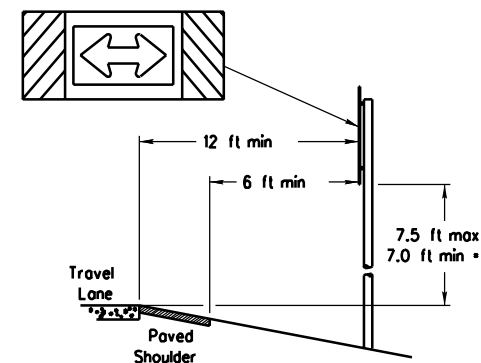


When this sign is needed at the end of a two-lane, two way roadway, the right edge of the sign should be in line with the centerline of the roadway. Place as close to ROW as practical.

No more than 2 sign posts should be located within a 7 ft. circle.

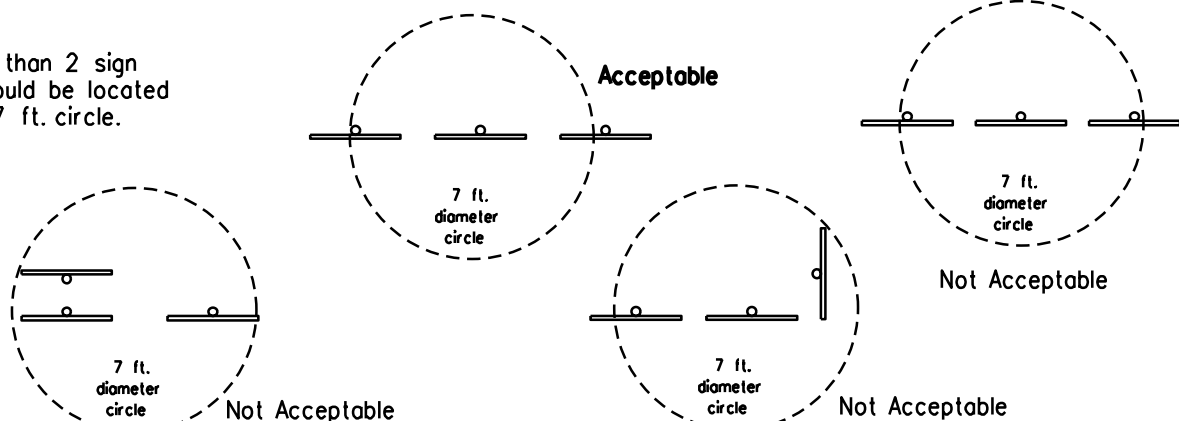


BEHIND BARRIER

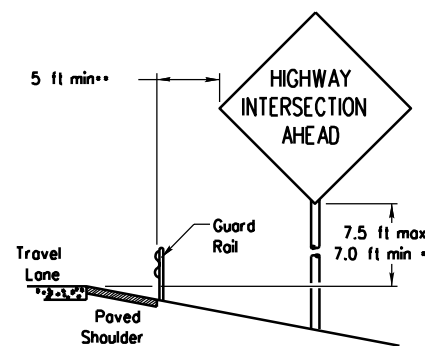


BEHIND GUARDRAIL

**Sign clearance based on distance required for proper guard rail or concrete barrier performance.

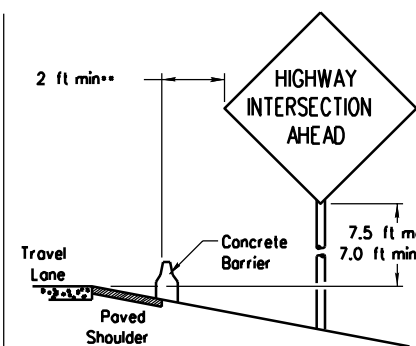

BEHIND CONCRETE BARRIER

TYPICAL SIGN ATTACHMENT DETAIL

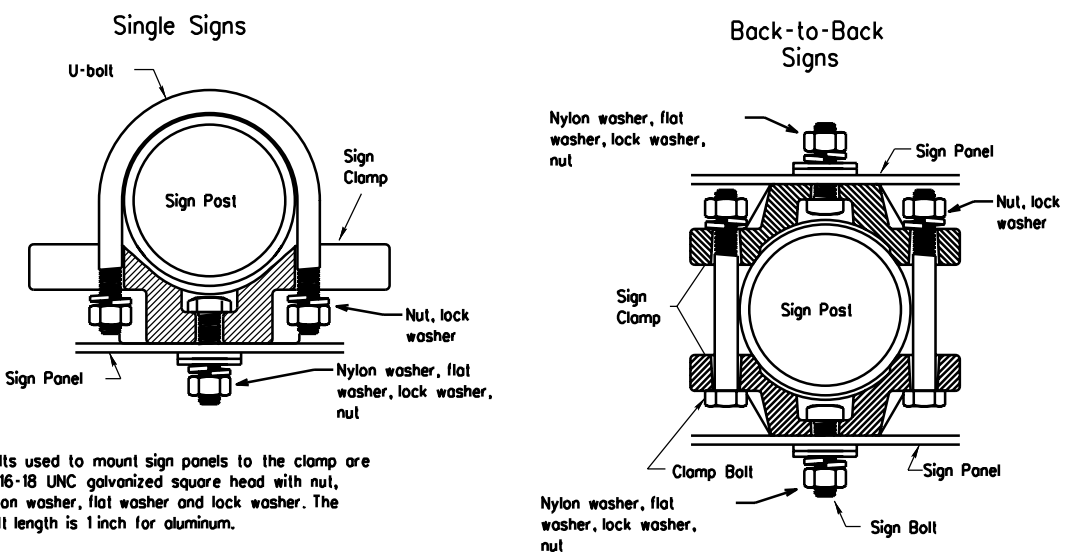


Bolts used to mount sign panels to the clamp are 5/16-18 UNC galvanized square head with nut, nylon washer, flat washer and lock washer. The bolt length is 1 inch for aluminum.

When two sign clamps are used to mount signs back-to-back, use a 5/16-18 UNC galvanized hex head per ASTM A307 with nut and helical-spring lock washer. The approximate bolt lengths for various post sizes and sign clamp types are given in the table at right. The bolt length may need to be adjusted depending upon field conditions.

Sign clamps may be either the specific size clamp or the universal clamp.


Pipe Diameter	Approximate Bolt Length	
	Specific Clamp	Universal Clamp
2" nominal	3"	3 or 3 1/2"
2 1/2" nominal	3 or 3 1/2"	3 1/2 or 4"
3" nominal	3 1/2 or 4"	4 1/2"

SIGNS WITH PLAQUES

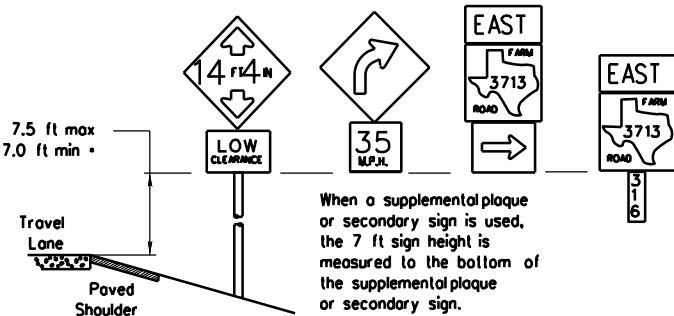


When a supplemental plaque or secondary sign is used, the 7 ft sign height is measured to the bottom of the supplemental plaque or secondary sign.

CURB & GUTTER OR RAISED ISLAND

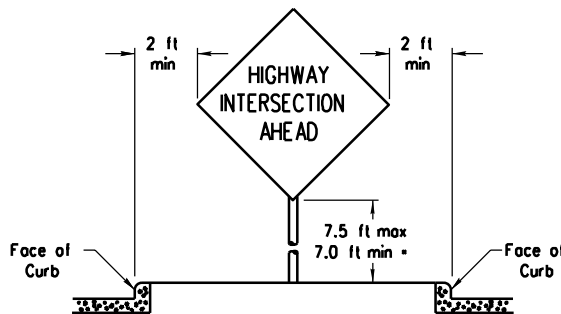

RESTRICTED RIGHT-OF-WAY


(When 6 ft min. is not possible.)

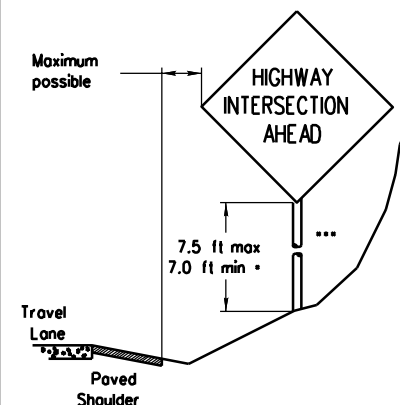

Right-of-way restrictions may be created by rocks, water, vegetation, forest, buildings, a narrow island, or other factors.

In situations where a lateral restriction prevents the minimum horizontal clearance from the edge of the travel lane, signs should be placed as far from the travel lane as practical.

*** Post may be shorter if protected by guardrail or if Engineer determines the post could not be hit due to extreme slope.

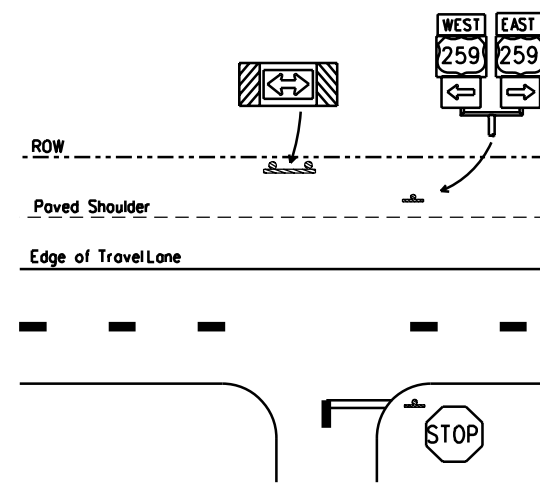

• Signs shall be mounted using the following condition that results in the greatest sign elevation:

- (1) a minimum of 7 to a maximum of 7.5 feet above the edge of the travel lane or
- (2) a minimum of 7 to a maximum of 7.5 feet above the grade at the base of the support when sign is installed on the backslope.

The maximum values may be increased when directed by the Engineer.

See the Traffic Operations Division website for detailed drawings of sign clamps, Triangular Slipbase System components and Wedge Anchor System components.

The website address is:
<http://www.txdot.gov/publications/traffic.htm>

STANDARD PLANS
 TEXAS DEPARTMENT OF TRANSPORTATION
 Traffic Operations Division

SIGN MOUNTING DETAILS SMALL ROADSIDE SIGNS GENERAL NOTES & DETAILS

SMD(GEN)-08

REVISED	DATE	BY	REASON	DATE	BY	REASON
9-08	---	---	---	---	---	---
COUNTY	CONTROL	SECTION	JOB	HIGHWAY	SHEET	
---	---	---	---	---	44	

TRIANGULAR SLIPBASE INSTALLATION GENERAL REQUIREMENTS


NOTE
The devices shall be installed per manufacturers' recommendations. Installation procedures shall be provided to the Engineer by Contractor.

GENERAL NOTES:




- Slip base shall be permanently marked to indicate manufacturer. Method, design, and location of marking are subject to approval of the TxDOT Traffic Standards Engineer.
- Material used as post with this system shall conform to the following specifications:
 10 BWG Tubing (2.875" outside diameter)
 0.134" nominal wall thickness
 Seamless or electric-resistance welded steel tubing or pipe
 Steel shall be HSLAS Gr 55 per ASTM A1011 or ASTM A1008
 Other steels may be used if they meet the following:
 55,000 PSI minimum yield strength
 70,000 PSI minimum tensile strength
 20% minimum elongation in 2"
 Wall thickness (uncoated) shall be within the range of 0.122" to 0.138"
 Outside diameter (uncoated) shall be within the range of 2.867" to 2.883"
 Galvanization per ASTM A123 or ASTM A653 G210. For pre-coated steel tubing (ASTM A653), recoat tube outside diameter weld seam by metallizing with zinc wire per ASTM B833.
 Schedule 80 Pipe (2.875" outside diameter)
 0.276" nominal wall thickness
 Steel tubing per ASTM A500 Gr C
 Other seamless or electric-resistance welded steel tubing or pipe with equivalent outside diameter and wall thickness may be used if they meet the following:
 46,000 PSI minimum yield strength
 62,000 PSI minimum tensile strength
 21% minimum elongation in 2"
 Wall thickness (uncoated) shall be within the range of 0.248" to 0.304"
 Outside diameter (uncoated) shall be within the range of 2.855" to 2.895"
 Galvanization per ASTM A123
- See the Traffic Operations Division website for detailed drawings of sign clamps and Texas Universal Triangular Slipbase System components. The website address is:
<http://www.txdot.gov/publications/traffic.htm>
- Sign supports shall not be spliced except where shown. Sign support posts shall not be spliced.

ASSEMBLY PROCEDURE


- Foundation**
- Prepare 12-inch diameter by 42-inch deep hole. If solid rock is encountered, the depth of the foundation may be reduced such that it is embedded a minimum of 18 inches into the solid rock.
 - The Engineer may permit batches of concrete less than 2 cubic yards to be mixed with a portable, motor-driven concrete mixer. For small placements less than 0.5 cubic yards, hand mixing in a suitable container may be allowed by Engineer. Concrete shall be Class A.
 - Push the pipe end of the slip base stub into the concrete. Rotate the stub back and forth while pushing it down into the concrete to assure good contact between the concrete and stub. Continue to work the stub into the concrete until it is between 2 to 4 inches above the ground.
 - Plumb the stub. Allow a minimum of 4 days to set, unless otherwise directed by the Engineer.
 - The triangular slipbase system is multidirectional and is designed to release when struck from any direction.
- Support**
- Cut support so that the bottom of the sign will be 7 to 7.5 feet above the edge of the travelway (i.e., edge of the closest lane) when slip plate is below the edge of pavement or 7 to 7.5 feet above slip plate when the slip plate is above the edge of the travelway. The cut shall be plumb and straight.
 - Attach sign to support using connections shown. When multiple signs are installed on the same support, ensure the minimum clearance between each sign is maintained. See SMD(SLIP-2) for clearances based on sign types.

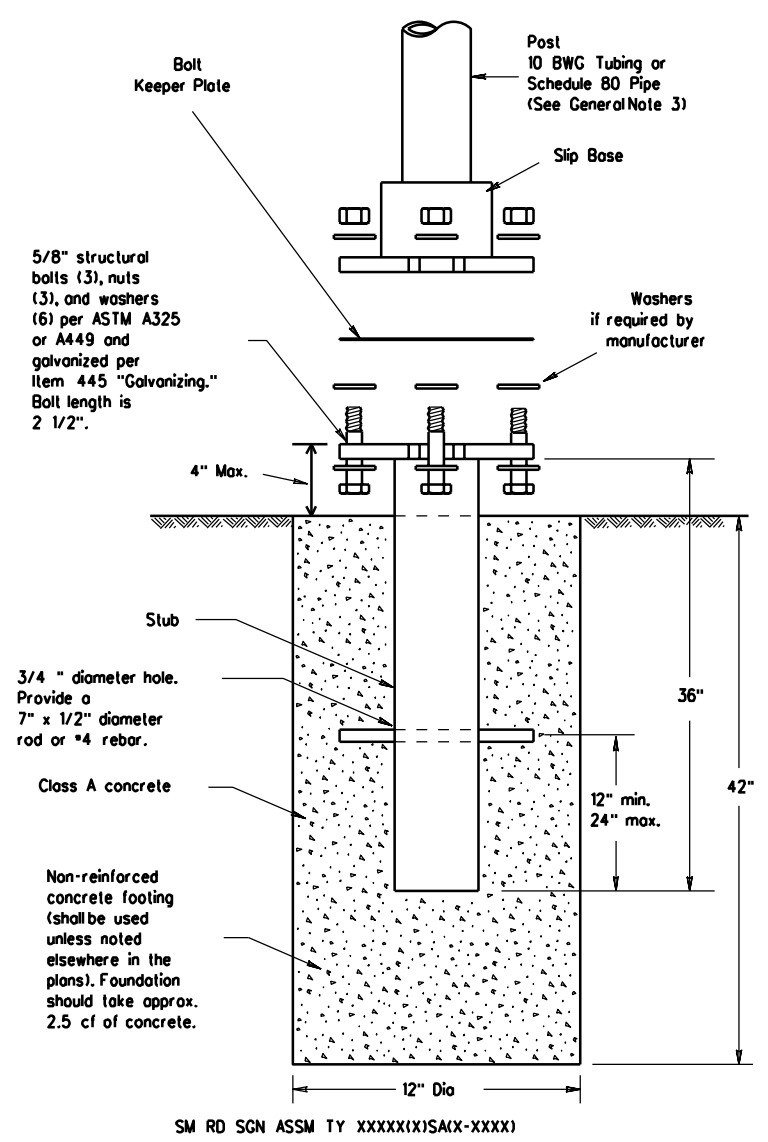

SM RD SGN ASSM TY XXXXX(X)SA(X-XXXX)

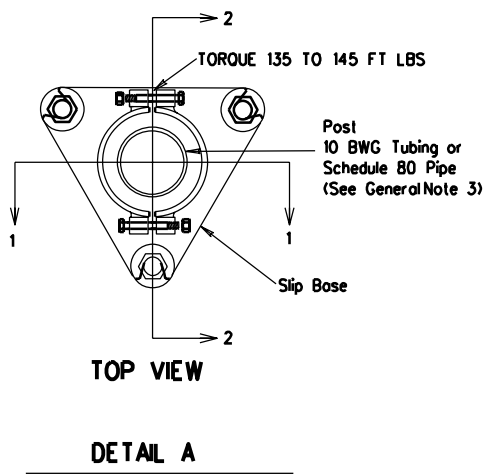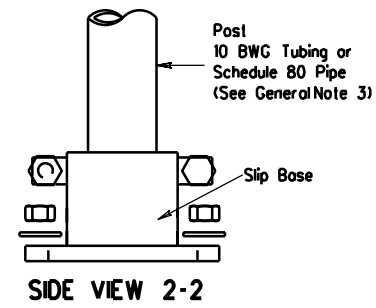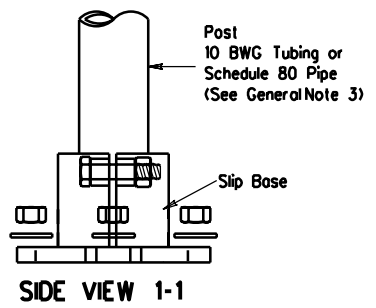

CONCRETE ANCHOR

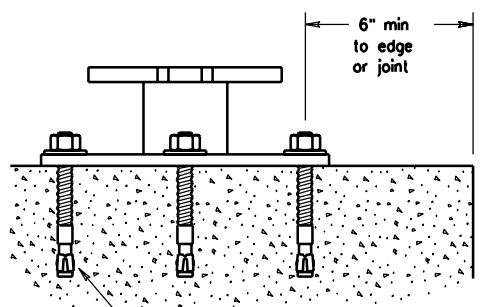


Concrete anchor consists of 5/8" diameter stud bolt with UNC series bolt threads on the upper end. Heavy hex nut per ASTM A563, and hordened washer per ASTM F436. The stud bolt shall have a minimum yield and ultimate tensile strength of 50 and 75 KSI, respectively. Nuts, bolts and washers shall be galvanized per Item 445, "Galvanizing." Adhesive type anchors shall have stud bolts installed with Type III epoxy per DNS-6100, "Epoxyes and Adhesives." Adhesive anchors may be loaded after adequate epoxy cure time per the manufacturer's recommendations. Top of bolt shall extend at least flush with top of the nut when installed. The anchor, when installed in 4000 psi normal-weight concrete with a 5 1/2" minimum embedment, shall have a minimum allowable tension and shear of 3900 and 3100 psi, respectively.

5/8" diameter Concrete Anchor - 8 places (embed a minimum of 5 1/2" and torque to min. of 50 ft-lbs). Anchor may be expansion or adhesive type.

SM RD SGN ASSM TY XXXXX(X)SB(X-XXXX)

DISCLAIMER: The use of this standard is governed by the "Texas Engineering Practice Act". No warranty of any kind is made by TxDOT for any purpose whatsoever. TxDOT assumes no responsibility for the conversion of this standard to other formats or damages resulting from its use.

DATE:
FILE:



Texas Department of Transportation
Dallas District Standard

SIGN MOUNTING DETAILS
SMALL ROADSIDE SIGNS
TRIANGULAR SLIPBASE SYSTEM

SMD(SLIP-1)-08(DAL)















ADDED DETAIL A FOR CLAMP BASE
10-2010

© TxDOT July 2002		DN: TxDOT	CK: TxDOT	DW: TxDOT	CK: TxDOT
REVISIONS		CONT	SECT	JOB	HIGHWAY
9-08		---	---	---	---
12-10 (DISTRICT)					
ADDED CLAMP BASE					
DETAIL FOR SLIP					
BASE INSTALLATION					
---		---		SHEET NO.	
				45	

26B

DISCLAIMER
The use of this standard is governed by the "Texas Engineering Practice Act". No warranty of any kind is made by TxDOT for any purpose whatsoever, and TxDOT assumes no responsibility for the conversion of this standard to other formats or for incorrect results or damages resulting from its use.

LEVELS DISPLAYED
1 2 3 4 5 6 7 8 9 10 11 12 13 14 15 16
17 18 19 20 21 22 23 24 25 26 27 28 29 30 31 32
33 34 35 36 37 38 39 40 41 42 43 44 45 46 47 48
49 50 51 52 53 54 55 56 57 58 59 60 61 62 63

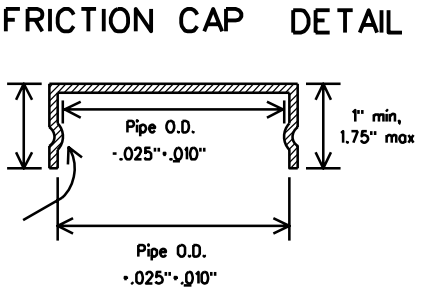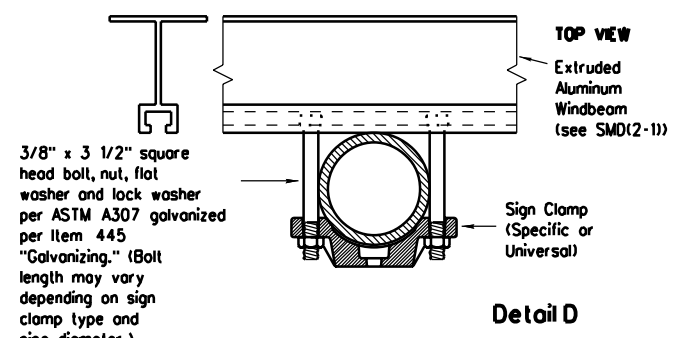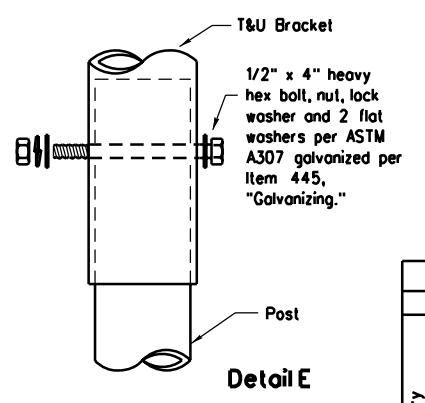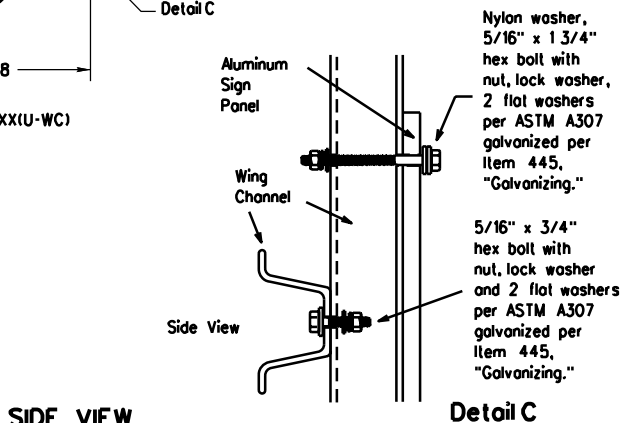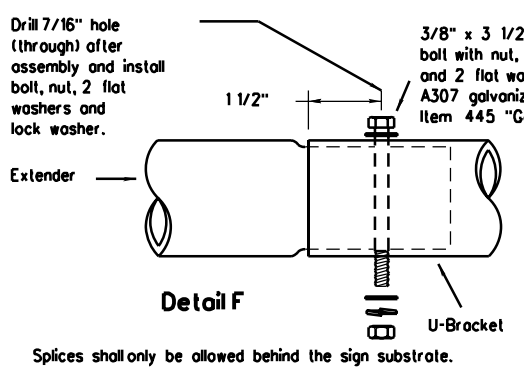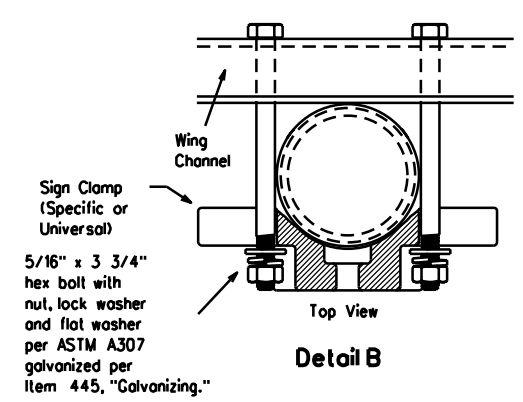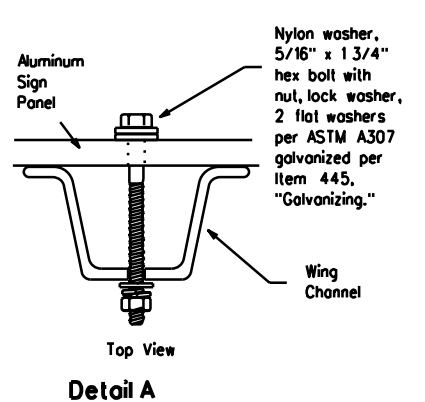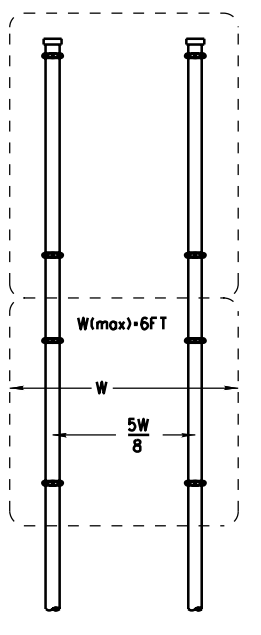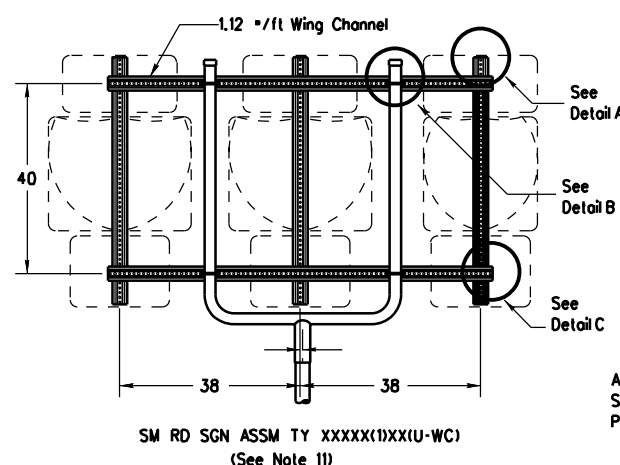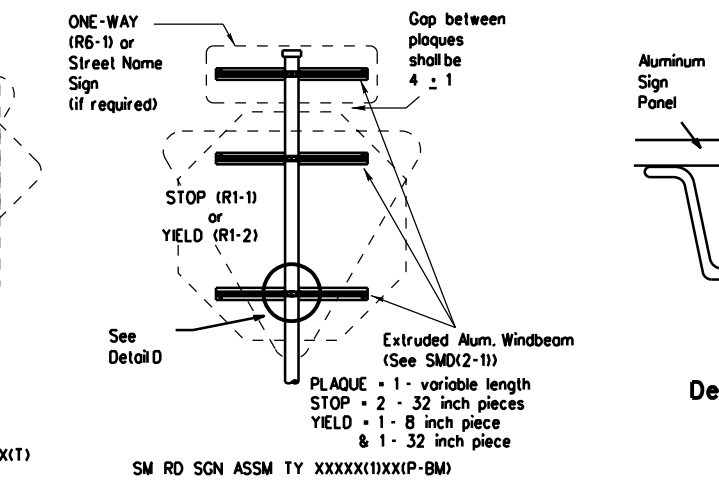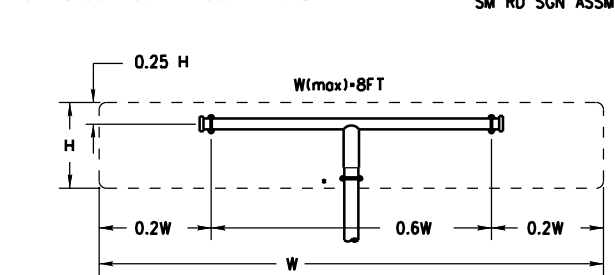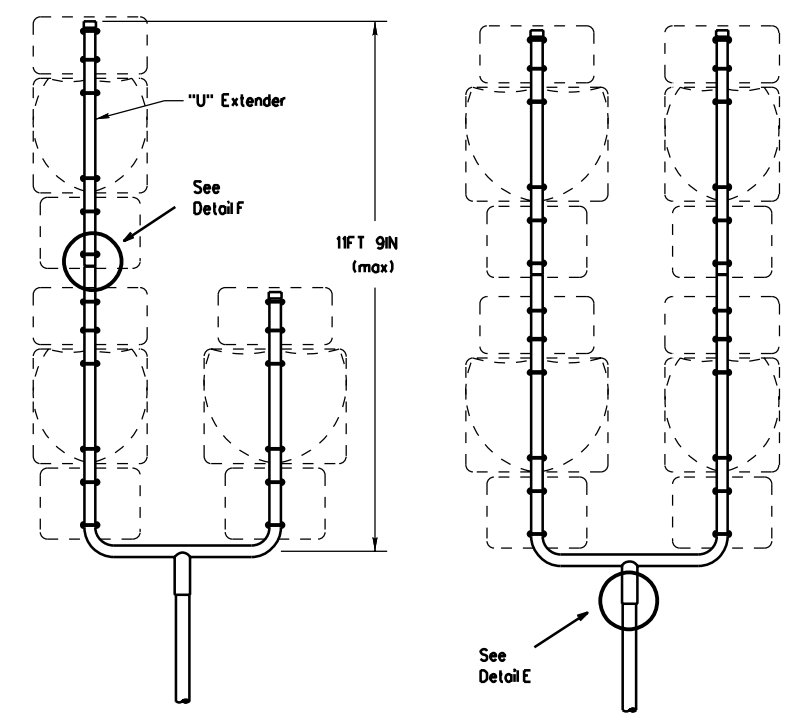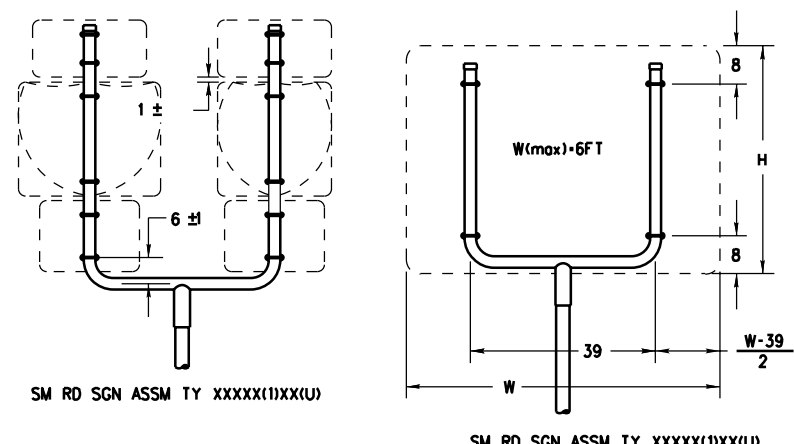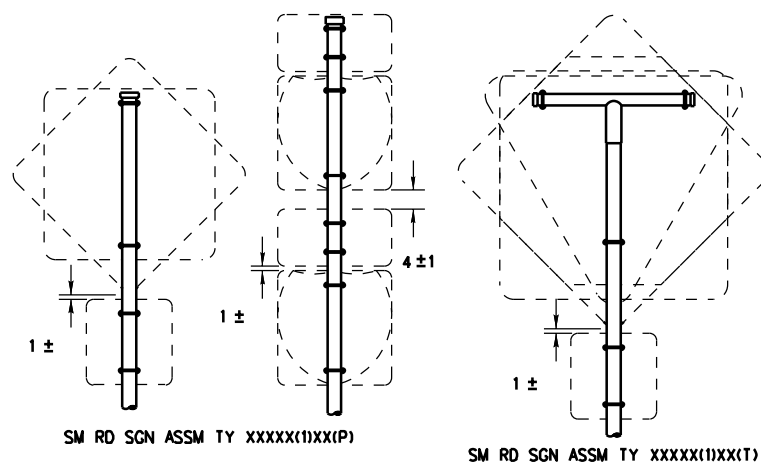

Friction caps may be manufactured from hot rolled or cold rolled steelsheets. The minimum sheet metal thickness shall be 24 gauge for all cap sizes. The rim edges shall be reasonably straight and smooth. Caps shall be sized and formed in such a manner as to produce a drive-on friction fit and have no tendency to rock when seated on the pipe. The depth shall be sufficient to give positive protection against entrance of rainwater. They shall be free of sharp creases or indentations and show no evidence of metal fracture. Caps shall have an electrodeposited coating of zinc in accordance with the requirements of ASTM B633 Class FE/ZN 8.

GENERAL NOTES:

- | SIGN SUPPORT | OF POSTS | MAX. SIGN AREA |
|--------------|----------|----------------|
| 10 BWC | 1 | 16 SF |
| 10 BWC | 2 | 32 SF |
| Sch 80 | 1 | 32 SF |
| Sch 80 | 2 | 64 SF |
- The Engineer may require that a Schedule 80 post be used in place of a 10 BWC where a sign height is abnormally high due to a fill slope.
- Sign supports shall not be spliced except where shown. Sign support posts shall not be spliced.
- Aluminum sign blanks shall conform to Departmental Material Specifications DMS-7110 and shall have the following minimum thicknesses: 0.080 for signs less than 7.5 sq. ft., 0.100 for signs 7.5 to 15 sq. ft., and 0.125 for signs greater than 15 sq. ft.
- Signs that require specific supports due to reasons in addition to windloading are indicated on the "REQUIRED SUPPORT" table on this sheet.
- For horizontal rectangular signs fabricated from flat aluminum, T-brackets are used for signs 24 inches or less in height. U-brackets are used for signs of greater height.
- When two triangular slipbase supports are used to support a single sign, they shall not be "rigidly" connected to each other except through the sign panel. This will allow each support to act independently when impacted by an errant vehicle.
- Wing channel shall meet ASTM A 1011 SS Gr 50 and be galvanized per ASTM A 123.
- Excess pipe, wing channel, or windbeam shall be cut off so that it does not extend beyond the sign panel (i.e., excess support shall not be visible when the sign is viewed from the front.) Repair galvanized coating at cut support ends per Item 445, "Galvanizing."
- Additional route markers may be added vertically, provided the total sign area does not exceed the maximum allowable amount per Note 1.
- Additional sign clamp required on the "T-bracket" post for 24 inch height signs. Place the clamp 3 inches above bottom of sign when possible.
- Post open ends shall be fitted with Friction Caps.
- Sign blanks shall be the sizes and shapes shown on the plans.

REQUIRED SUPPORT	
SIGN DESCRIPTION	SUPPORT
48-inch STOP sign (R1-1)	TY 10BWC(1)XX(T) TY 10BWC(1)XX(P-BM)
60-inch YIELD sign (R1-2)	TY 10BWC(1)XX(T) TY 10BWC(1)XX(P-BM)
48x16-inch ONE-WAY sign (R6-1)	TY 10BWC(1)XX(T) TY 10BWC(1)XX(P-BM)
36x48, 48x36, and 48x48-inch signs	TY 10BWC(1)XX(T)
48x60-inch signs	TY S80(1)XX(T)
48x48-inch signs (diamond or square)	TY 10BWC(1)XX(T)
48x60-inch signs	TY S80(1)XX(T)
48-inch Advance School X-ing sign (S1-1)	TY 10BWC(1)XX(T)
48-inch School X-ing sign (S2-1)	TY 10BWC(1)XX(T)
Large Arrow sign (W1-6 & W1-7)	TY 10BWC(1)XX(T)











STANDARD PLANS
Texas Department of Transportation
Traffic Operations Division

SIGN MOUNTING DETAILS
SMALL ROADSIDE SIGNS
TRIANGULAR SLIPBASE SYSTEM
SMD(SLIP-2)-08

REVISIONS	DATE	BY	CHK'D	APP'D	SHEET
9-08	---	---	---	---	46
	COUNTY	CONTROL	SECTION	JOB	HIGHWAY
	---	---	---	---	---

DISCLAIMER
The use of this standard is governed by the "Texas Engineering Practice Act". No warranty of any kind is made by TxDOT for any purpose whatsoever. TxDOT assumes no responsibility for the conversion of this standard to other formats or for incorrect results or damages resulting from its use.

LEVELS DISPLAYED
ACC:
17 18 19 20 21 22 23 24 25 26 27 28 29 30 31 32
33 34 35 36 37 38 39 40 41 42 43 44 45 46 47 48
49 50 51 52 53 54 55 56 57 58 59 60 61 62 63

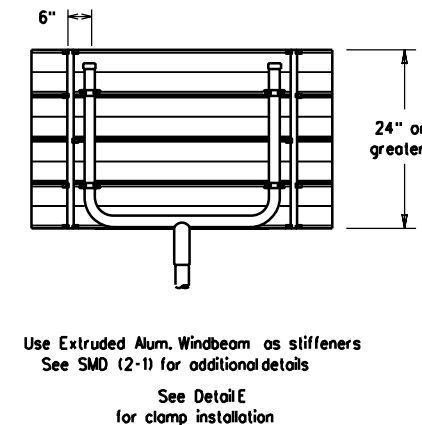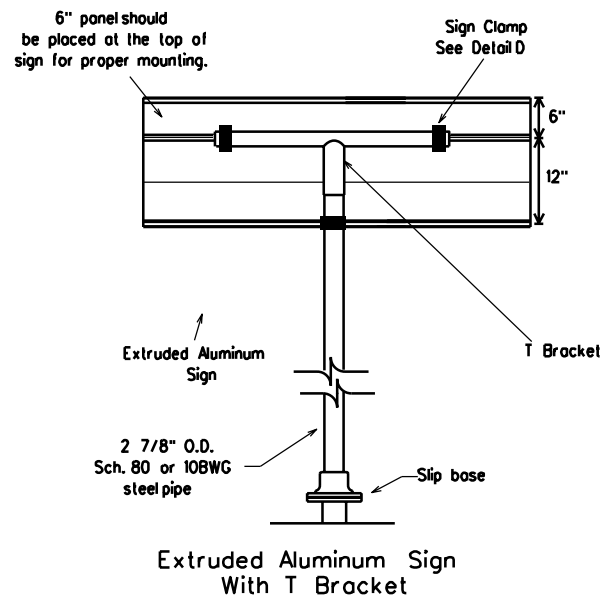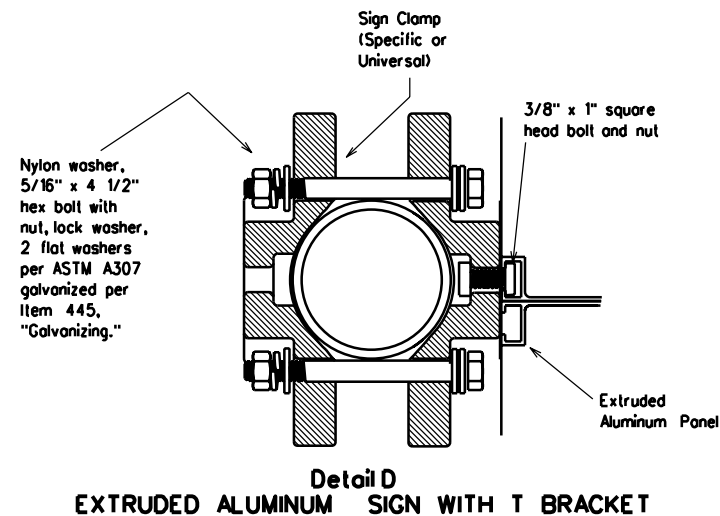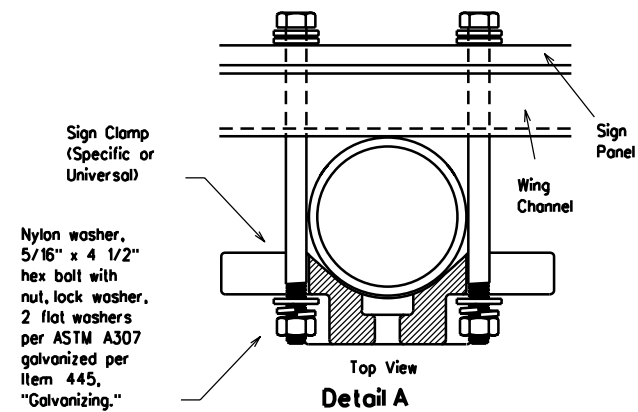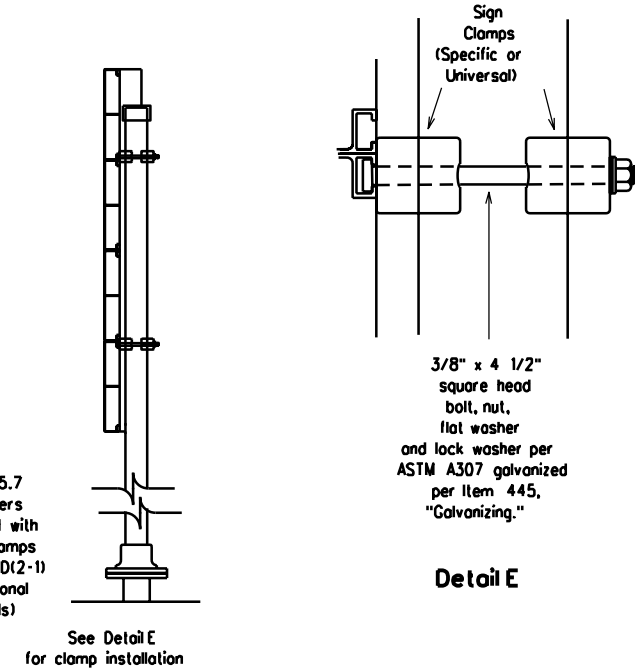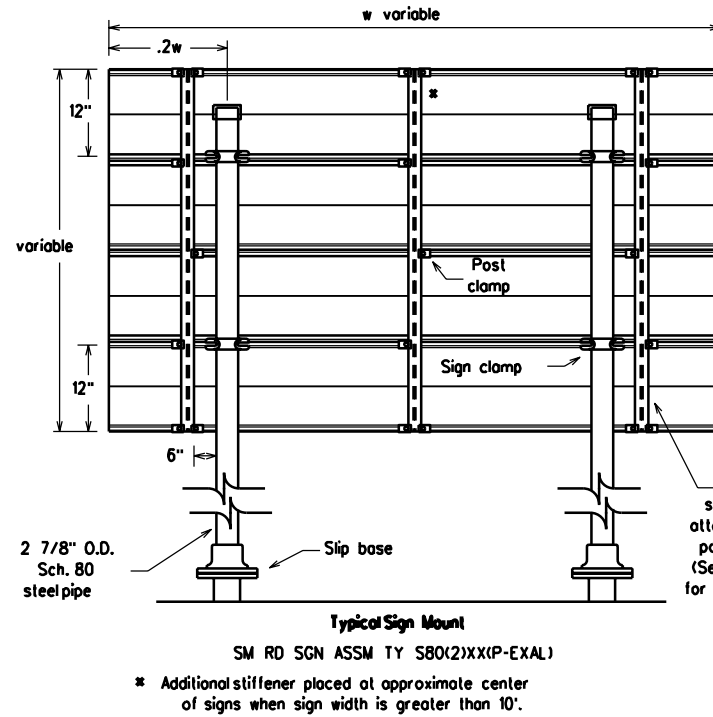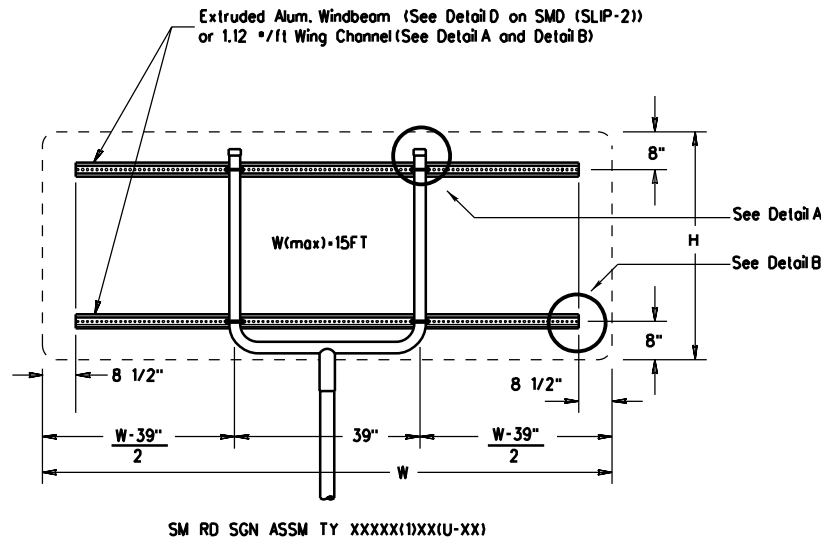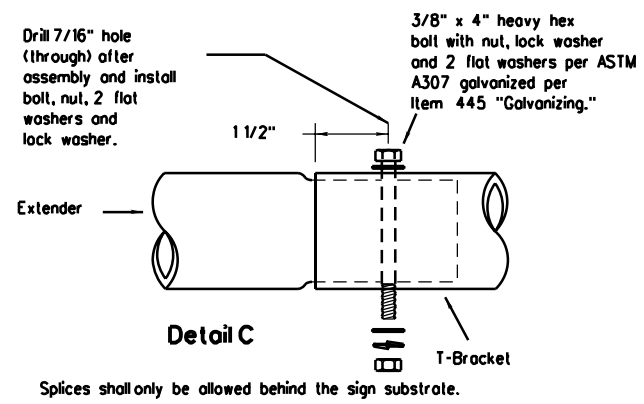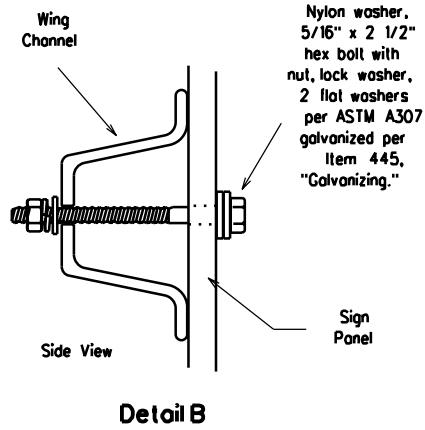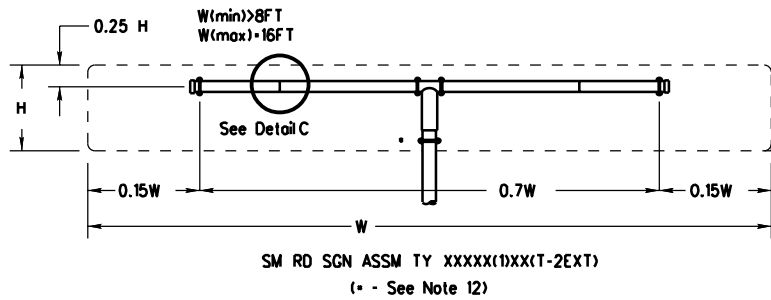

GENERAL NOTES:

- | SIGN SUPPORT | # OF POSTS | MAX. SIGN AREA |
|--------------|------------|----------------|
| 10 BWG | 1 | 16 SF |
| 10 BWG | 2 | 32 SF |
| Sch 80 | 1 | 32 SF |
| Sch 80 | 2 | 64 SF |
- The Engineer may require that a Schedule 80 post be used in place of a 10 BWG where a sign height is abnormally high due to a fill slope.
 - Sign supports shall not be spliced except where shown. Sign support posts shall not be spliced.
 - Aluminum sign blanks shall conform to Departmental Material Specifications DMS-7110 and shall have the following minimum thicknesses: 0.080 for signs less than 7.5 sq. ft., 0.100 for signs 7.5 to 15 sq. ft., and 0.125 for signs greater than 15 sq. ft.
 - Signs that require specific supports due to reasons in addition to windloading are indicated on the "REQUIRED SUPPORT" table on this sheet.
 - For horizontal rectangular signs fabricated from flat aluminum, T-brackets are used for signs 24 inches or less in height. U-brackets are used for signs of greater height.
 - When two triangular slipbase supports are used to support a single sign, they shall not be "rigidly" connected to each other except through the sign panel. This will allow each support to act independently when impacted by an errant vehicle.
 - Wing channel shall meet ASTM A 1011 SS Gr 50 and be galvanized per ASTM A 123.
 - Excess pipe, wing channel, or windbeam shall be cut off so that it does not extend beyond the sign panel (i.e., excess support shall not be visible when the sign is viewed from the front.) Repair galvanized coating at cut support ends per Item 445, "Galvanizing."
 - Sign blanks shall be the sizes and shapes shown on the plans.
 - Additional sign clamp required on the "T-bracket" post for 24 inch high signs. Place the clamp 3 inches above bottom of sign when possible.
 - Post open ends shall be fitted with Friction Caps.


REQUIRED SUPPORT		
	SIGN DESCRIPTION	SUPPORT
Regulatory	48-inch STOP sign (R1-1)	TY 10BWG(1)XX(T) TY 10BWG(1)XX(P-BM)
	60-inch YIELD sign (R1-2)	TY 10BWG(1)XX(T) TY 10BWG(1)XX(P-BM)
	48x16-inch ONE-WAY sign (R6-1)	TY 10BWG(1)XX(T) TY 10BWG(1)XX(P-BM)
	36x48, 48x36, and 48x48-inch signs	TY 10BWG(1)XX(T)
Warning	48x60-inch signs	TY S80(1)XX(T)
	48x48-inch signs (diamond or square)	TY 10BWG(1)XX(T)
	48x60-inch signs	TY S80(1)XX(T)
	48-inch Advance School X-ing sign (S1-1)	TY 10BWG(1)XX(T)
	48-inch School X-ing sign (S2-1)	TY 10BWG(1)XX(T)
	Large Arrow sign (W1-6 & W1-7)	TY 10BWG(1)XX(T)

STANDARD PLANS
Texas Department of Transportation
Traffic Operations Division


SIGN MOUNTING DETAILS
SMALL ROADSIDE SIGNS
TRIANGULAR SLIPBASE SYSTEM
SMD(SLIP-3)-08

REVISIONS	STATE DISTRICT	FEDERAL REGION	FEDERAL AID PROJECT	SHEET
9-08	---	---	---	47
	COUNTY	CONTROL	SECTION	JOB
	---	---	---	---


DISCLAIMER: The use of this standard is governed by the "Texas Engineering Practice Act". No warranty of any kind is made by TxDOT for any purpose whatsoever. TxDOT assumes no responsibility for the conversion of this standard to other formats or for incorrect results or damages resulting from its use.

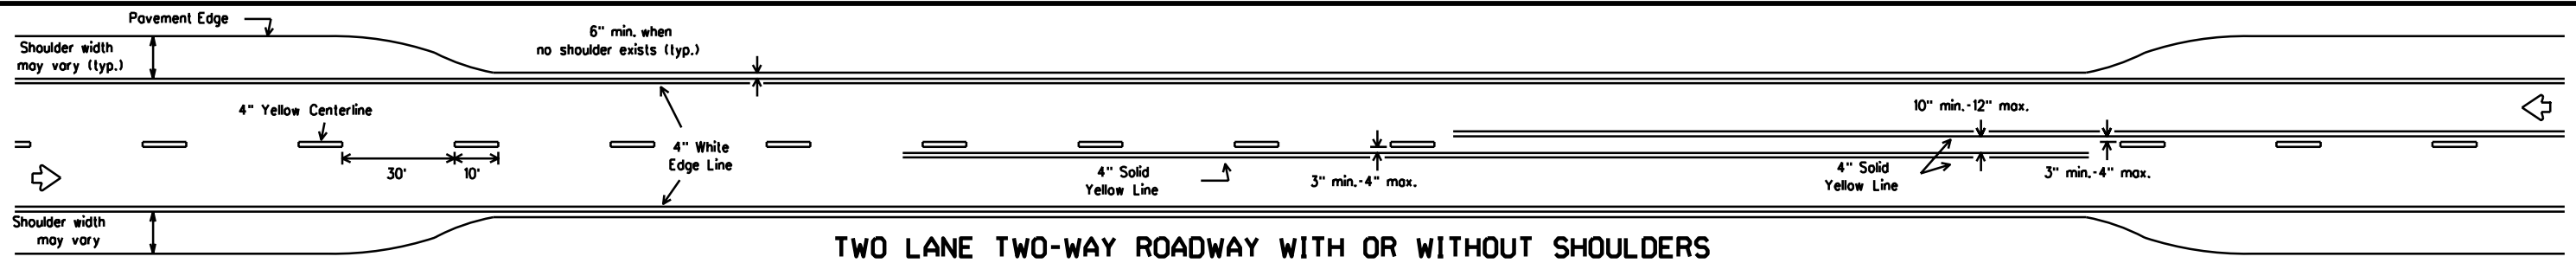


TWO LANE TWO-WAY ROADWAY WITH OR WITHOUT SHOULDERS

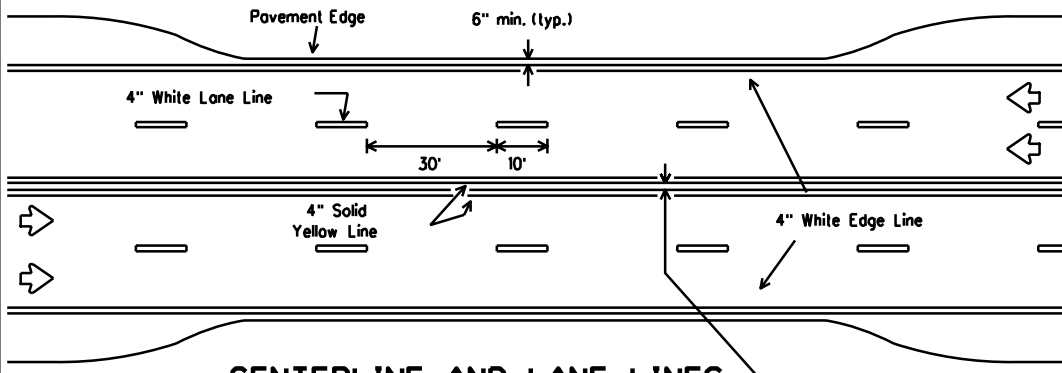


**CENTERLINE AND LANE LINES
FOUR LANE TWO-WAY ROADWAY
WITH OR WITHOUT SHOULDERS**

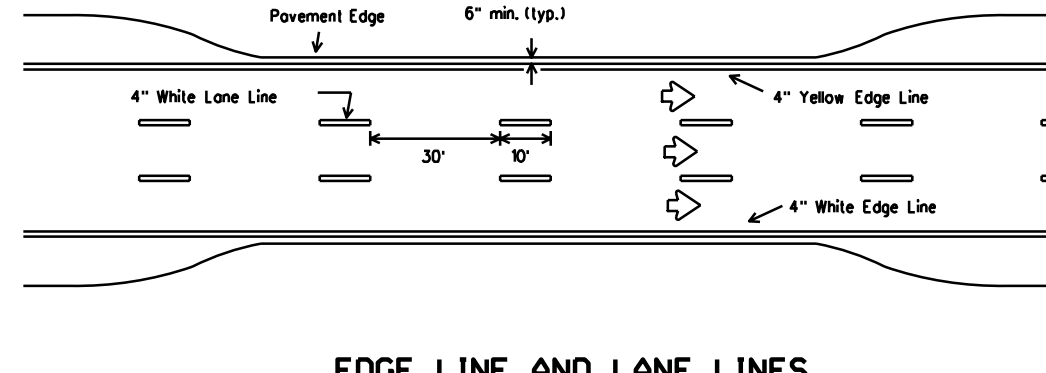


**EDGE LINE AND LANE LINES
ONE-WAY ROADWAY
WITH OR WITHOUT SHOULDERS**

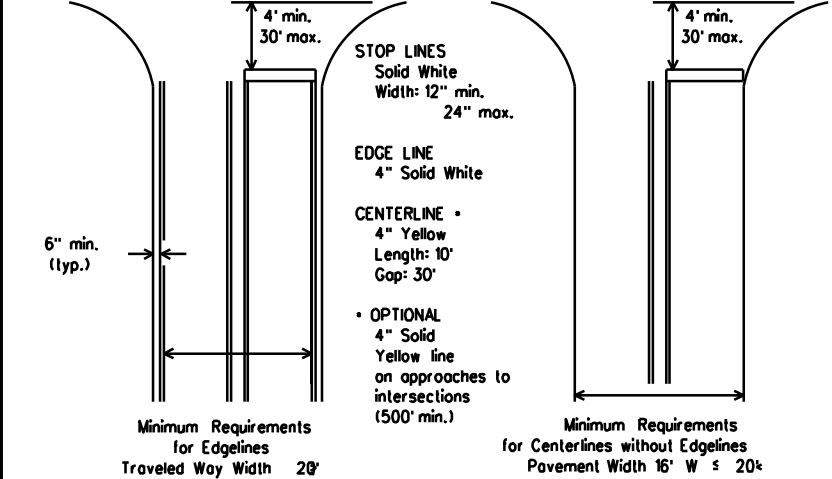

**GUIDE FOR PLACEMENT OF STOP LINES,
EDGE LINE & CENTERLINE**
Based on Traveled Way and Pavement Widths for Undivided Highways

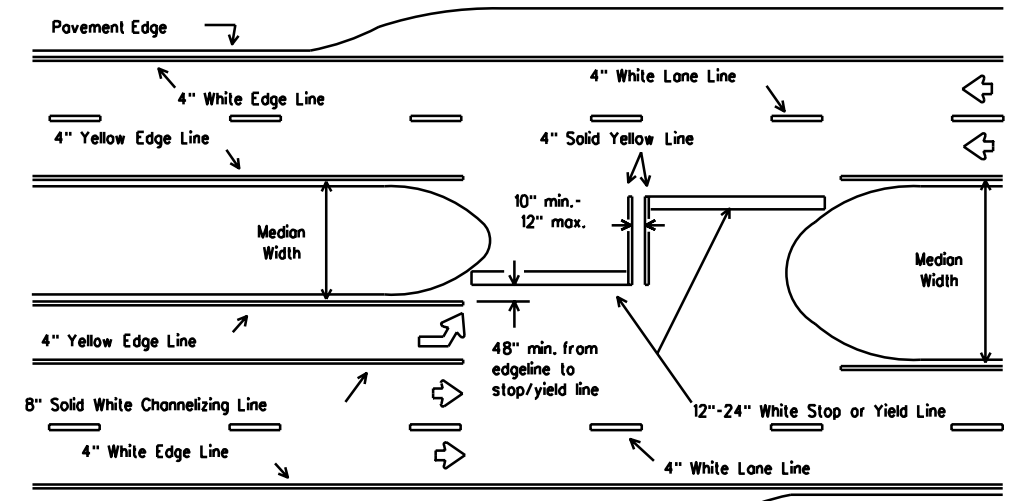

FOUR LANE DIVIDED ROADWAY INTERSECTIONS

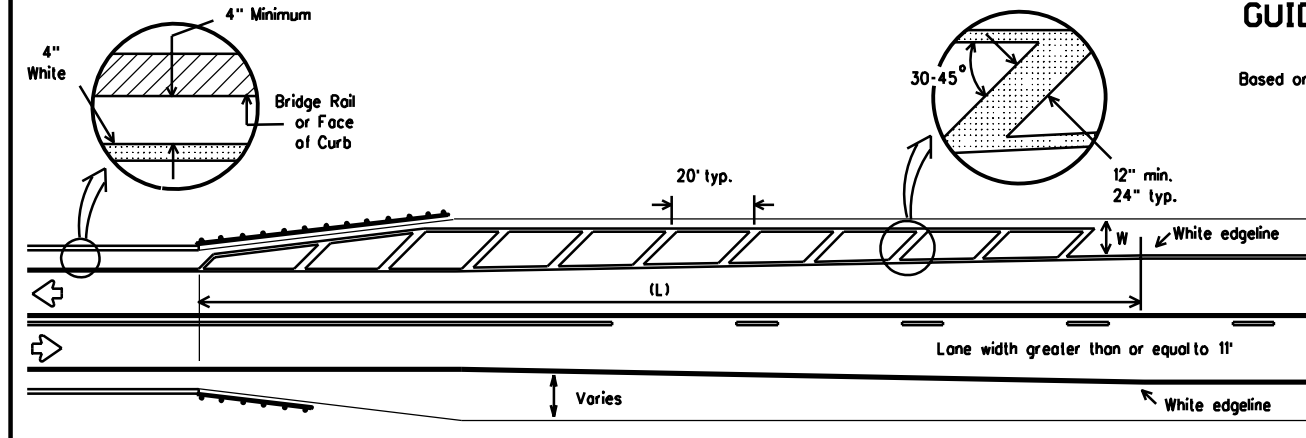

**ROADWAYS WITH REDUCED SHOULDER
WIDTHS ACROSS BRIDGE OR CULVERT**

TABLE 1 - TYPICAL LENGTH (L)

Posted Speed x	Formula
≤ 40	$L = \frac{WS^2}{60}$
≥ 45	$L = WS$

x 85th Percentile Speed may be used on roads where traffic speeds normally exceed the posted speed limit. Crosshatching length should be rounded up to nearest 5 foot increment.
L-Length of Crosshatching (FT.) W-Width of Offset (FT.)
S-Posted Speed (MPH)

EXAMPLES:


An 8 foot shoulder in advance of a bridge reduces to 4 feet on a 70 MPH roadway. The length of the cross-hatching should be:
 $L = 8 \times 70 = 560$ ft.
A 4 foot shoulder in advance of a bridge reduces to 2 feet on a 40 MPH roadway. The length of the cross-hatching should be:
 $L = 4(40) \div 60 = 106.67$ ft. rounded to 110 ft.

GENERAL NOTES

1. Edgeline striping shall be as shown in the plans or as directed by the Engineer. The edgeline should typically be placed a minimum of 6 inches from the edge of pavement. This distance may vary due to pavement raveling or other conditions. Edgelines are not required in curb and gutter sections of roadways.
2. The traveled way includes only that portion of the roadway used for vehicular travel and not the parking lanes, sidewalks, berms and shoulders. The traveled ways shall be measured from the inside of edgeline to inside of edgeline of a two lane roadway.

MATERIAL SPECIFICATIONS	
PAVEMENT MARKERS (REFLECTORIZED)	DMS-4200
EPOXY AND ADHESIVES	DMS-6100
BITUMINOUS ADHESIVE FOR PAVEMENT MARKERS	DMS-6130
TRAFFIC PAINT	DMS-8200
HOT APPLIED THERMOPLASTIC	DMS-8220
PERMANENT PREFABRICATED PAVEMENT MARKINGS	DMS-8240

All pavement marking materials shall meet the required Departmental Material Specifications as specified by the plans.

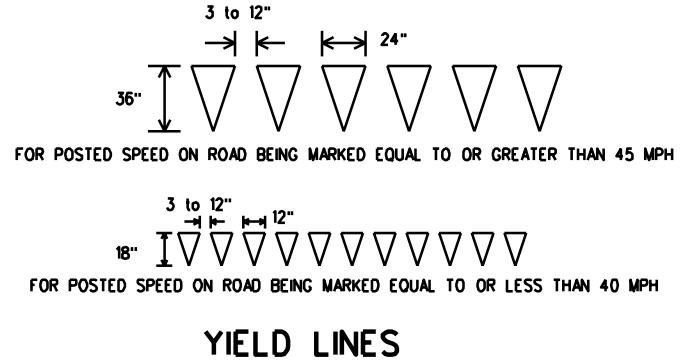

YIELD LINES

Texas Department of Transportation
Traffic Operations Division

**TYPICAL STANDARD
PAVEMENT MARKINGS**







PM(1)-12

© TxDOT November 1978	DN: TxDOT	CK: TxDOT	DW: TxDOT	CK: TxDOT
REVISIONS	CONT	SECT	JOB	HIGHWAY
8-95 2-12	---	---	---	---
5-00				
8-00	DIST		COUNTY	SHEET NO.
3-03	---		---	48

DATE: \$DATE\$
FILE: \$FILES\$

REFLECTIVE RAISED PAVEMENT MARKERS FOR VEHICLE POSITIONING GUIDANCE

DISCLAIMER: The use of this standard is governed by the "Texas Engineering Practice Act". No warranty of any kind is made by TxDOT for any purpose whatsoever. TxDOT assumes no responsibility for the conversion of this standard to other formats or for incorrect results or damages resulting from its use.

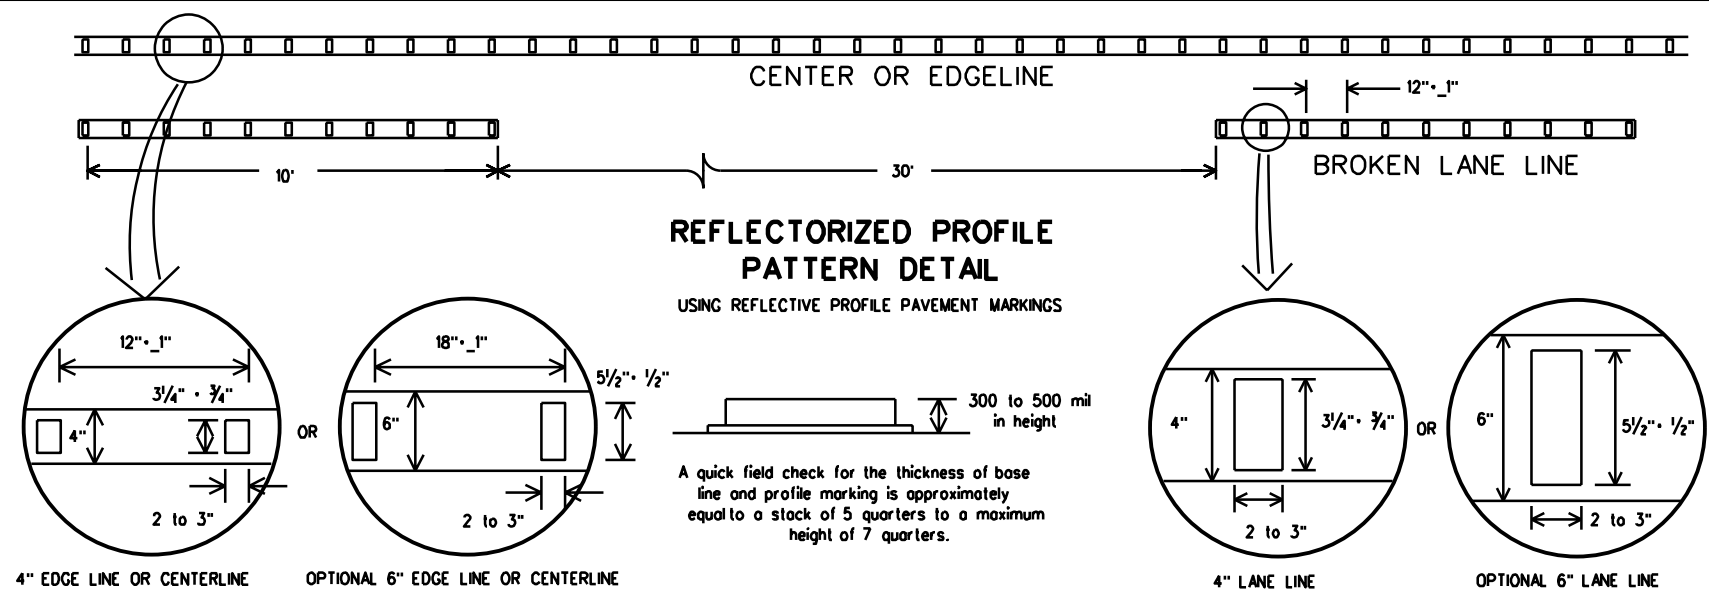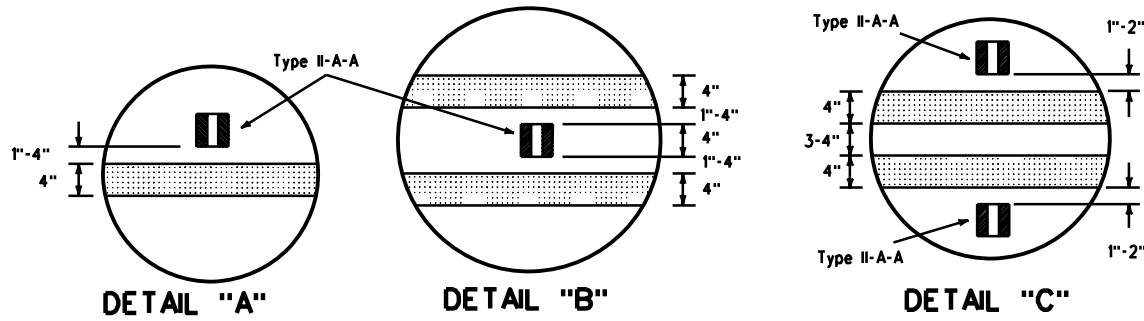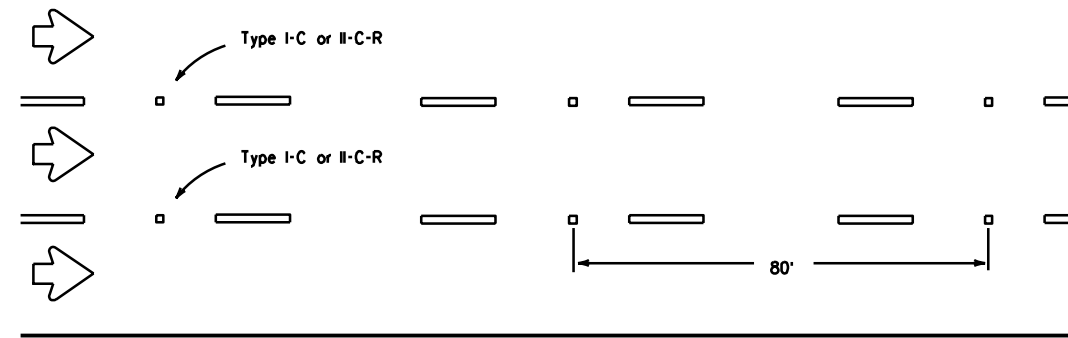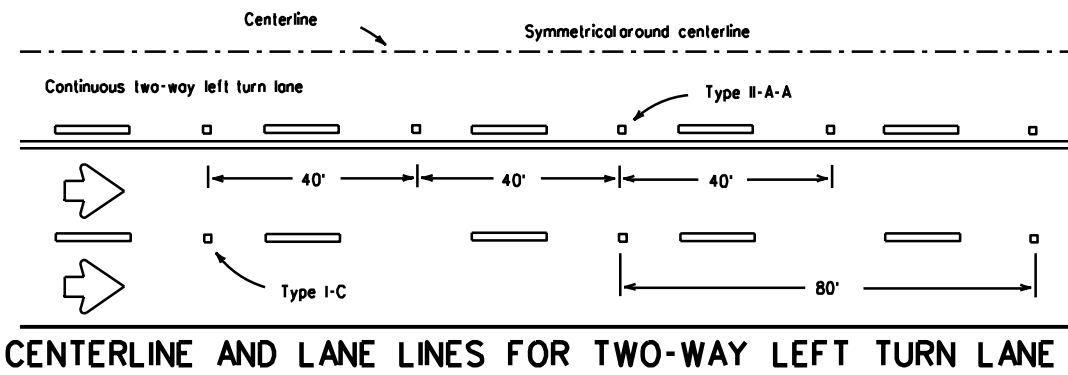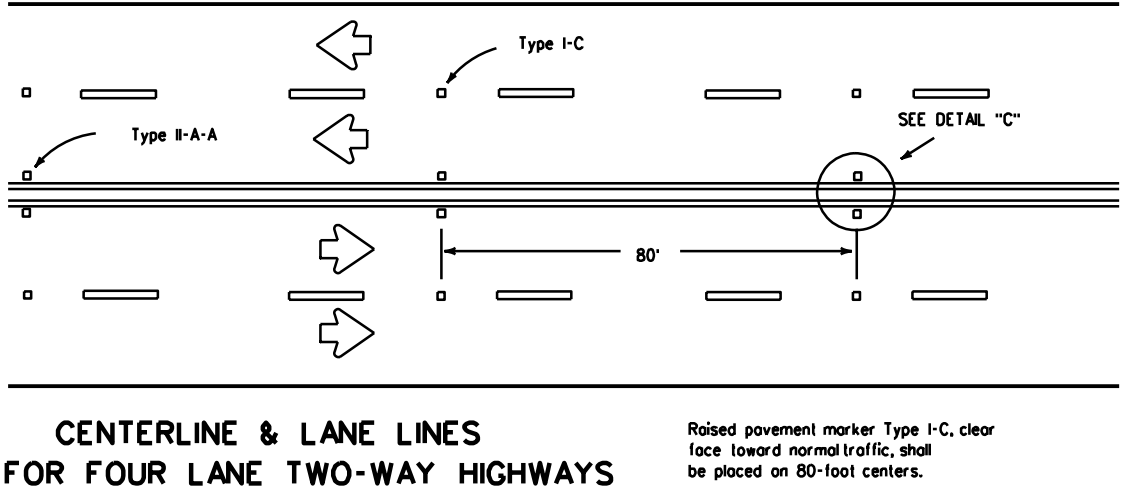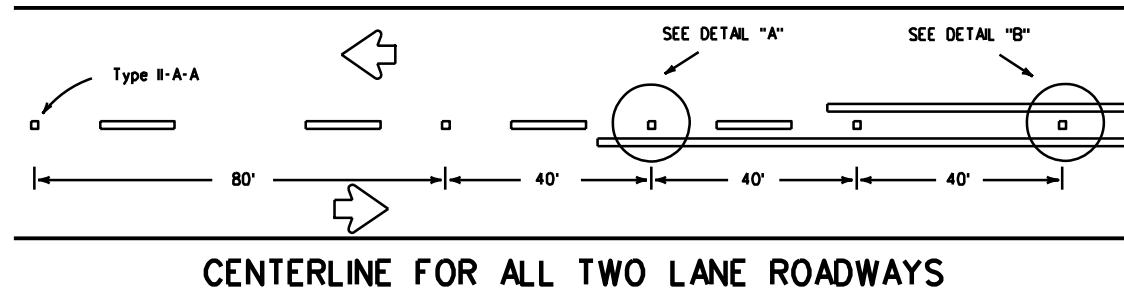




NOTE:
Profile markings shall not be placed on roadways with a posted speed limit of 45 MPH or less.

GENERAL NOTES

All raised pavement markers placed in broken lines shall be placed in line with and midway between the stripes.
On concrete pavements the raised pavement markers should be placed to one side of the longitudinal joints.

MATERIAL SPECIFICATIONS	
PAVEMENT MARKERS (REFLECTORIZED)	DMS-4200
EPOXY AND ADHESIVES	DMS-6100
BITUMINOUS ADHESIVE FOR PAVEMENT MARKERS	DMS-6130
TRAFFIC PAINT	DMS-8200
HOT APPLIED THERMOPLASTIC	DMS-8220
PERMANENT PREFABRICATED PAVEMENT MARKINGS	DMS-8240

All pavement marking materials shall meet the required Departmental Material Specifications as specified by the plans.

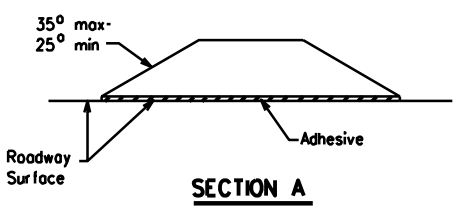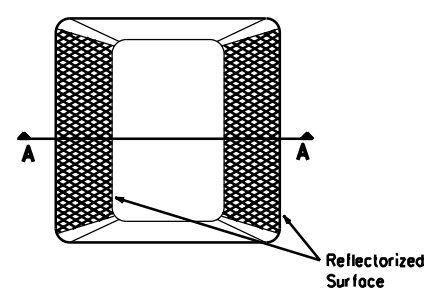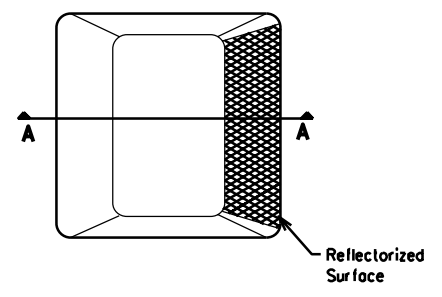

RAISED PAVEMENT MARKERS

Texas Department of Transportation
Traffic Operations Division

**POSITION GUIDANCE USING
RAISED MARKERS
REFLECTORIZED PROFILE
MARKINGS**


PM(2)-12

DATE: \$DATES\$
FILE: \$FILES\$


© TxDOT April 1977		DN: TxDOT	CK: TxDOT	DW: TxDOT	CK: TxDOT
REVISIONS		CONT	SECT	JOB	HIGHWAY
4-92	2-10	---	---	---	---
5-00	2-12	---	---	---	---
8-00		DIST	COUNTY		SHEET NO.
2-08		---	---		49

DISCLAIMER: The use of this standard is governed by the "Texas Engineering Practice Act". No warranty of any kind is made by TxDOT for any purpose whatsoever. TxDOT assumes no responsibility for the conversion of this standard to other formats or for incorrect results or damages resulting from its use.


DATE: FILE:

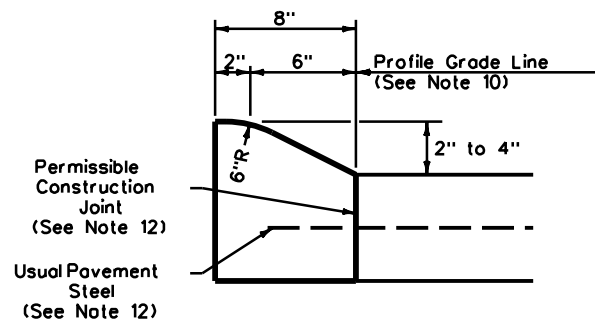


**TYPE I CURB (MONOLITHIC)
2" - 4" HEIGHT**

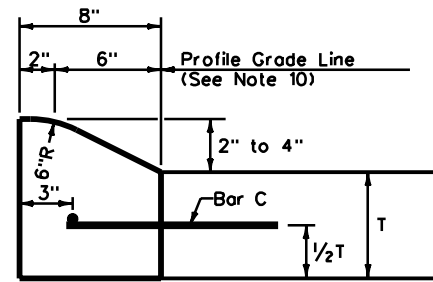


**TYPE I CURB AND GUTTER
2" - 4" HEIGHT**

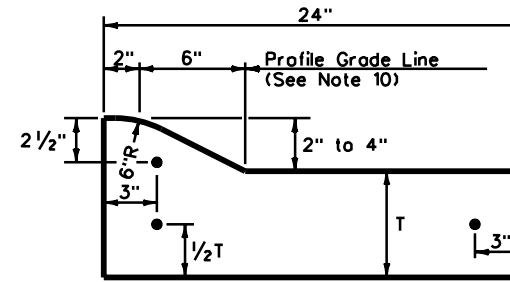


**TYPE II CURB (MONOLITHIC)
5" - 5 3/4" HEIGHT**

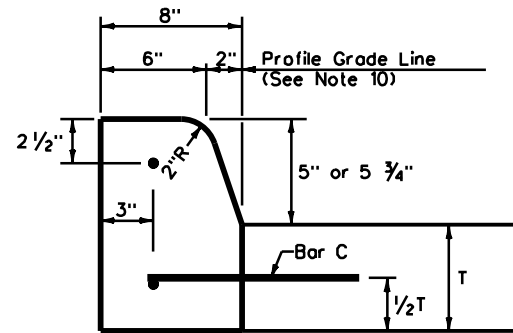


**TYPE II CURB AND GUTTER
5" - 5 3/4" HEIGHT**

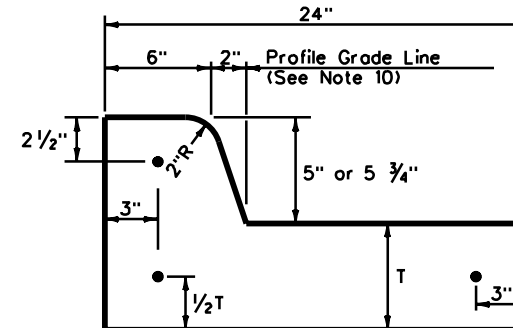


**TYPE III CURB (KEYED)
2" - 4" HEIGHT**

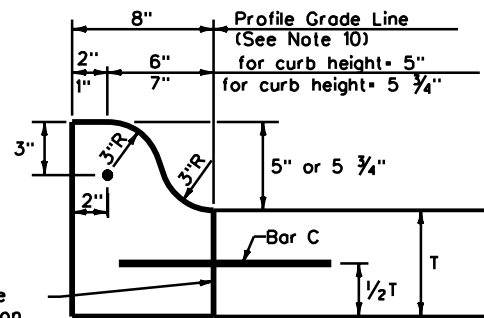


**TYPE IIIa CURB
5" - 5 3/4" HEIGHT**

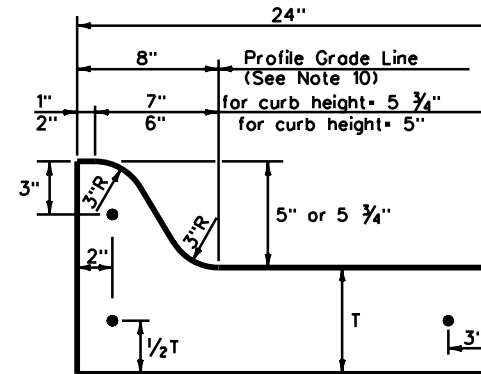


**TYPE IIIa CURB AND GUTTER
5" - 5 3/4" HEIGHT**

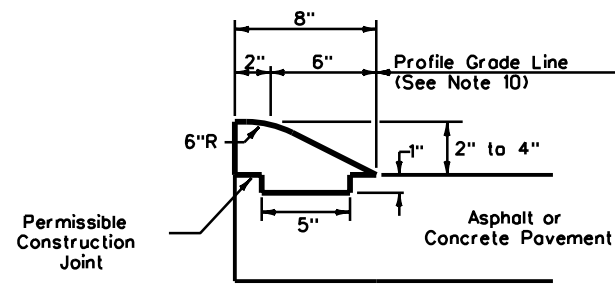


**TYPE IV CURB (KEYED)
5" - 5 3/4" HEIGHT**

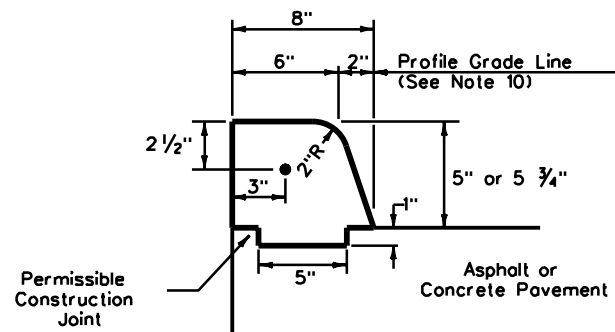

**TYPE IV CURB AND GUTTER
5" - 5 3/4" HEIGHT**

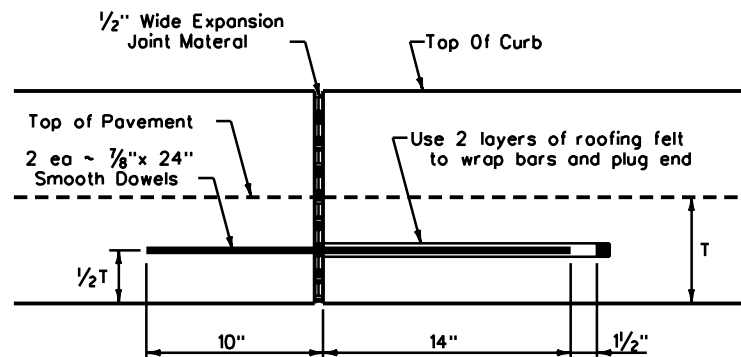


EXPANSION JOINT DETAIL

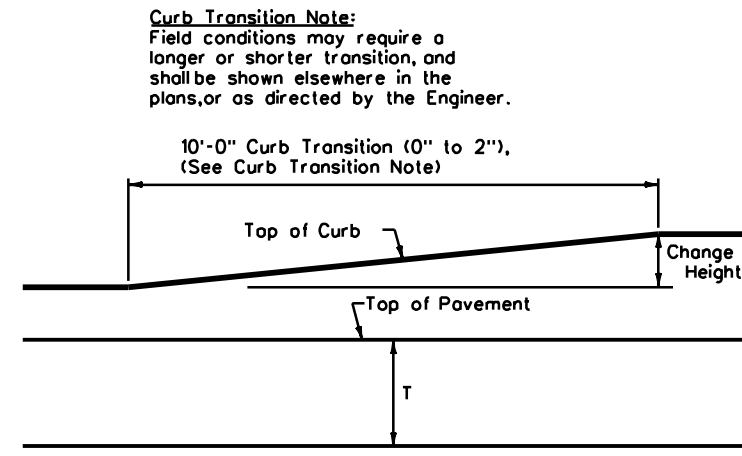

CURB TRANSITION
Note: To be paid for as Highest Curb

General Notes

- All materials and construction shall be in accordance with Item 529, "Concrete Curb, Gutter, and Combined Curb and Gutter."
- Concrete shall be Class A.
- When reinforcing bars are used, they shall be No.4 unless otherwise shown. The use of synthetic fiber in lieu of steel reinforcing is acceptable, provided the fiber producer is on the Department Producer List (MPL), maintained by TxDOT, Construction Division.
- Round exposed sharp edges with a rounding tool, to a minimum radius of 1/4 inch.
- All existing curbs and driveways to be removed shall be sawed or removed at existing joints.
- Where concrete curb is placed on existing concrete pavement, the pavement shall be drilled and the reinforcing bars grouted in place.
- Expansion and contraction joints shall be constructed to match pavement joints in all curbs and curb and gutter adjacent to jointed concrete pavement. Where placement of curb or curb and gutter is not adjacent to concrete pavement, expansion joints shall be provided at structures, curb returns at streets, and at locations directed by The Engineer.
- Vertical and horizontal dowel bars and transverse reinforcing bars shall be placed at four feet C-C.
- Dimension 'T' shown is the thickness of concrete pavement. When curb is installed adjacent to flexible pavement dimension 'T' is 8" maximum.
- Usual profile grade line. Refer to typical sections and plan-profile sheets for exact locations.
- One-half inch expansion joint material shall be provided where curb or curb and gutter is adjacent to sidewalk or riprap.
- When vertical permissible construction joints are used, resulting in a longitudinal construction joint in the pavement, the longitudinal pavement steel shall be placed in accordance with pavement details shown elsewhere in the plans for longitudinal construction joints. Reinforcing steel for curb section shall then conform to that required for concrete curb.

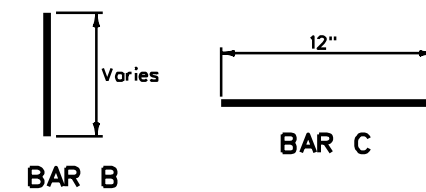


Curb Transition Note:
Field conditions may require a longer or shorter transition, and shall be shown elsewhere in the plans, or as directed by the Engineer.


		Design Division Standard	
<h2>CONCRETE CURB AND GUTTER</h2> <h3>CCCG-12</h3>			
FILE: cccg12	DN: TxDOT	CK: AM	DW: VP
© TxDOT 1995	CONT: ...	SECT: ...	JOB: ...
REVISIONS	DIST: ...	COUNTY: ...	SHEET NO. 50

DISCLAIMER: The use of this standard is governed by the "Texas Engineering Practice Act". No warranty of any kind is made by TxDOT for any purpose whatsoever. TxDOT assumes no responsibility for the conversion of this standard to other formats or for incorrect results or damages resulting from its use.

DATE: \$DATE\$
 FILE: \$FILE\$
 \$TIME\$

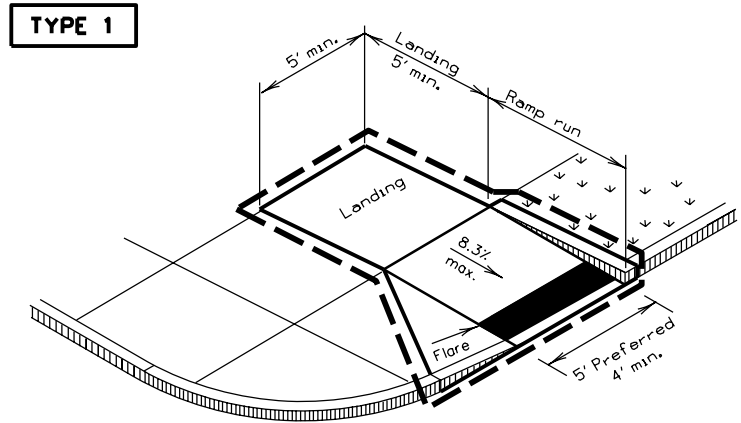


PERPENDICULAR CURB RAMP

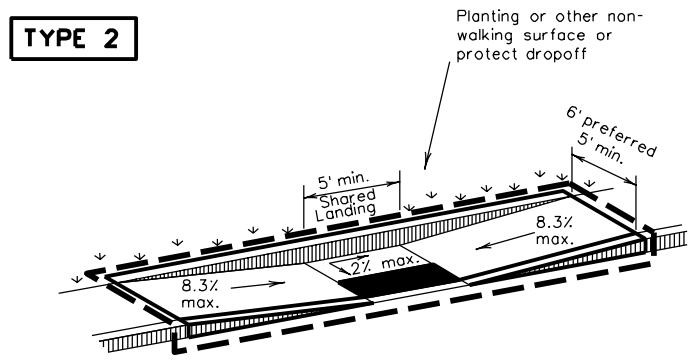


PARALLEL CURB RAMP

(Use only where water will not pond in the landing.)

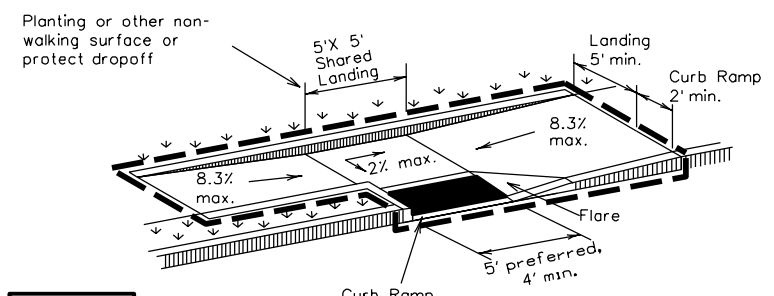


TYPE 3

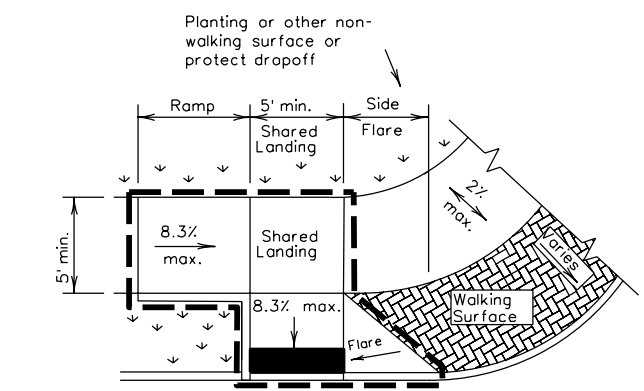


TYPE 6

COMBINATION CURB RAMPS

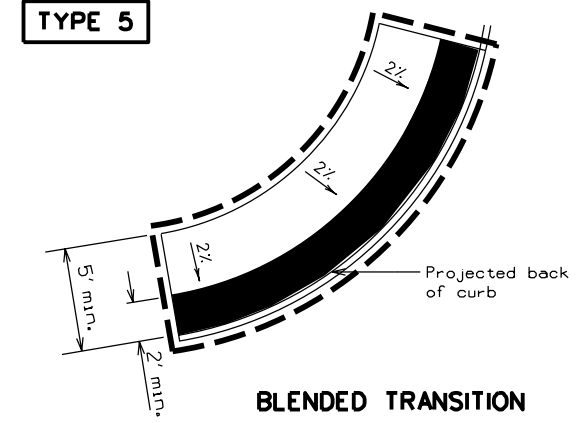


BLENDED TRANSITION

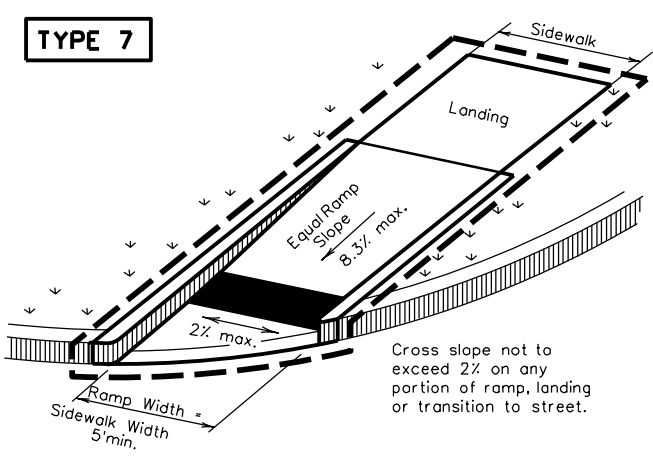


(Sidewalk set back from curb)

DIRECTIONAL RAMPS WITHIN RADIUS

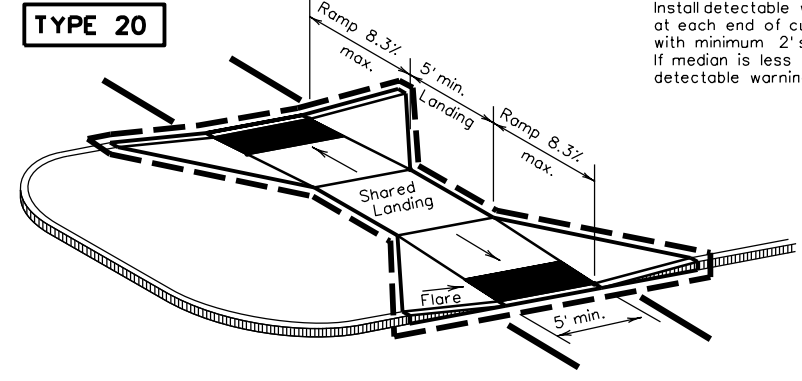


CURB RAMPS AT MEDIAN ISLANDS

Install detectable warning surface at each end of cut-through ramp with minimum 2' smooth surface between. If median is less than 6' wide, eliminate detectable warning surfaces.

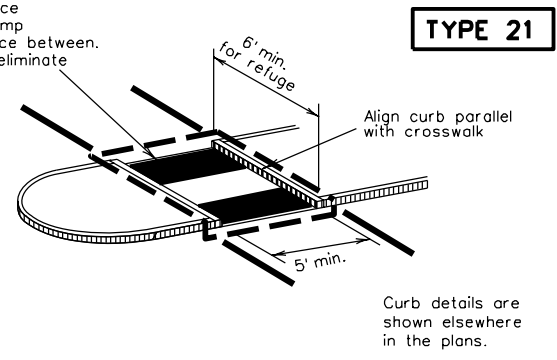


TYPE 21

Align curb parallel with crosswalk. Curb details are shown elsewhere in the plans.

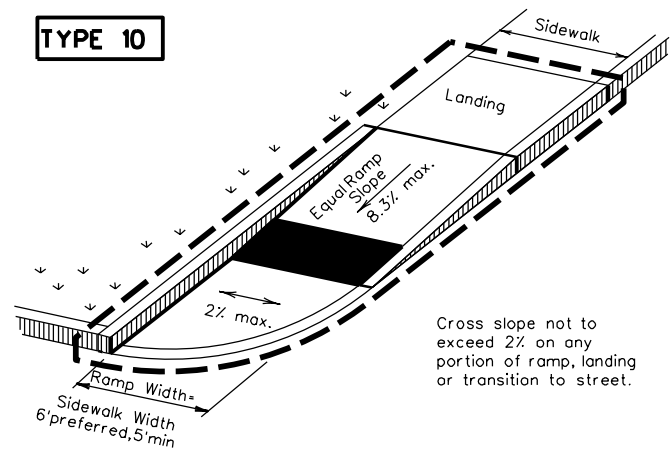


(Sidewalk adjacent to curb)

Cross slope not to exceed 2% on any portion of ramp, landing or transition to street.

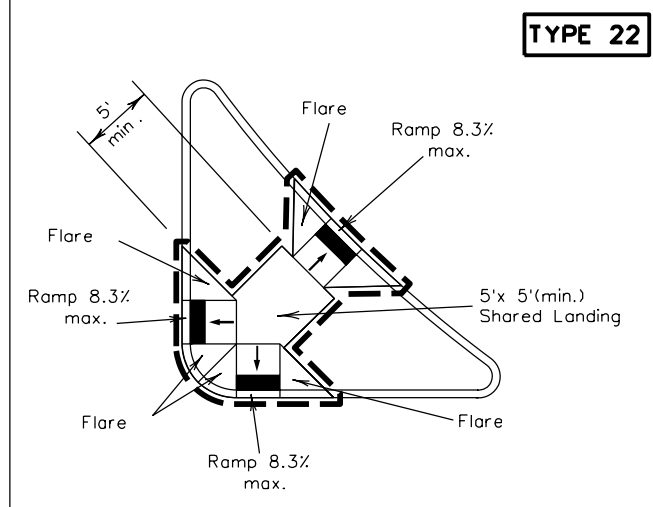

TYPE 22

COMBINATION ISLAND RAMPS

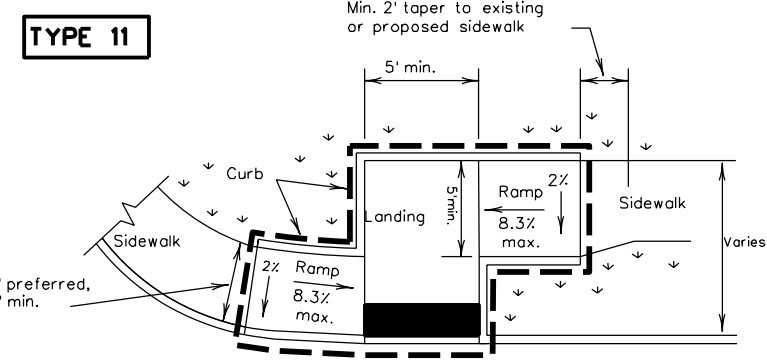

OFFSET PARALLEL CURB RAMP

NOTES / LEGEND:

See General Notes on sheet 2 of 4 for more information.

- ∨ ∨ ∨ Denotes planting or non-walking surface not part of pedestrian circulation path.

- Ramp Limits of Payment
- Detectable Warning Surface

**PEDESTRIAN FACILITIES
 CURB RAMPS**

PED-12A

FILE: ped12a.dgn	DN: TxDOT	CK: PK	DW: TxDOT	CK: HD
© TxDOT March 2002	CONT	SECT	JOB	HIGHWAY
REVISIONS
VP June 13, 2012	DIST	COUNTY	SHEET NO.	
	51	


General Notes

Curb Ramps


1. Install a curb ramp or blended transition at each pedestrian street crossing.
2. All slopes shown are maximum allowable. Lesser slopes that will still drain properly should be used. Adjust curb ramp length or grade of approach sidewalks as directed.
3. The minimum sidewalk width is 5'. Where the sidewalk is adjacent to the back of curb, a 6' sidewalk width is desirable. Where a 5' sidewalk cannot be provided due to site constraints, sidewalk width may be reduced to 4' for short distances. 5' x 5' passing areas at intervals not to exceed 200' are required.
4. Landings shall be 5' x 5' minimum with a maximum 2% slope in any direction.
5. Maneuvering space at the bottom of curb ramps shall be a minimum of 4' x 4' wholly contained within the crosswalk and wholly outside the parallel vehicular travel path.
6. Maximum allowable cross slope on sidewalk and curb ramp surfaces is 2%.
7. Provide flared sides where the pedestrian circulation path crosses the curb ramp. Flared sides shall be sloped at 10% maximum, measured parallel to the curb. Returned curbs may be used only where pedestrians would not normally walk across the ramp, either because the adjacent surface is planted, substantially obstructed, or otherwise protected.
8. Additional information on curb ramp location, design, light reflective value and texture may be found in the current edition of the Texas Accessibility Standards (TAS) and 16 TAC 68.102.
9. To serve as a pedestrian refuge area, the median should be a minimum of 6' wide, measured from back of curbs. Medians should be designed to provide accessible passage over or through them.
10. Small channelization islands, which do not provide a minimum 5' x 5' landing at the top of curb ramps, shall be cut through level with the surface of the street.
11. Crosswalk dimensions, crosswalk markings and stop bar locations shall be as shown elsewhere in the plans. At intersections where crosswalk markings are not required, curb ramps shall align with theoretical crosswalks unless otherwise directed.
12. Handrails are not required on curb ramps. Provide curb ramps wherever on accessible route crosses (penetrates) a curb.
13. Curb ramps and landings shall be constructed and paid for in accordance with Item 531 "Sidewalks".
14. Place concrete at a minimum depth of 5" for ramps, flares and landings, unless otherwise directed.
15. Provide a smooth transition where the curb ramps connect to the street.
16. Curbs shown on sheet 1 within the limits of payment are considered part of the curb ramp for payment, whether it is concrete curb, gutter, or combined curb and gutter.
17. Existing features that comply with TAS may remain in place unless otherwise shown on the plans.

Detectable Warning Material


18. Curb ramps must contain a detectable warning surface that consists of raised truncated domes complying with Section 705 of the TAS. The surface must contrast visually with adjoining surfaces, including side flares. Furnish and install an approved cast-in-place dark brown or dark red detectable warning surface material adjacent to uncolored concrete, unless specified elsewhere in the plans.
19. Detectable Warning Materials must meet TxDOT Departmental Materials Specification DMS 4350 and be listed on the Material Producer List. Install products in accordance with manufacturer's specifications.
20. Detectable warning surfaces must be slip resistant and not allow water to accumulate.
21. Detectable warning surfaces shall be a minimum of 24" in depth in the direction of pedestrian travel, and extend the full width of the curb ramp or landing where the pedestrian access route enters the street.
22. Detectable warning surfaces shall be located so that the edge nearest the curb line is at the back of curb. Align the rows of domes to be perpendicular to the grade break between the ramp run and the street. Detectable warning surfaces may be curved along the corner radius.
23. Shaded areas on Sheet 1 of 4 indicate the approximate location for the detectable warning surface for each curb ramp type.

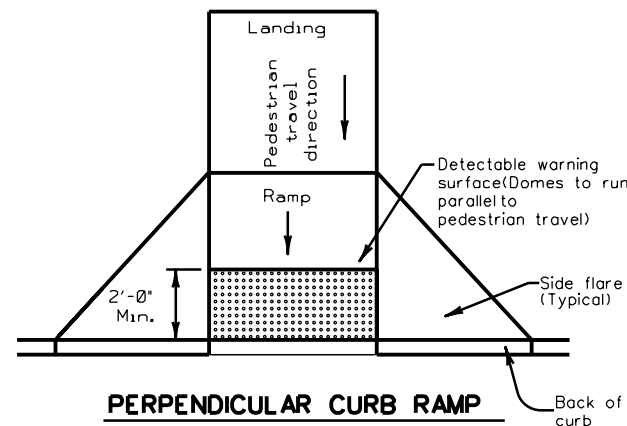


Typical placement of detectable warning surface on sloping ramp run.

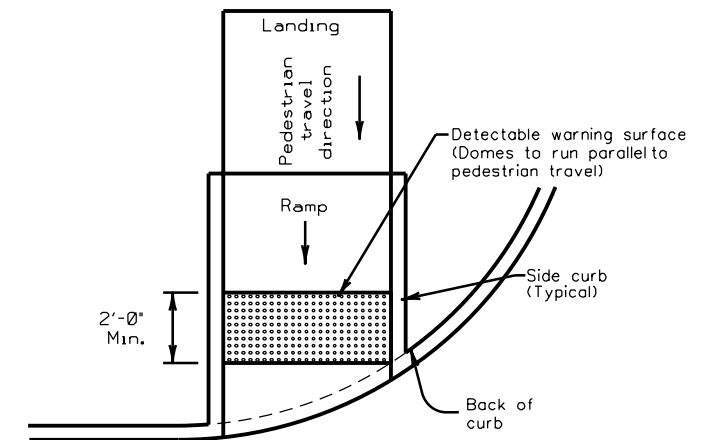

Typical placement of detectable warning surface on sloping ramp run.

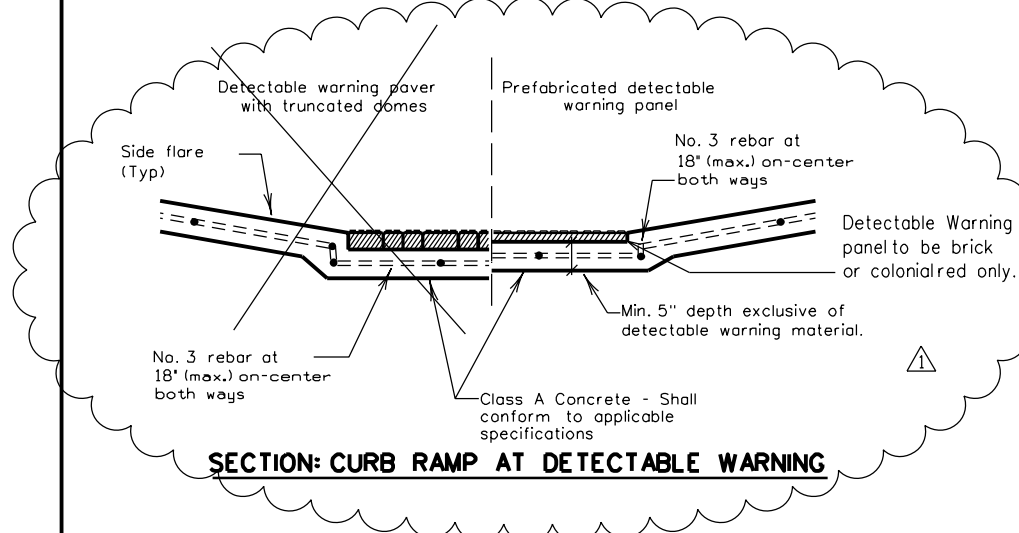

DETECTABLE WARNINGS

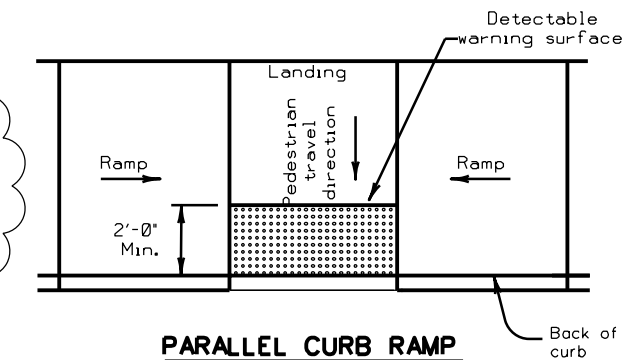

Typical placement of detectable warning surface on landing at street edge.

Detectable Warning Pavers

24. Furnish detectable warning paver units meeting all requirements of ASTM C-936, C-33. Lay in a two by two unit basket weave pattern or as directed.
25. Lay full-size units first followed by closure units consisting of at least 25 percent of a full unit. Cut detectable warning paver units using a power saw.

Sidewalks

26. Provide clear ground space at operable parts, including pedestrian push buttons. Operable parts shall be placed within one or more reach ranges specified in TAS 308.
27. Place traffic signal or illumination poles, ground boxes, controller boxes, signs, drainage facilities and other items so as not to obstruct the pedestrian access route or clear ground space.
28. Street grades and cross slopes shall be as shown elsewhere in the plans.
29. Changes in level greater than 1/4 inch are not permitted.
30. The least possible grade should be used to maximize accessibility. The running slope of sidewalks and crosswalks within the public right of way may follow the grade of the parallel roadway. Where a continuous grade greater than 5% must be provided, handrails may be desirable to improve accessibility. Handrails may also be needed to protect pedestrians from potentially hazardous conditions. If provided, handrails shall comply with TAS 505.
31. Handrail extensions shall not protrude into the usable landing area or into intersecting pedestrian routes.
32. Driveways and turnouts shall be constructed and paid for in accordance with Item "Intersections, Driveways and Turnouts". Sidewalks shall be constructed and paid for in accordance with Item, "Sidewalks".
33. Sidewalk details are shown elsewhere in the plans.

RECORD DRAWINGS

THESE RECORD DRAWINGS HAVE BEEN PREPARED TO REFLECT ANY CHANGES AND/OR MODIFICATIONS MADE TO THE DESIGN PLANS, PROVIDED BY THE CONTRACTOR AND THE CITY INSPECTOR. UNLESS OTHERWISE NOTED, THE PROJECT HAS BEEN CONSTRUCTED IN SUBSTANTIAL CONFORMANCE WITH THE DESIGN DRAWINGS. THE ENGINEERING CONSULTANT IS NOT RESPONSIBLE FOR ACCURACY AND COMPLETENESS EXCEPT FOR WHAT WAS PROVIDED BY THE CONTRACTOR. THE PLAN SET USED FOR BIDDING ORIGINALLY SEALED 5/4/2016 AND REVISED 8/8/2016.

Thomas P. Grant, P.E. 2/20/2017
SIGNATURE DATE

THOMAS P. GRANT, P.E., KIMLEY-HORN AND ASSOCIATES, INC.

SHEET 2 OF 4



**PEDESTRIAN FACILITIES
CURB RAMPS**


PED-12A

FILE: ped12a.dgn	DN: TxDOT	CK: PK	DW: TxDOT	CK: HD
© TxDOT March 2002	CONT	SECT	JOB	HIGHWAY
REVISIONS
VP June 13, 2012	DIST	COUNTY	SHEET NO.	
	52	


DISCLAIMER: The use of this standard is governed by the "Texas Engineering Practice Act". No warranty of any kind is made by TxDOT for any purpose whatsoever. TxDOT assumes no responsibility for the conversion of this standard to other formats or for incorrect results or damages resulting from its use.

\$TIME\$
\$DATE\$
\$FILE\$


DISCLAIMER: The use of this standard is governed by the "Texas Engineering Practice Act". No warranty of any kind is made by TxDOT for any purpose whatsoever. TxDOT assumes no responsibility for the conversion of this standard to other formats or for incorrect results or damages resulting from its use.

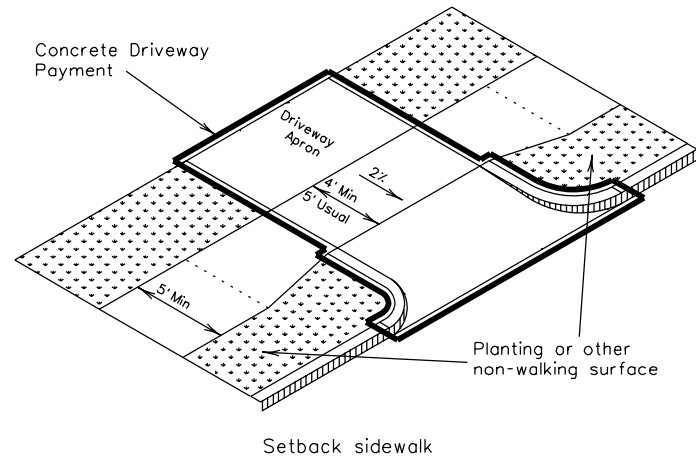


Setback sidewalk

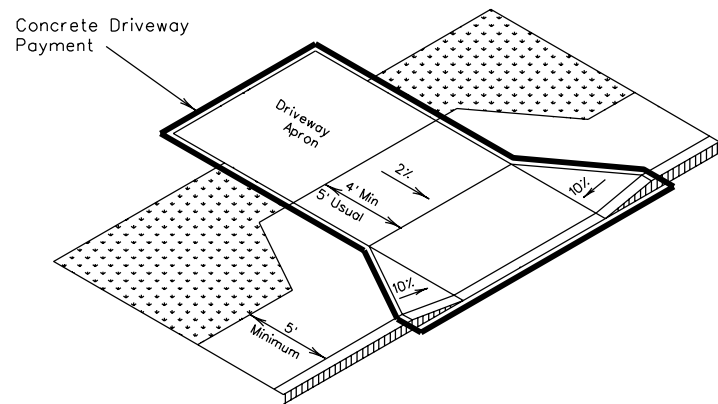

Apron offset sidewalk

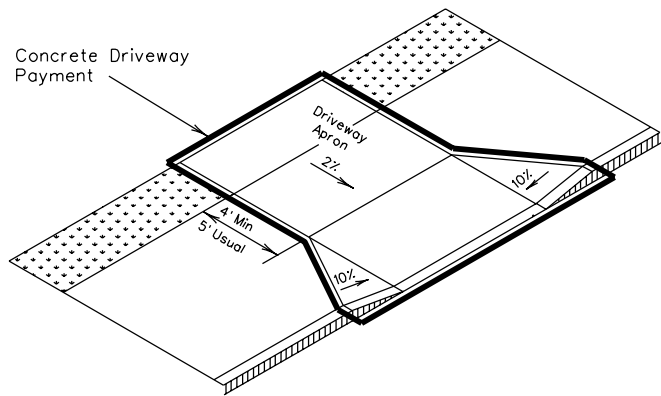


Wide sidewalk

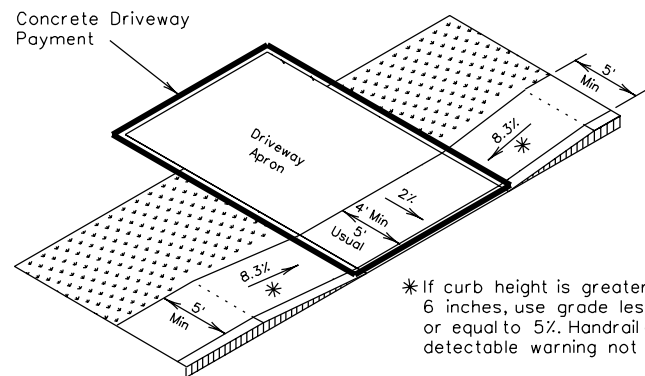

* If curb height is greater than 6 inches, use grade less than or equal to 5%. Handrail and detectable warning not required.


Ramp sidewalk

SIDEWALK TREATMENT AT DRIVEWAYS

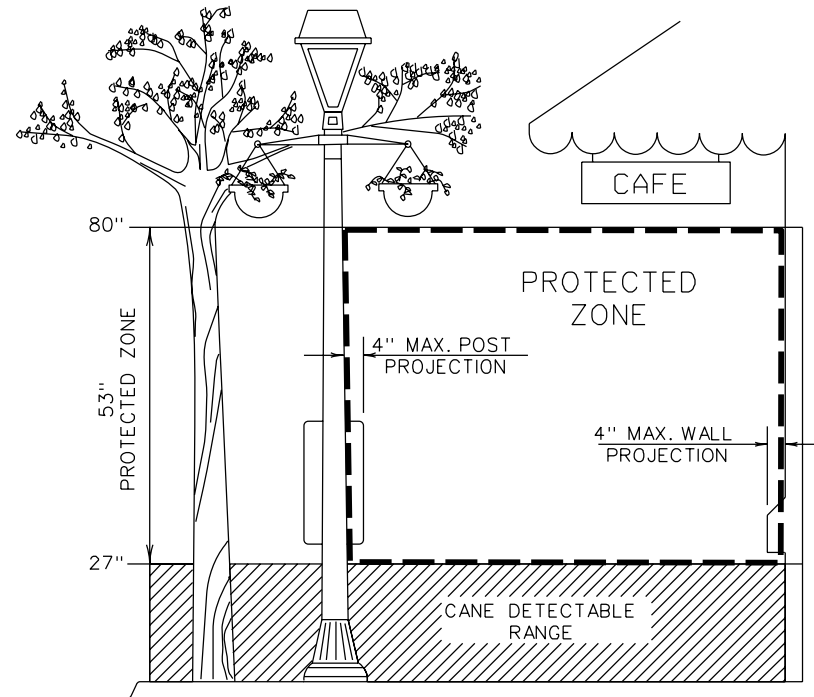


PROTECTED ZONE

In pedestrian circulation area, maximum 4" projection for post or wall mounted objects between 27" and 80" above the surface.

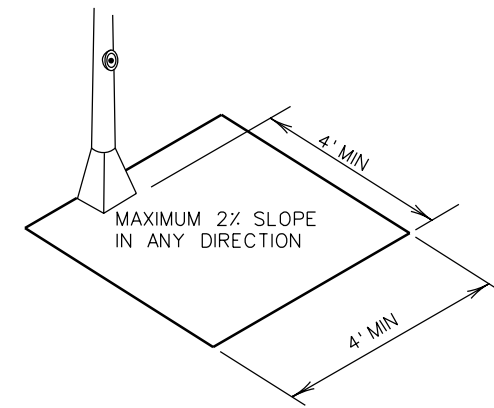


CLEAR GROUND SPACE ADJACENT TO PEDESTRIAN PUSH BUTTON

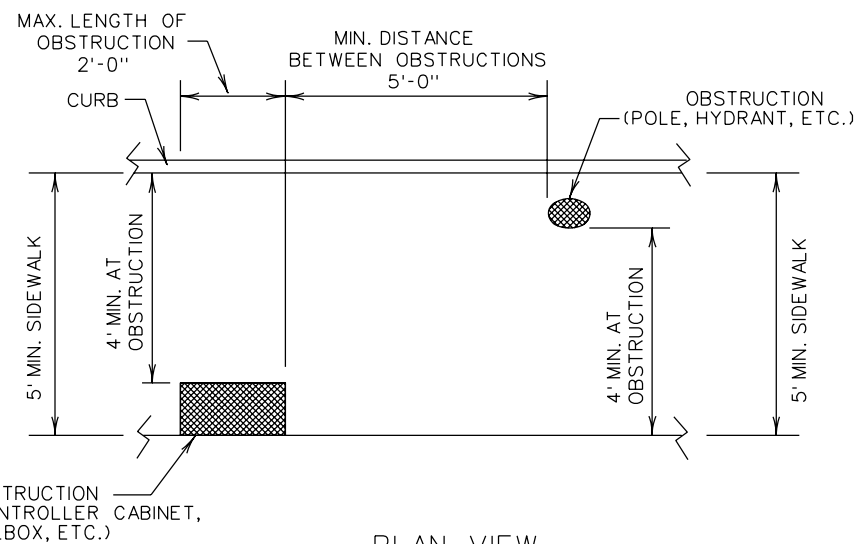


**PLAN VIEW
PLACEMENT OF STREET FIXTURES**

(ITEMS NOT INTENDED FOR PUBLIC USE. MINIMUM 4' x 4' CLEAR GROUND SPACE REQUIRED AT PUBLIC USE FIXTURES.)

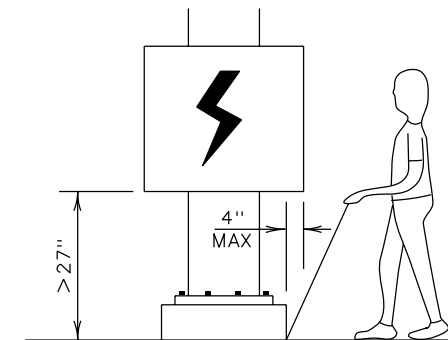

When an obstruction of a height greater than 27" from the surface would create a protrusion of more than 4" into the pedestrian circulation area, construct additional curb or foundation at the bottom to provide a maximum 4" overhang.

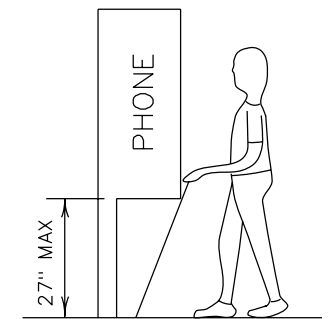

Protruding objects of a height 27" are detectable by cane and do not require additional treatment.

DETECTION BARRIER FOR VERTICAL CLEARANCE > 80"

SHEET 3 OF 4

Texas Department of Transportation
Design Division Standard


**PEDESTRIAN FACILITIES
CURB RAMPS**

PED-12A


FILE: ped12a.dgn	DN: TxDOT	CK: PK	DW: TxDOT	CK: HD
©TxDOT March 2002	CONT	SECT	JOB	HIGHWAY
REVISIONS	---	---	---	---
VP June 13, 2012	DIST	COUNTY	SHEET NO.	
	---	---	53	

DATE: \$DATE\$
FILE: \$FILE\$
\$TIME\$


DISCLAIMER: The use of this standard is governed by the "Texas Engineering Practice Act". No warranty of any kind is made by TxDOT for any purpose whatsoever. TxDOT assumes no responsibility for the conversion of this standard to other formats or for incorrect results or damages resulting from its use.

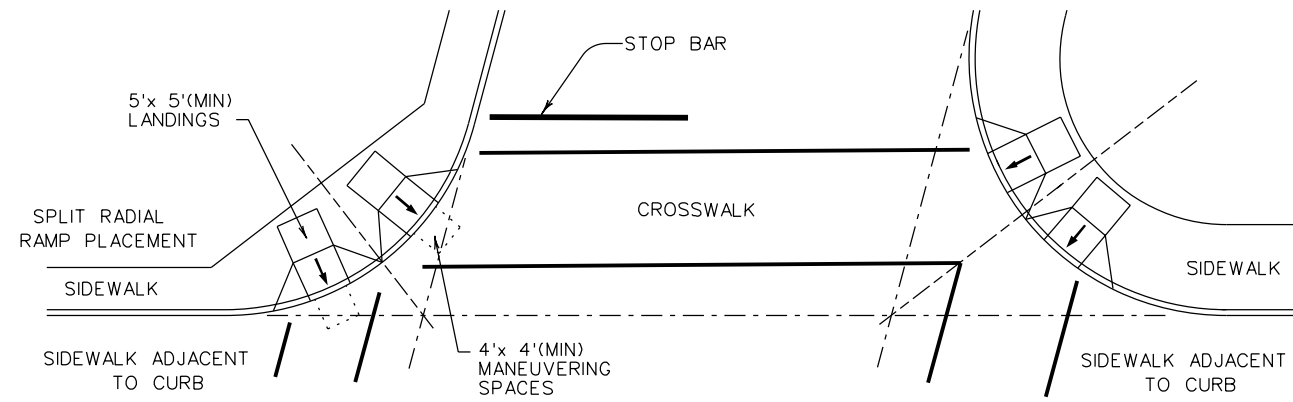


SKewed INTERSECTION WITH "LARGE" RADIUS

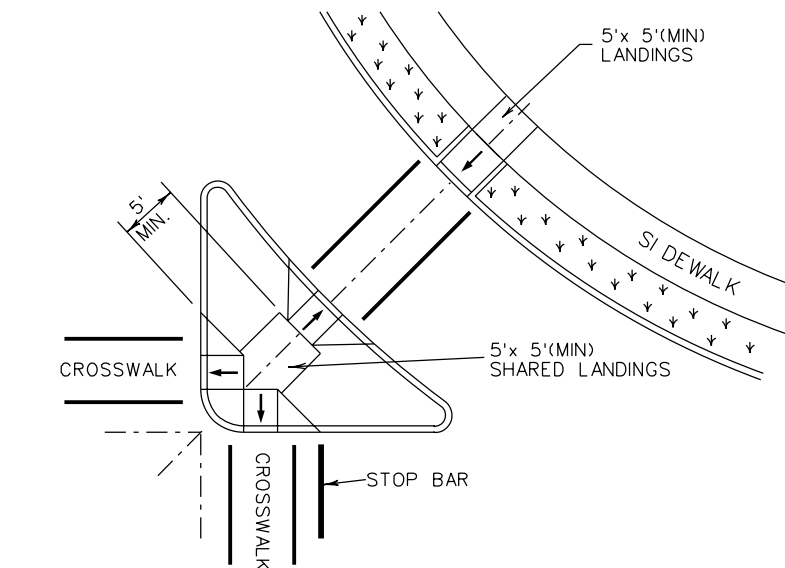


AT INTERSECTION W/FREE RIGHT TURN & ISLAND

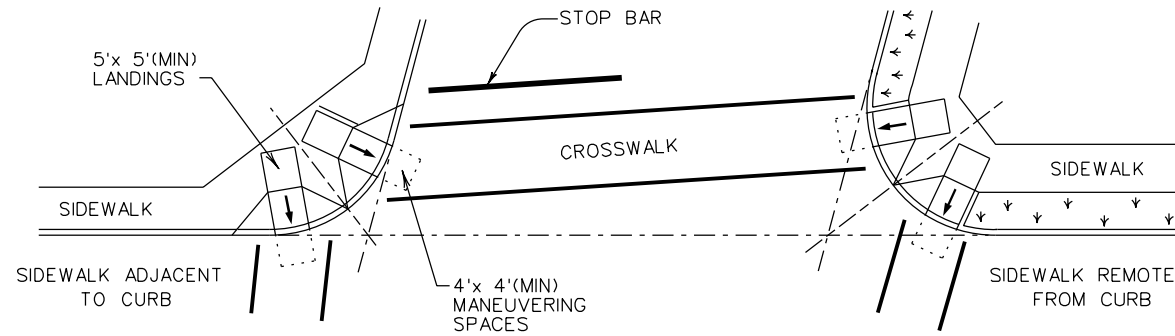

SKewed INTERSECTION WITH "SMALL" RADIUS

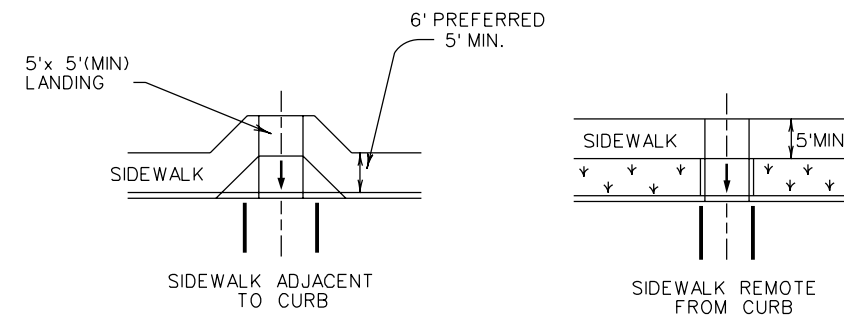

MID-BLOCK PLACEMENT PERPENDICULAR RAMPs

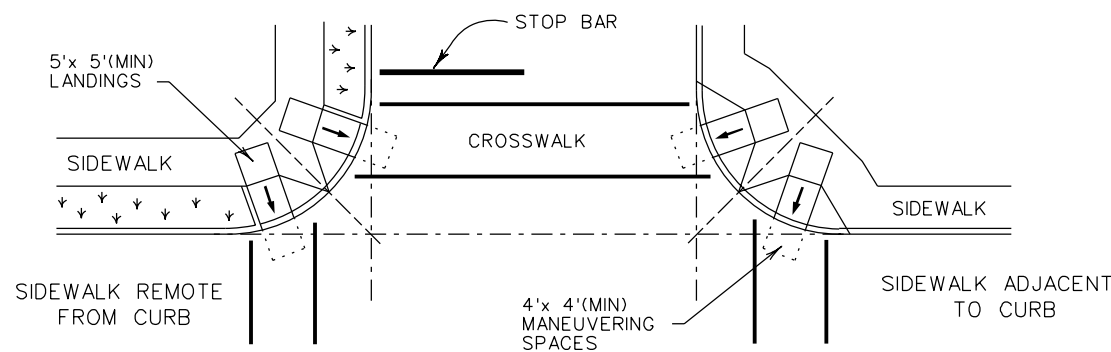

NORMAL INTERSECTION WITH "SMALL" RADIUS

TYPICAL CROSSING LAYOUTS

SHEET 4 OF 4



PEDESTRIAN FACILITIES CURB RAMPS

PED-12A

FILE: ped12a.dgn	DN: TxDOT	CK: PK	DW: TxDOT	CK: HD
© TxDOT March 2002	CONT	SECT	JOB	HIGHWAY
REVISIONS
VP June 13, 2012	DIST	COUNTY	SHEET NO.	
	54	

DATE: \$DATE\$
FILE: \$FILE\$
\$TIME\$