


JT. 10' N OF N END PARAPET

EAST SIDE VILLAGE DR.
@ N. END APPROACH SLAB
STA 0+20.00

5' N. OF N END PARAPET
STA 0+14.86

N. END PARAPET
STA 0+09.86

S. END PARAPET (19.8' S OF JT)
STA -0+1.42

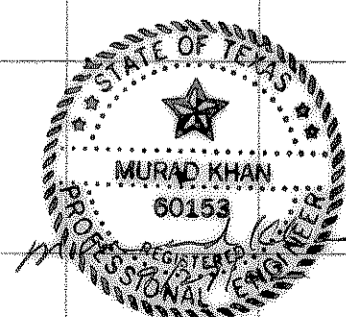

NO.	REVISION	BY	DATE
CITY OF ROCKWALL, TEXAS			
ENGINEERING DEPARTMENT			
CROSS SECTIONS			
VILLAGE DRIVE			
BETWEEN MARINA DR & INTERSTATE 30			
BRIDGE APPROACH PAVING REPAIR			
MK ENGINEERS			
CONSULTING ENGINEERS, SURVEYOR, & PLANNERS			
2734 W KINGSLEY, SUITE K-2			
GARLAND, TEXAS 75041 972/ 271-4987			
DESIGNED- MK	DRAWN- DT	DATE- MARCH, 1999	FILE- C:\PROJECTS\BRIDGE\
APPROVED-	CHECKED-MK	SCALE- 1"=6'	SHEET- 9 OF 9