

STA. 0400
CONNECT TO EXISTING
8" WATER LINE
INSTALL
1 - 8" x 8" TAPPING
SLEEVE AND VALV.

STA. 0425
INSTALL
1 - 8" 1 1/4" BEND

STA. 2485
CONNECT TO EXISTING
6" WATER LINE
INSTALL
1 - 8" x 6" TEE
1 - 6" x 6" TEE
1 - 6" SLEEVE
1 - 6" 90 BEND
1 - 5" GATE VALVE

STA. 5477.5
CONNECT TO EXISTING
8" WATER LINE
INSTALL
1 - 8" x 8" CROSS
1 - 8" x 6" TEE
1 - 8" x 6" REDUCER
1 - 6" 90 BEND
1 - 6" SLEEVE
1 - 8" PLUG
1 - 6" GATE VALVE

STA. 7476
CONNECT TO EXISTING 6"
WATER LINE
INSTALL
8" x 8" CROSS
1 - 8" PLUG
1 - 8" GATE VALVE

STA. 0400
CONNECT TO EXISTING
6" WATER LINE
REMOVE EXISTING 6" PLUG
INSTALL
1 - 6" x 6" TEE
1 - 6" PLUG
1 - 6" GATE VALVE
2 - 6" 45° BENDS

STA. 3476
INSTALL
1 - 6" x 6" TEE
1 - 8" 1/2" BEND
1 - 6" PLUG

STA. 6457
INSTALL
1 - 6" x 6" CROSS
2 - 6" PLUGS
1 - 6" GATE VALVE
1 - STD. FIRE HYD.

1 - 6" GATE VALVE
1 - 6" TEE
2 - 6" PLUGS

Check Valves

Check Valves

Missing Valves


Check Valves

Check Valves

Check Valve

Check Valves

NOTE: SERVICE CONNECTIONS TO BE LOCATED IN THE FIELD BY THE ENGINEER.

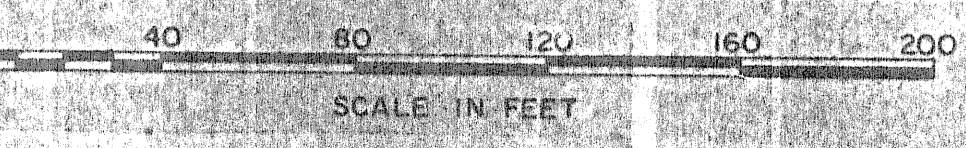

CITY OF ROCKWALL, TEXAS
ADDITIONS TO WATER DISTRIBUTION SYSTEM
WATER MAIN IN LILLIAN ST AND
KERNODLE ST. AND IN BOURN
AND ALAMO ST.

FORREST AND COTTON, INC. CONSULTING ENGINEERS DALLAS, TEXAS DECEMBER, 1961

FILE NO.	DESIGNED BY	DRAWN BY	CHECKED BY	APPROVED BY	SHEET
					6