


STA. 0400
CONNECT TO EXISTING
6" WATER LINE
INSTALL
1 - 6" x 6" TEE
1 - 6" SLEEVE
1 - 5" - 22 1/2° BEND
1 - 6" GATE VALVE

STA. 4485
INSTALL
1 - 6" x 6" TEE
2 - 6" GATE VALVES
1 - STD. FIRE HYD.

STA. 11420
INSTALL
1 - 6" x 6" TEE
1 - 6" GATE VALVE
1 - STD. FIRE HYD.
1 - 22 1/2° BEND

STA. 17410
INSTALL
1 - 6" x 6" TEE
1 - 6" PLUG
1 - 6" GATE VALVE
1 - STD. FIRE HYD.

NOTE: SERVICE CONNECTIONS TO BE LOCATED IN THE FIELD BY THE ENGINEER.

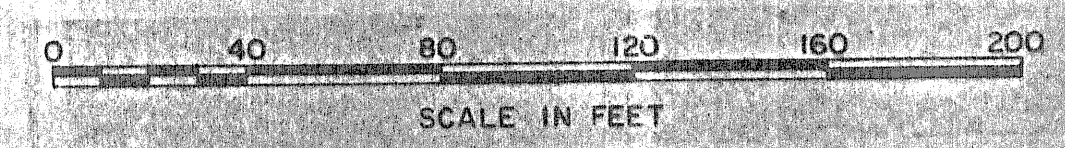

AS SHOWN
THIS DRAWING IS TO BE USED TO REFERENCE ONLY AND NOT TO BE USED FOR CONSTRUCTION WITHOUT THE APPROVAL OF THE ENGINEER.
By *[Signature]*
Date *May 2, 1965*

CITY OF ROCKWALL, TEXAS
ADDITIONS TO WATER DISTRIBUTION SYSTEM

WATER MAIN IN WILLIAMS ST.

FORREST AND COTTON, INC. DALLAS, TEXAS
CONSULTING ENGINEERS DECEMBER, 1961

FILE NO.	DESIGNED BY DRAWN BY CHECKED BY APPROVED	SHEET NO. 5 OF 3 SHEETS
----------	---	--------------------------------------