


WHITE ROAD (FM-740 TO TUBBS ROAD) RANCH TRAIL CONNECTION

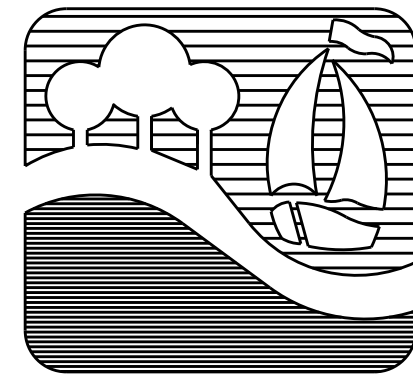


CITY OF ROCKWALL

"THE NEW HORIZON"

JULY 2009

BILL CECIL * MAYOR
 DAVID SWEET
 MARK RUSSO
 GLEN FARRIS
 CLIFF SEVIER - MAYOR PRO-TEM
 MATT SCOTT
 MARGO NIELSEN
 CITY COUNCIL
 JULIE COUCH
 CITY MANAGER
 CHUCK TODD, P.E.
 DIRECTOR OF PUBLIC WORKS

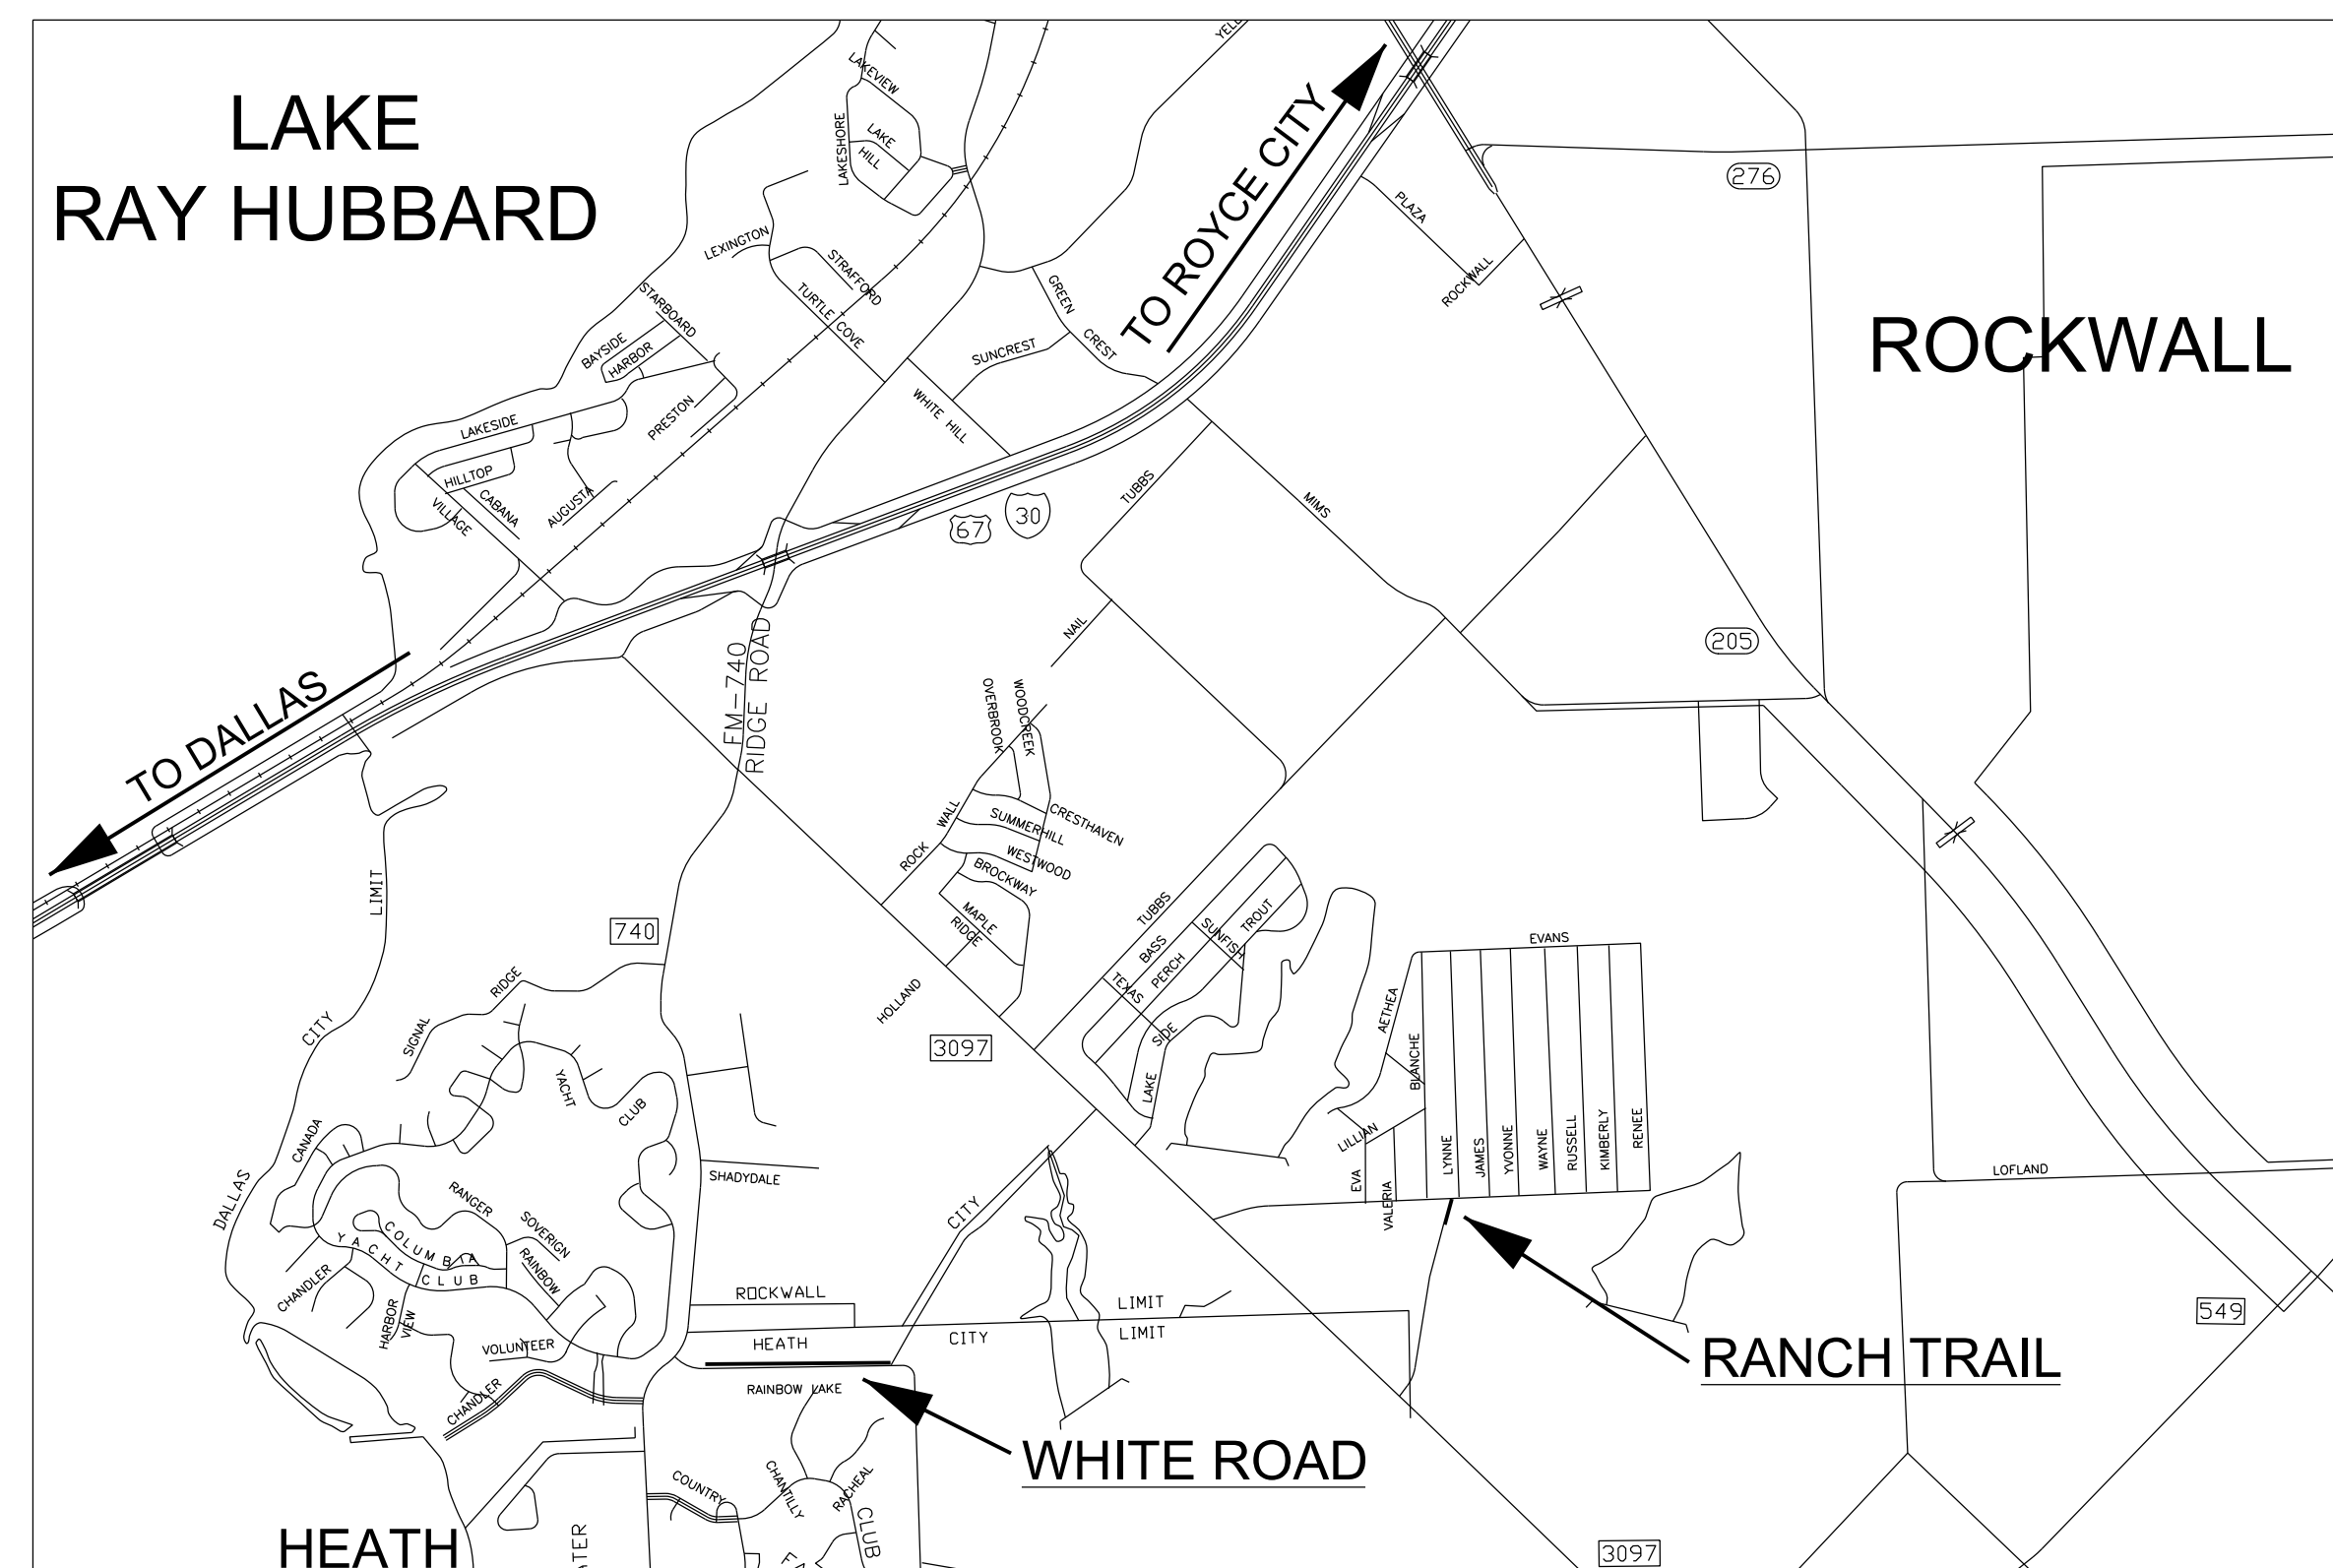

VICINITY MAP
N.T.S.

SHEET INDEX

SHEET NO.	DESCRIPTION
GN-1	COVER SHEET
GN-2	GENERAL NOTES
GN-3	QUANTITY SUMMARY SHEET
GN-4	TYPICAL SECTIONS
WT-P1	WHITE PAVING P&P STA 1+00 TO 6+00
WT-P2	WHITE PAVING P&P STA 6+00 TO 11+00
WT-P3	WHITE PAVING P&P STA 11+00 TO 16+00
WT-P4	WHITE PAVING P&P STA 16+00 TO 17+87
WT-D1	WHITE DRAINAGE AREA MAP AND CALCULATIONS
WT-D2	WHITE STORM DRAIN P&P
WT-EC1	WHITE EROSION CONTROL
WT-XS1-XS5	WHITE CROSS SECTIONS
RT-P1	RANCH TRAIL PAVING P&P STA 1+00 TO 4+75
RT-D1	RANCH TRAIL DRAINAGE AREA MAP & CALCULATIONS
RT-XS	RANCH TRAIL CROSS SECTIONS
EC-1	EROSION CONTROL NARRATIVE

RECORD DRAWING

THE SEAL THAT ORIGINALLY APPEARED ON THIS DOCUMENT WAS AUTHORIZED BY TED B. SUGG, TEXAS NO 82775 ON 7-1-2009

THESE RECORD DRAWINGS WERE PREPARED BASED UPON AS CONSTRUCTED DRAWINGS PROVIDED BY THE CONTRACTOR WHO REPRESENTED THAT ALL FIELD CHANGES AND DEVIATIONS FROM THE APPROVED CONSTRUCTION DRAWINGS WERE INCLUDED ON FEBRUARY 22, 2011.



TBPE REG. #F-474

18383 PRESTON ROAD, SUITE 110
 DALLAS, TEXAS 75252
 972-818-7275