

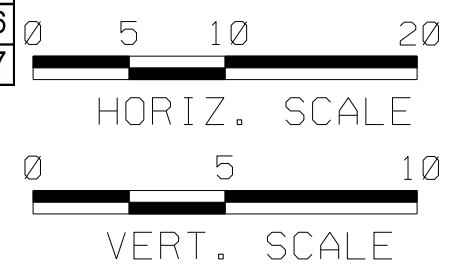



CONTROL PT	STA	OFFSET	ELEV	NORTHING	EASTING
54	5+45.99	19.36' RT	541.59	7008864.76	2591845.08
55	13+35.13	10.80' RT	551.51	7008893.77	2592634.26
56	18+58.25	3.25' RT	538.29	7008885.45	2593157.37

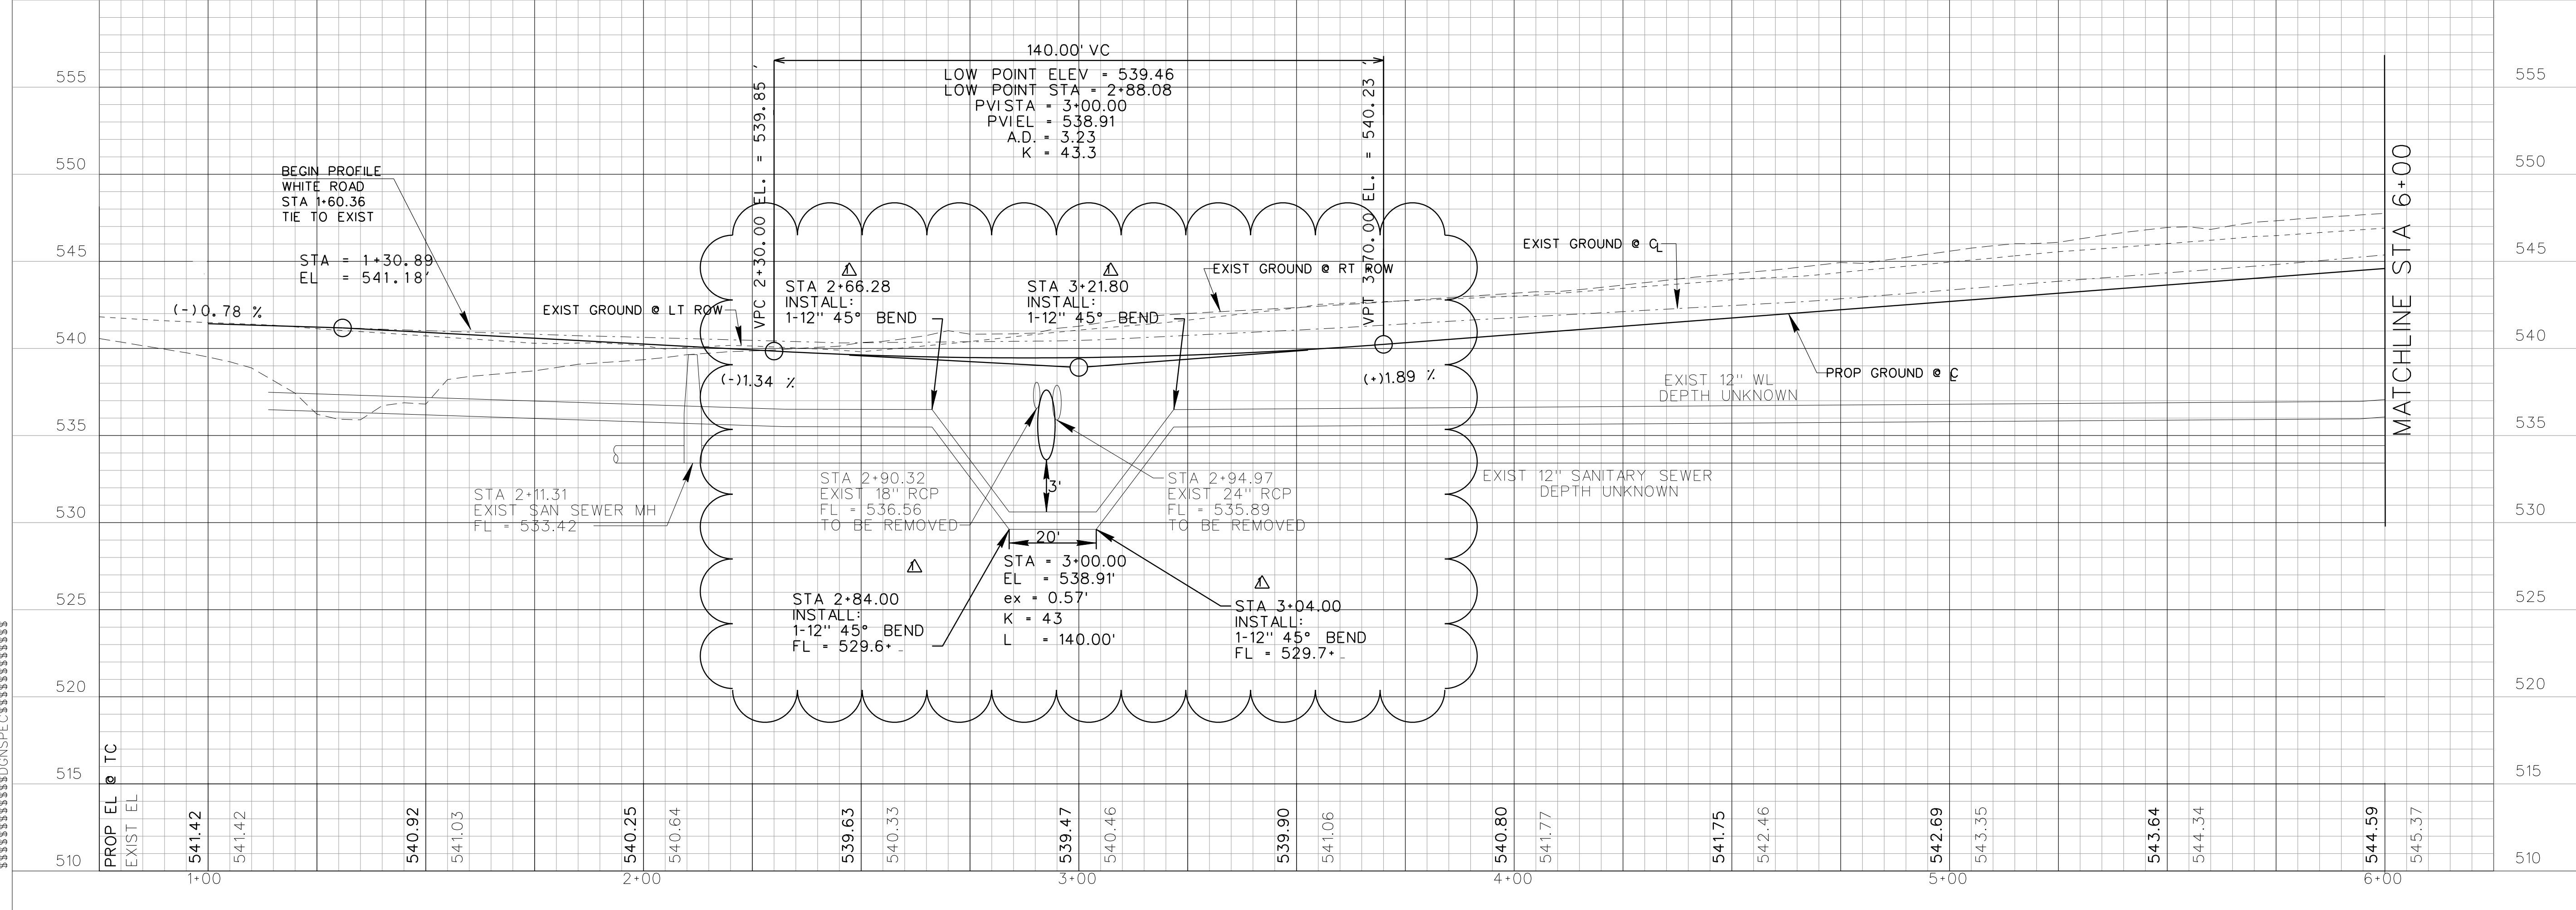

RECORD DRAWING
THE SEAL THAT ORIGINALLY APPEARED ON THIS DRAWING IS THE ONLY VALID SEAL FOR THIS PROJECT. THESE RECORD DRAWINGS WERE PREPARED BY THE CONTRACTOR WHO HAS REVIEWED AND REPRESENTED THAT ALL FIELD CHANGES AND DEVIATIONS FROM THE APPROVED CONSTRUCTION DRAWINGS WERE INCLUDED ON FEBRUARY 22, 2011.

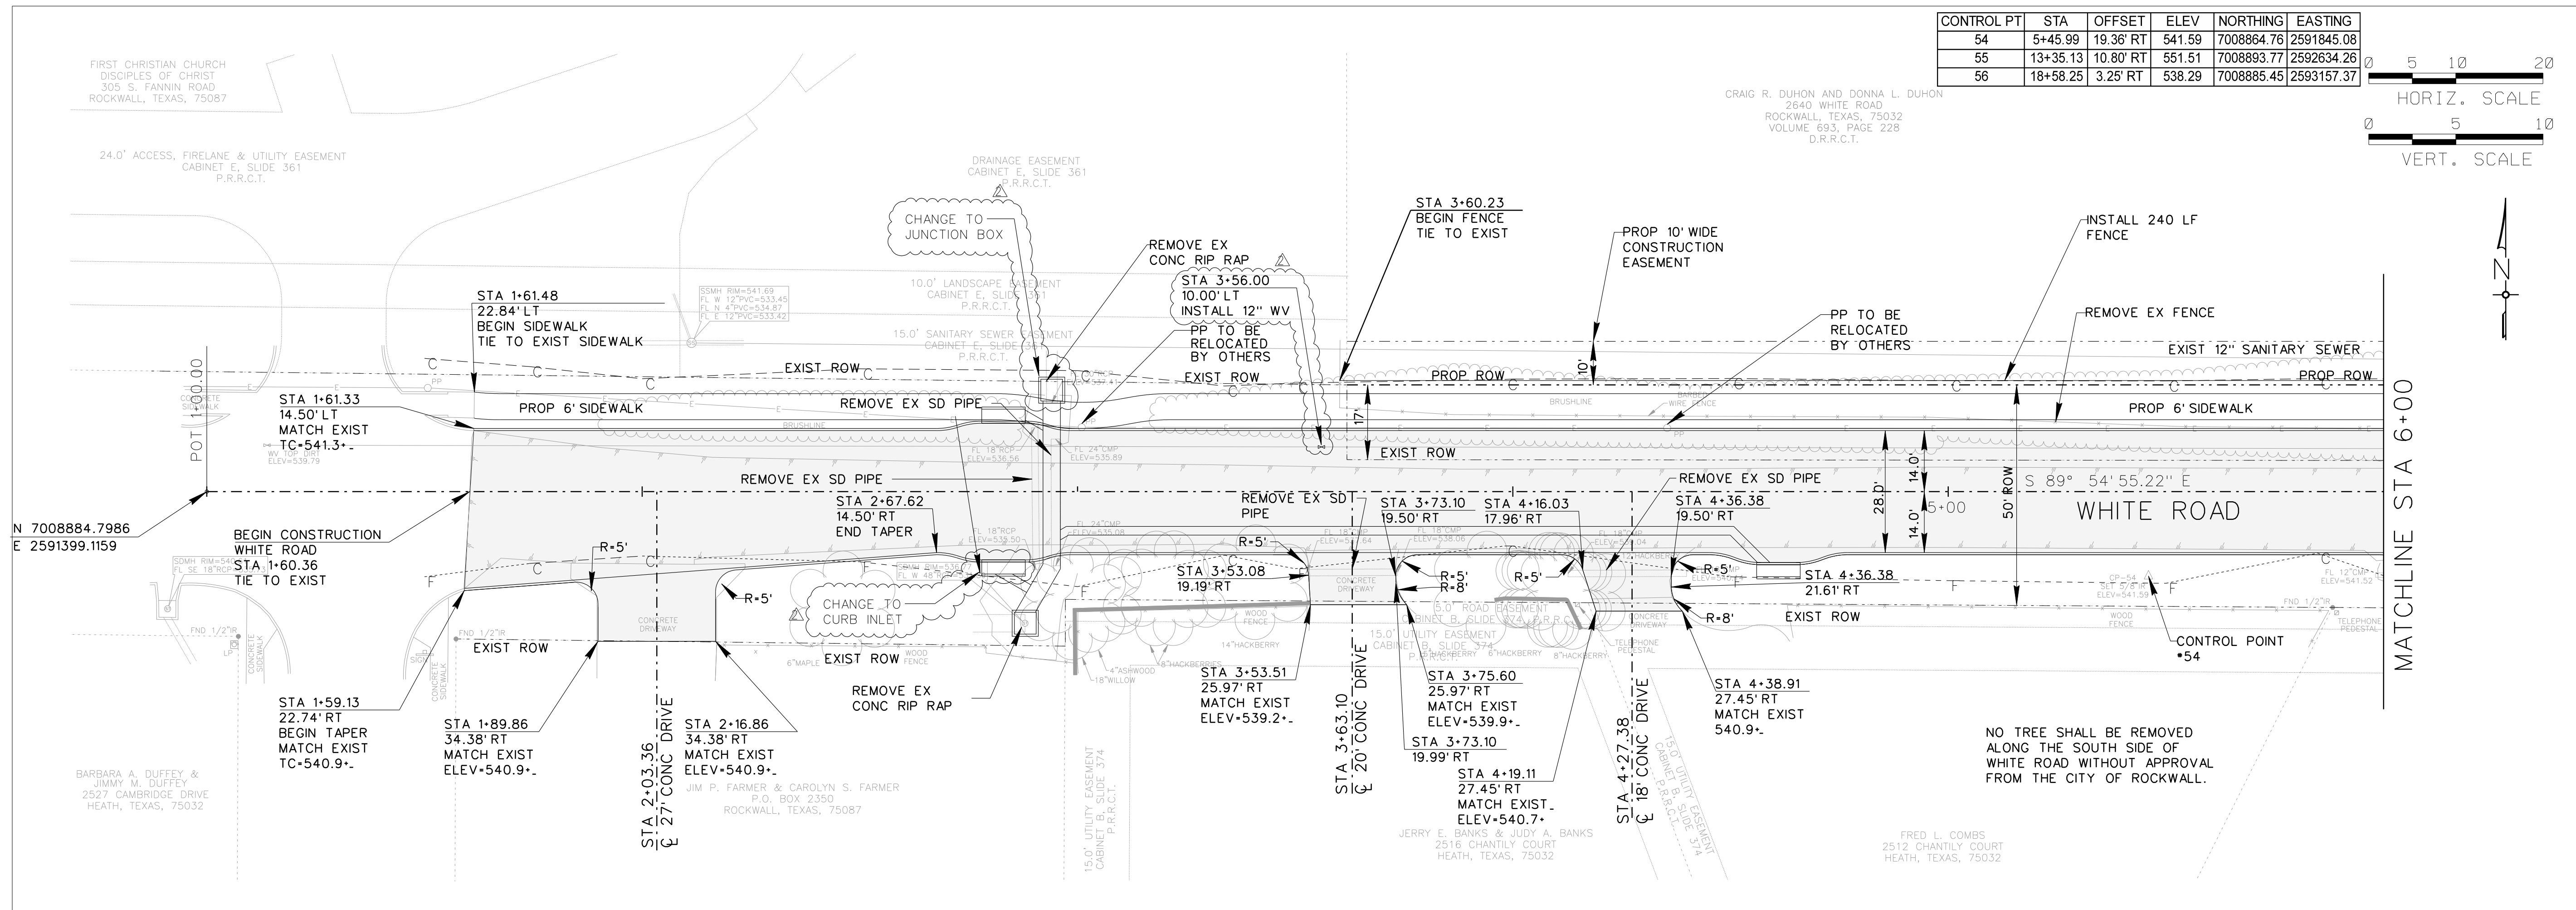

CITY OF ROCKWALL
WHITE ROAD & RANCH TRAIL
WHITE ROAD
PAVING STA 1+00 TO 6+00

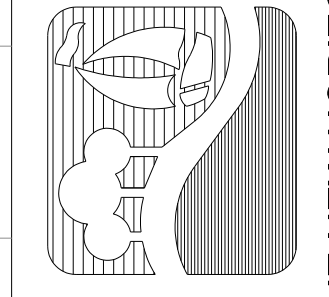

DATE	BY	REVISION	NO.	TYPE REG.
12/15/09	PRKJ	INSTALL 45° BENDS TO LOWER WL	1	#F-474
2/14/11	MAW	RECORD DRAWINGS	2	

DESIGN: CRH / TBS
 DRAWN: CRH / TBS
 CHECKED: PESSJ
 APPROVED: PESSJ

DATE: JULY 2009
 FILE: \$FILES\$

18383 PRESTON ROAD, SUITE 110
 DALLAS, TEXAS 75252
 972-818-7275
 PESSJ JOB NO.: 52091000