
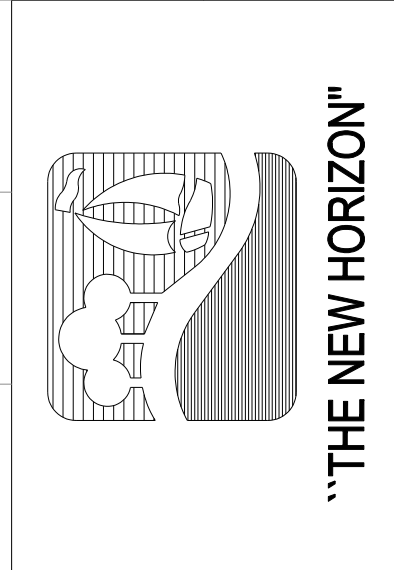


RECORD DRAWING
 THE SEAL THAT ORIGINALLY APPEARED ON THIS DRAWING IS TO REMAIN UNCHANGED. THESE RECORD DRAWINGS WERE PREPARED BY THE CONTRACTOR WHO PROVIDED BY THE CONTRACTOR WHO REPRESENTED THAT ALL FIELD CHANGES AND DEVIATIONS FROM THE APPROVED CONSTRUCTION DRAWINGS WERE INCLUDED ON FEBRUARY 22, 2011.

CITY OF ROCKWALL
WHITE ROAD & RANCH TRAIL
WHITE ROAD
PAVEING STA 11+00 TO 16+00

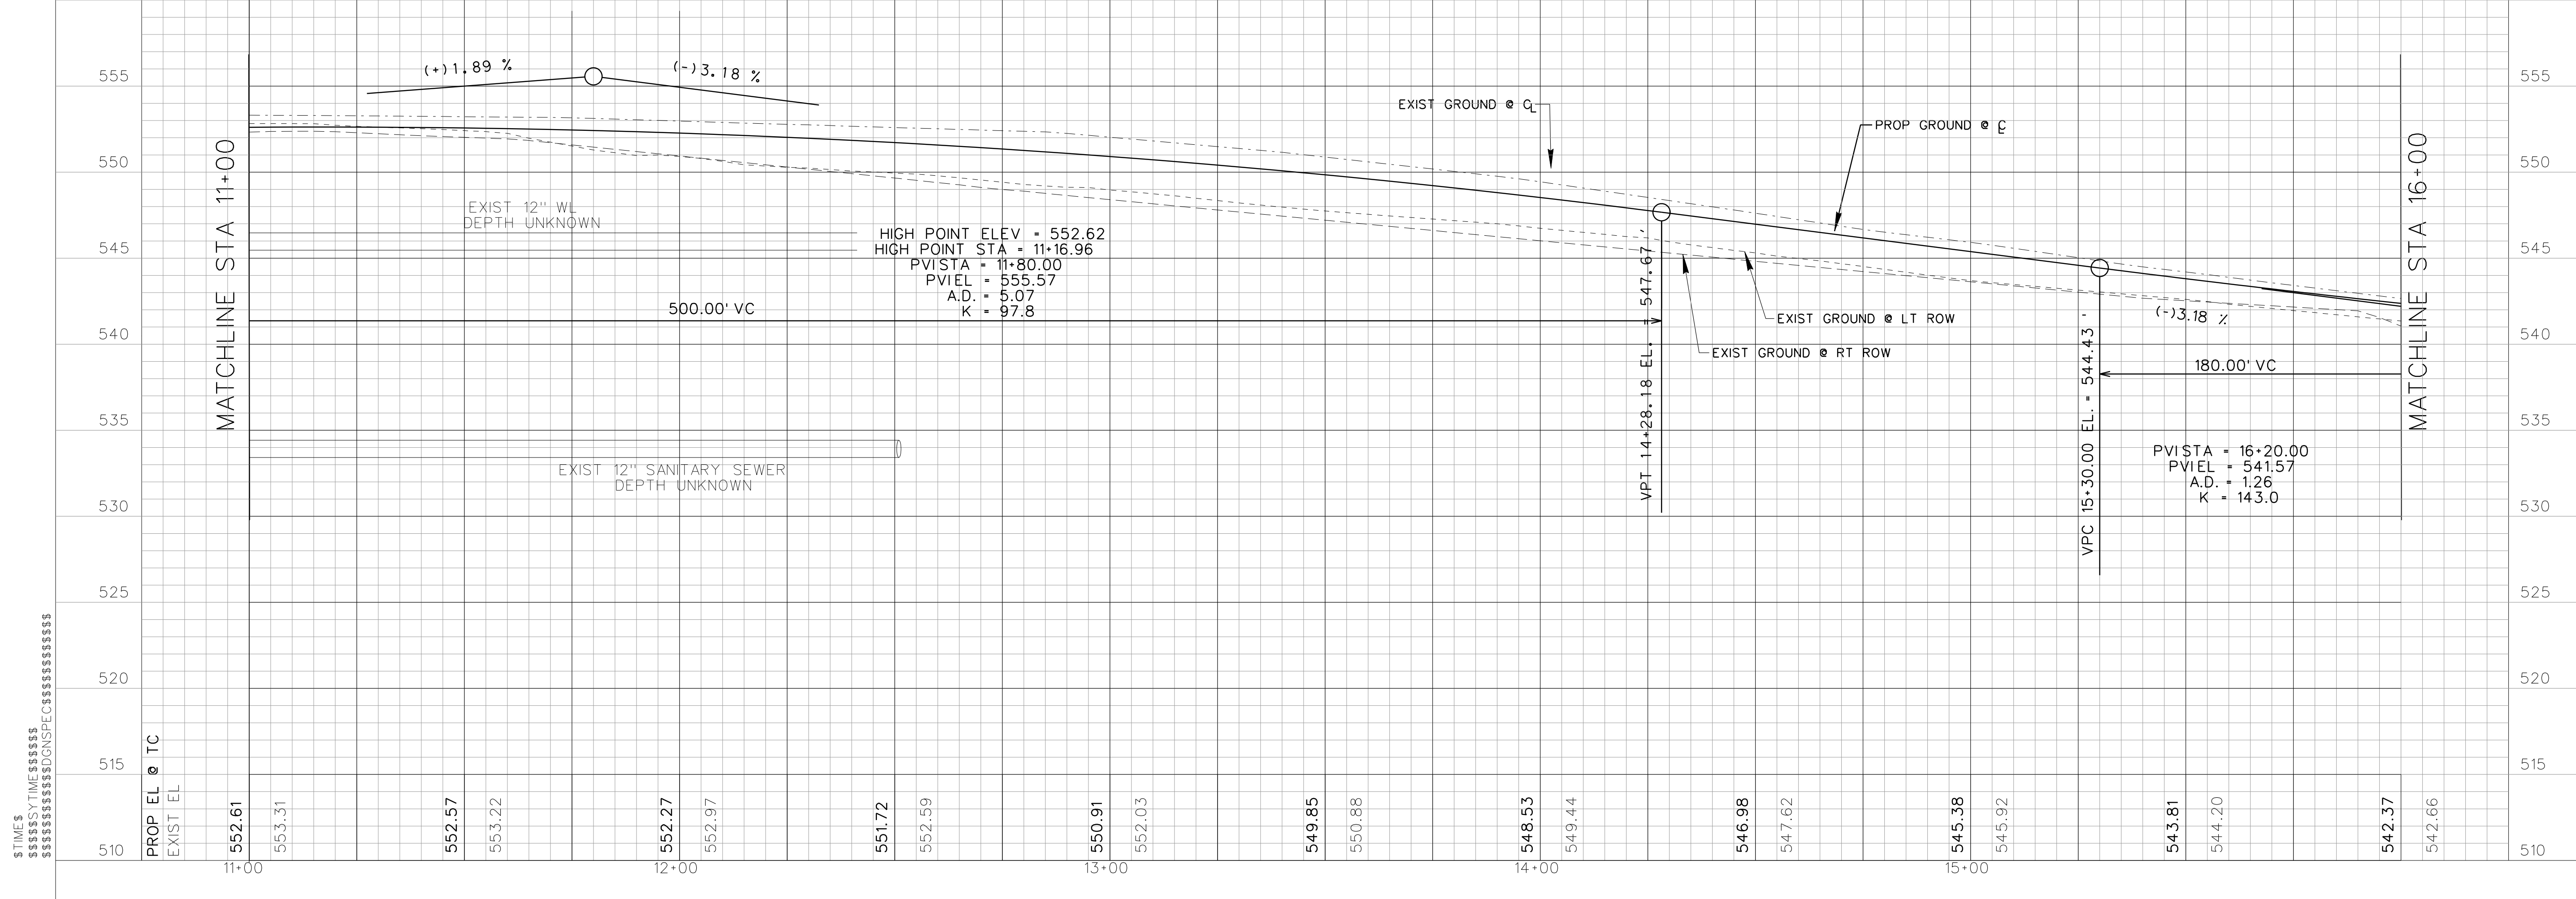

REVISION	NO.	DATE	BY	DATE
DRIVEWAY RADIUS CHANGED TO 20'	TBS	3/23/10	TBS	
RECORD DRAWINGS	MAW	2/14/11	MAW	

DESIGN: CRH / TBS	CHECKED: PESSJ
DRAWN: CRH / TBS	APPROVED: PESSJ

TBPE REG. NO. #F-474	18383 PRESTON ROAD, SUITE 110 DALLAS, TEXAS 75252 972-818-7275
PBS&J JOB NO.: 52091000	DATE: JULY 2009
FILE: \$FILES\$	

8 TIMES \$TIME \$\$\$\$\$\$
 \$\$\$\$\$\$SYTIME \$\$\$\$\$\$
 \$\$\$\$\$\$DONSPEC\$\$\$\$\$