
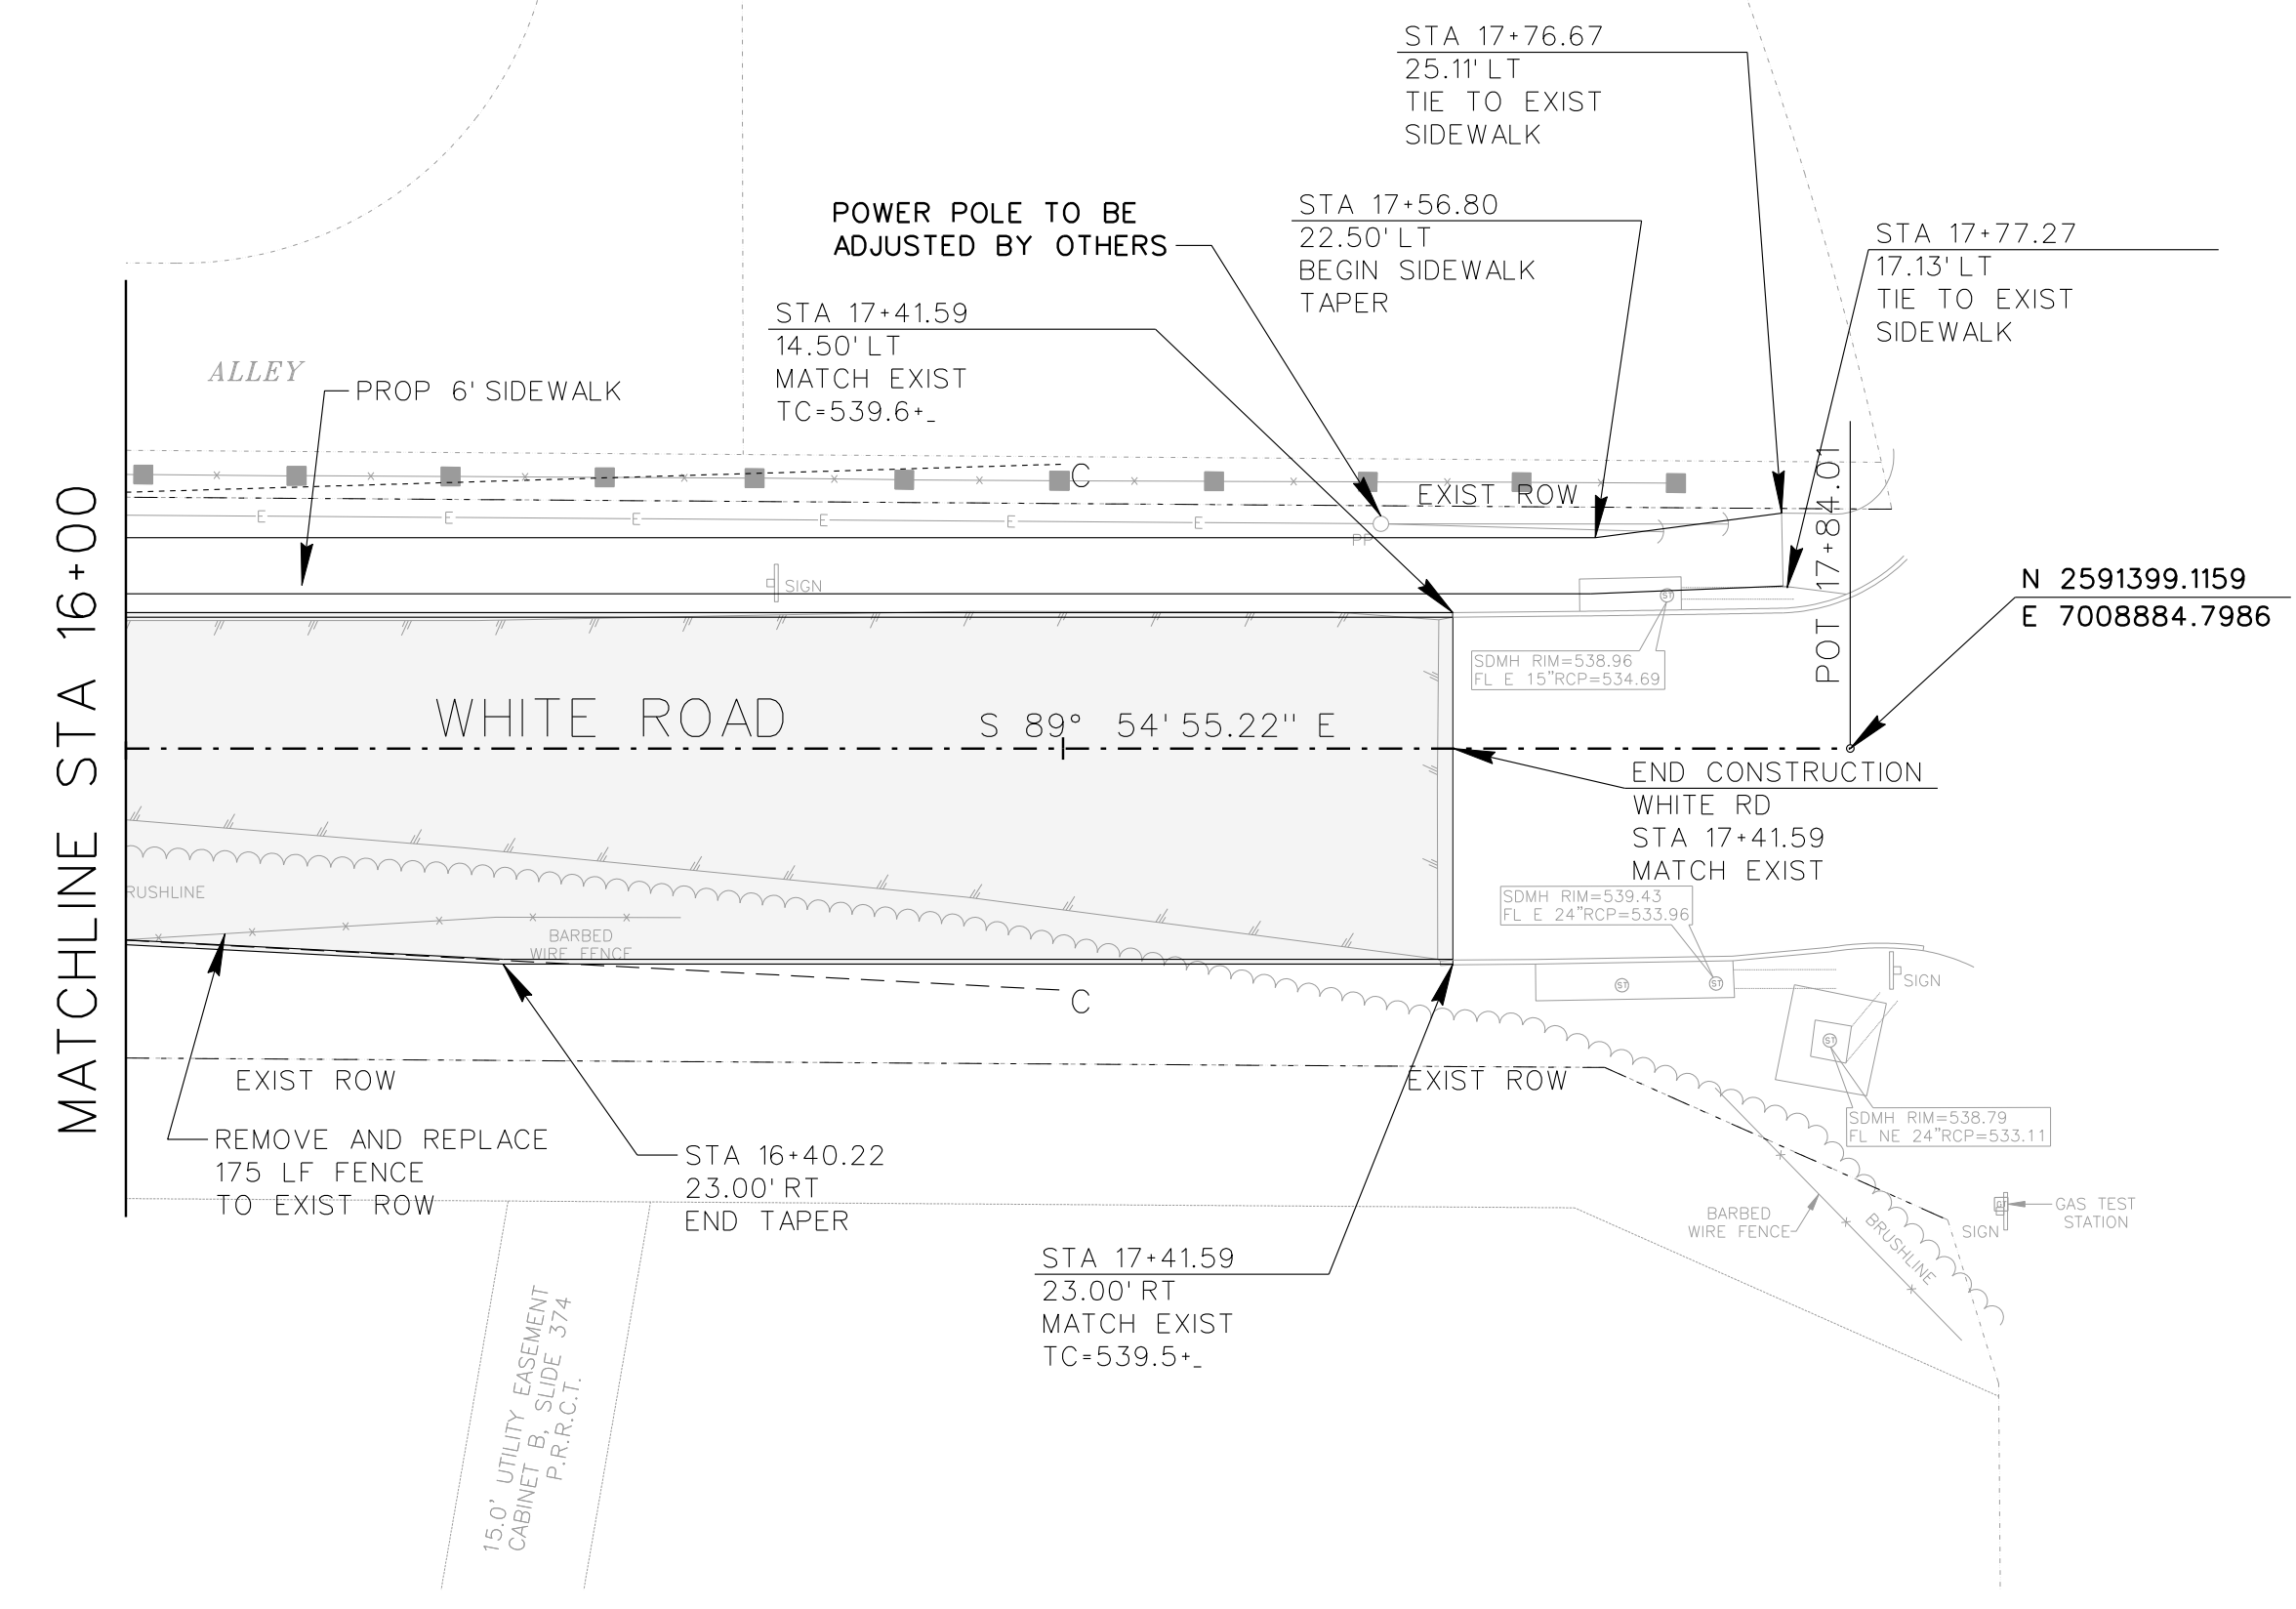
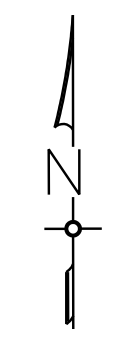



D.R. CLARK & CO. CUSTOM BUILDERS  
368 NATIONAL DRIVE  
ROCKWALL, TEXAS, 75032

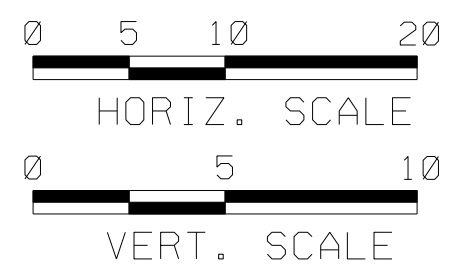

CP-56  
SET 5/8"R  
ELEV=538.29

CONTROL POINT  
#56


N 2591399.1159  
E 7008884.7986

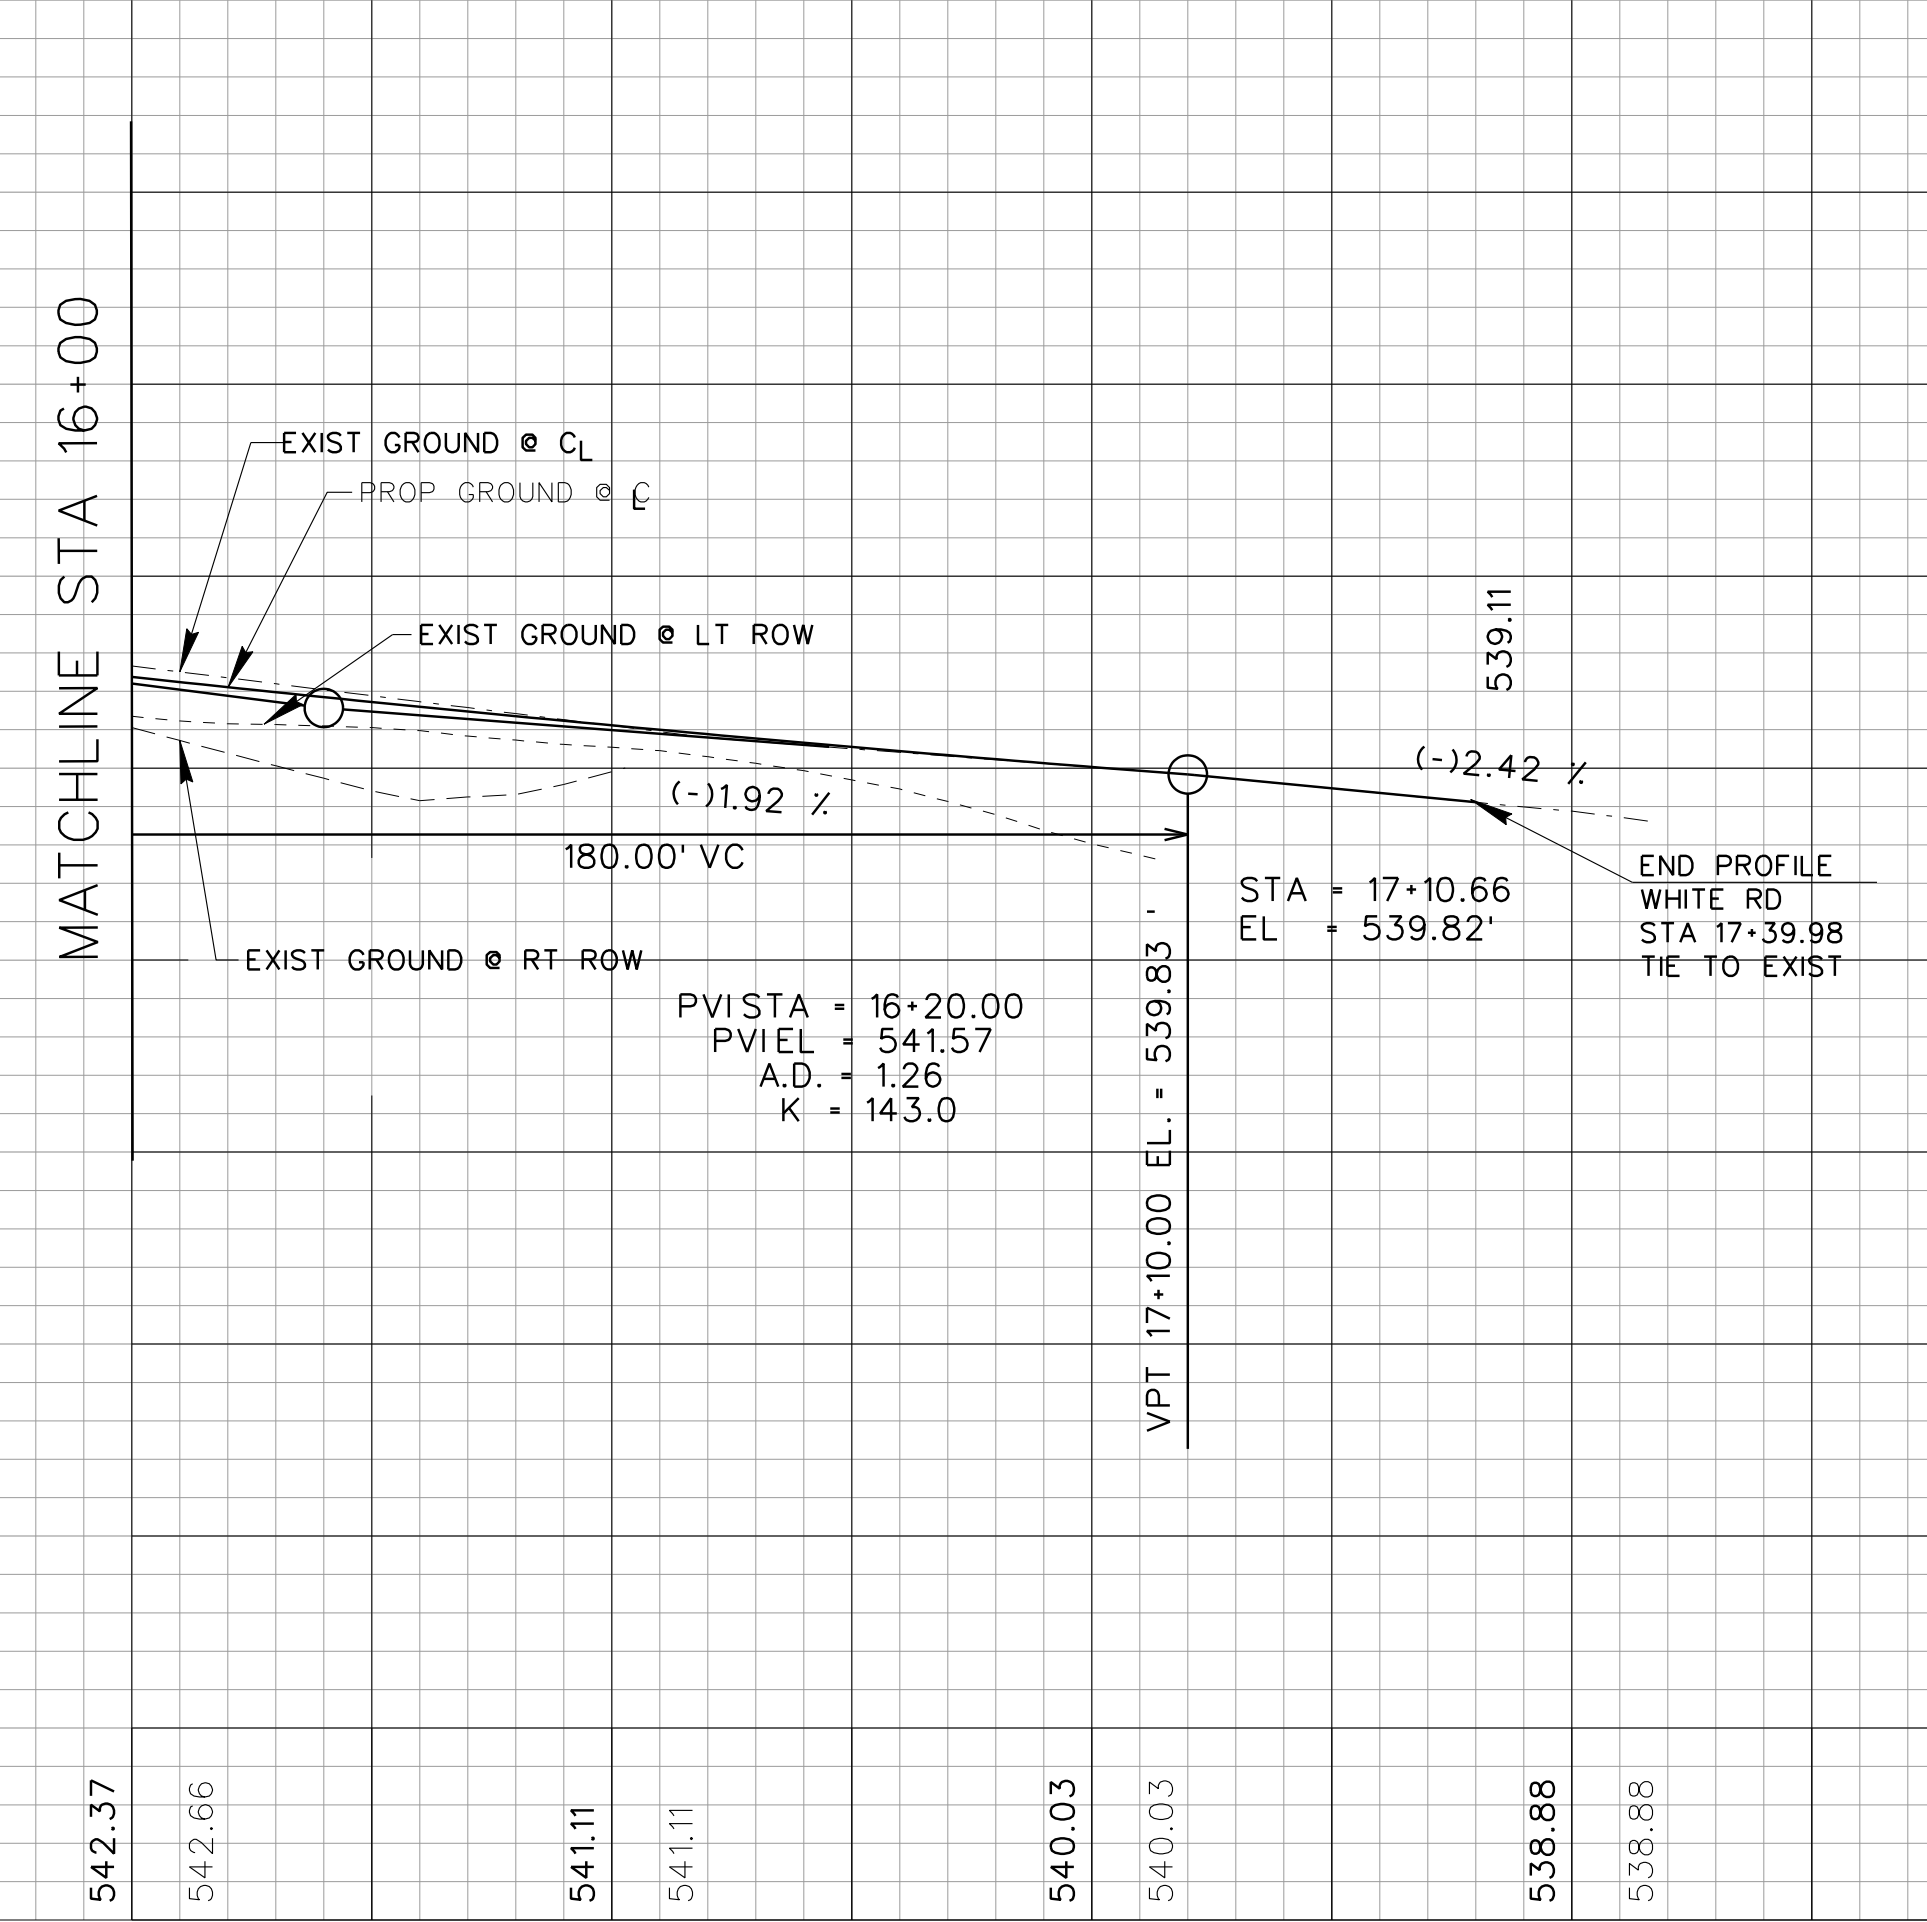

8 TIMES  
\$\$\$\$SYTIME\$\$\$\$  
\$\$\$\$\$DONSPEC\$\$\$\$\$

**RECORD DRAWING**  
THE SEAL THAT ORIGINALLY APPEARED ON THIS DRAWING IS THE PROPERTY OF THE ENGINEER WHO ISSUED IT. THESE RECORD DRAWINGS WERE PREPARED BY THE CONTRACTOR WHO PROVIDED ALL FIELD CHANGES AND DEVIATIONS FROM THE APPROVED CONSTRUCTION DRAWINGS WERE INCLUDED ON FEBRUARY 22, 2011.

**CITY OF ROCKWALL**  
**WHITE ROAD & RANCH TRAIL**  
**WHITE ROAD**  
**PAVEING STA 16+00 TO 17+84**

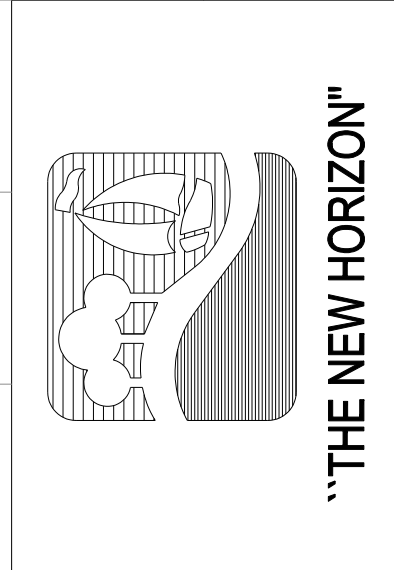

DATE	BY	REVISION	TBPE REG. NO.	DESIGN: CRH / TBS	CHECKED: PBS&J
			18383 PRESTON ROAD, SUITE 110 DALLAS, TEXAS 75252 972-818-7275	DATE: JULY 2009	APPROVED: PBS&J
			PBS&J JOB NO.: 52091000	DESIGN: CRH / TBS	APPROVED: PBS&J
			FILE: \$FILES\$	DRAWN: CRH / TBS	APPROVED: PBS&J