

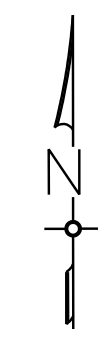


FIRST CHRISTIAN CHURCH
DISCIPLES OF CHRIST
305 S. FANNIN ROAD
ROCKWALL, TEXAS, 75087


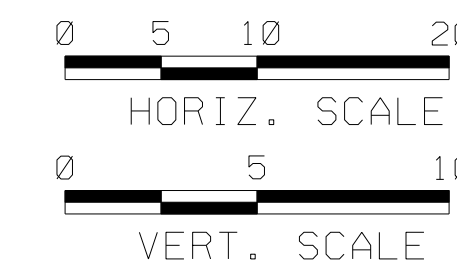


RECORD DRAWING
THE SEAL THAT ORIGINALLY APPEARED ON THIS DRAWING IS THE SEAL OF THE ENGINEER, TERRY B. SAUC, TEXAS NO. 82775, ON 7-1-2009. THESE RECORD DRAWINGS WERE PREPARED BY THE CONTRACTOR, PBS&J, AND REPRESENTED THAT ALL FIELD CHANGES AND DEVIATIONS FROM THE APPROVED CONSTRUCTION DRAWINGS WERE INCLUDED ON FEBRUARY 22, 2011.

**CITY OF ROCKWALL
WHITE ROAD & RANCH TRAIL
WHITE ROAD
DRAINAGE IMPROVEMENTS**

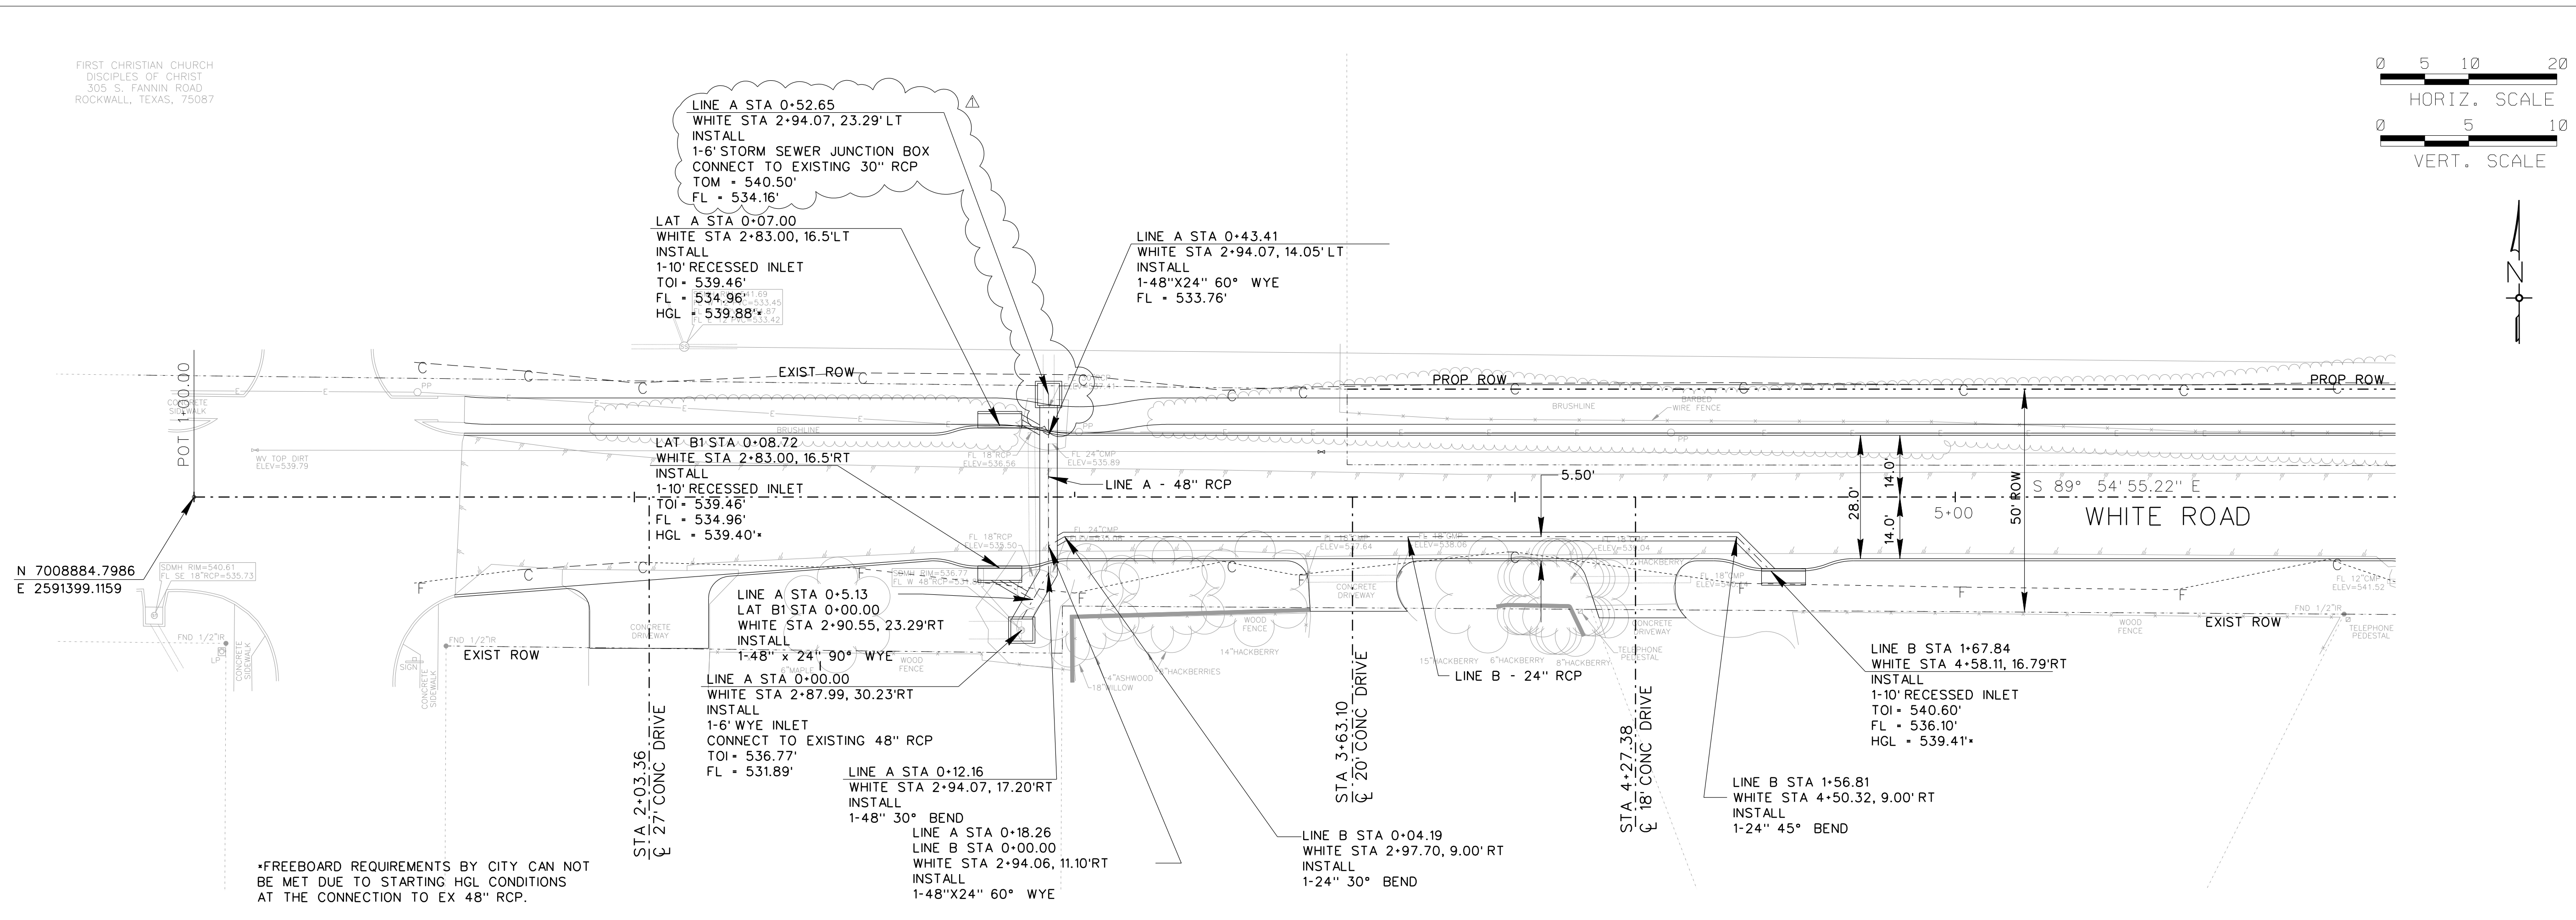

*FREEBOARD REQUIREMENTS BY CITY CAN NOT BE MET DUE TO STARTING HGL CONDITIONS AT THE CONNECTION TO EX 48" RCP.

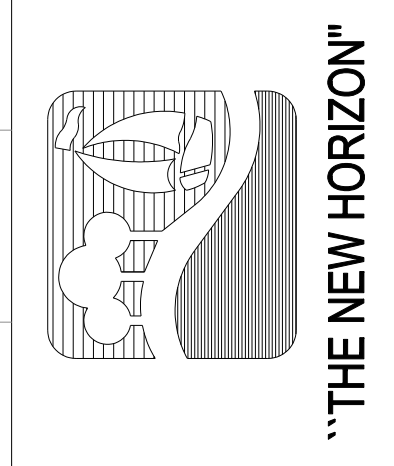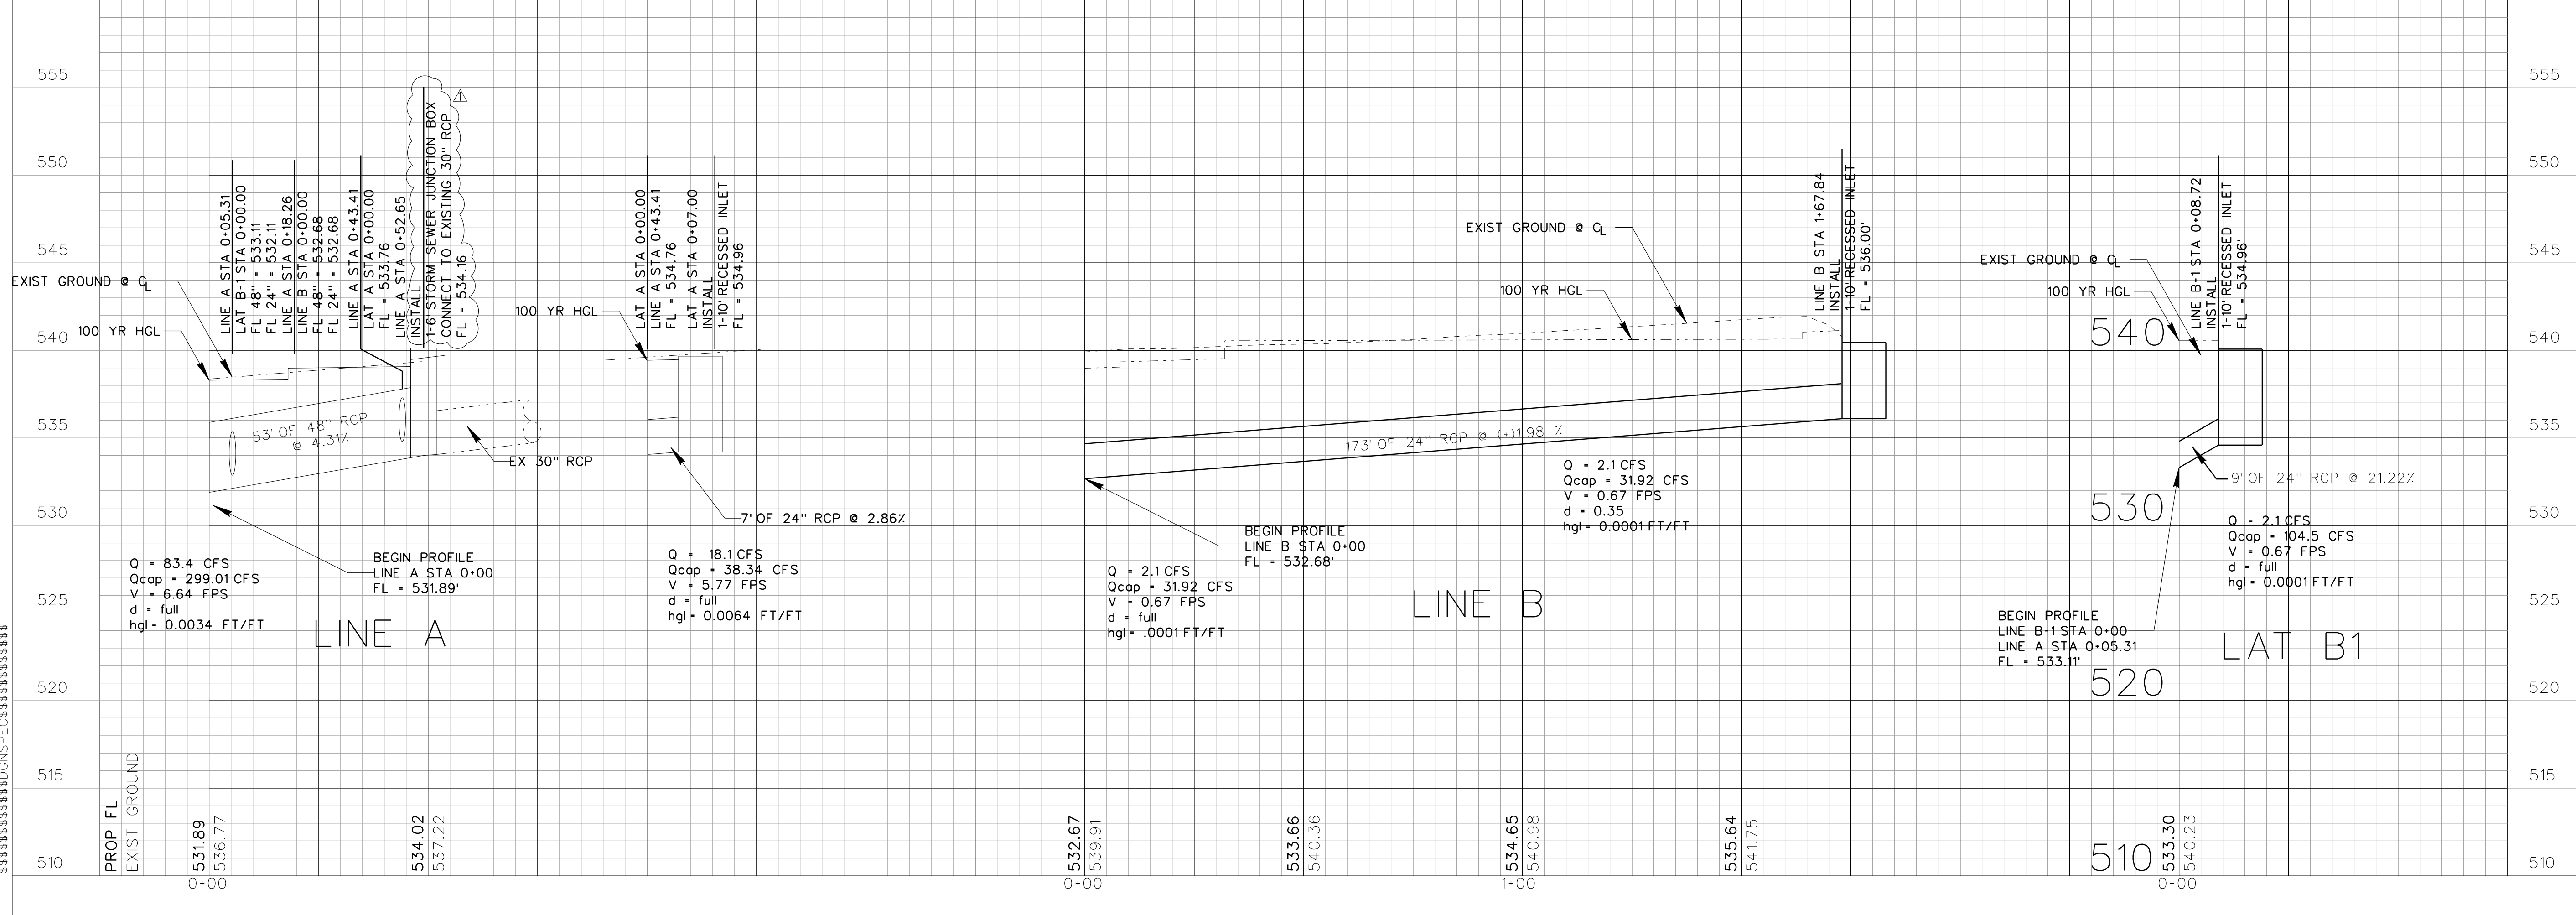

REVISION	DATE	BY	DATE
RECORD DRAWINGS	2/14/11	MAW	

DESIGN	CHECKED	DATE
CRH / TBS	PBS&J	JULY 2009

DESIGN	CHECKED	DATE
CRH / TBS	PBS&J	JULY 2009

TYPE	NO.	DATE
TBPE REC.	#F-474	2/14/11

18383 PRESTON ROAD, SUITE 110
DALLAS, TEXAS 75252
972-818-7275
PBS&J JOB NO.: 52091000
DATE: JULY 2009
FILE: \$FILE\$.S\$