



8TIME\$
 \$\$\$SYTIME\$\$\$\$\$
 \$\$\$DONSPEC\$\$\$\$\$

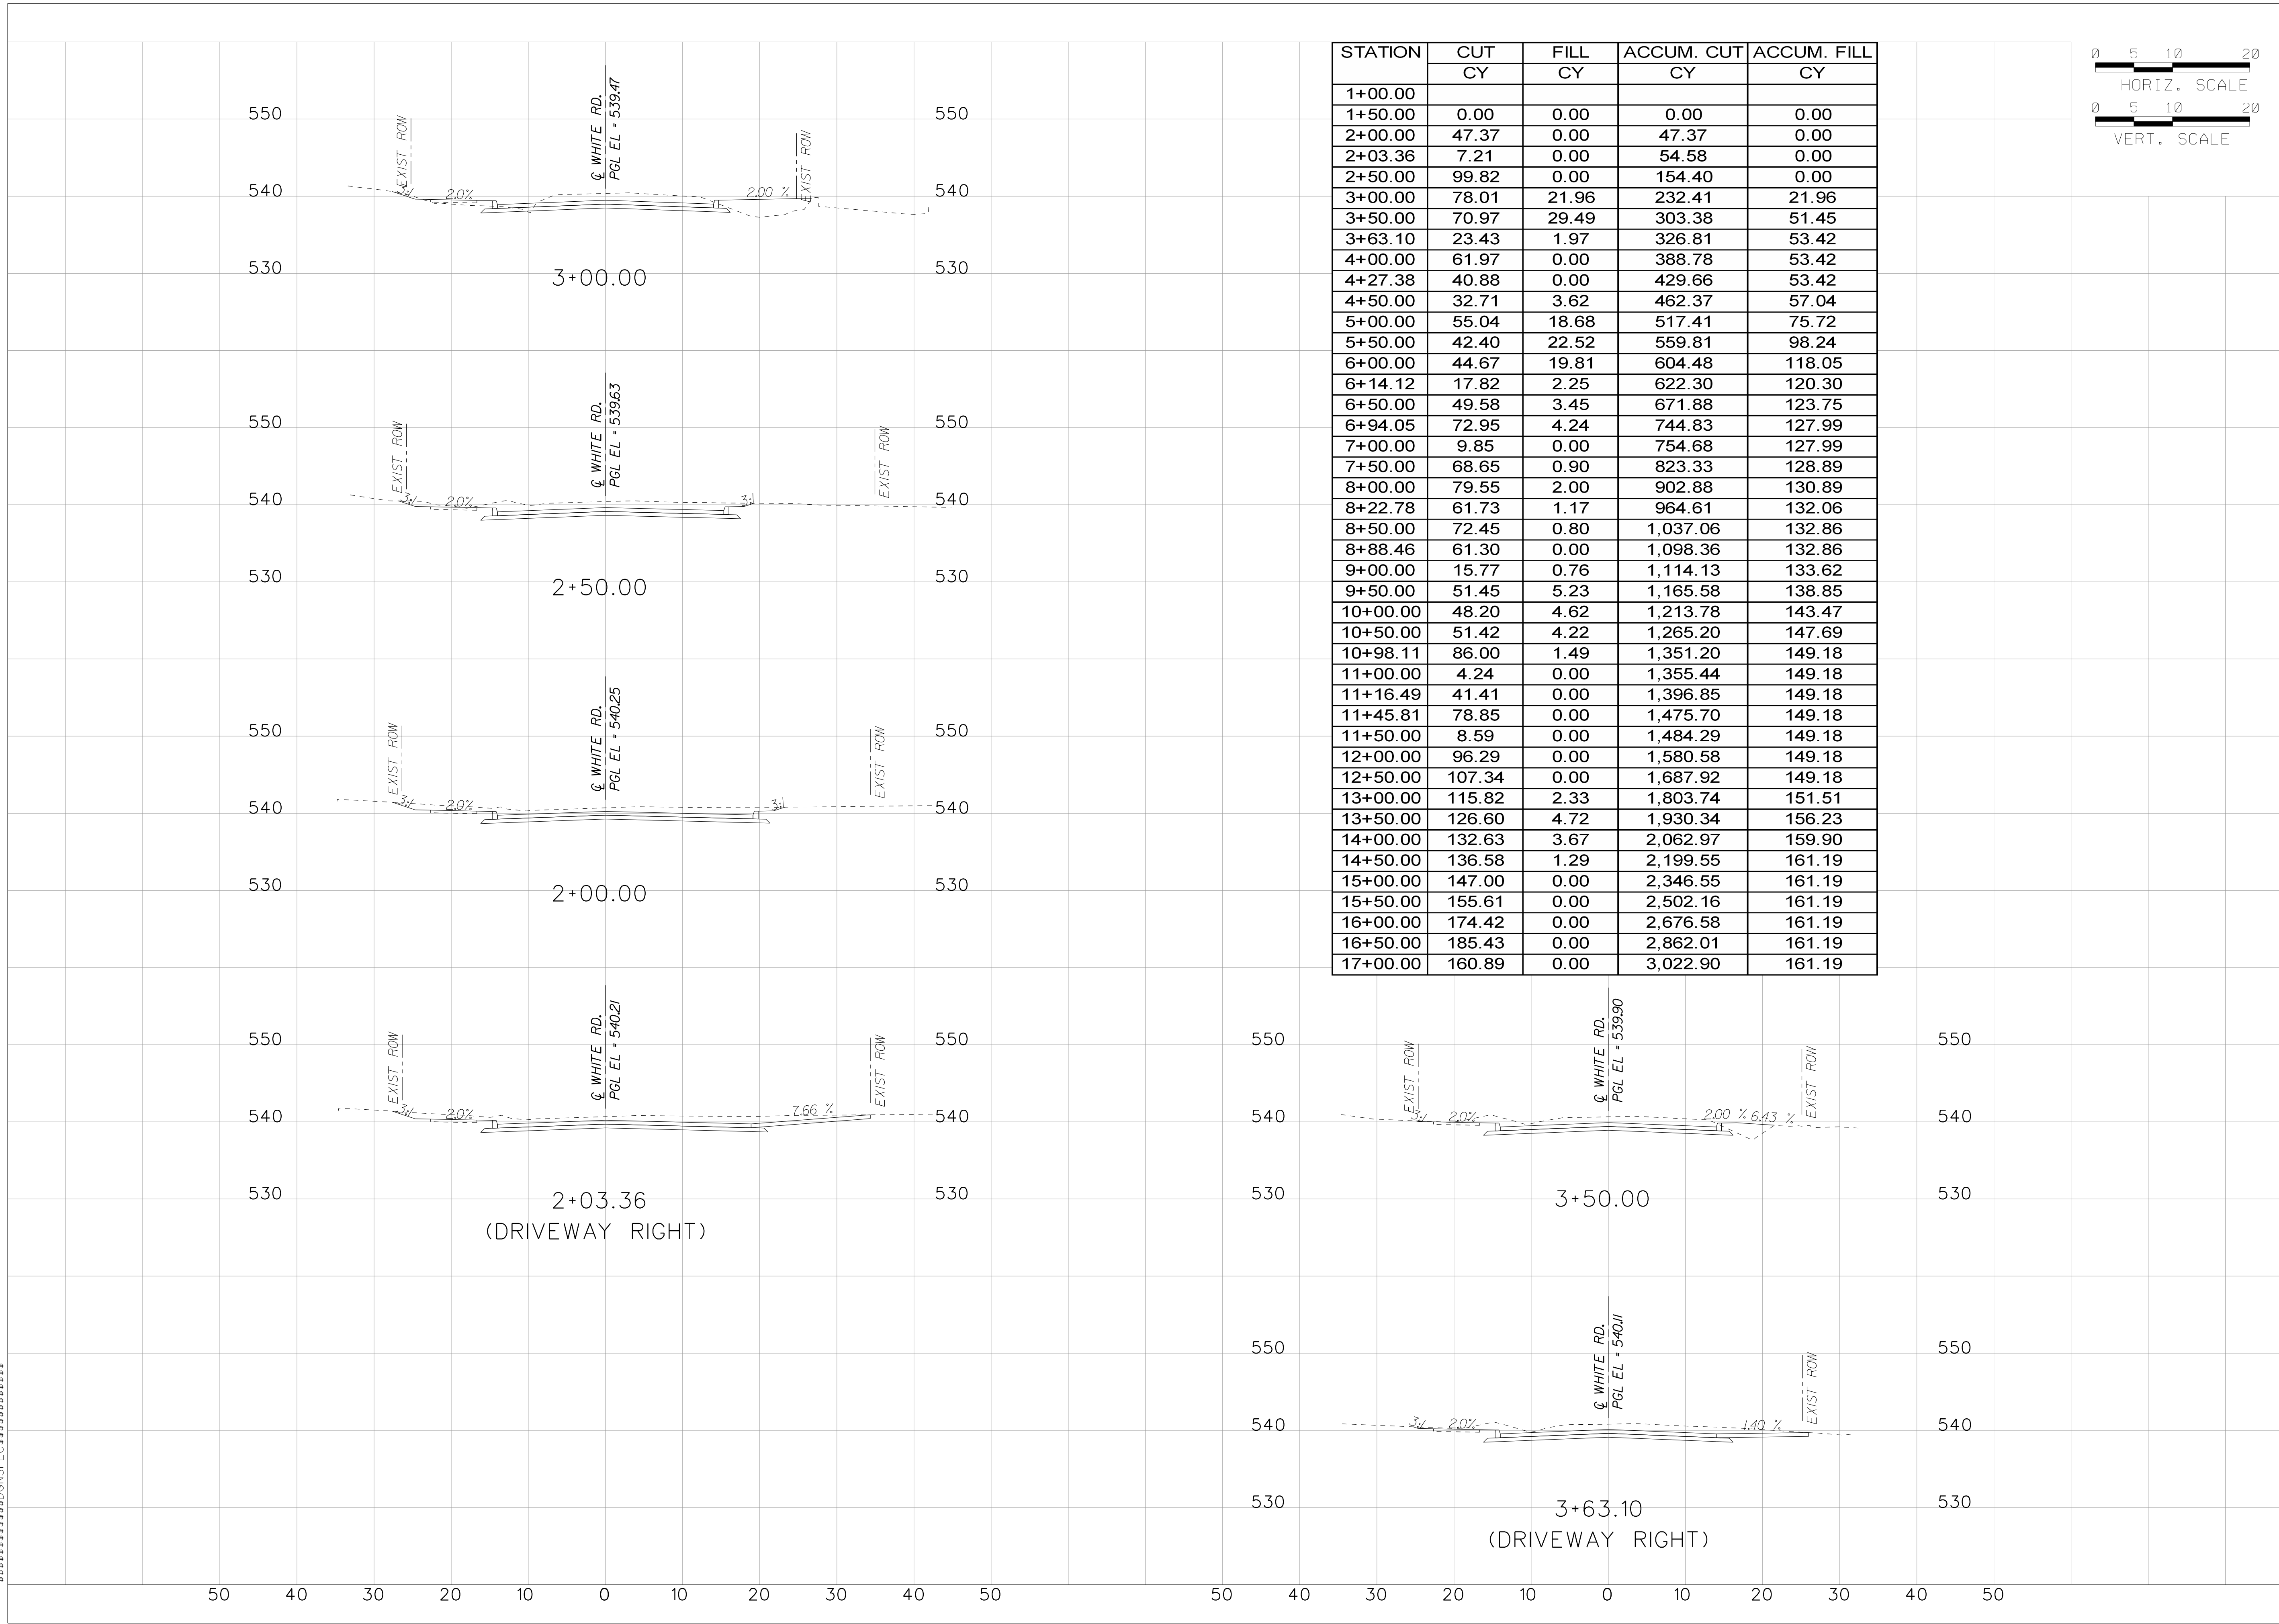


STATION	CUT	FILL	ACCUM. CUT	ACCUM. FILL
	CY	CY	CY	CY
1+00.00				
1+50.00	0.00	0.00	0.00	0.00
2+00.00	47.37	0.00	47.37	0.00
2+03.36	7.21	0.00	54.58	0.00
2+50.00	99.82	0.00	154.40	0.00
3+00.00	78.01	21.96	232.41	21.96
3+50.00	70.97	29.49	303.38	51.45
3+63.10	23.43	1.97	326.81	53.42
4+00.00	61.97	0.00	388.78	53.42
4+27.38	40.88	0.00	429.66	53.42
4+50.00	32.71	3.62	462.37	57.04
5+00.00	55.04	18.68	517.41	75.72
5+50.00	42.40	22.52	559.81	98.24
6+00.00	44.67	19.81	604.48	118.05
6+14.12	17.82	2.25	622.30	120.30
6+50.00	49.58	3.45	671.88	123.75
6+94.05	72.95	4.24	744.83	127.99
7+00.00	9.85	0.00	754.68	127.99
7+50.00	68.65	0.90	823.33	128.89
8+00.00	79.55	2.00	902.88	130.89
8+22.78	61.73	1.17	964.61	132.06
8+50.00	72.45	0.80	1,037.06	132.86
8+88.46	61.30	0.00	1,098.36	132.86
9+00.00	15.77	0.76	1,114.13	133.62
9+50.00	51.45	5.23	1,165.58	138.85
10+00.00	48.20	4.62	1,213.78	143.47
10+50.00	51.42	4.22	1,265.20	147.69
10+98.11	86.00	1.49	1,351.20	149.18
11+00.00	4.24	0.00	1,355.44	149.18
11+16.49	41.41	0.00	1,396.85	149.18
11+45.81	78.85	0.00	1,475.70	149.18
11+50.00	8.59	0.00	1,484.29	149.18
12+00.00	96.29	0.00	1,580.58	149.18
12+50.00	107.34	0.00	1,687.92	149.18
13+00.00	115.82	2.33	1,803.74	151.51
13+50.00	126.60	4.72	1,930.34	156.23
14+00.00	132.63	3.67	2,062.97	159.90
14+50.00	136.58	1.29	2,199.55	161.19
15+00.00	147.00	0.00	2,346.55	161.19
15+50.00	155.61	0.00	2,502.16	161.19
16+00.00	174.42	0.00	2,676.58	161.19
16+50.00	185.43	0.00	2,862.01	161.19
17+00.00	160.89	0.00	3,022.90	161.19

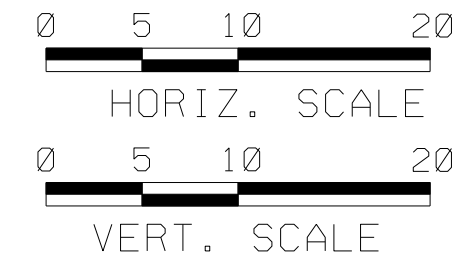

RECORD DRAWING
 THE SEAL THAT ORIGINALLY APPEARED ON THIS DRAWING IS THE SEAL OF THE REGISTERED PROFESSIONAL ENGINEER, TEXAS, LICENSE NO. 82775, ON 7-1-2009.
 THESE RECORD DRAWINGS WERE PREPARED BY THE CONTRACTOR AND REPRESENTED THAT ALL FIELD CHANGES AND DEVIATIONS FROM THE APPROVED CONSTRUCTION DRAWINGS WERE INCLUDED ON FEBRUARY 22, 2011.

CITY OF ROCKWALL
 WHITE ROAD & RANCH TRAIL
 WHITE ROAD
 CROSS SECTIONS

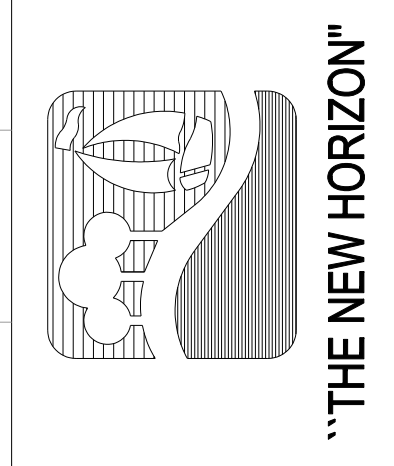

TYPE REC. NO.	DATE
#F-474	
BY	
REVISION	
DESIGN: CRH / TBS	CHECKED: PBS&J
DRAWN: CRH / TBS	APPROVED: PBS&J
DATE: JULY 2009	
FILE: \$FILES\$	