

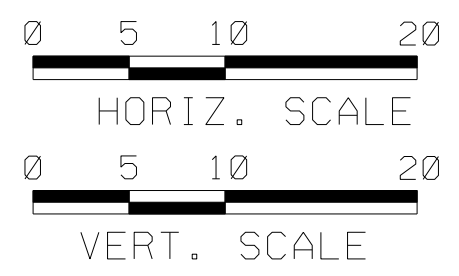


8TIME\$
 \$\$\$SYTIME\$\$\$\$\$
 \$\$\$DONSPEC\$\$\$\$\$

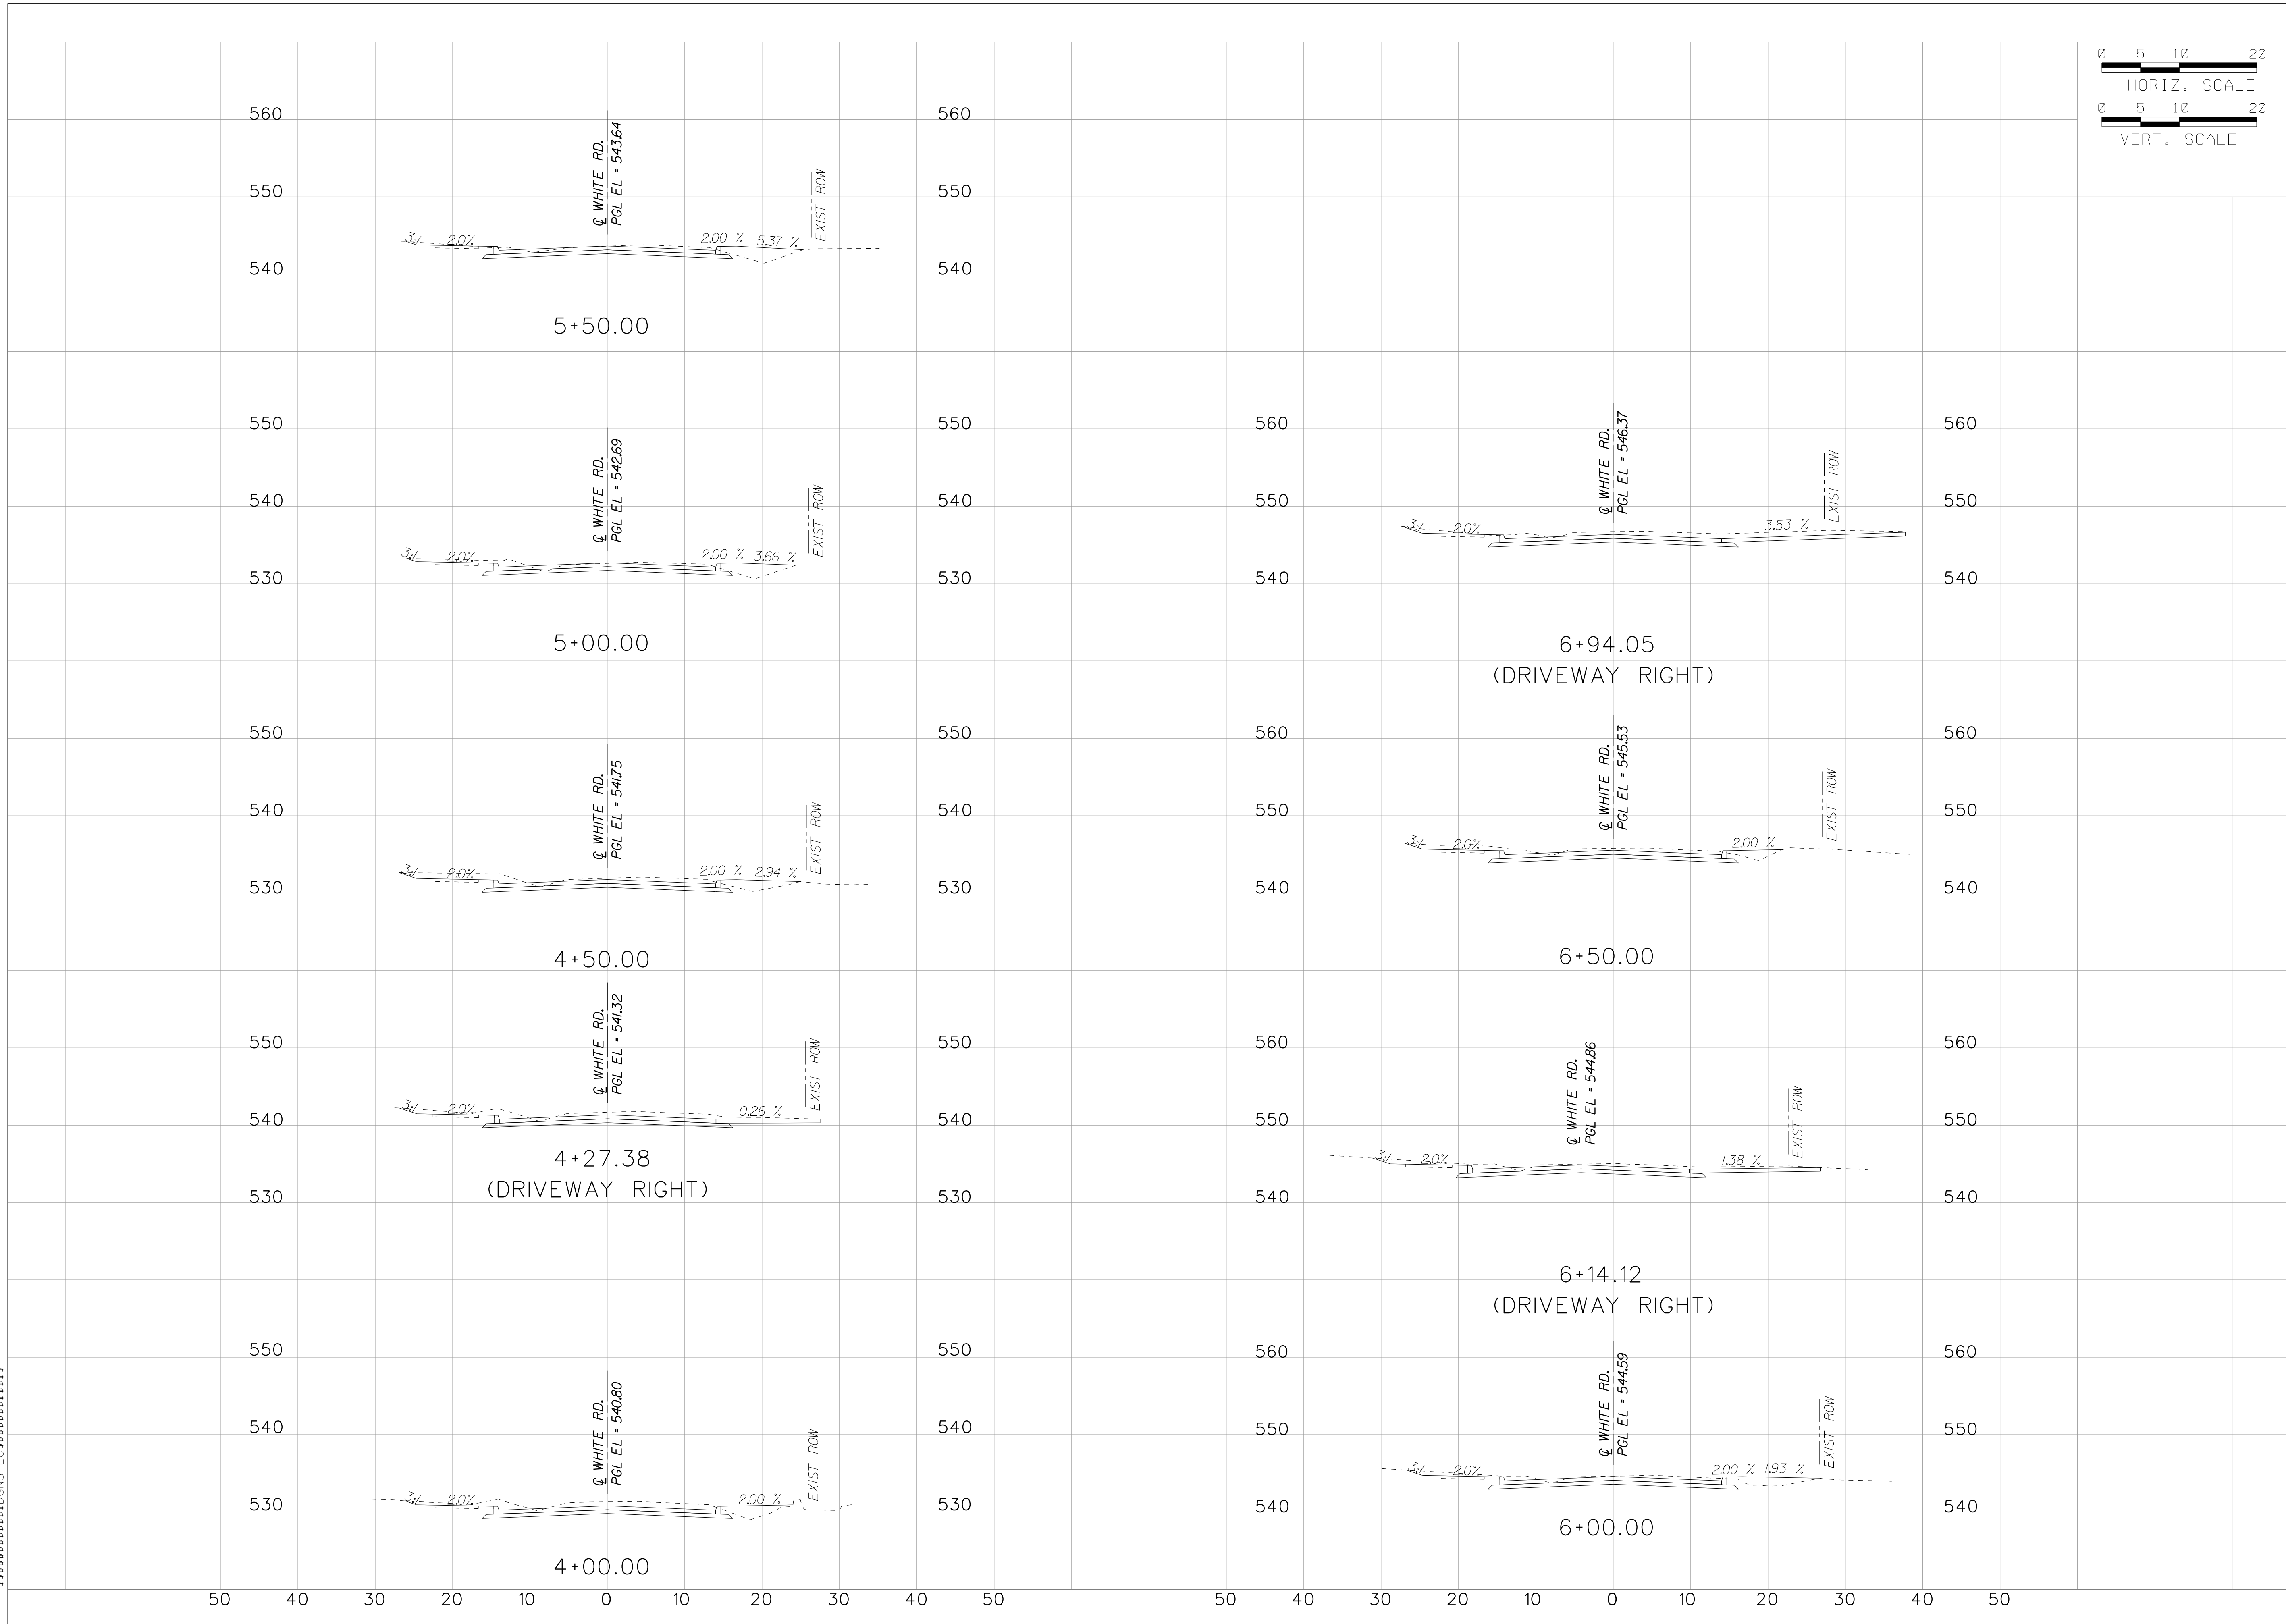

RECORD DRAWING
 THE SEAL THAT ORIGINALLY APPEARED ON THIS DRAWING IS TO REMAIN UNLESS THE ENGINEER HAS BEEN ADVISED BY THE CONTRACTOR WHO PROVIDED THE ORIGINAL DRAWINGS THAT ALL FIELD CHANGES AND DEVIATIONS FROM THE APPROVED RECORD DRAWINGS WERE INCLUDED ON FEBRUARY 22, 2011.

CITY OF ROCKWALL
WHITE ROAD & RANCH TRAIL
WHITE ROAD
CROSS SECTIONS

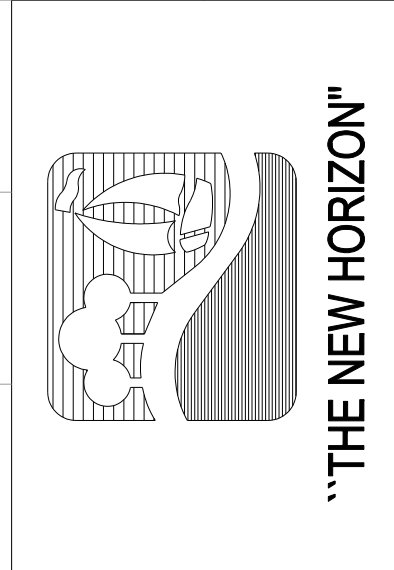

DATE	BY	REVISION	TBPE REG. NO.	DESIGN: CRH / TBS	CHECKED: PBS&J
			#F-474	DRAWN: CRH / TBS	APPROVED: PBS&J
			18383 PRESTON ROAD, SUITE 110		
			DALLAS, TEXAS 75252		
			972-818-7275		
			PBS&J JOB NO.: 52091000		
			DATE: JULY 2009		
			FILE: \$FILES\$		