

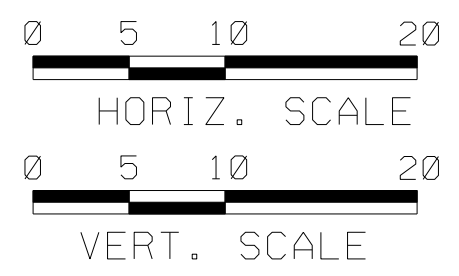


8TIME\$
 \$\$\$SYTIME\$\$\$\$\$
 \$\$\$DONSPEC\$\$\$\$\$

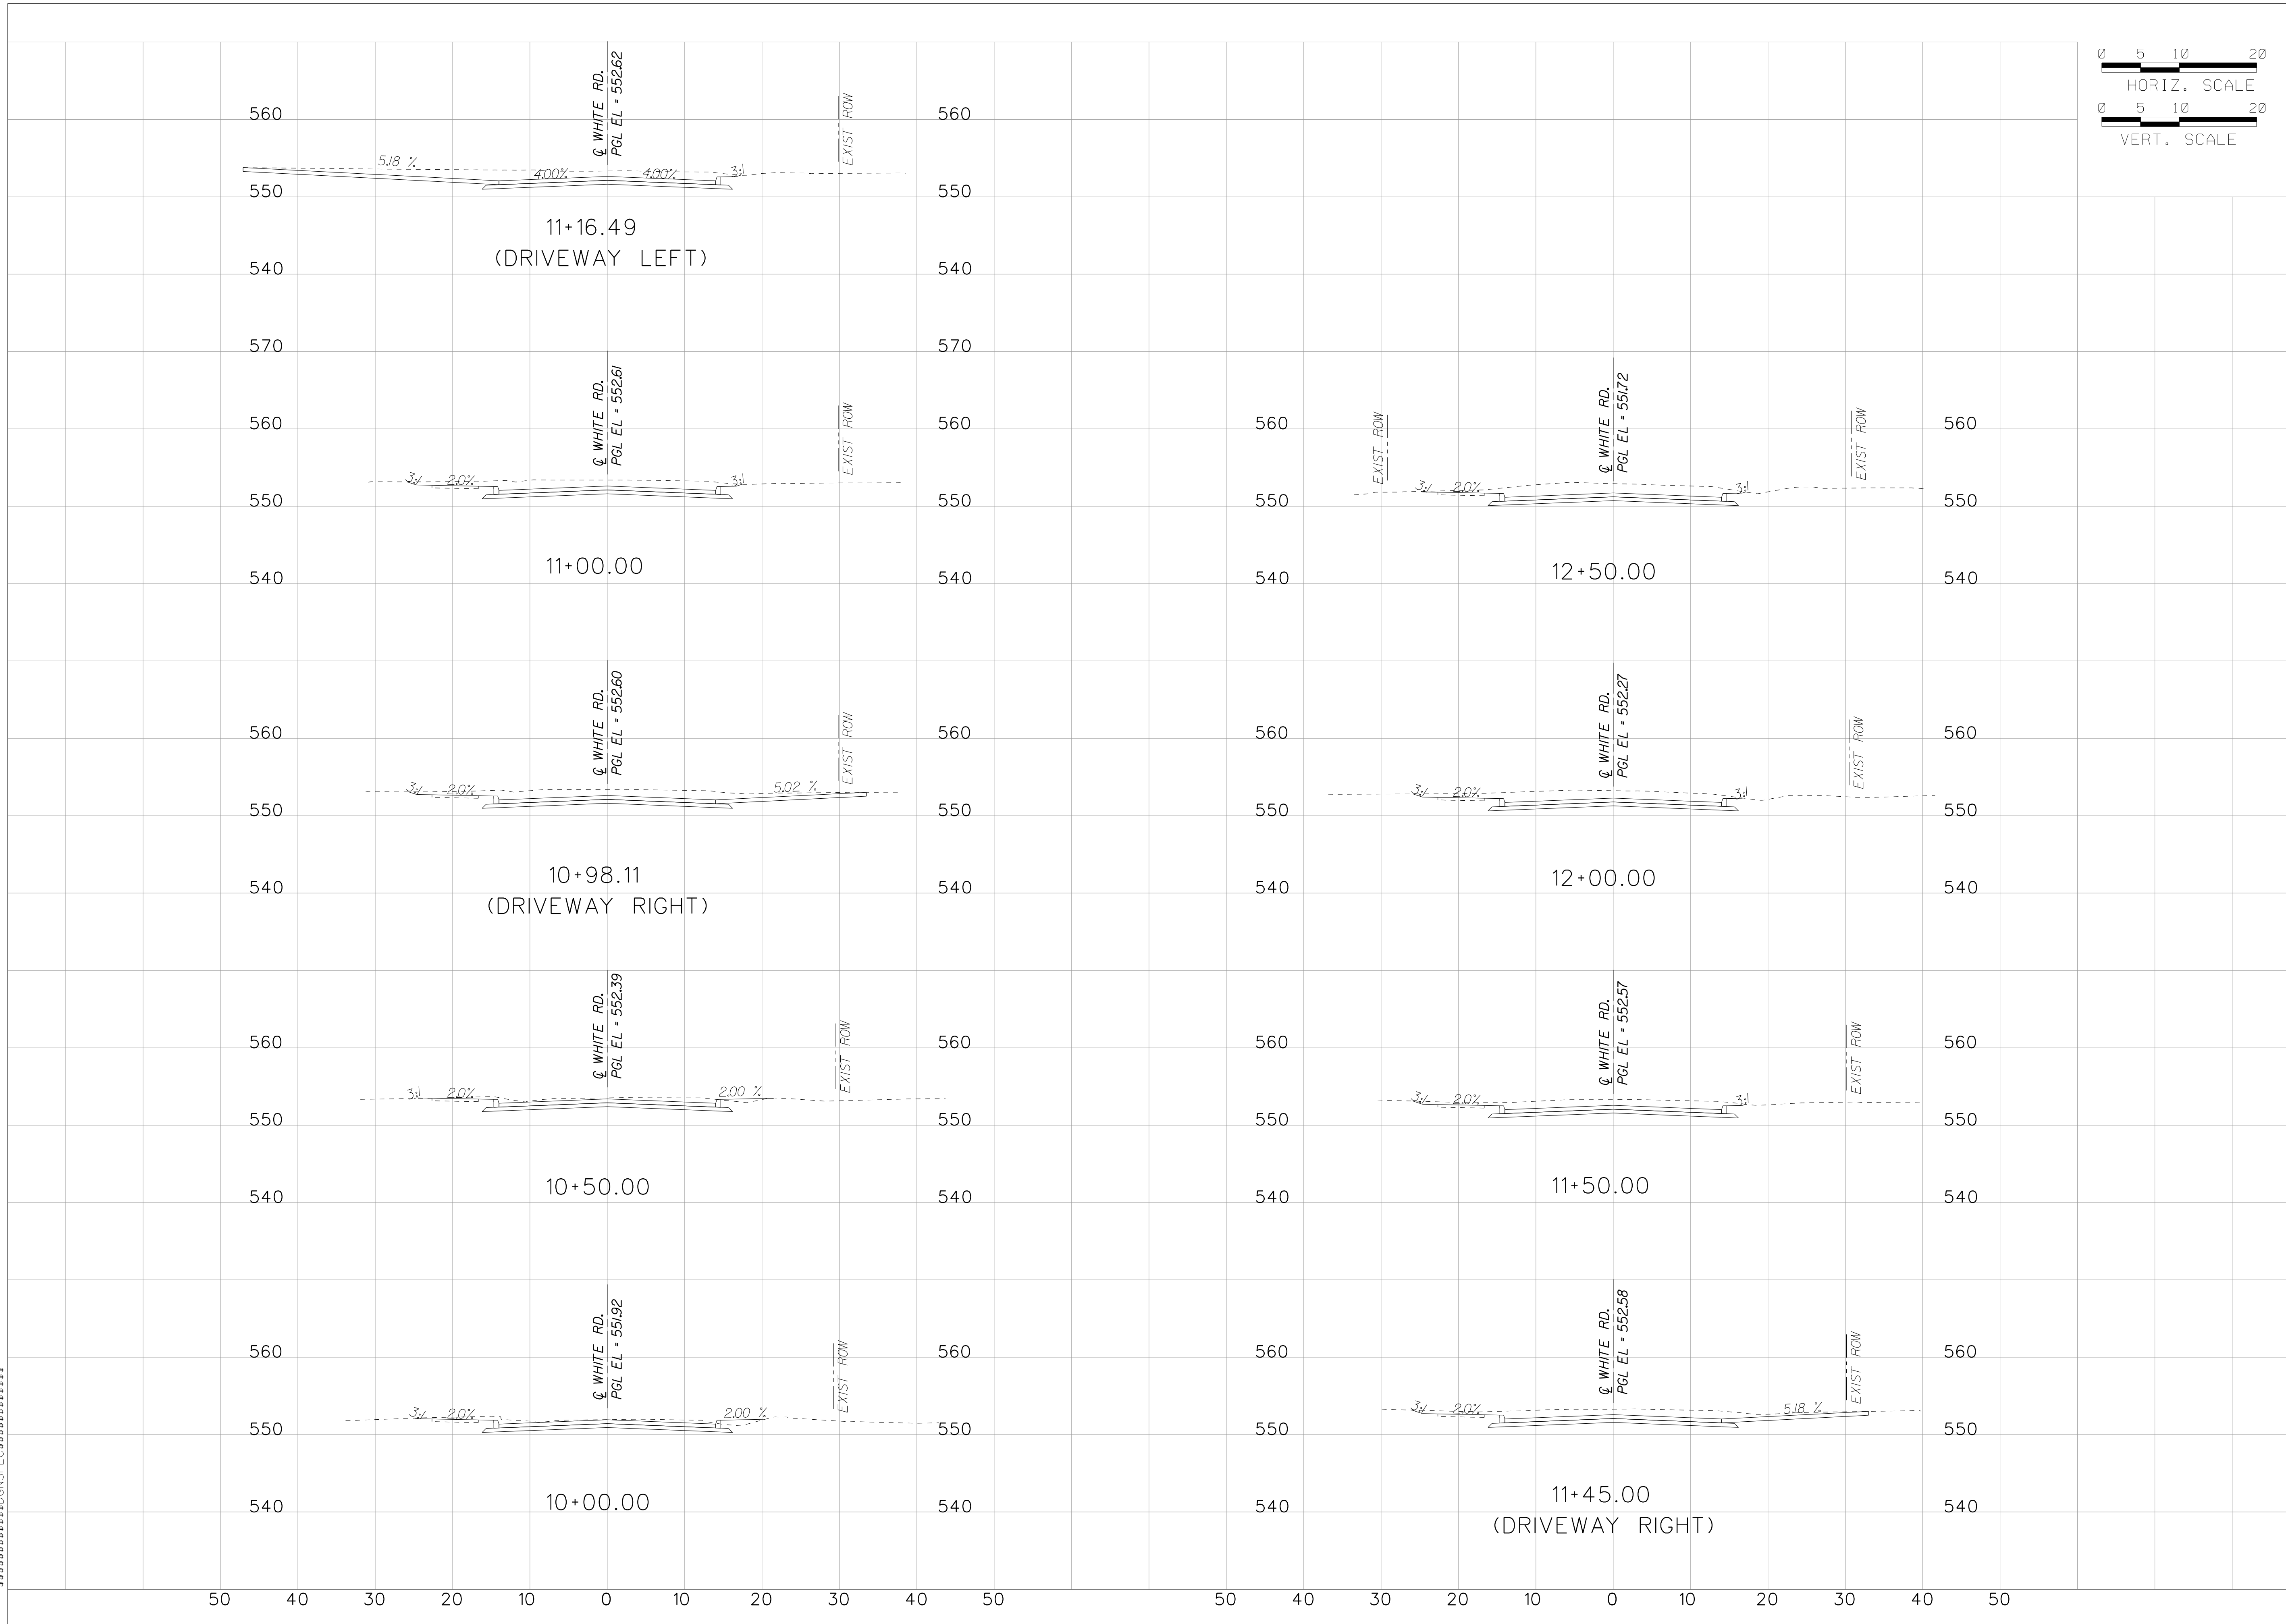

RECORD DRAWING
 THE SEAL THAT ORIGINALLY APPEARED ON THIS DRAWING IS THE SEAL OF THE ENGINEER WHO DESIGNED IT. THIS SEAL IS NOT VALID FOR ANY OTHER PROJECTS. THESE RECORD DRAWINGS WERE PREPARED BY THE CONTRACTOR WHO PROVIDED THE ORIGINAL DRAWINGS. DEVIATIONS FROM THE APPROVED ORIGINAL DRAWINGS WERE INCLUDED ON FEBRUARY 22, 2011.

CITY OF ROCKWALL
WHITE ROAD & RANCH TRAIL
WHITE ROAD
CROSS SECTIONS

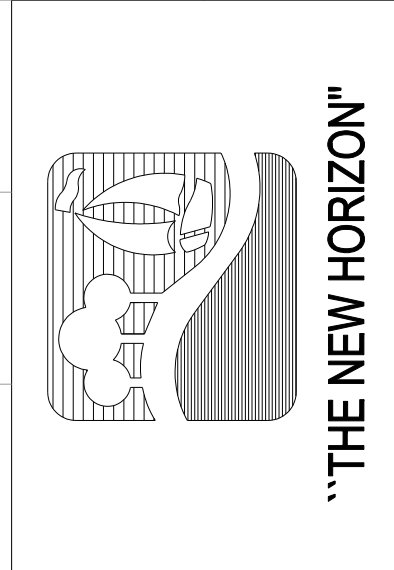

DATE	BY	REVISION	TYPE REC. NO.
			#-474
			18383 PRESTON ROAD, SUITE 110
			DALLAS, TEXAS 75252
			972-818-7275
			PBS&J JOB NO.: 52091000
			DATE: JULY 2009
			FILE: \$FILES\$
			DESIGN: CRH / TBS
			DRAWN: CRH / TBS
			CHECKED: PBS&J
			APPROVED: PBS&J