

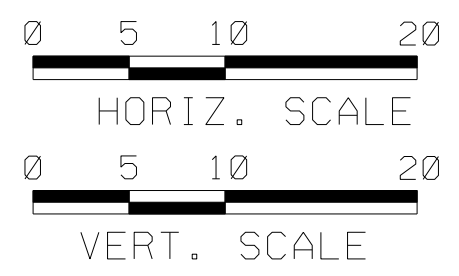


8TIME\$  
 \$\$\$SYTIME\$\$\$\$\$  
 \$\$\$DONSPEC\$\$\$\$\$

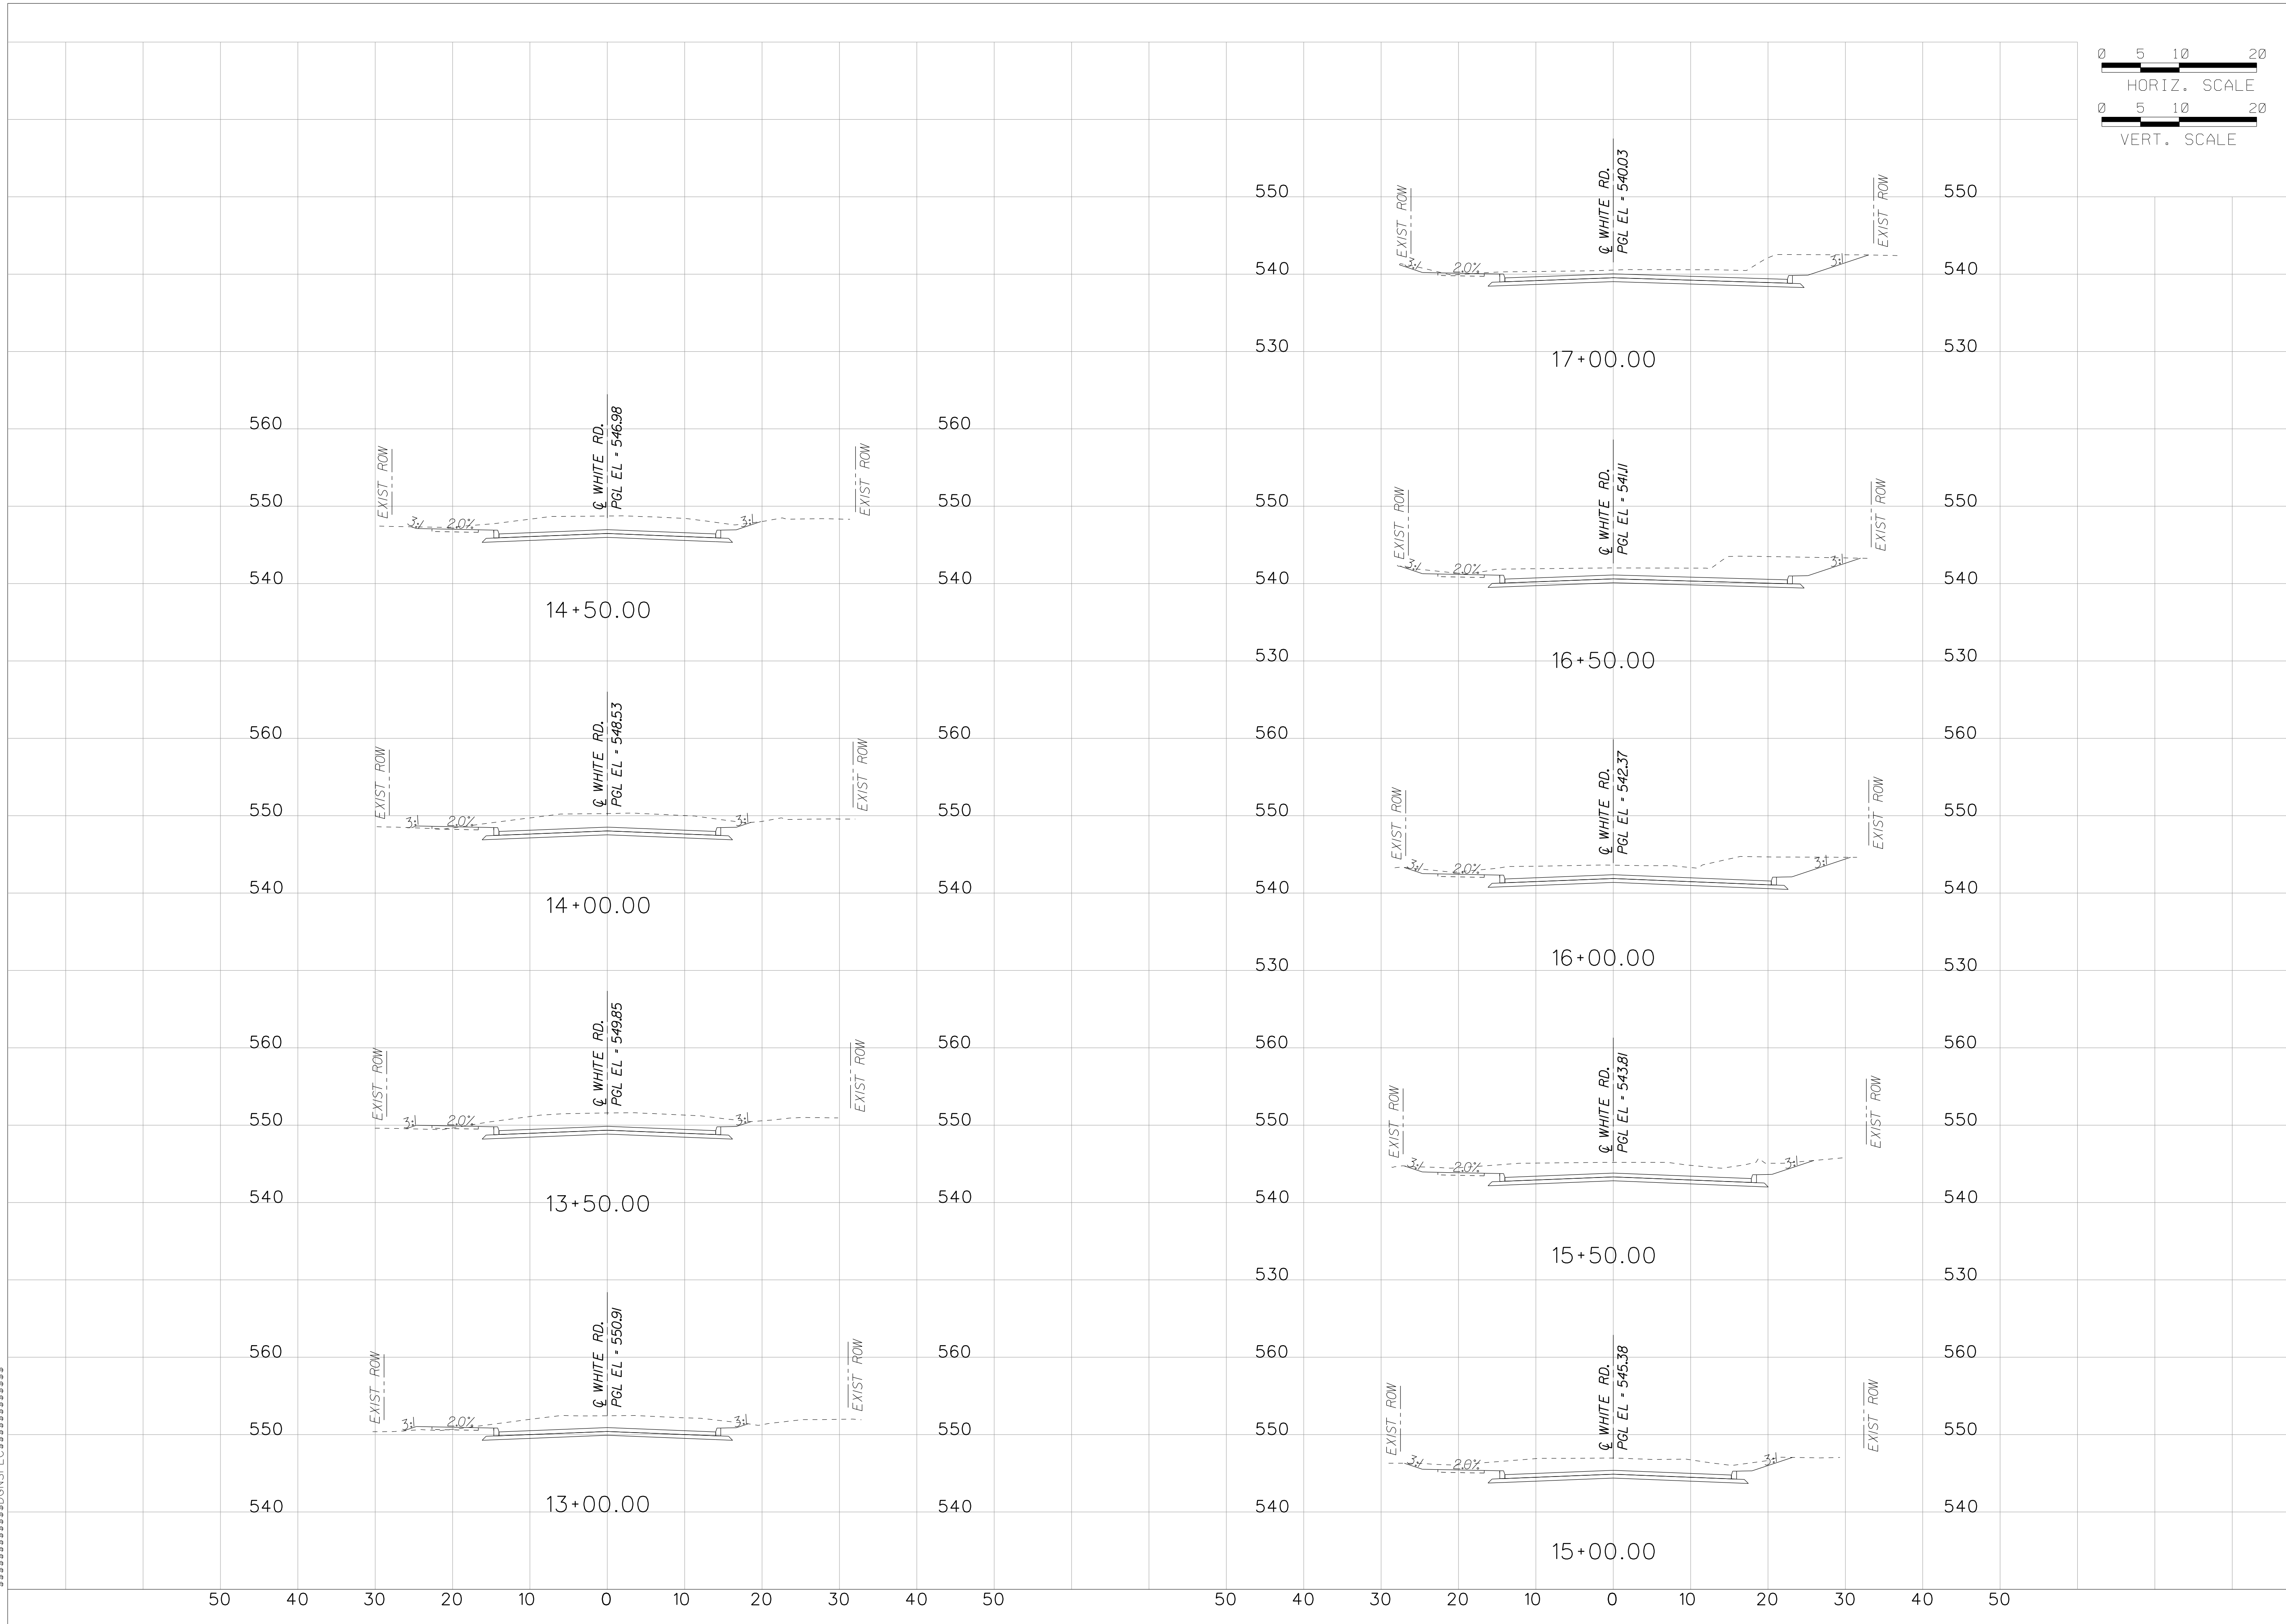

**RECORD DRAWING**  
 THE SEAL THAT ORIGINALLY APPEARED ON THIS DRAWING IS TO REMAIN UNLESS THE CONTRACTOR HAS BEEN ADVISED BY THE CONTRACTOR WHO PROVIDED THE ORIGINAL DRAWINGS THAT ALL FIELD CHANGES AND DEVIATIONS FROM THE APPROVED DESIGNATION DRAWINGS WERE INCLUDED ON FEBRUARY 22, 2011.

**CITY OF ROCKWALL**  
**WHITE ROAD & RANCH TRAIL**  
**WHITE ROAD**  
**CROSS SECTIONS**

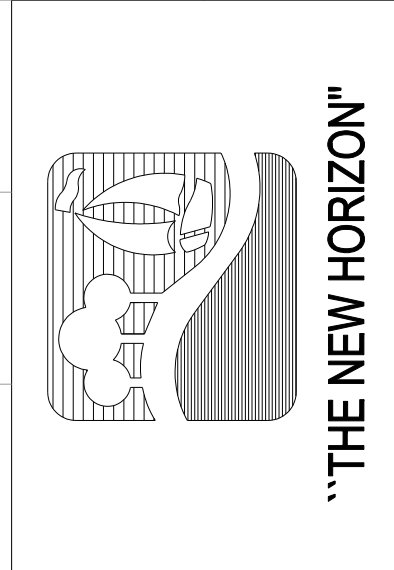

TYPE	REC. NO.	DATE
BY		
REVISION		
DESIGN: CRH / TBS	CHECKED: PESSJ	
DRAWN: CRH / TBS	APPROVED: PESSJ	

18383 PRESTON ROAD, SUITE 110  
 DALLAS, TEXAS 75252  
 972-818-7275  
 PB&J JOB NO.: 52091000  
 DATE: JULY 2009  
 FILE: \$FILES\$