

**RECORD DRAWING**

THE SEAL THAT ORIGINALLY APPEARED ON THIS DRAWING IS TO BE REPRODUCED ON THIS RECORD DRAWING.



THESE RECORD DRAWINGS WERE PREPARED BY THE CONTRACTOR WHO OBTAINED THE PERMITS AND REPRESENTS THAT ALL FIELD CHANGES AND DEVIATIONS FROM THE APPROVED CONSTRUCTION DRAWINGS WERE INCLUDED ON FEBRUARY 22, 2011.

**CITY OF ROCKWALL**

**WHITE ROAD & RANCH TRAIL**

**RANCH TRAIL**

**PAVEING STA 1+00 TO 4+75**

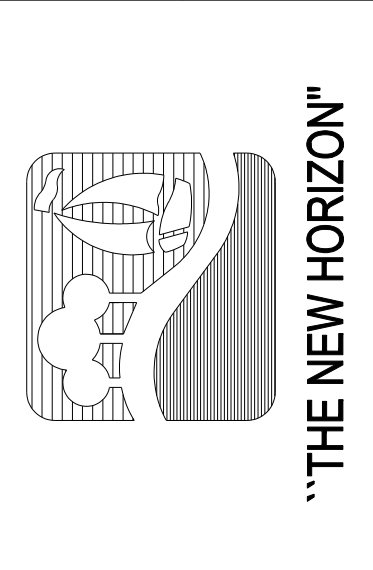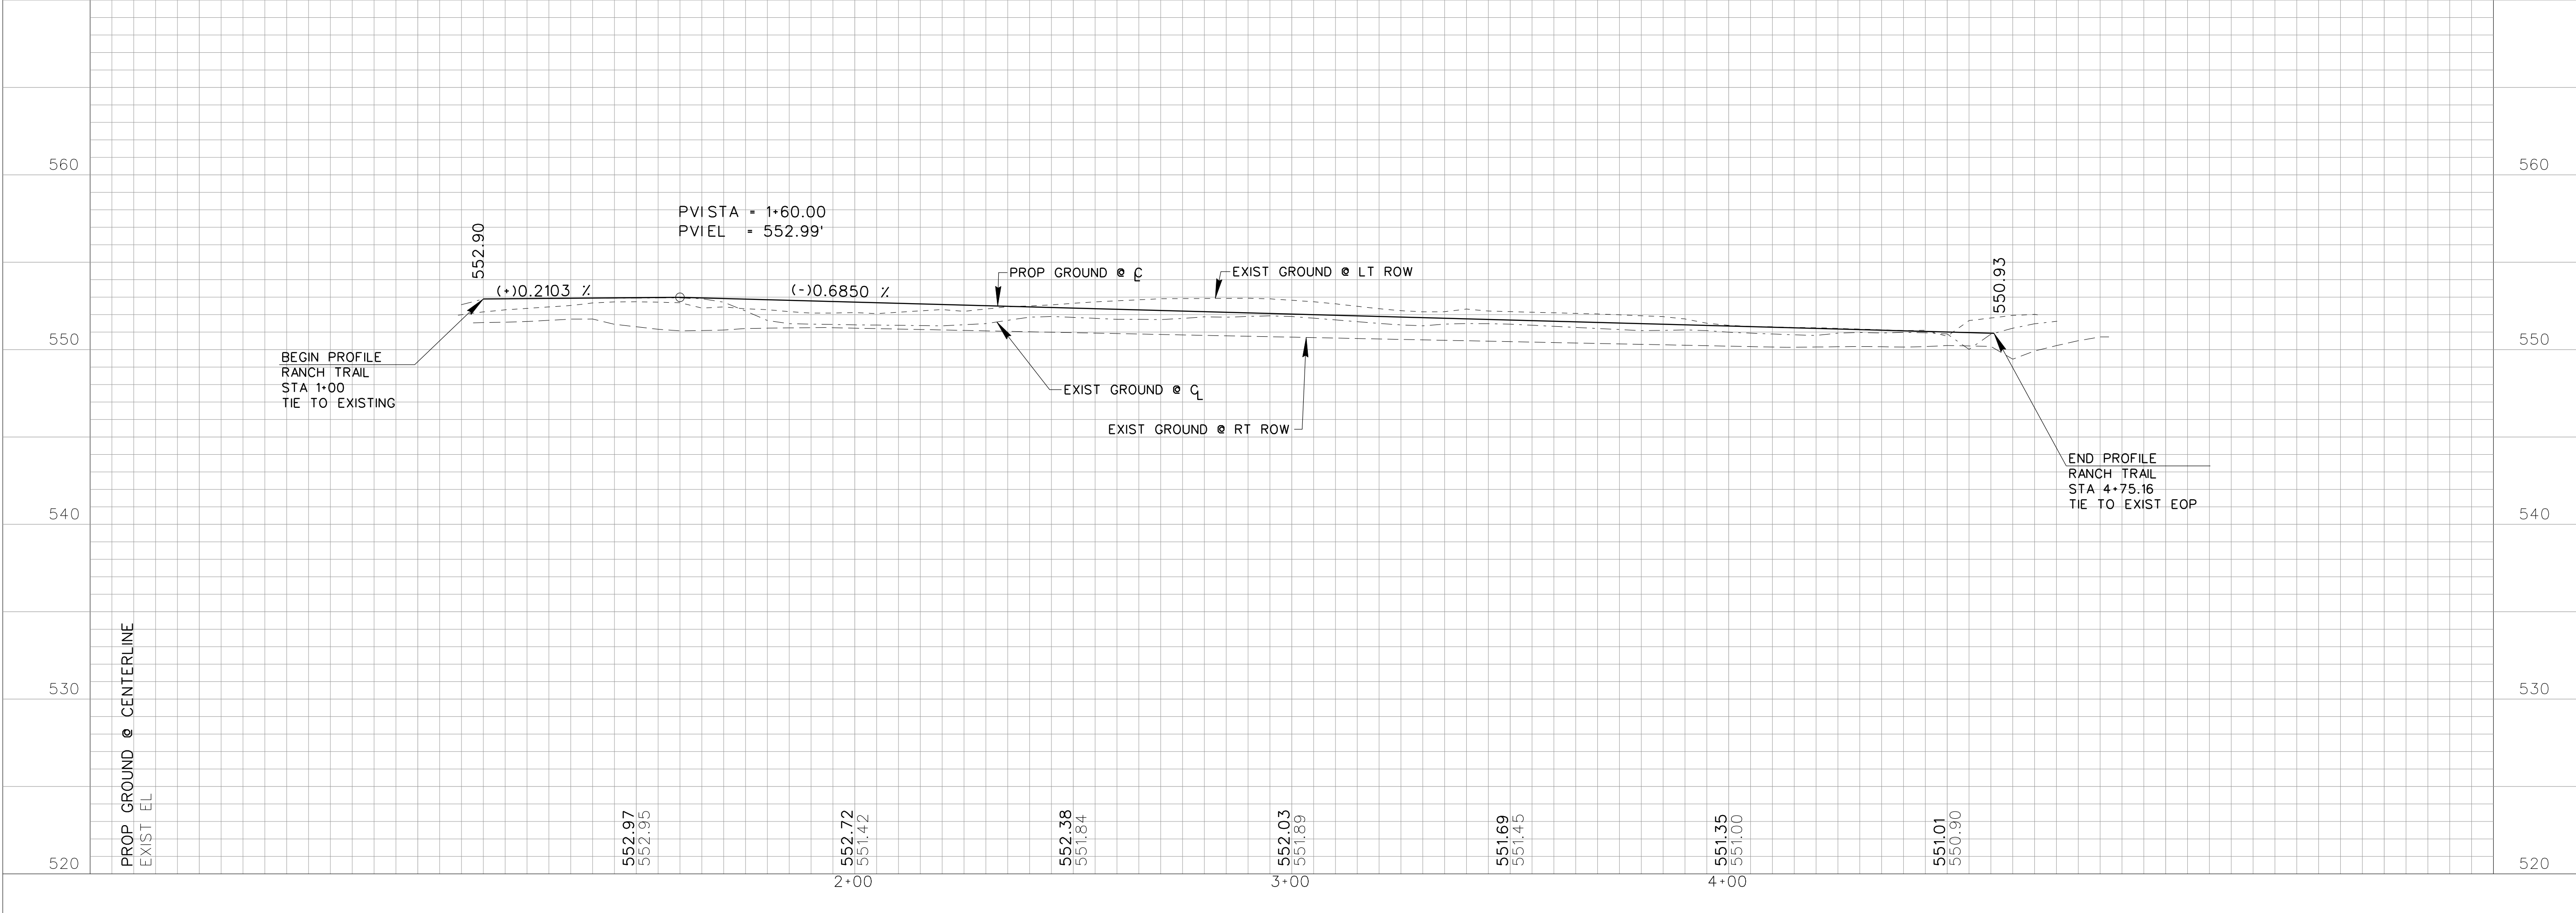

NO.	REVISION	BY	DATE

DESIGN: CRH / TBS	CHECKED: PBS&J
DRAWN: CRH / TBS	APPROVED: PPS&J

TBPE REG. NO. #F-474	DATE: JULY 2009
18383 PRESTON ROAD, SUITE 110 DALLAS, TEXAS 75252	FILE: \$FILES\$

8 TIMES \$\$\$\$\$\$SYTIME\$\$\$\$\$\$  
 \$\$\$\$\$\$SYTIME\$\$\$\$\$\$  
 \$\$\$\$\$\$SYTIME\$\$\$\$\$\$