




STIME\$  
 \$\$\$SYTIME\$\$\$\$\$  
 \$\$\$DONSPEC\$\$\$\$\$

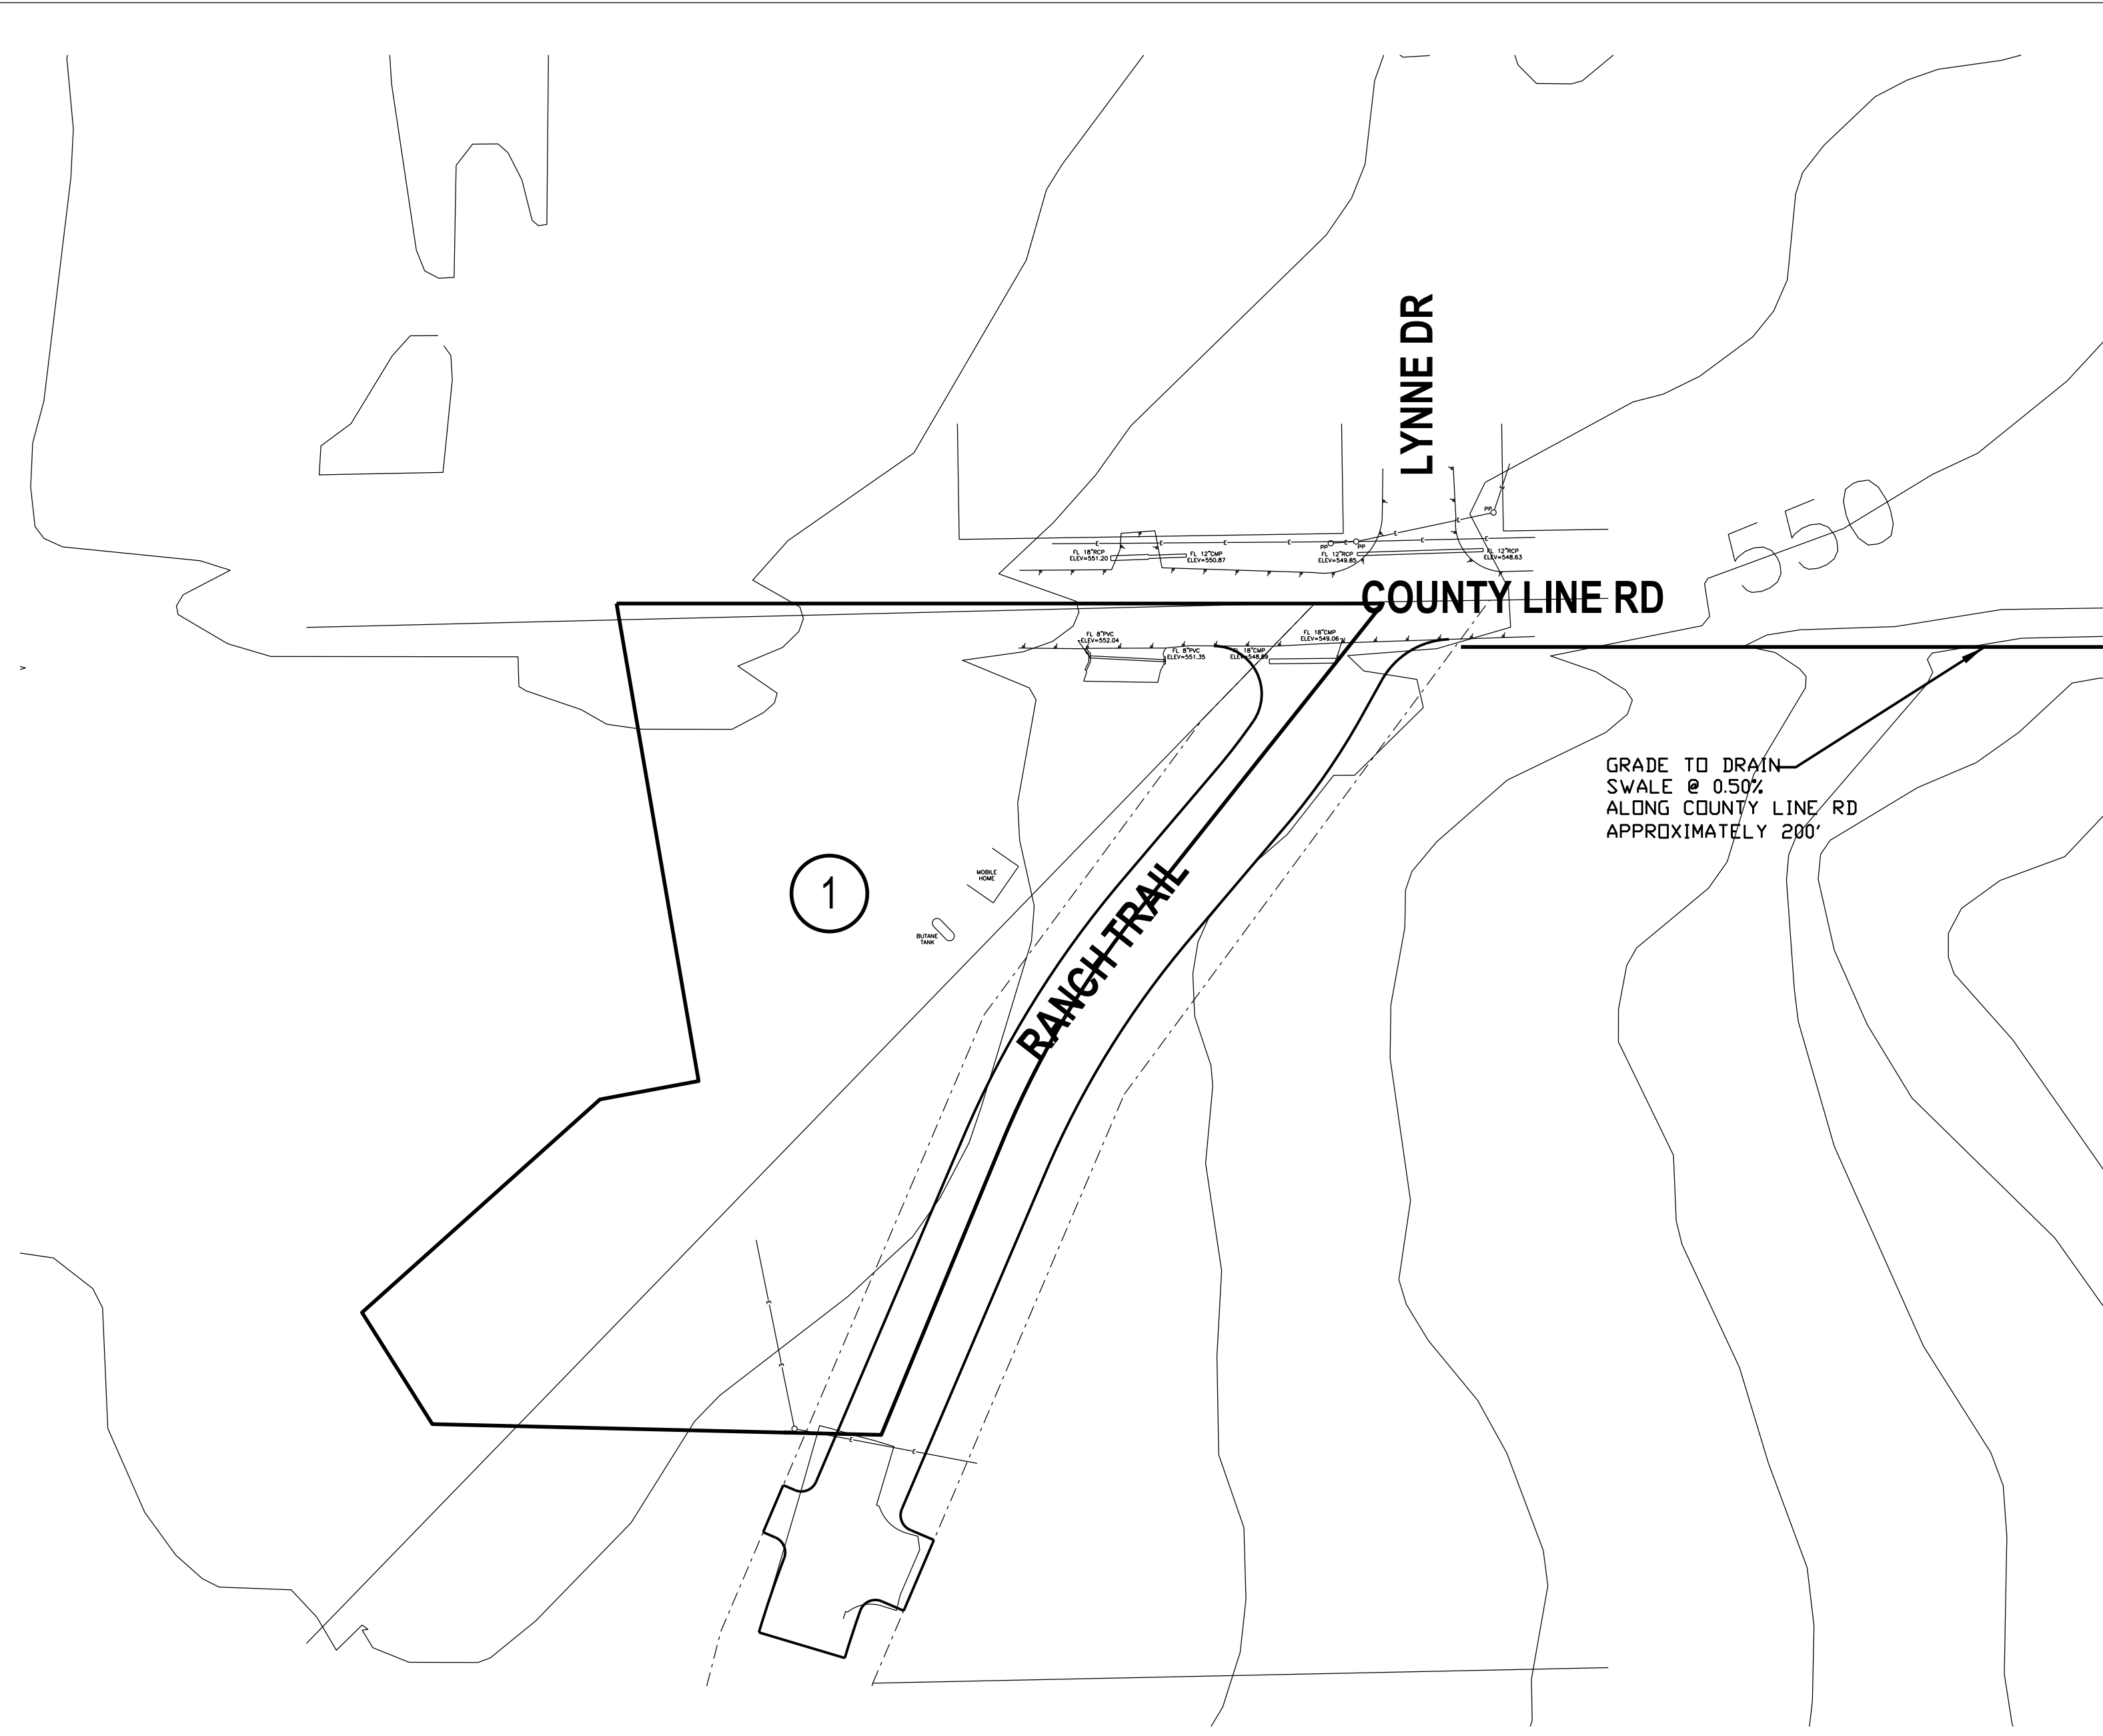

DRAINAGE AREA CALCULATIONS				
AREA	C	I	A	Q100
1	0.5	9.8	0.96	4.70

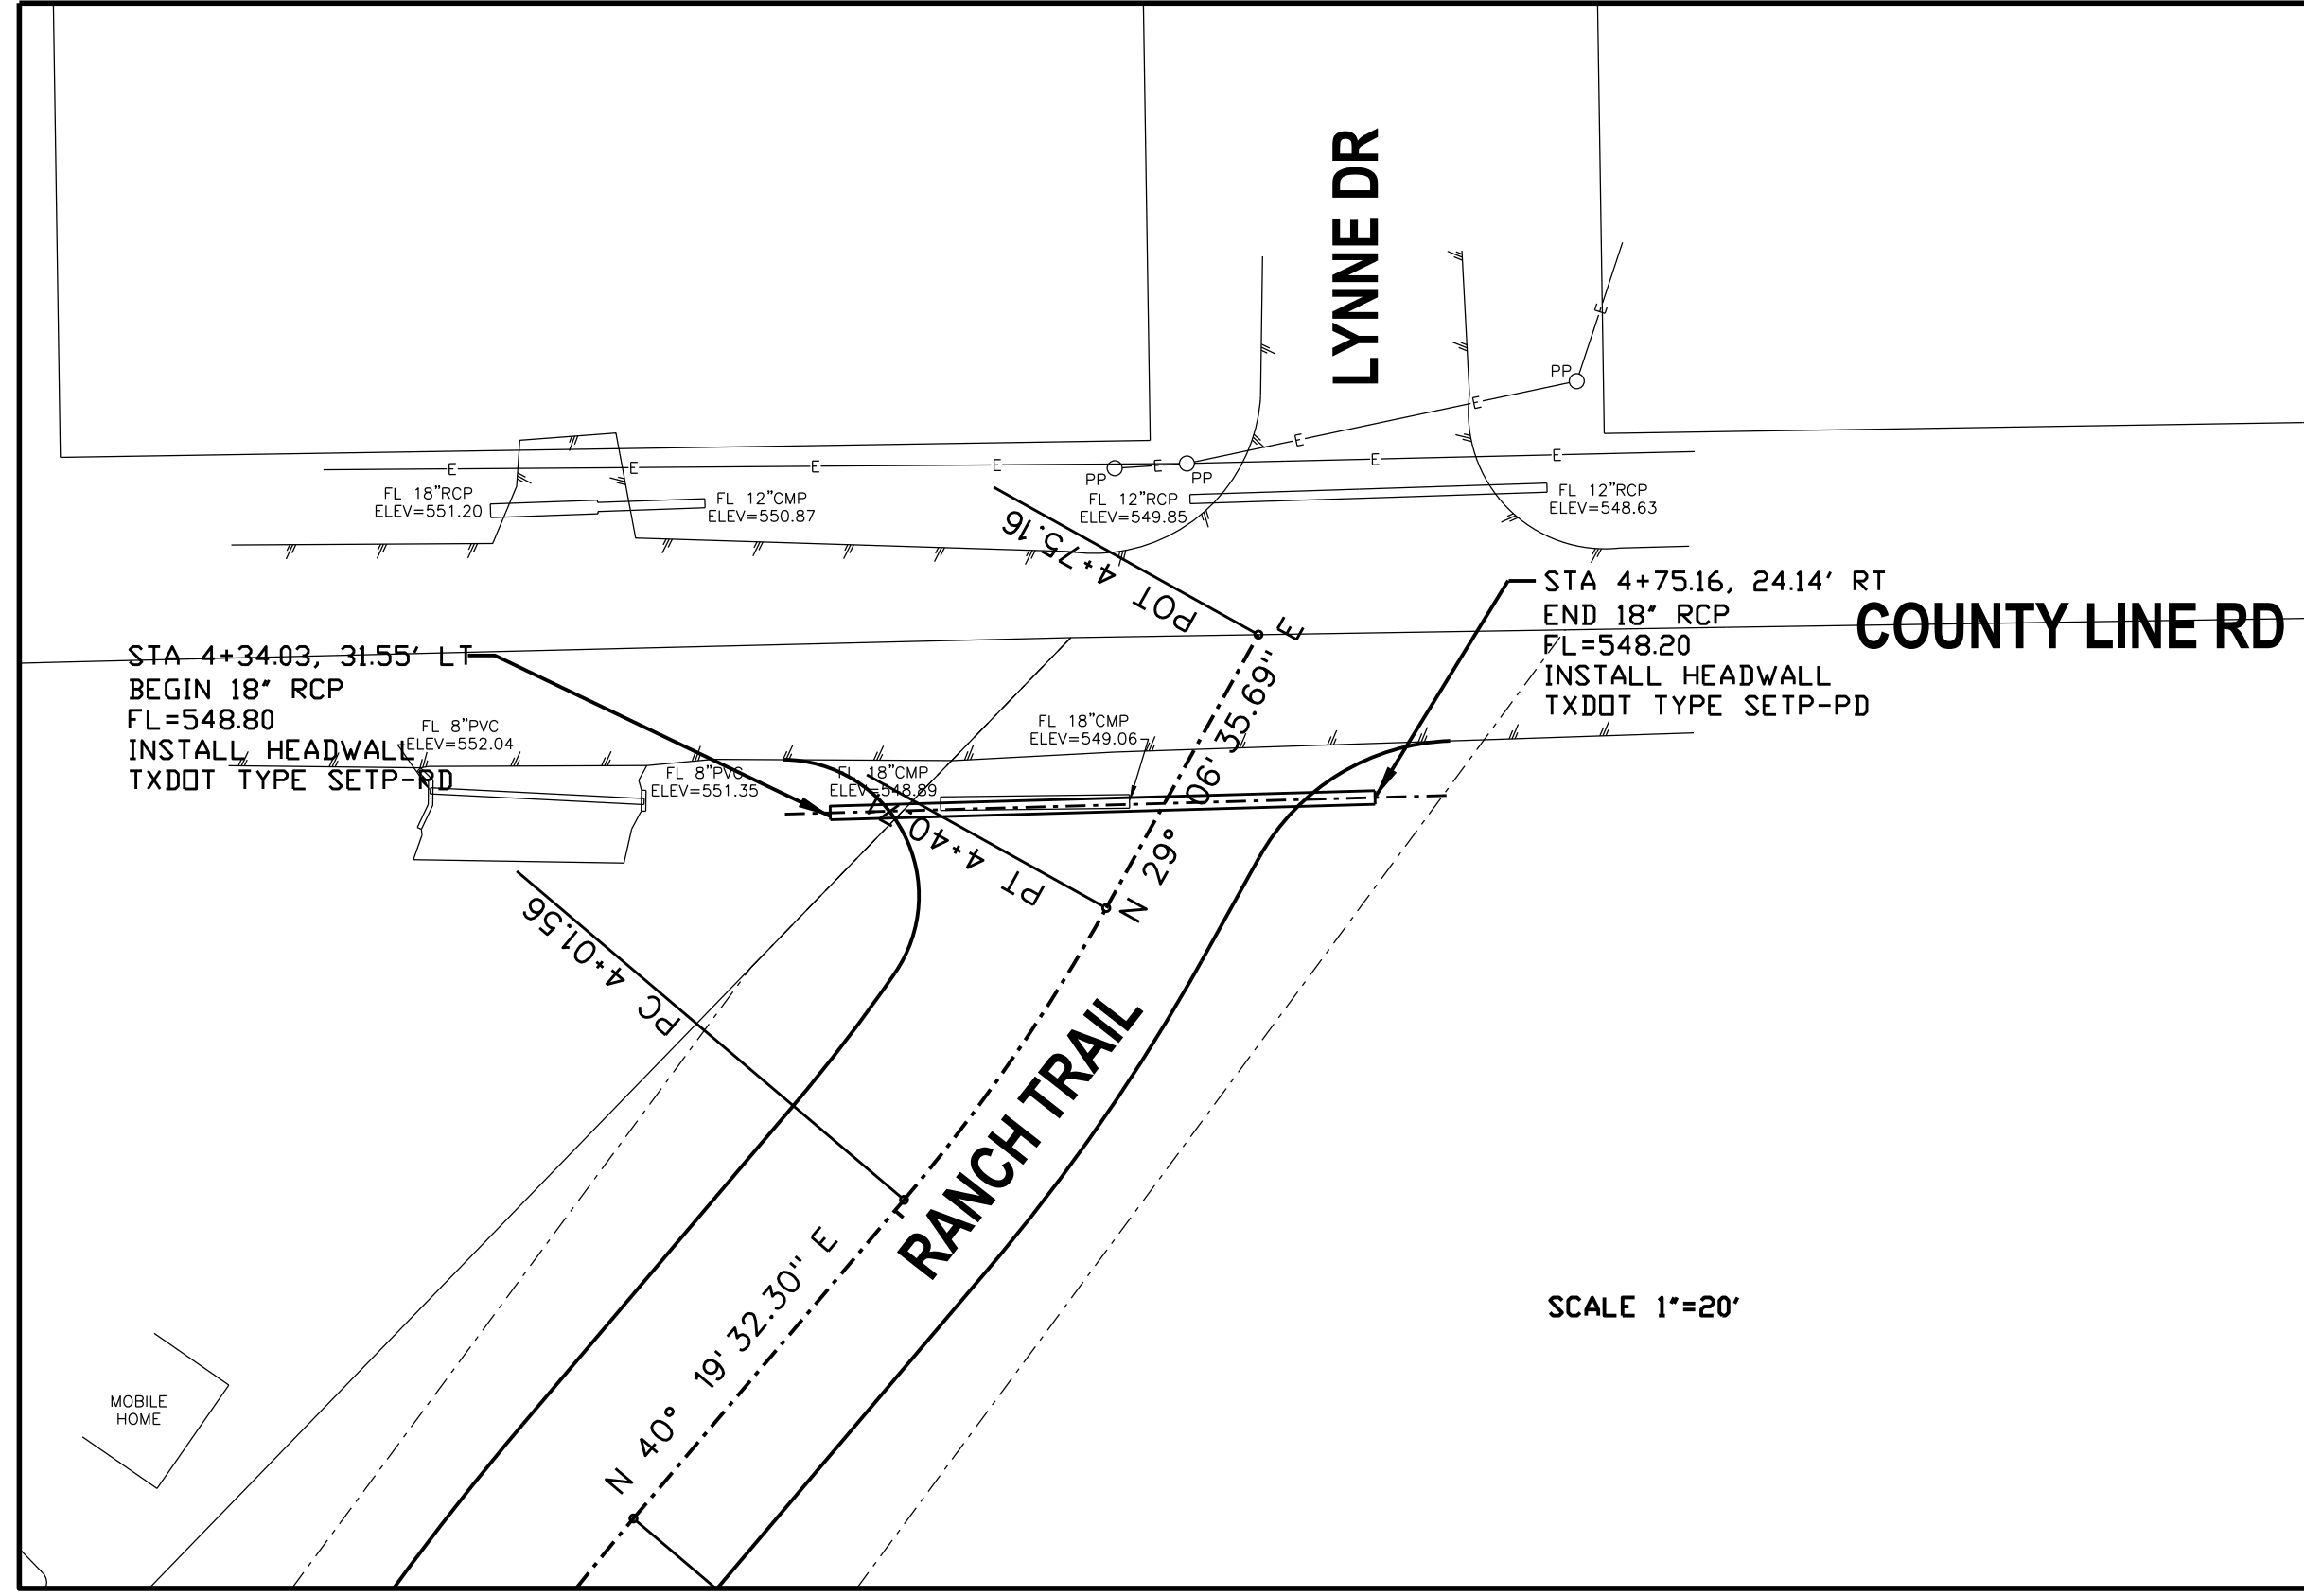


SCALE 1"=20'

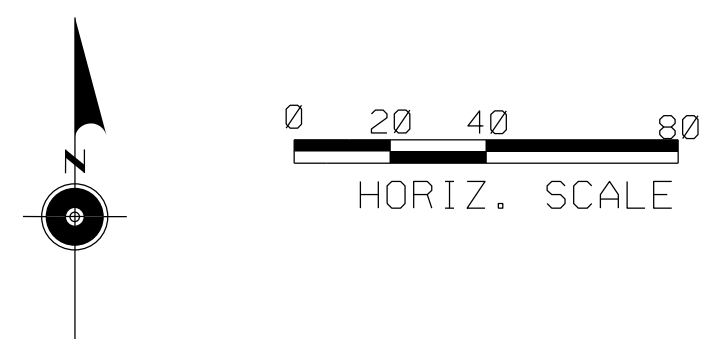

**RECORD DRAWING**  
 THE SEAL THAT ORIGINALLY APPEARED ON THIS DRAWING IS THE ONLY VALID SEAL FOR THIS PROJECT. THESE RECORD DRAWINGS WERE PREPARED BY THE CONTRACTOR WHO PROVIDED THE ORIGINAL DRAWINGS. DEVIATIONS FROM THE APPROVED CONSTRUCTION DRAWINGS WERE INCLUDED ON FEBRUARY 22, 2011.

CITY OF ROCKWALL  
 WHITE ROAD & RANCH TRAIL  
 RANCH TRAIL  
 DRAINAGE AREA MAP

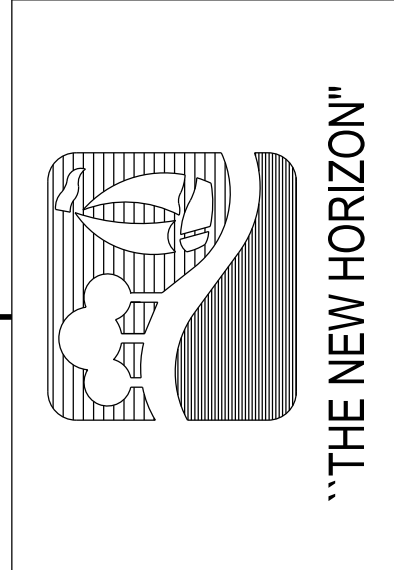

TYPE REG. NO.	DATE	BY	REVISION	CHECKED:	APPROVED:
474				PBS&J	PBS&J
18383 PRESTON ROAD, SUITE 110 DALLAS, TEXAS 75252 972-818-7275 PBS&J JOB NO.: 52091000 DATE: JULY 2009 FILE: \$FILES\$					