


PEBBLEBROOK APARTMENTS
PHASE TWO
LOT 1 BLOCK A
SLIDE B PAGE 45-46

ROW BY SEPARATE INSTRUMENT
VOL. 479 PAGE 14
TRACT 3

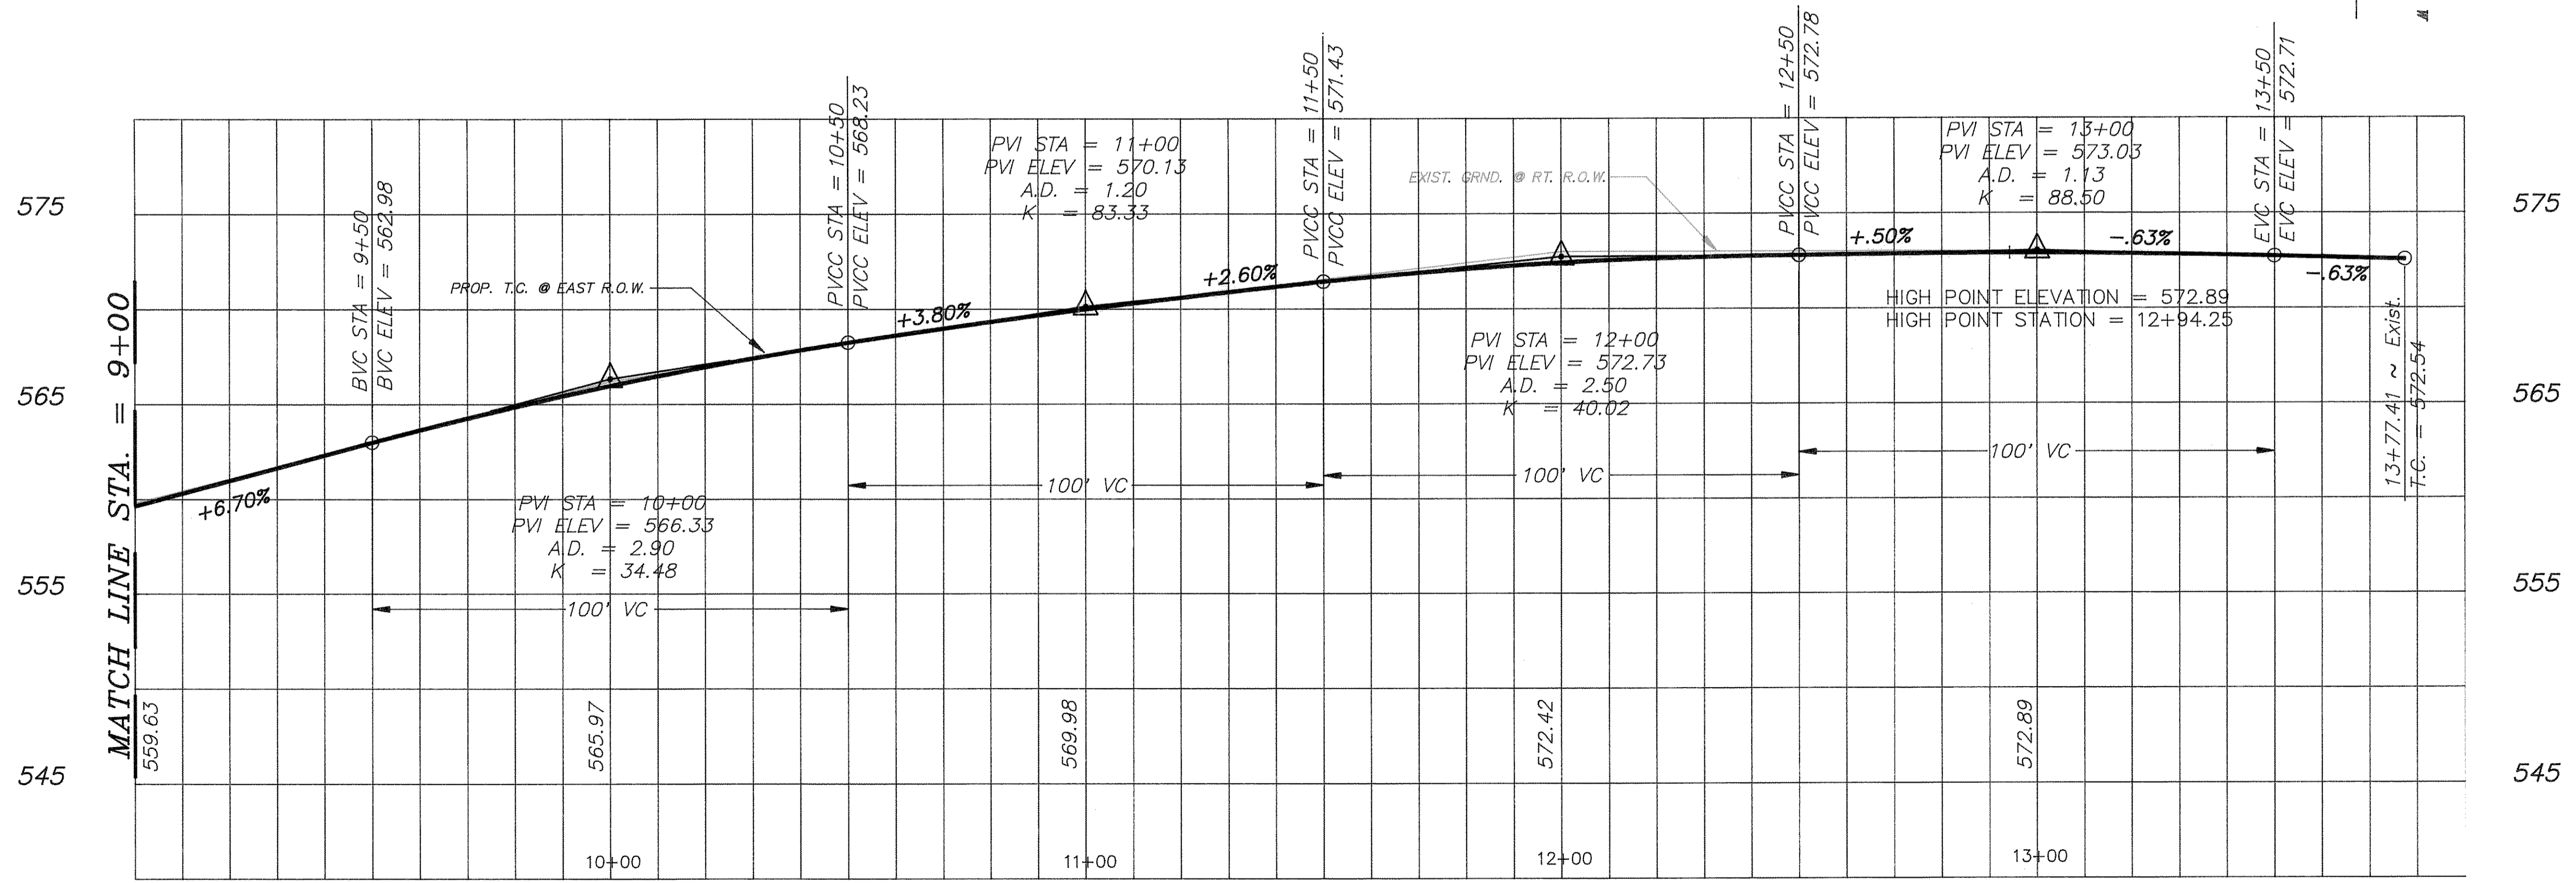

BENCHMARK:
TOP OPERATING NUT OF FIRE HYDRANT
@ SOUTHEAST CORNER OF KYLE DRIVE
& YELLOWJACKET LANE INTERSECTION.
ELEV. = 529.27

PAVING IMPROVEMENTS
YELLOWJACKET LANE
ROCKWALL, TEXAS
CITY OF ROCKWALL
"THE NEW HORIZON"

REVISION NO.	REMARKS	DATE

DESIGNED: B.W.H.
DRAWN: ACAD
JOB NO. DATE: 4/93 SHEET NO. 4 OF 12

