


Revision	Date	Description

Owner:  
**City of McLendon-Chisholm**  
 1248 S. Hwy. 205 • McLendon-Chisholm, TX • 75032  
 Phone: 972-524-2077

**City of McLendon-Chisholm**  
**SANITARY SEWER MAIN**

**F.C. CUNY CORPORATION**  
 #2 Horizon Court • Ste. 500 • Heath, Texas 75032  
 Phone: 469-402-7700  
 Fax: 469-402-0700  
 Texas Registered Engineering Firm F-7449

THE SEAL APPEARING ON THIS DOCUMENT WAS AUTHORIZED BY CHRISTOPHER R. CUNY, P.E. 65642

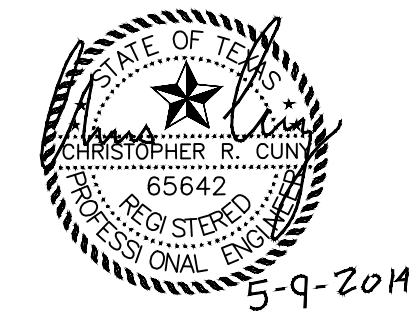

Drawn By: FC CUNY	Checked By: FC CUNY
Date: 12-12	Project No.: 08-007

Sheet Title:  
**Offsite Sanitary Sewer**  
**Sta. 136+00 to Sta. 166+00**

Scale: 1"=100'	Sheet No.: 7 of 12
-------------------	-----------------------

RECORD DRAWING