



8" SANITARY SEWER MAIN
TO BE INSTALLED 8' FROM
TXDOT R.O.W. (TYP.) SEE
DETAIL ON SHEET 1


Lewis

F.M. 550

8" SS FORCE MAIN

LEGEND

- EX. CONTOURS
- PROPOSED SANITARY SEWER MAIN
- - - EX. RIGHT-OF-WAY

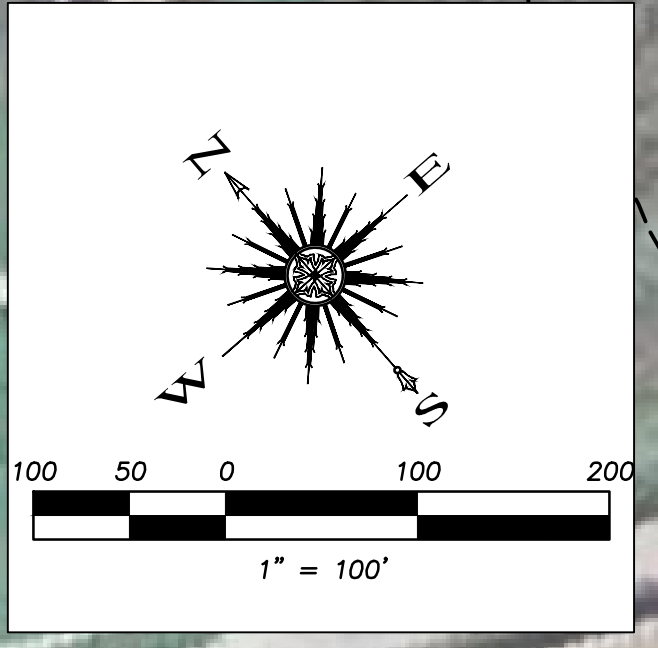


Revision	Date	Description

Owner:
City of McLendon-Chisholm
1248 S. Hwy. 205 • McLendon-Chisholm, TX • 75032
Phone: 972-524-2077

City of McLendon-Chisholm
SANITARY SEWER MAIN

F.C. CUNY CORPORATION
#2 Horizon Court • Ste. 500 • Heath, Texas 75032
Phone: 469-402-7700
Fax: 469-402-0700
Texas Registered Engineering Firm F-7449


THE SEAL APPEARING ON THIS DOCUMENT WAS AUTHORIZED BY CHRISTOPHER R. CUNY, P.E. 65642

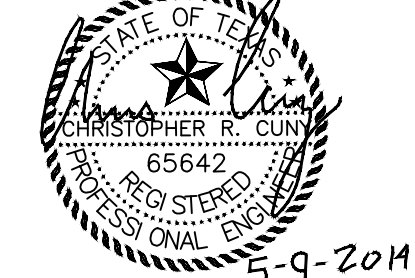

Drawn By: FC CUNY	Checked By: FC CUNY
Date: 12-12	Project No.: 08-007

Sheet Title:
**Offsite Sanitary Sewer
Sta. 194+00 to Sta. 224+00**

Scale: 1"=100'	Sheet No.: 9 of 12
-------------------	-----------------------

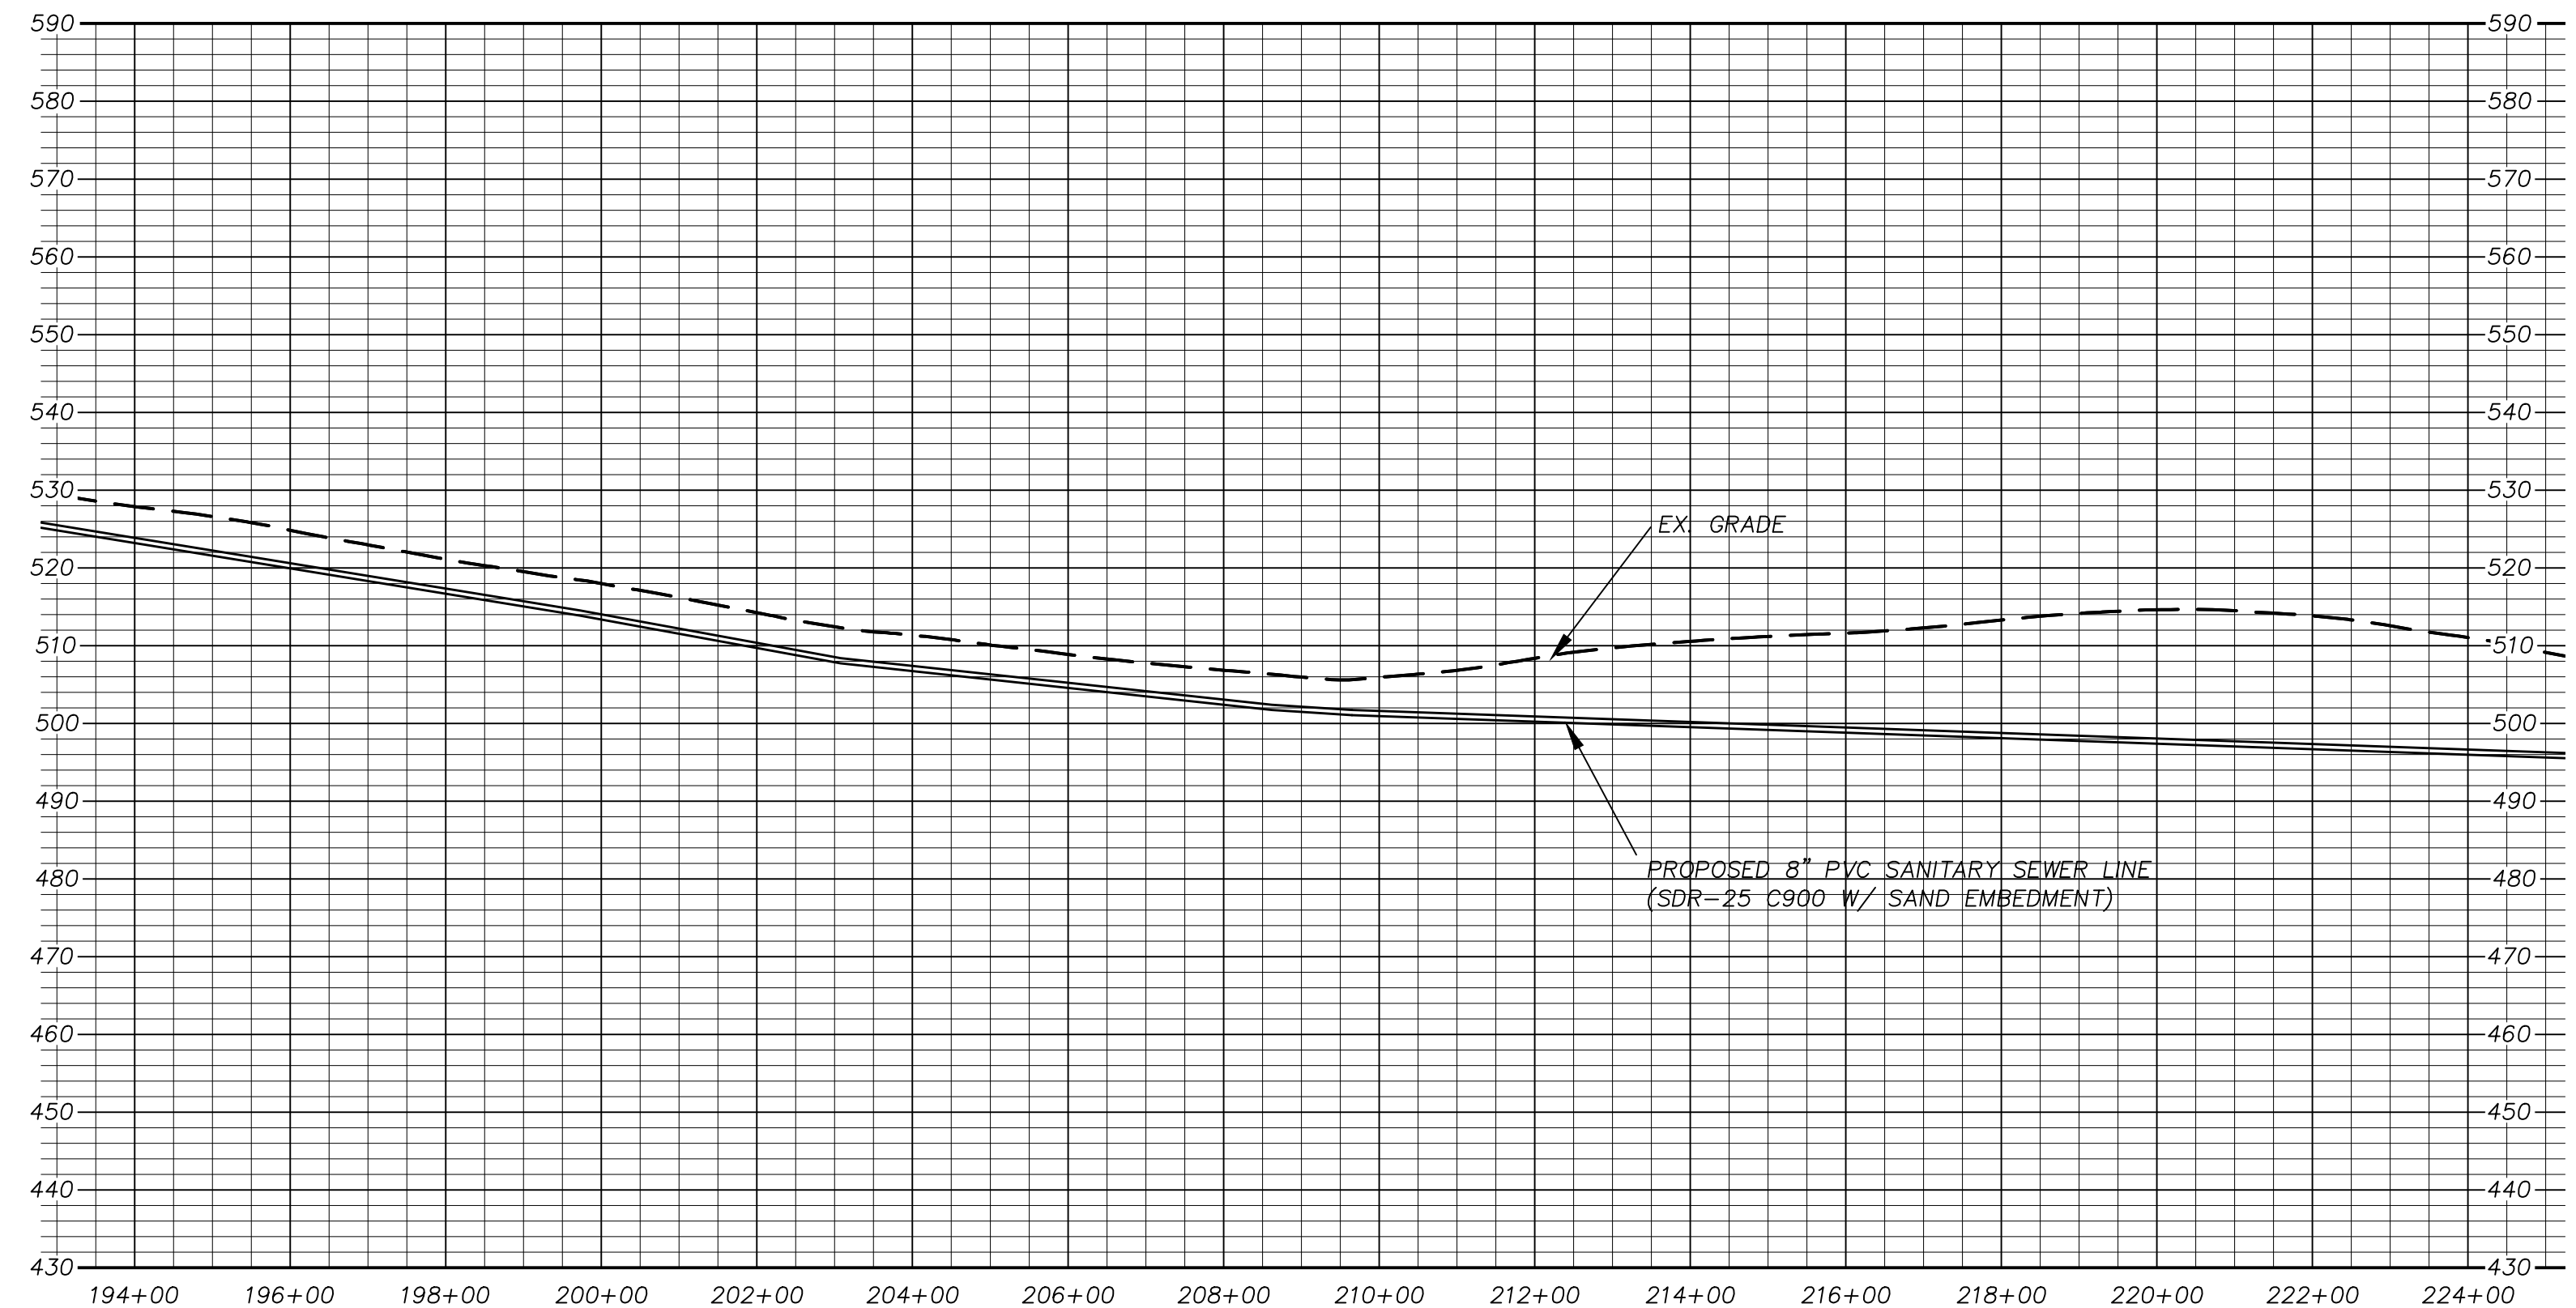

V: 1"=20'
H: 1"=200'

RECORD DRAWING