



1785 E. I 30
 ROCKWALL, TEXAS
 75087

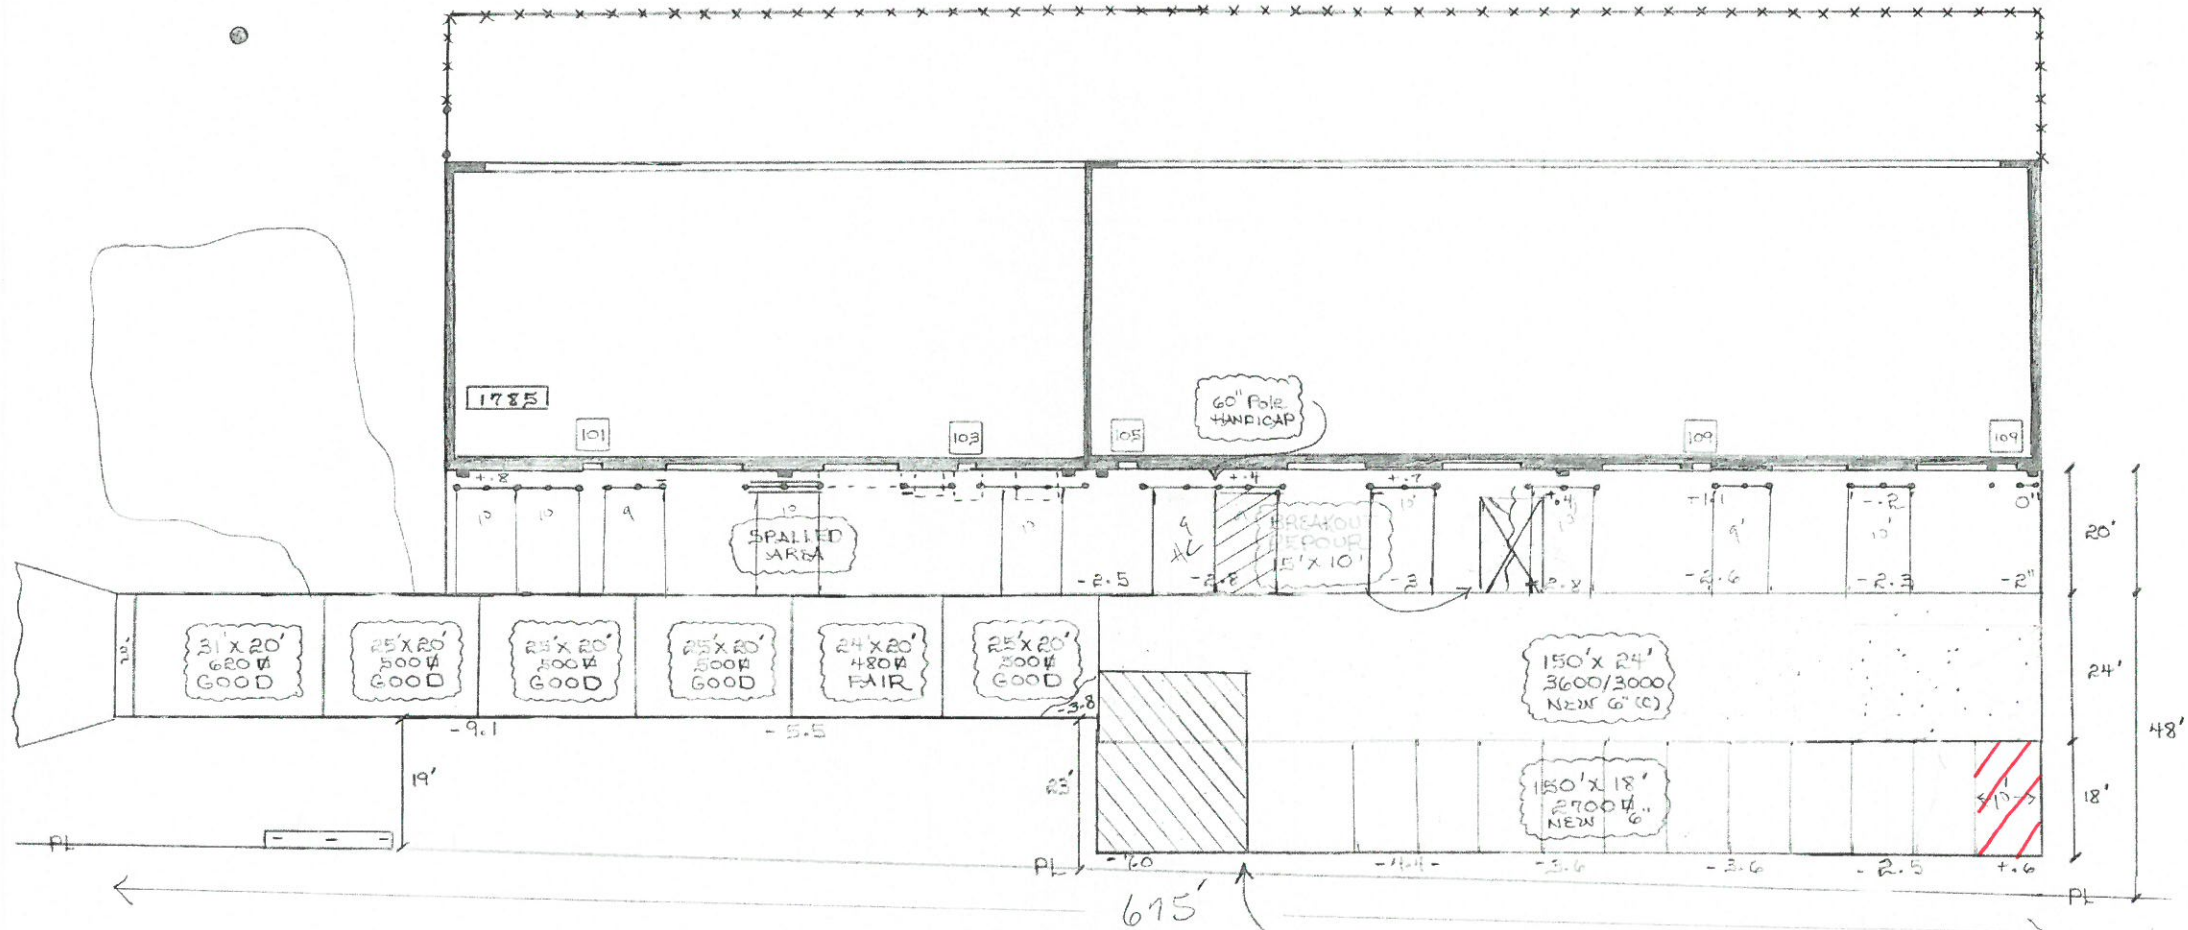

GREG OLLOM
 941 CORNELIUS RD.
 ROCKWALL, TEXAS
 75087
 972.771.5626 -L
 gollom@sbcglobal.net

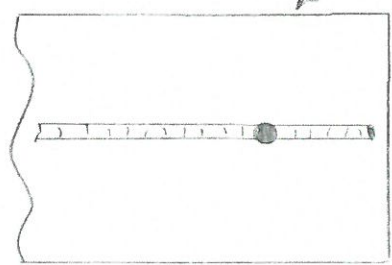

3600 psi
 6.5 sack
 #3 - 18" OC

Romy Williams
 Dist. City Engineer
 972.774.7746
 awilliams@rockwall.com

20' x 20'
 600#
 DUMPSTER
 PAD
 8"

RELEASED FOR CONSTRUCTION
 ALL RESPONSIBILITY FOR ADEQUACY OF DESIGN
 REMAINS WITH THE DESIGN ENGINEER. THE CITY
 OF ROCKWALL, IN REVIEWING AND RELEASING
 PLANS FOR CONSTRUCTION, ASSUMES NO
 RESPONSIBILITY FOR ADEQUACY OR ACCURACY
 OF DESIGN.

NORTH
 CITY *OJW* 10-20-16
 DATE