
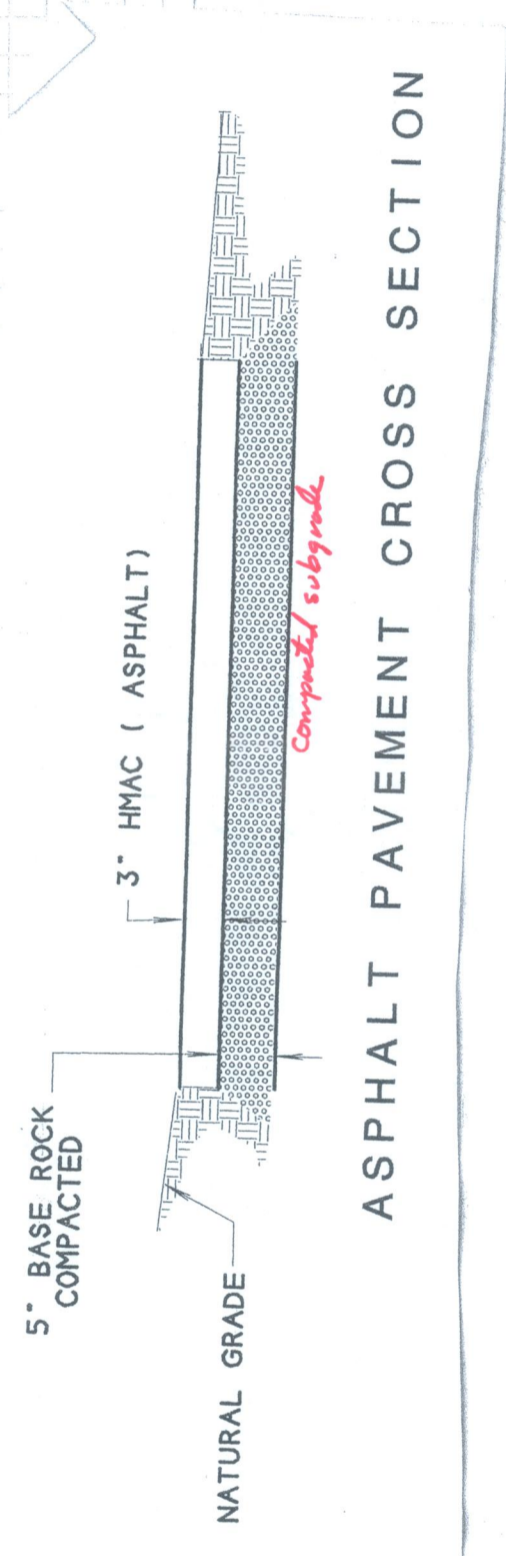


Sorany's Set

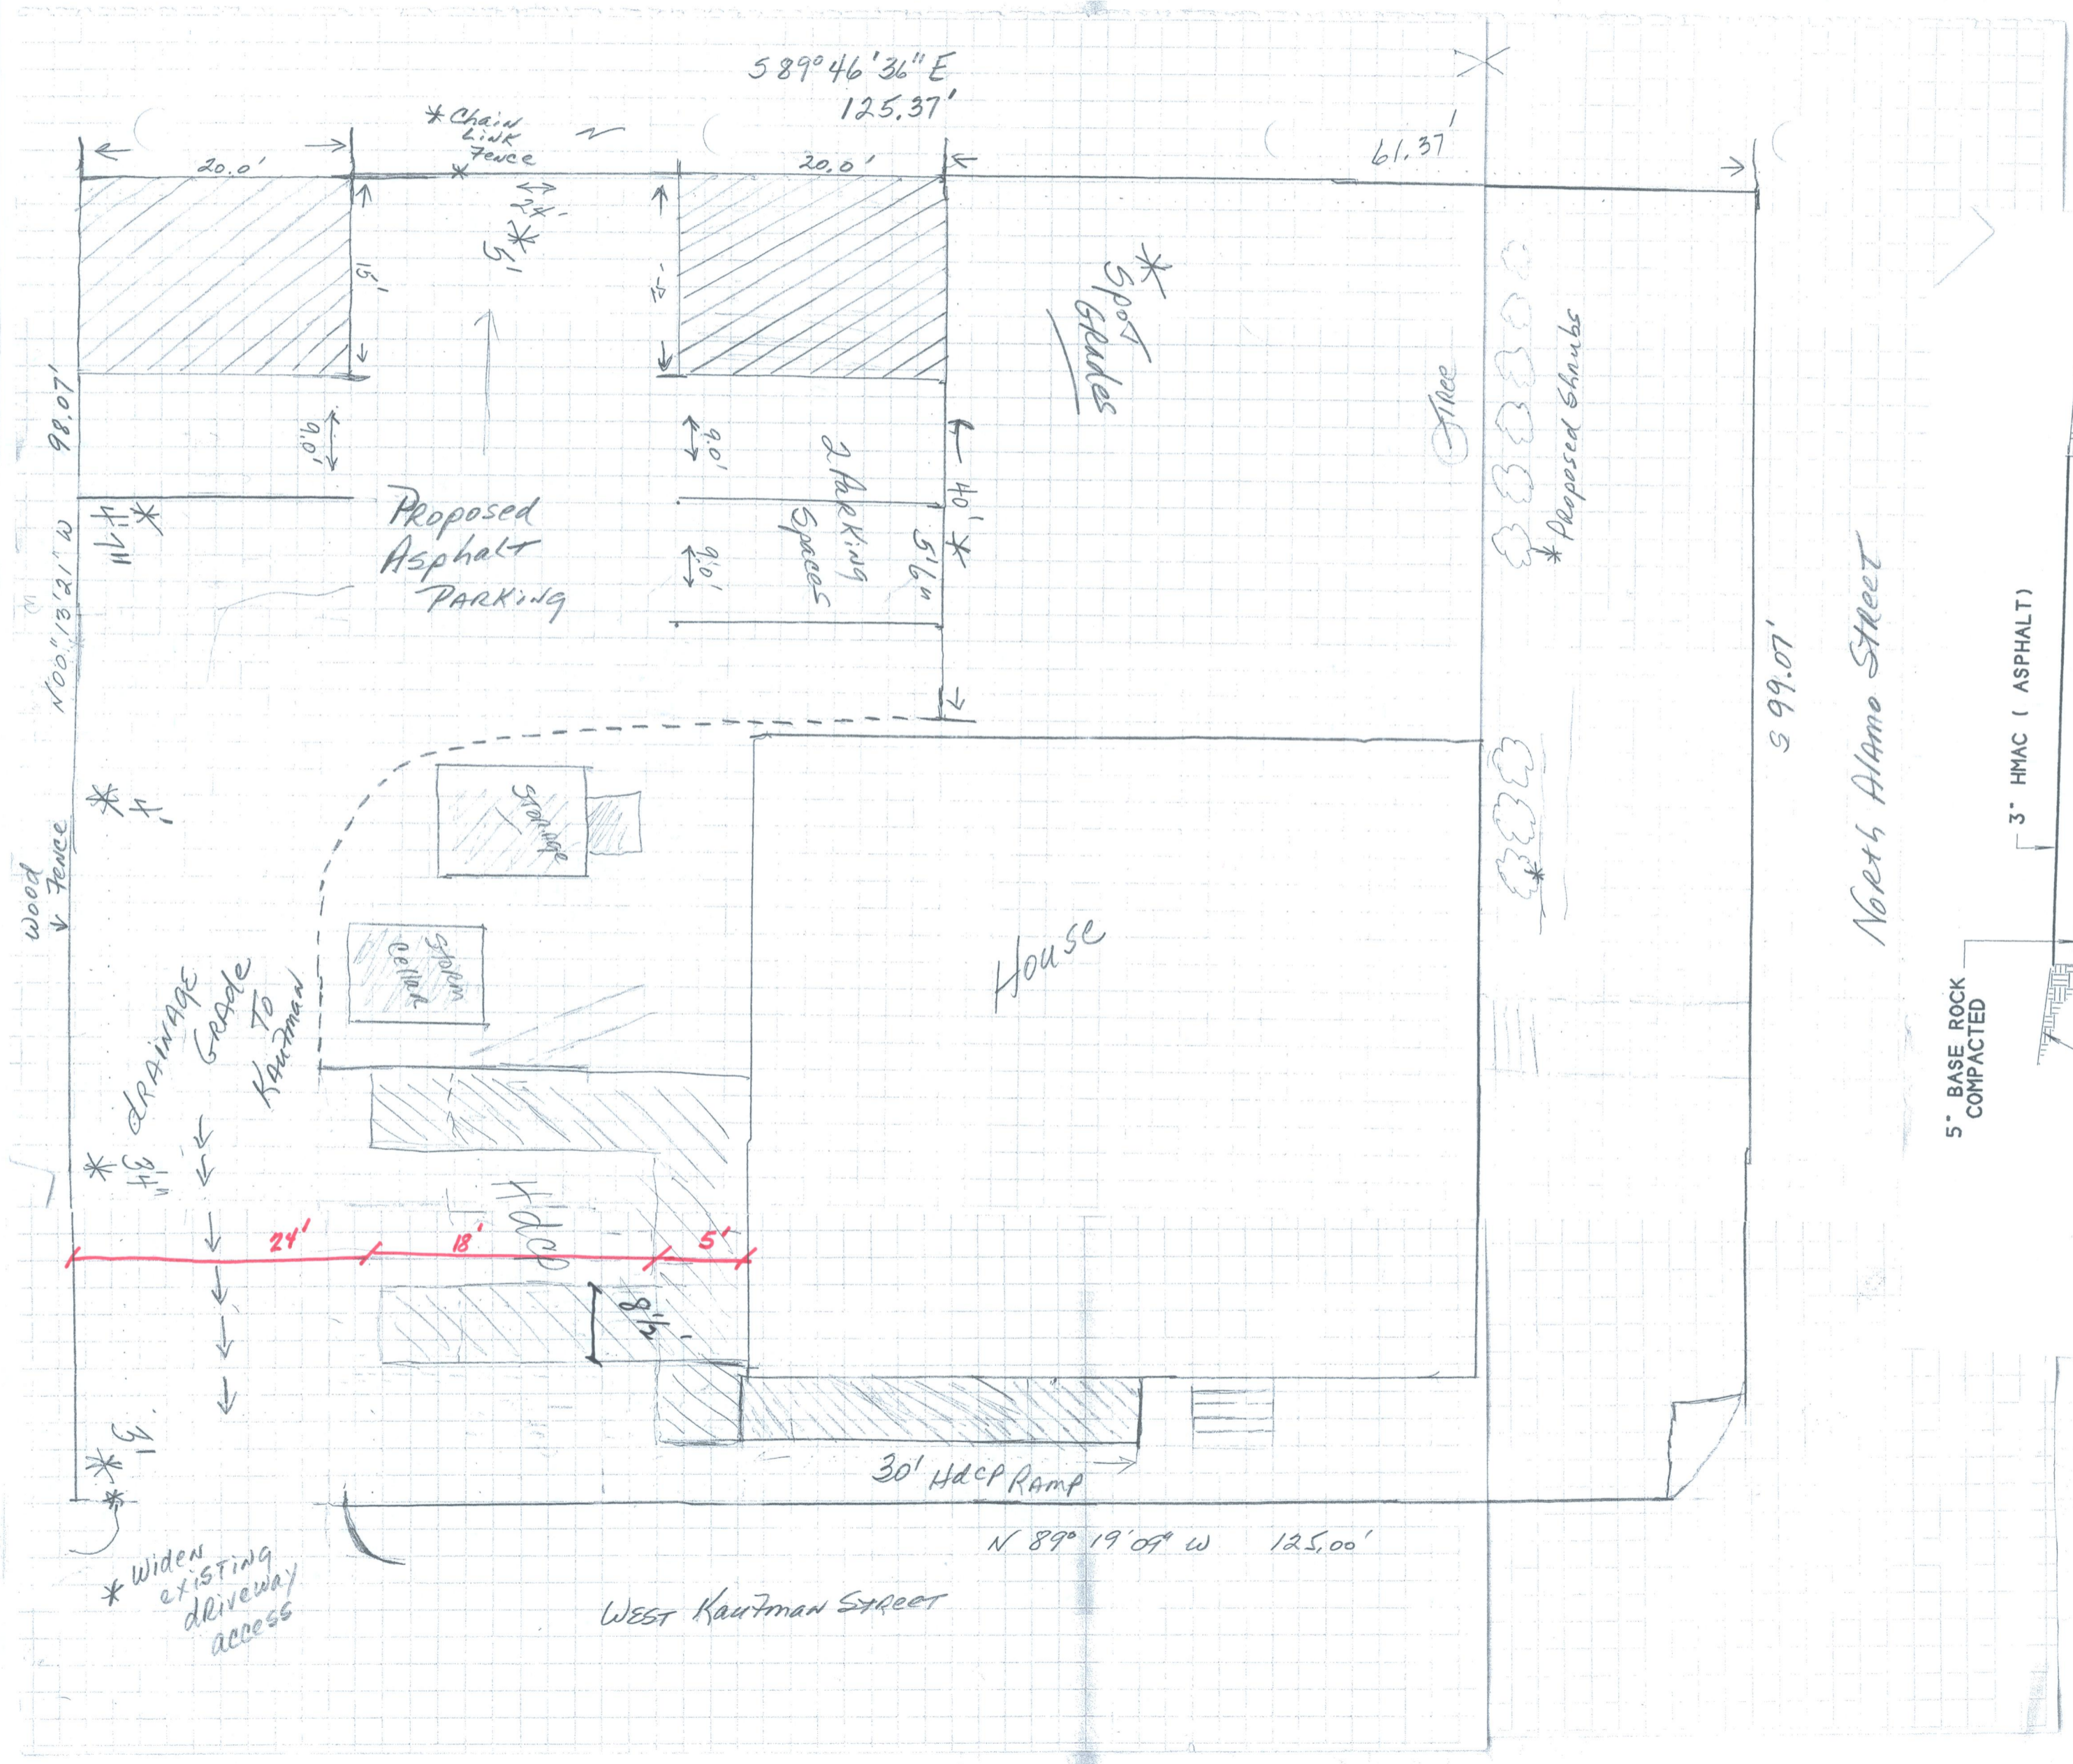

Red porch Stone

201 N. Alamo

APPROVED FOR CONSTRUCTION

NOV 02 2006

City of Rockwall Engineering Dept.  
City Engineer: CAT