



CULVERT PROFILE

NOT TO SCALE

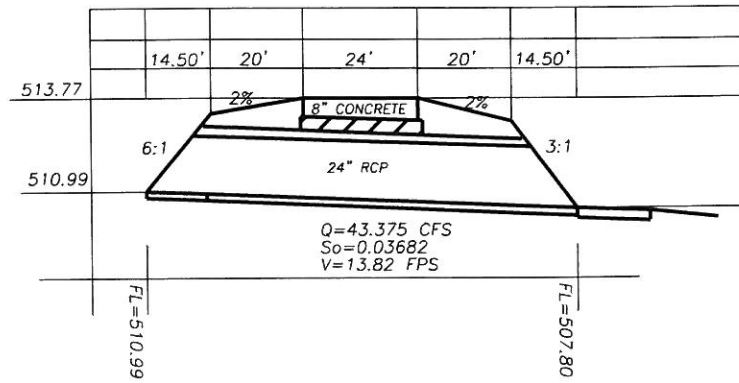




CONCRETE PAVEMENT SECTION

NOT TO SCALE

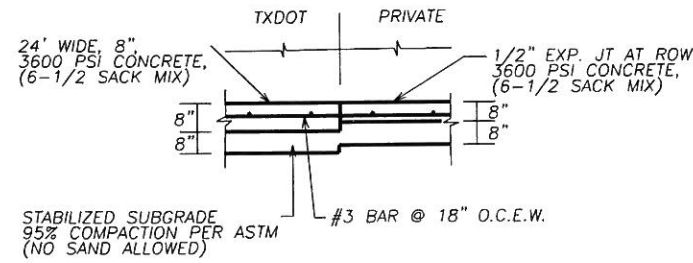

SWALE SECTION


NOT TO SCALE

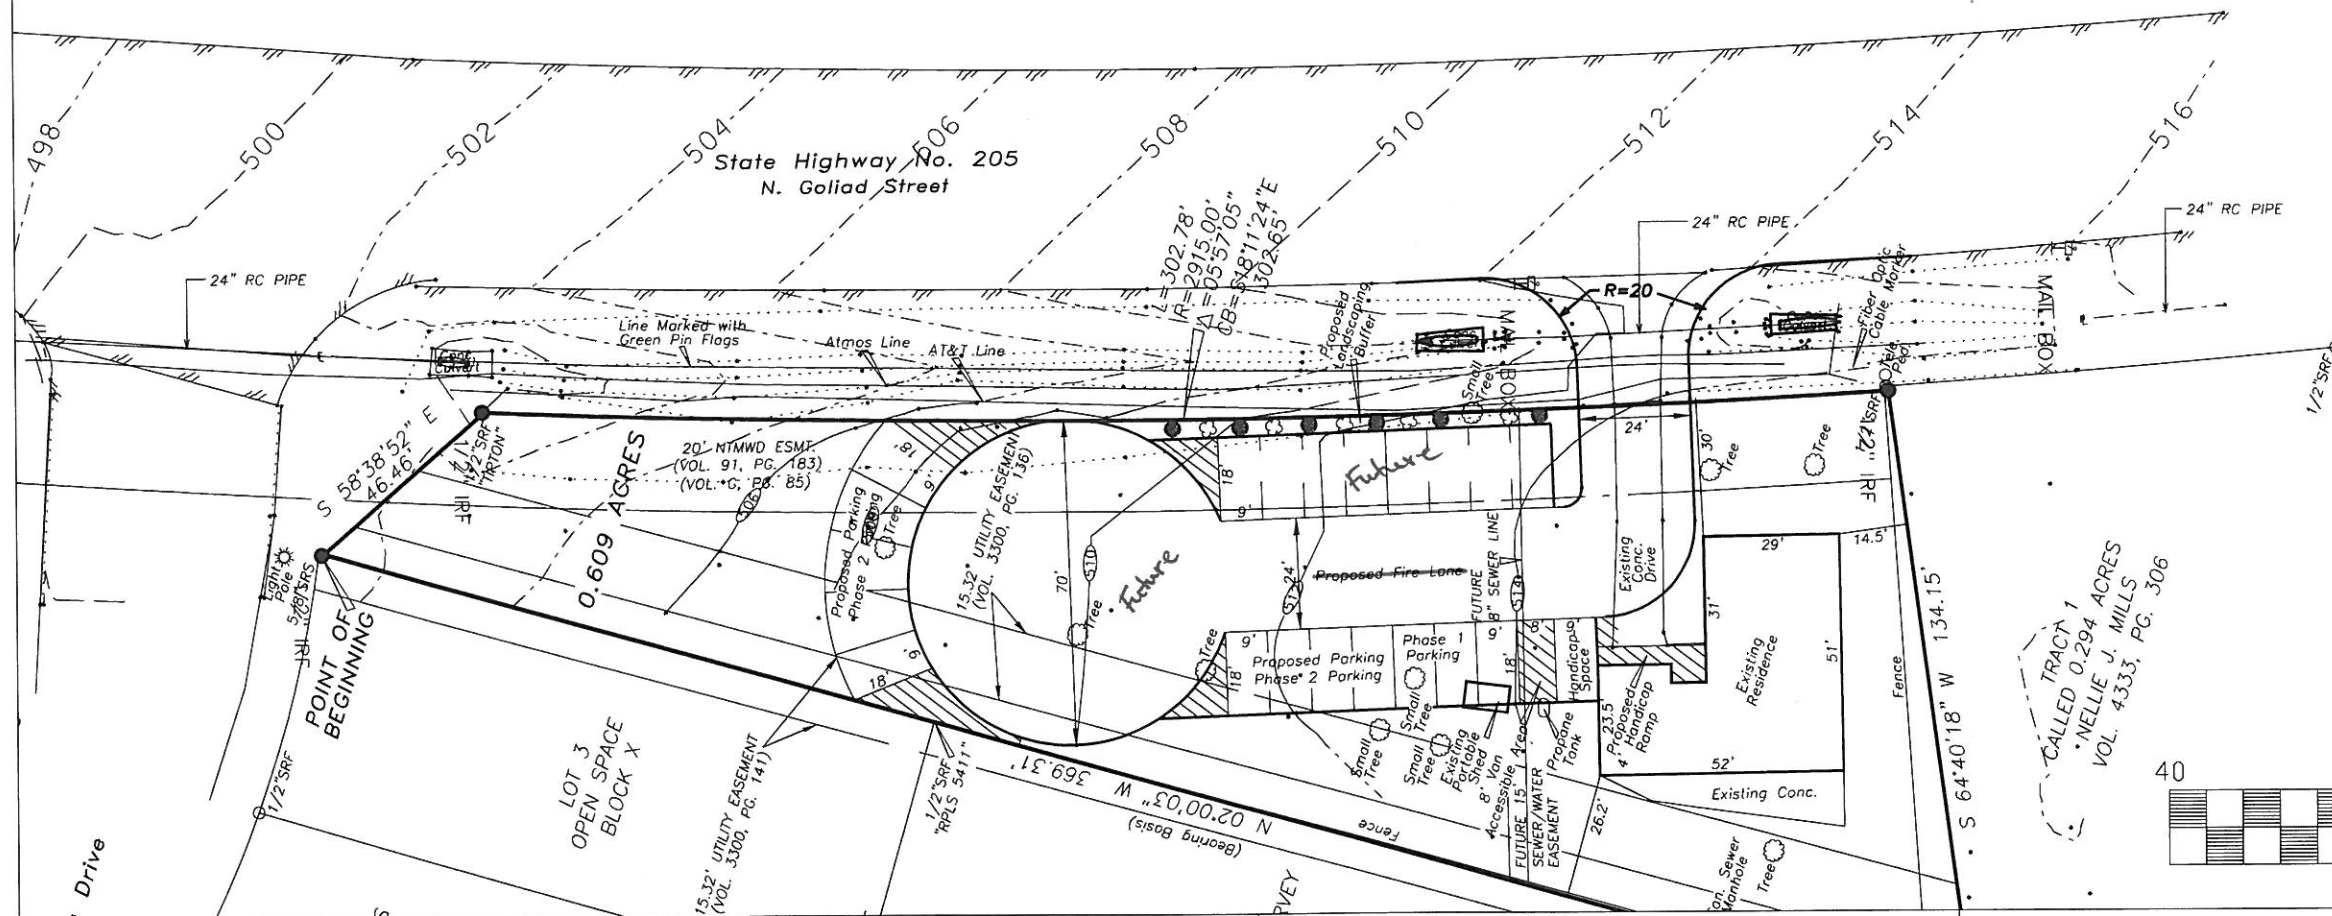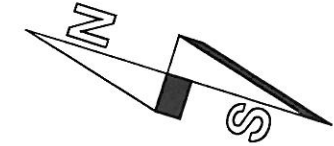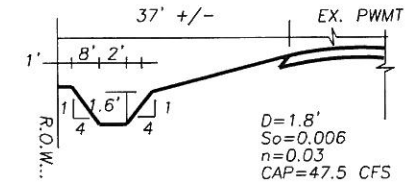

NOTES

1. TXDOT PERMIT REQUIRED.
2. ALL FILL TO BE COMPACTED TO MIN 95% USING SHEEP'S FOOT ROLLER
3. CONTACT TEXAS ONE STOP (1-800-245-4545) PRIOR TO ANY CONSTRUCTION.
4. CONTACT ATMOS ENERGY (972-485-5277) TO COORDINATE GAS.
5. ALL DISTURBED AREA IN TXDOT R.O.W. SHALL BE SODDED.

TRACT 1
CALLED 0.294 ACRES
NELLIE J. MILLS
VOL. 4333, PG. 306

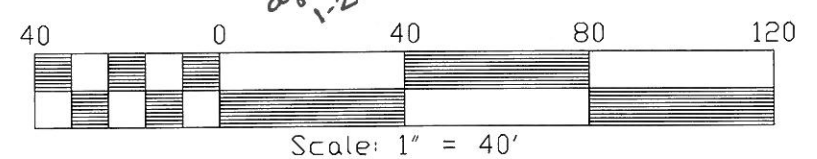

AAAA PLUS SURVEYORS, LLC
1500 HICKORY CREEK LN. ROCKWALL, TEXAS 75032
OFFICE (972) 771-9888 FAX (972) 771-9888
plat@aaaaplussurveyors.com

PREPARED FOR:

4037 N GOLIAD ROAD
ROCKWALL TX

SHEET
1
OF
1