

VICINITY MAP
NOT TO SCALE

0.427 ACRES
INEZ R. SMITH
TO
SHANNON MCCORD
VOL. 3451, PG. 103

0.50 ACRES
C. A. & DORTHY SEABOLT
TO
CRAIG MERRITT
VOL. 2263, PG. 21

0.46 ACRES
CRAIG MERRITT
TO
WILLIAM H. & MELINDA MIGNEAULT
VOL. 2933, PG. 260

TRACT 2
NAN L. SMARTT &
JULIANA BOND
VOL. 879, PG. 14

TRACT 1
NAN L. SMARTT &
JULIANA BOND
VOL. 879, PG. 14

APPROVED FOR
CONSTRUCTION

AUG 2 2007


City of Rockwall Engineering Dept.
City Engineer: *AT*

AMENDED
SITE PLAN
503 S. GOLIAD STREET
LOT 1, BLOCK A
CARABAJAL ADDITION
CITY OF ROCKWALL
ROCKWALL COUNTY, TEXAS

OWNER:
IRMA CARABAJAL
5930 LBJ SUITE 250
DALLAS, TEXAS 75240
972-788-9188

REVISION
NOV 28 2012
CITY OF ROCKWALL ENGINEERING DEPT.

REVISION
NOV 8 2012
CITY OF ROCKWALL ENGINEERING DEPT. *aw*

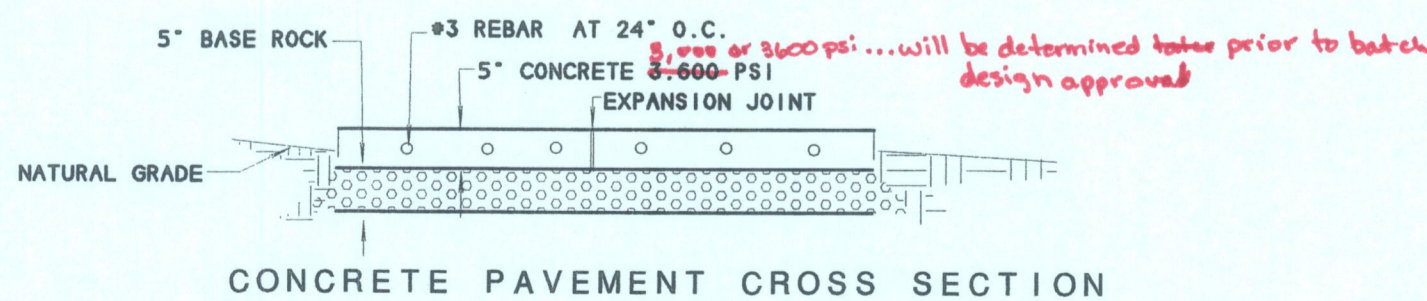

SYMBOL LEGEND	
	TV
	GAS
	TEL
	FH
	PP
	CABLE ROSE
	ELEC
	TU ELEC
	ELECTRIC
	SUBSURFACE
	JUNCTION BOX
	FENCE
	WATER
	PREFILTER
	SUBSURFACE
	A/C
	AIR COND.
	UNIT
	PROPANE
	TRAIL

SURVEY DATE: JULY 29, 2007
SCALE: 1" = 20'
CLIENT: CARABAJAL GF# NONE

R.S.C.I.
ROCKWALL SURVEYING CO., INC. LAND SURVEYING
1984 S. FM 551 ROYSE CITY, TX 75189 972-772-5434 PHONE 972-772-5443 FAX