


NORTH TEXAS  
MUNICIPAL WATER DISTRICT  
WYLIE, TEXAS

ROCKWALL TO CASH  
21 - INCH TRANSMISSION PIPELINE

PROJECT CF 83-4B

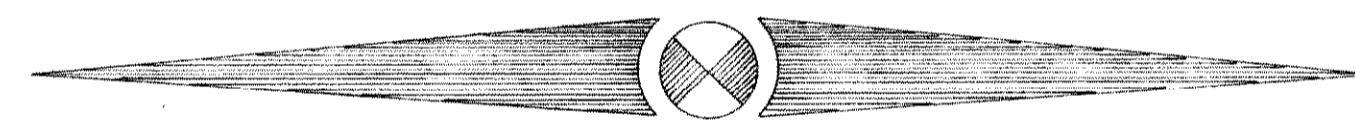

1984

BOARD OF DIRECTORS

O.L. STEGER  
DYON CANTRELL  
C. TRUETT SMITH

PRESIDENT  
VICE PRESIDENT  
SECRETARY TREASURER


CLIFFORD CARPENTER  
WILLIAM B. FINNEY  
BRETT HALL  
E.L. KOHN  
L.L. LEAKE  
CARL MANN  
DAVID B. McCALL, JR.

JACK McJUNKIN  
G.W. RANGE  
RICHARD H. ROACH  
A.R. SCHELL, III  
CONWAY SENTER  
BEN WHISENANT  
MARVIN YOUNGBLOOD

CARL W. RIEHN  
JOHN WADDELL

EXECUTIVE DIRECTOR  
ASSISTANT GENERAL MANAGER

Rec 8/15/84

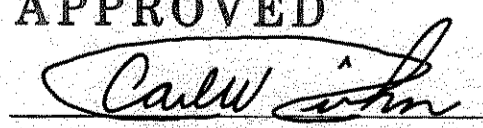APPROVED  
  
CARL W. RIEHN, EXECUTIVE DIRECTOR

FREESE and NICHOLS, INC.  
CONSULTING ENGINEERS