



NOTES:
 1. Fences Existing
 2. Remove Existing Tank, Tank Foundation And Move 2" Air Valve For 12", As Part Of Pipeline Work.

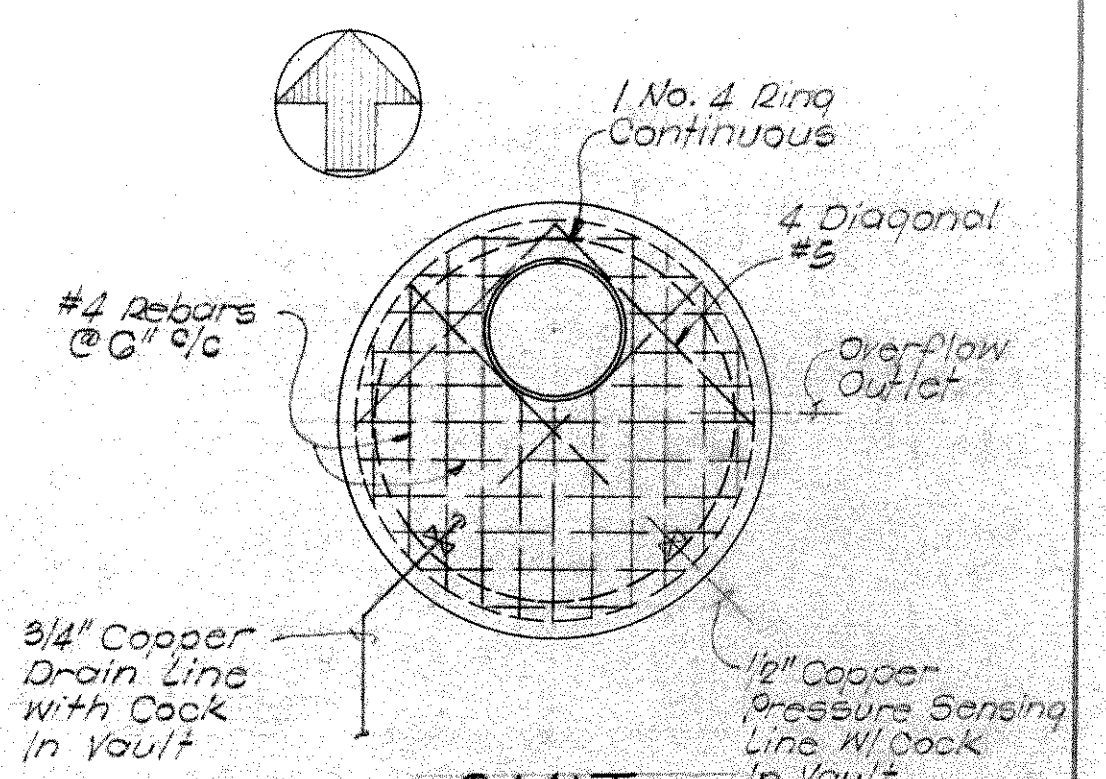


OMIT TOP PLAN
 Scale: 3/8" = 1'-0"

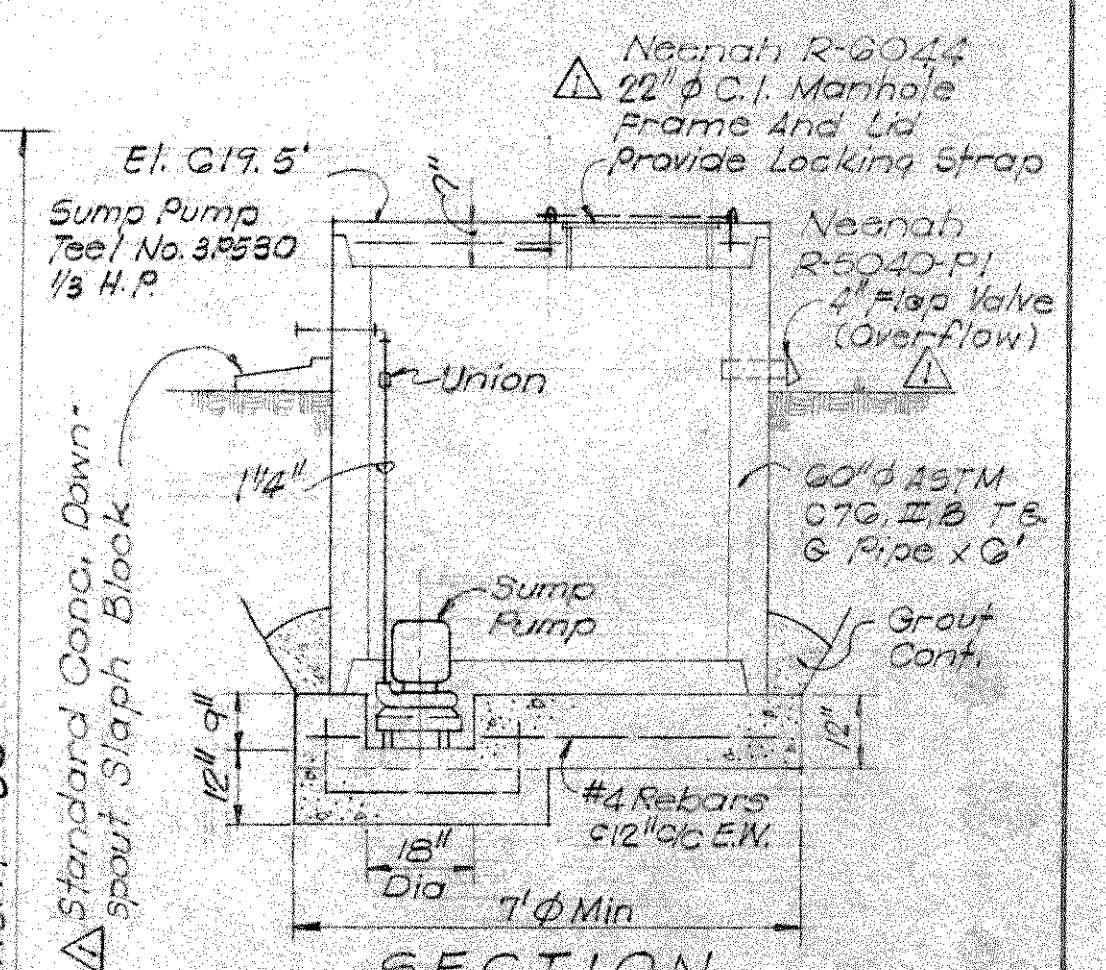


SECTION TRANSMITTER VAULT
 Scale: 3/8" = 1'-0"


LAYOUT - STANDPIPE AREA
 Scale: 1/4" = 1'-0"

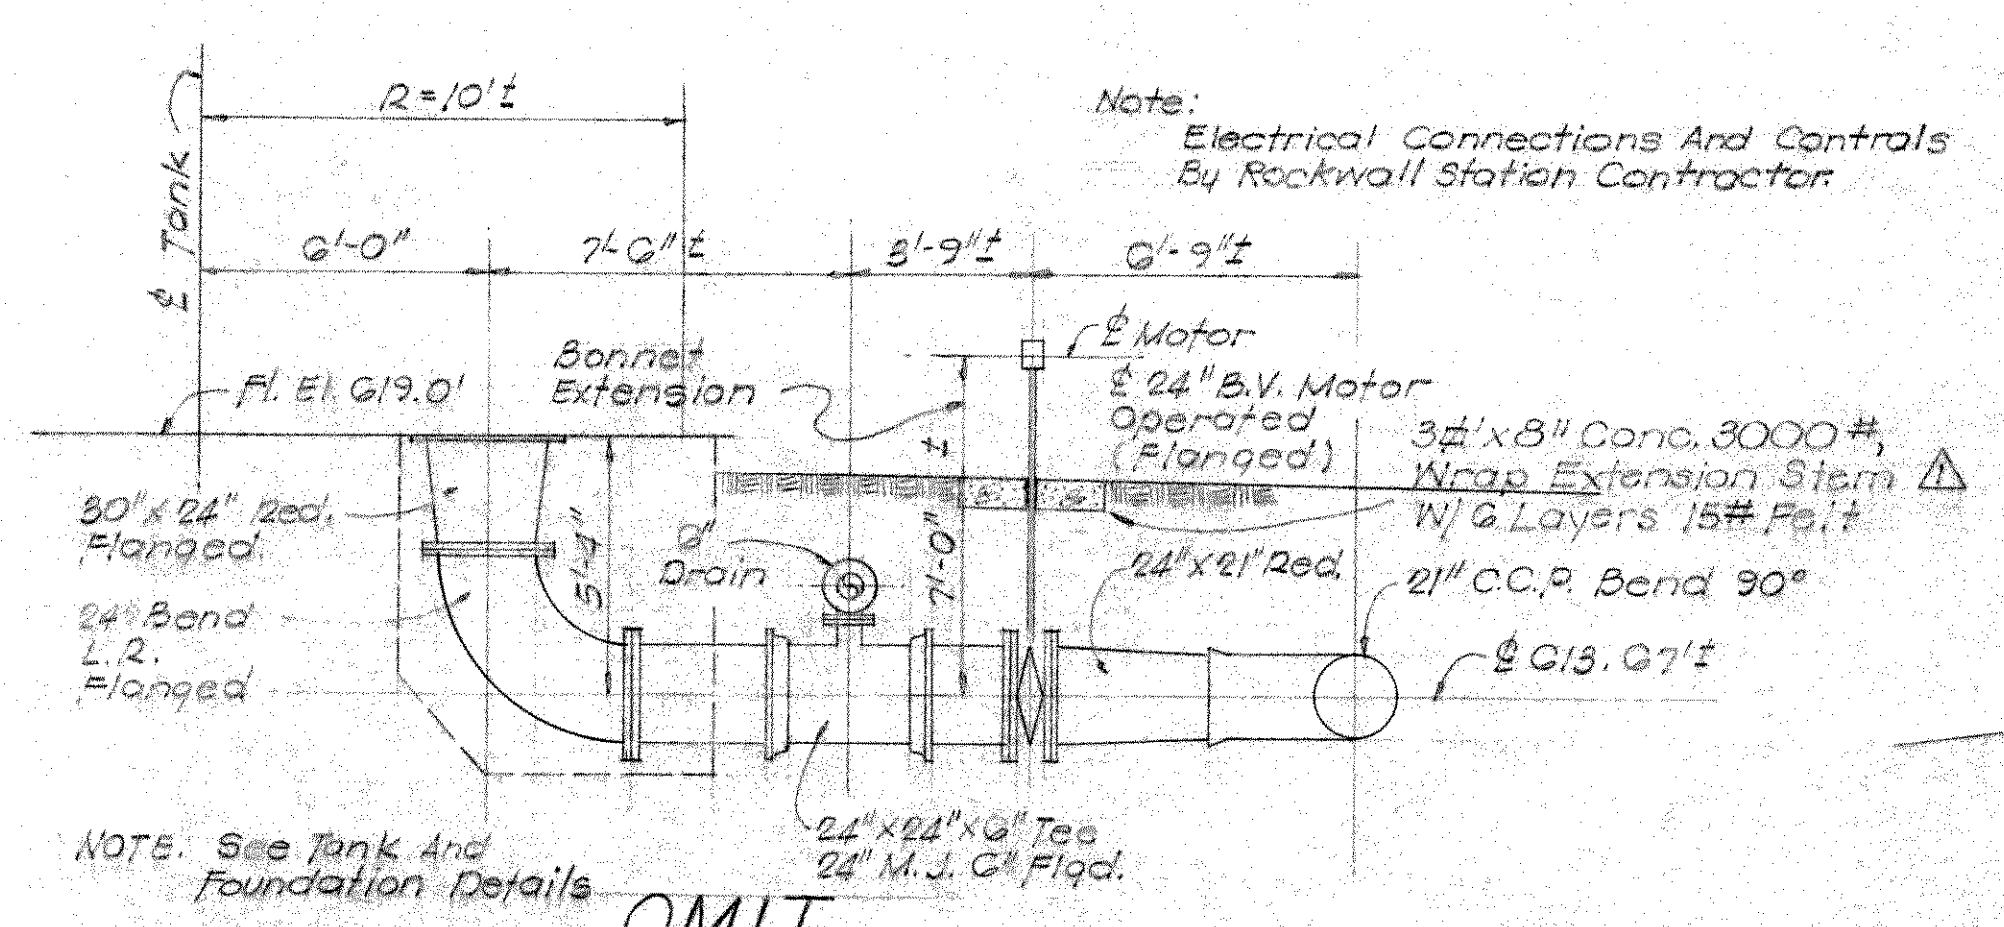

OMIT SECTION PIPE CONNECTION TO STANDPIPE
 Scale: 1/4" = 1'-0"

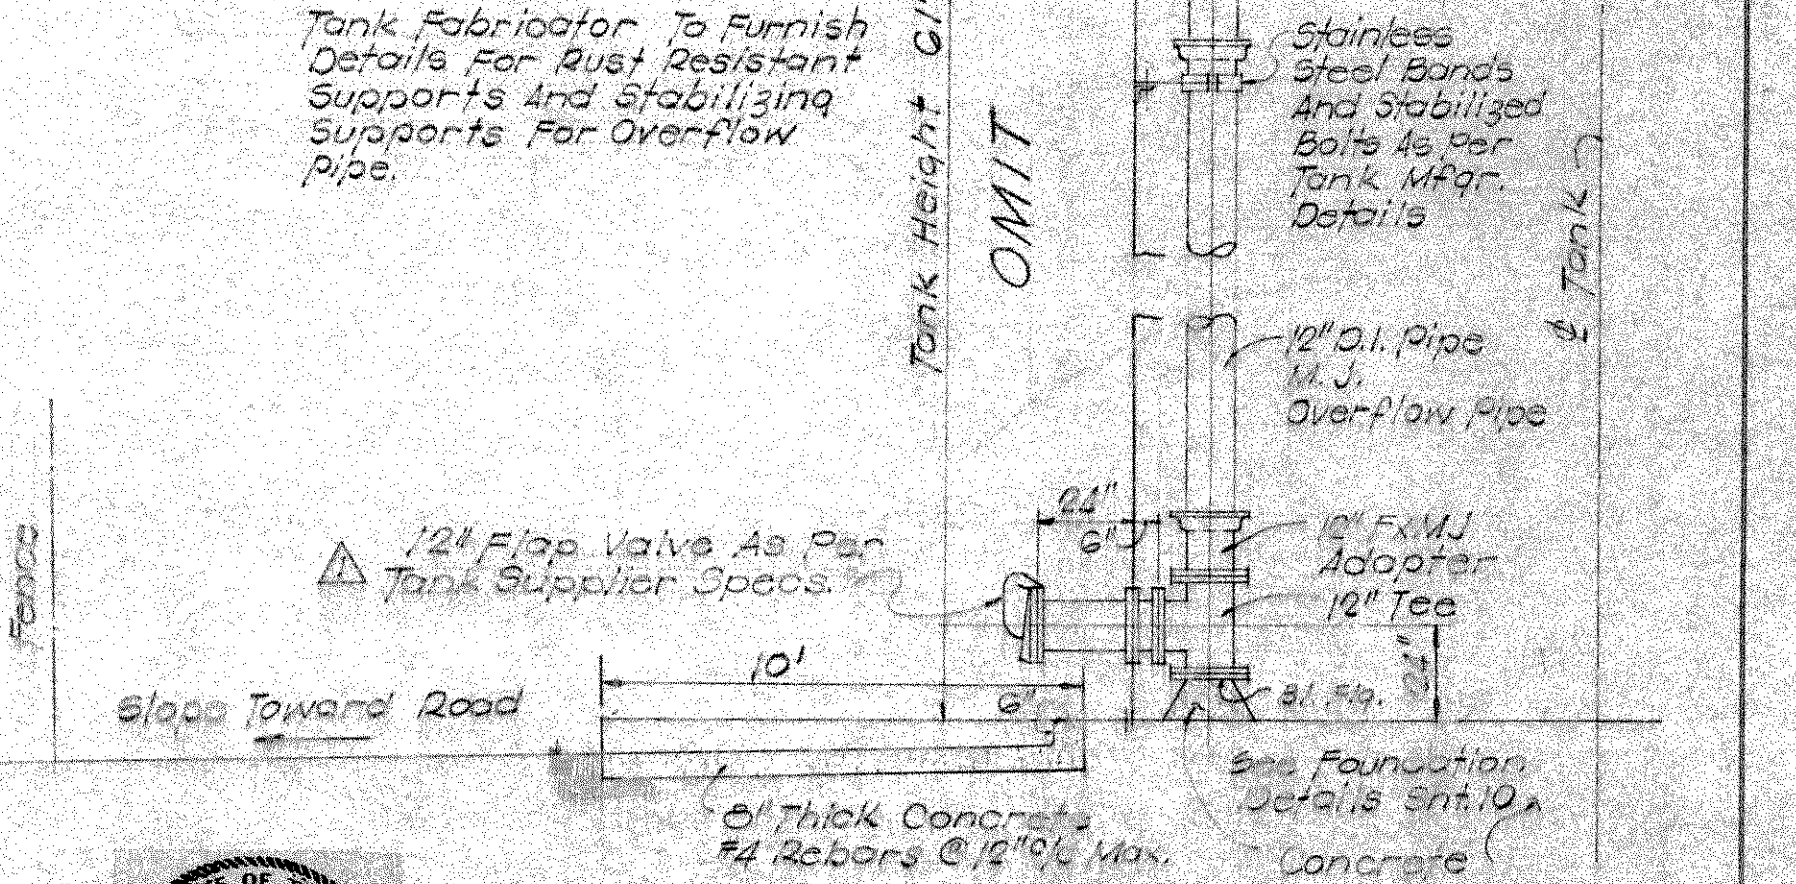

OMIT TYPICAL OVERFLOW DETAIL
 Scale: 1/4" = 1'-0"

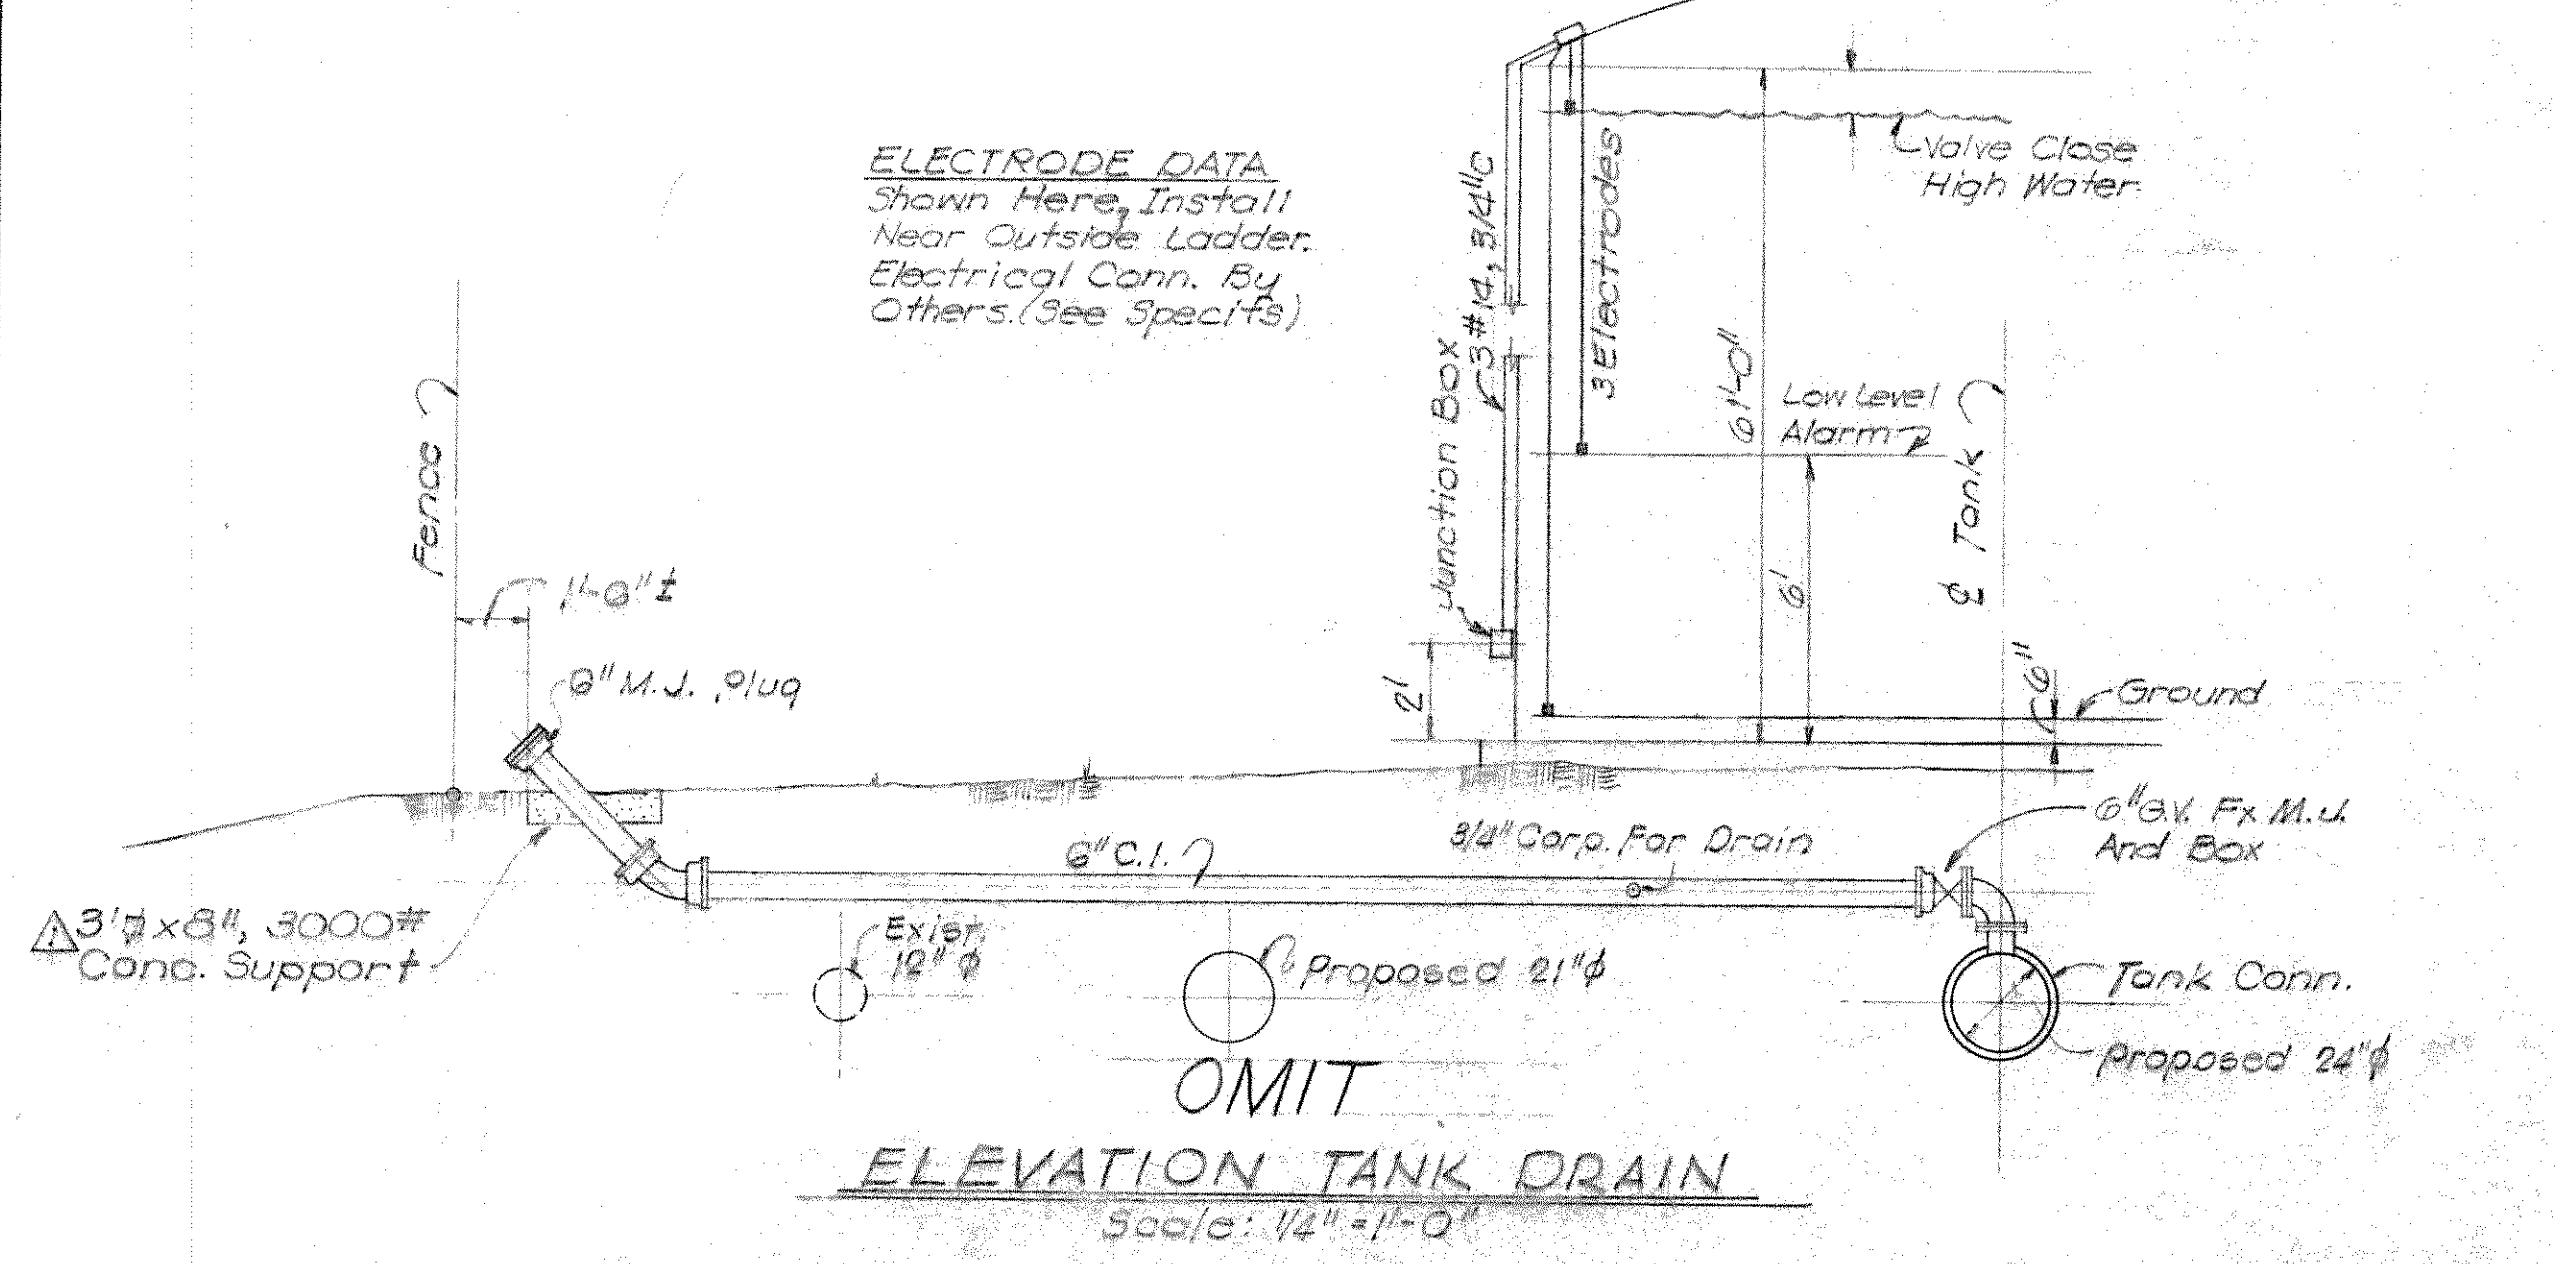

OMIT ELEVATION TANK DRAIN
 Scale: 1/4" = 1'-0"

ELECTRODE DATA
 Shown Here, Install Near Outside Ladder. Electrical Conn. By Others. (See Specs)

