
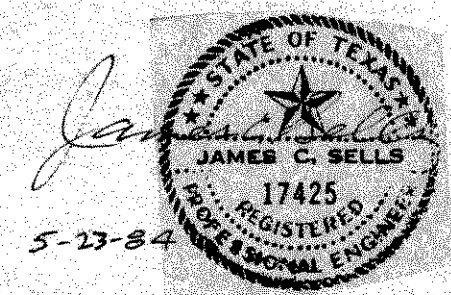
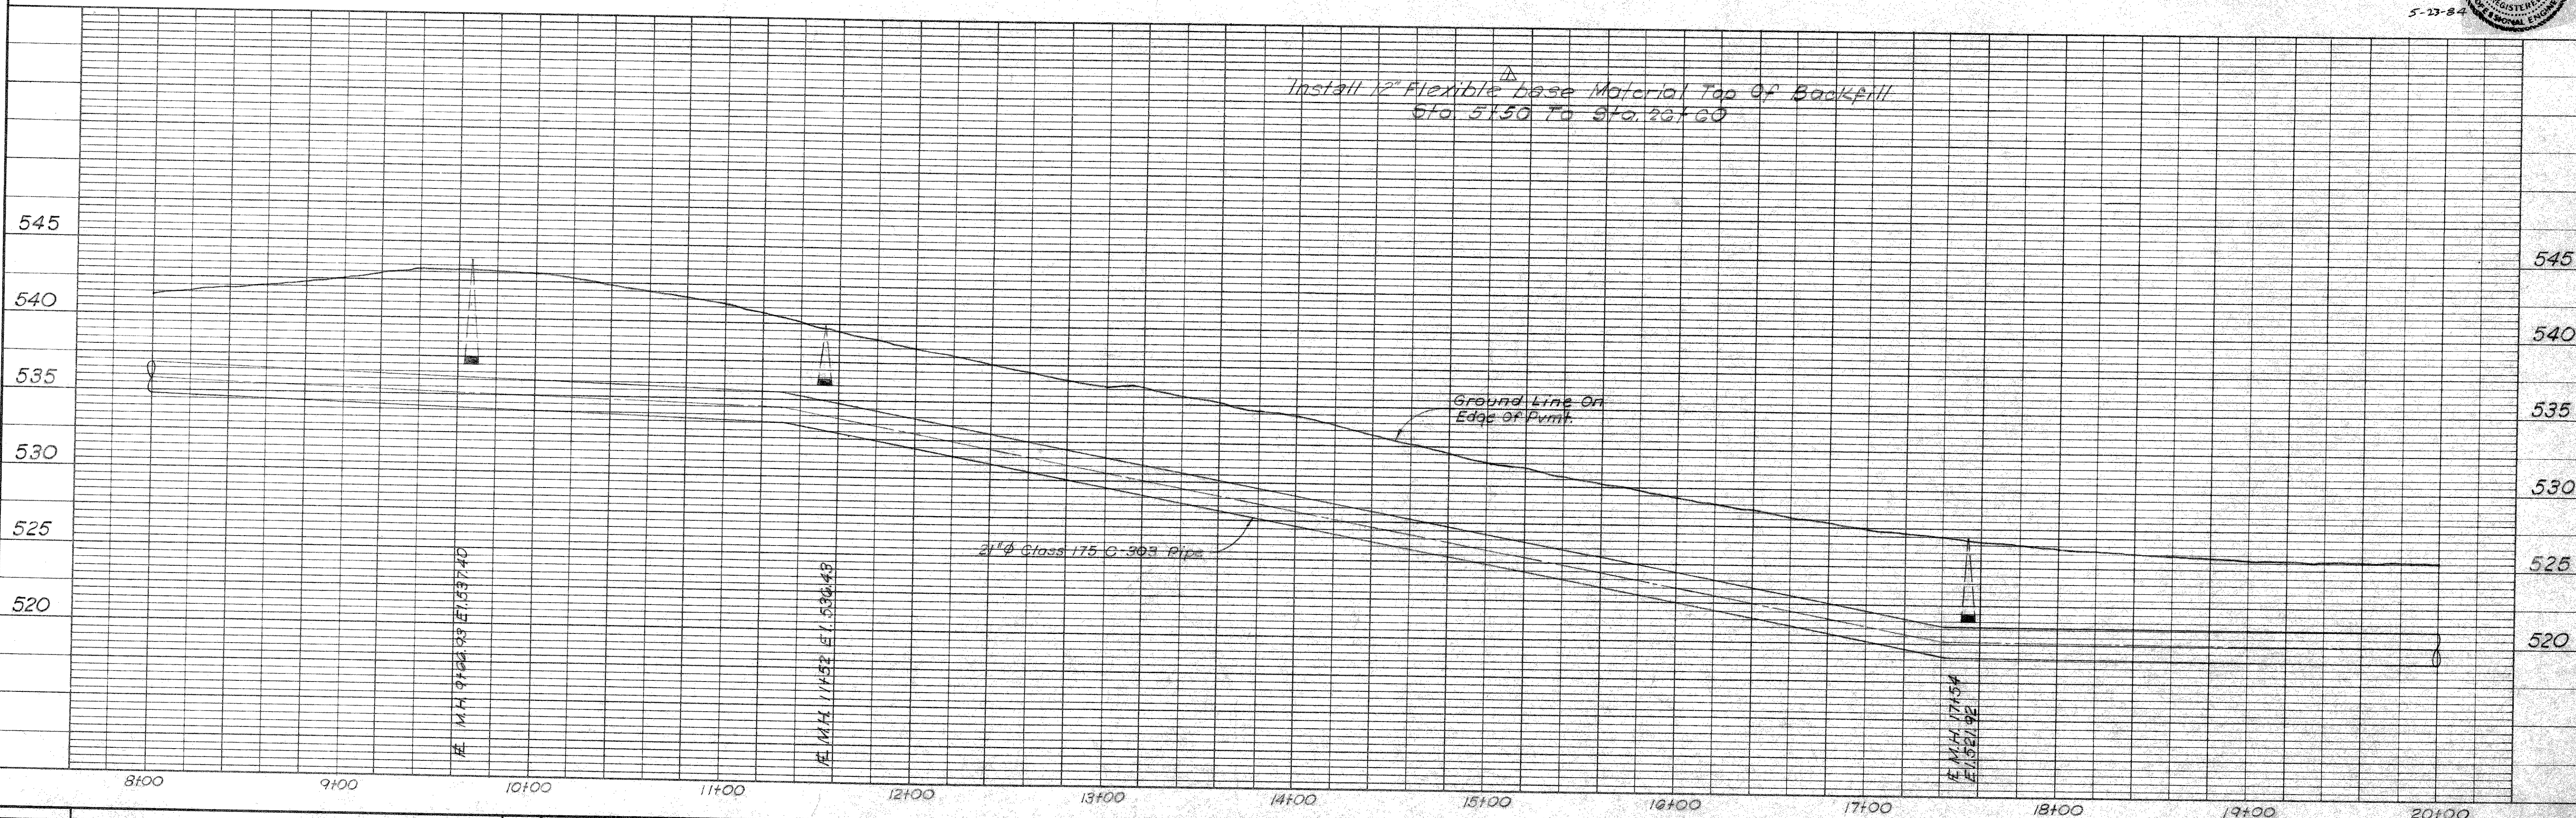
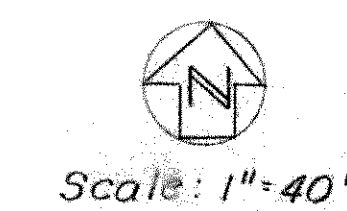


MATCH LINE STA 8+00

MATCH LINE STA 20+00

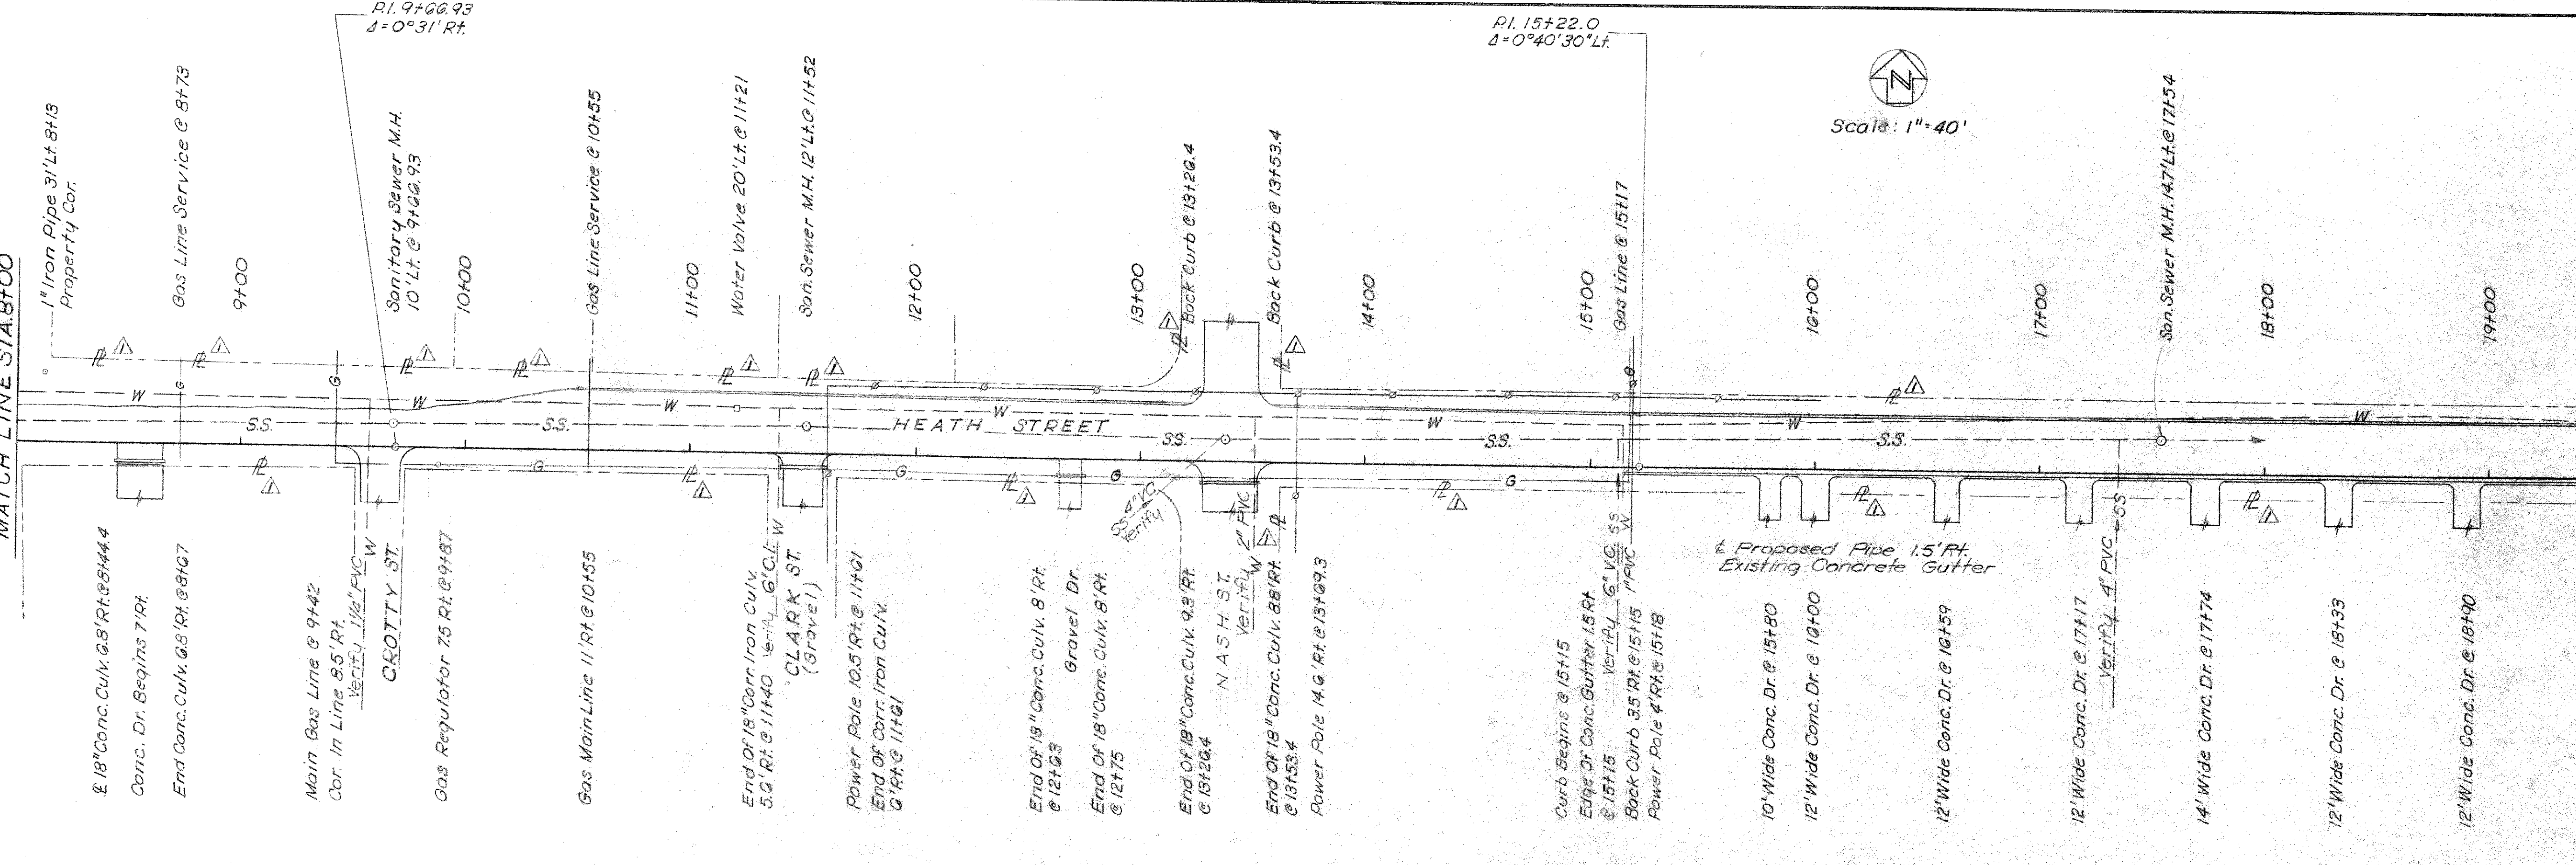

7.2-84	DESIGNED	J.C.S.	JOB NO.	NTD 83099B
7.3-84	DRAWN	J.C.S.	DATE	1984
	TRACED	J.C.S.	SCALE	AS SHOWN
	CHECKED	T.A.R.		

REVISION: 1. 18\"/>

**FRESE AND NICHOLS**  
CONSULTING ENGINEERS  
FORT WORTH-AUSTIN, TEXAS

**NORTH TEXAS MUNICIPAL WATER DISTRICT**  
WATER TRANSMISSION SYSTEM

**ROCKWALL STATION TO CASH PIPELINE**  
PLAN AND PROFILE

SHEET  
3 OF 11