



NOTE:
 125+00 13.4' Lt. & 2" Magnolia
 125+02 14.3' Rt. & 4" Mimosa
 125+24 10.2' Lt. & 2" Pecan
 125+24 11.7' Rt. & 4" Mimosa
 125+48 2.2' Lt. & Water Meter
 125+51 7.8' Rt. & 8" Mimosa
 125+61.5 10.3' Rt. & 10" Cedar
 125+72.5 4.3' Rt. & 2" Mimosa
 125+82 11.4' Lt. & 12" Hickby.

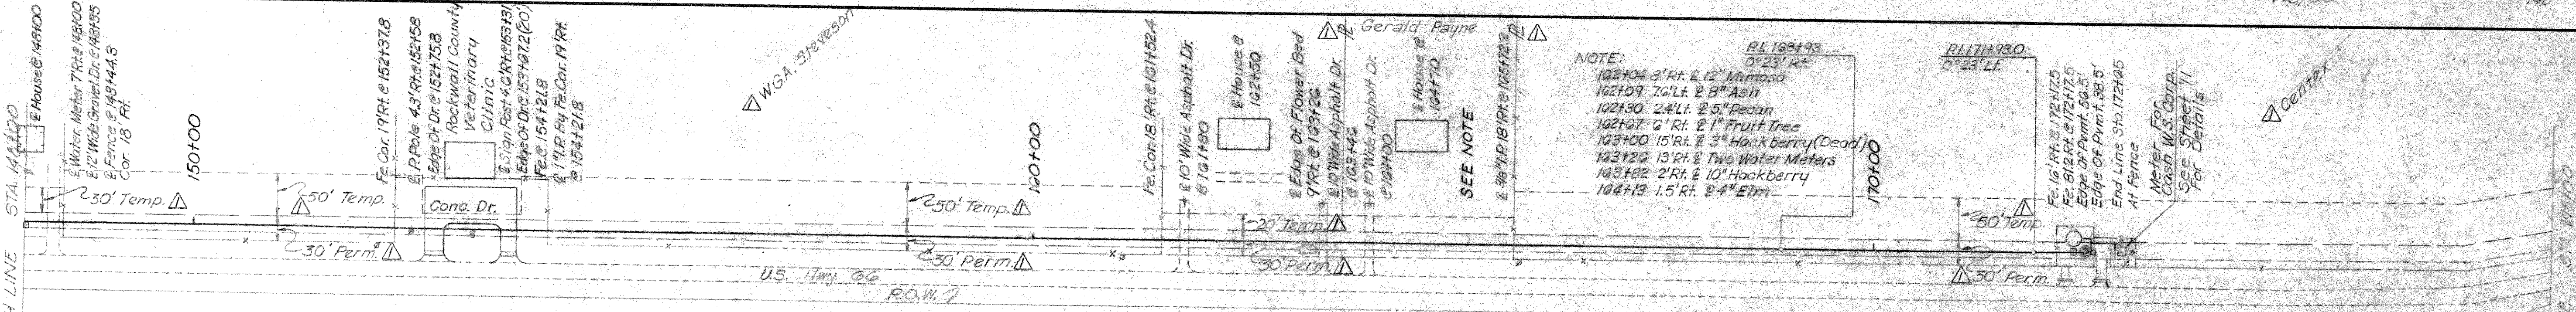

NOTE:
 162+04 3' Rt. & 12" Mimosa
 162+07 7' Lt. & 8" Ash
 162+30 2.4' Lt. & 5" Pecan
 162+67 6' Rt. & 1" Fruit Tree
 163+00 15' Rt. & 3" Hackberry (Dead)
 163+20 13' Rt. & Two Water Meters
 163+82 2' Rt. & 10" Hackberry
 164+13 1.5' Rt. & 4" Elm.

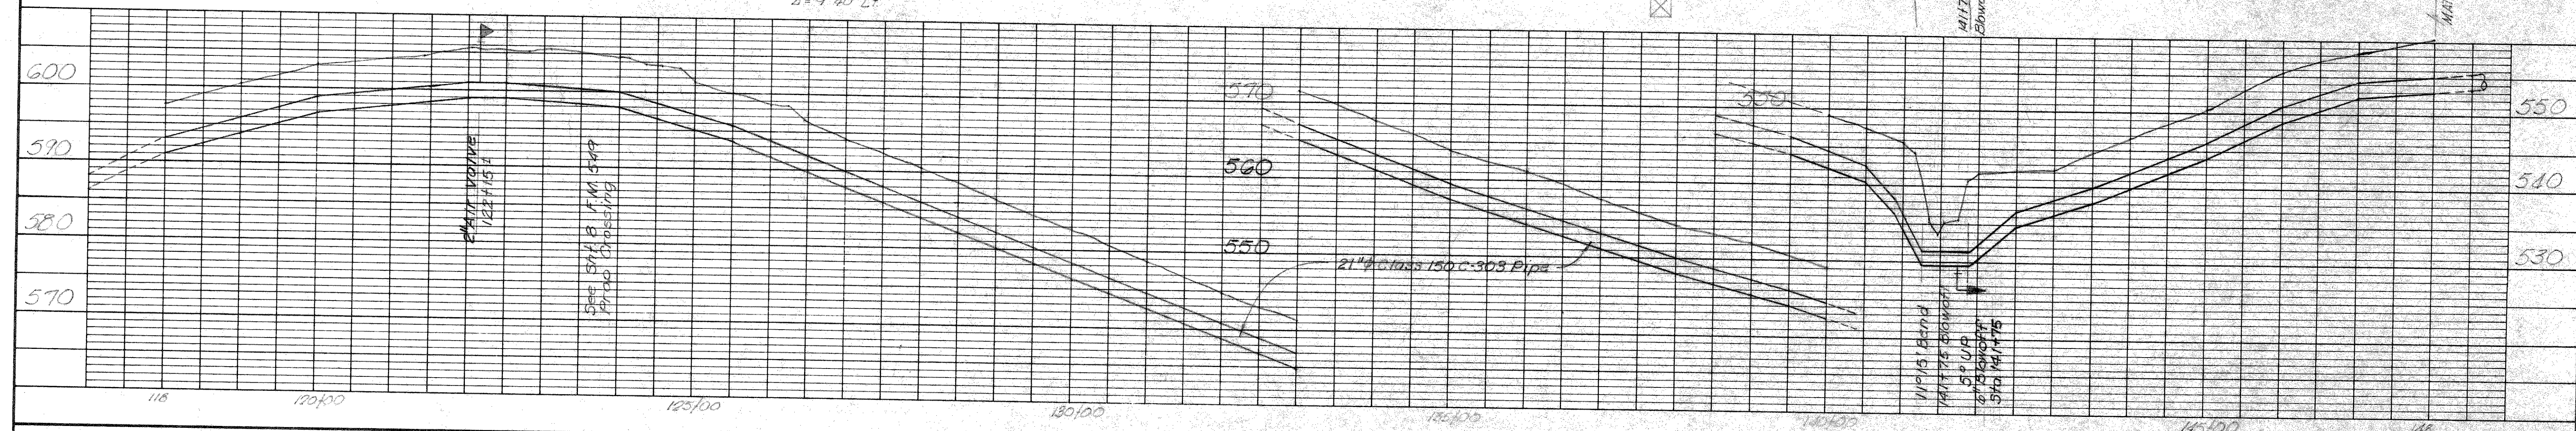