

EXISTING UTILITY OWNERS

BETA CABLE TELEVISION KERRY BOYLES	(214) 771-0202
CITY OF ROCKWALL DUB DOUPHRADE, ENGINEERING	(214) 771-1111
CONTEL OF TEXAS, INC. (CONTEL) TELEPHONE CABLES JOHN GENTRY, ENGINEERING FLAGGING FLAGGING	(214) 839-1593 (214) 389-4000 (214) 364-2121
FARMERS ELECTRIC COOPERATIVE, INC. TIM MACKEY, SENIOR STAKING ENGINEER MARK SIMPSON, STAKING	(214) 455-1715
NORTH TEXAS MUNICIPAL WATER DISTRICT (N.T.M.W.D.) JIM PARKS, ENGINEERING	(214) 442-5405
TEXAS UTILITIES ELECTRIC CO. (T.U.E.) ELECTRIC DISTRIBUTION JIM MC CORMICK, ENGINEERING ELECTRIC TRANSMISSION RICHARD WALKER, SUPER. STAKING	(214) 771-3188 (214) 721-6281
EXPLORER PIPELINE COMPANY CRAIG HILGENDORF, ENGINEERING KEN BAILEY, FLAGGING (24 HOURS NOTICE)	(918) 493-5104 (214) 527-3151
FRIENDSHIP CABLE T.V. MARK CLARK, ENGINEERING	(214) 286-5931
GARLAND POWER AND LIGHT BILL REUTHSINGER	(214) 205-2625
LONE STAR GAS COMPANY DISTRIBUTION TOM TURNIN, FLAGGING TRANSMISSION BRUCE BAKER, CONSTRUCTION DAVID CROMER, R.O.W.	(214) 487-3885 (214) 263-3444 (214) 741-1671 (214) 670-2072
SOUTHWESTERN BELL TELEPHONE GLENN ORR, ENGINEERING FLAGGING OR DIGGING, ENTERPRISE 9800	(214) 457-2213 (817) 998-4102
TEXAS MUNICIPAL POWER AGENCY (T.M.P.A.) BOBBY NORTHCUTT, PERMITS JACK THORMAHLER, ENGINEERING GAYLOR WHITE, SUPERVISOR	(214) 721-6278 (409) 873-2013
U.S. SPRINT FIBER OPTICS CABLE JACK WHITE, ENGINEERING FLAGGING, 24 HOUR NOTICE	(214) 554-2505 1-800-521-0579
MT. ZION WATER SUPPLY CORP. RANDALL EUBANKS	(214) 722-3631
LAVON WATER SUPPLY CORP. WILL MORROW, FLAGGING	(214) 853-3601

LEGEND

	WATER VALVE
	WATER METER
	FIRE HYDRANT
	ACCESS MANHOLE
	AIR VALVE WITH ACCESS MANHOLE - PLAN VIEW
	AIR VALVE WITH ACCESS MANHOLE - PROFILE VIEW
	BLOWOFF WITHOUT ACCESS MANHOLE - PLAN VIEW
	BLOWOFF WITHOUT ACCESS MANHOLE - PROFILE VIEW
	MAIN LINE VALVE - PROFILE VIEW
	OVERHEAD UTILITIES
	UNDERGROUND UTILITIES
	STORM DRAIN INLET
	POWER POLE
	LIGHT POLE
	GUY WIRE AND ANCHOR
	TELEPHONE PEDESTAL
	BURIED CABLE SIGN
	P.I. OR P.O.T.
	MONUMENT
	BENCH MARK AND / OR T.B.M.
	TREE
	WOODEN FENCE
	BARBED WIRE FENCE
	CHAIN LINK FENCE
	RAILROAD
	CONCRETE PAVING
	ASPHALT PAVING
	LIMITS OF TEMPORARY EASEMENT
	LIMITS OF PERMANENT EASEMENT
	PROPERTY LINE

SHEET NO.


0
1 OF 28
2 OF 28
28A OF 28

SHEET INDEX

TITLE SHEET
SHEET INDEX / LEGEND
HYDRAULIC GRADE LINE
PLAN AND PROFILE STA. 0+00 TO STA. 28+00
PLAN AND PROFILE STA. 28+00 TO STA. 56+00
PLAN AND PROFILE STA. 56+00 TO STA. 84+00
PLAN AND PROFILE STA. 84+00 TO STA. 112+00
PLAN AND PROFILE STA. 112+00 TO STA. 140+00
PLAN AND PROFILE STA. 140+00 TO STA. 168+00
PLAN AND PROFILE STA. 168+00 TO STA. 196+00
PLAN AND PROFILE STA. 196+00 TO STA. 224+00
PLAN AND PROFILE STA. 224+00 TO STA. 252+00
PLAN AND PROFILE STA. 252+00 TO STA. 280+00
PLAN AND PROFILE STA. 280+00 TO STA. 308+00
PLAN AND PROFILE STA. 308+00 TO STA. 336+00
PLAN AND PROFILE STA. 336+00 TO STA. 364+00
PLAN AND PROFILE STA. 364+00 TO STA. 392+00
PLAN AND PROFILE STA. 392+00 TO STA. 398+45.95
RAILROAD AND HIGHWAY CROSSING DETAILS
RAILROAD AND HIGHWAY CROSSING DETAILS
METER VAULT - MECHANICAL
METER VAULT - STRUCTURAL
METER VAULT - STRUCTURAL
METER VAULT - ELECTRICAL
METER VAULT - ELECTRICAL
CONTROL ROOM - ARCHITECTURAL
PIPELINE APPURTENANCES
PIPELINE APPURTENANCES
PIPELINE APPURTENANCES
ADDENDUM NO. 2

RECORD DRAWING

Date 11-1-11 By J.C.

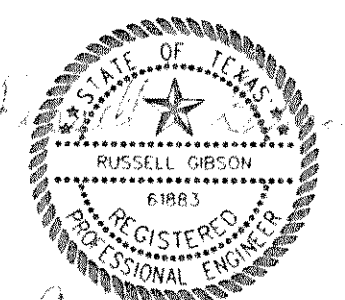

THE SEAL APPEARING ON THIS DOCUMENT WAS AUTHORIZED BY RUSSELL GIBSON, TEXAS P.E. NO. 61883 ON SEPTEMBER 24, 1990

DESIGNED	R.L.G.	JOB NO.	NTD88047
DRAWN	D.A.N.	DATE	SEP. 1990
TRACED	J.W.G.	SCALE	H. 1"=100'
CHECKED			V. 1"=10'

FREESE AND NICHOLS INC.
CONSULTING ENGINEERS
FORT WORTH - ARLINGTON - AUSTIN, TEXAS

NORTH TEXAS MUNICIPAL WATER DISTRICT
WYLIE - ROCKWALL - FARMERSVILLE PIPELINE

30-INCH PIPELINE
SHEET INDEX / LEGEND

SH. 1
OF 28

CF 88-3