




VALVE PIT LIGHTING AND POWER PLAN

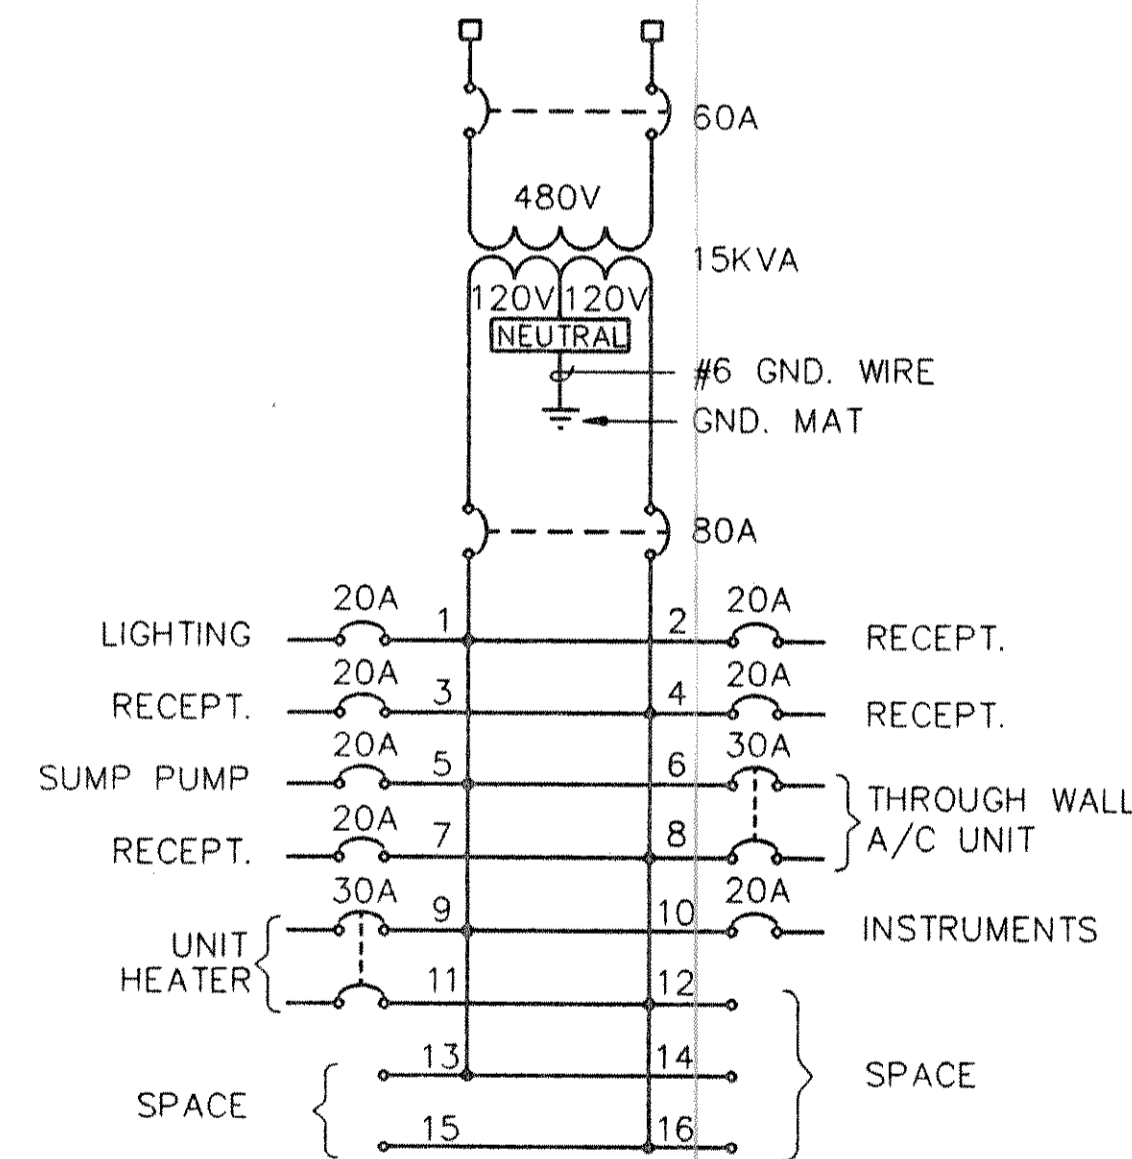


PACKAGED POWER SUPPLY PPSA

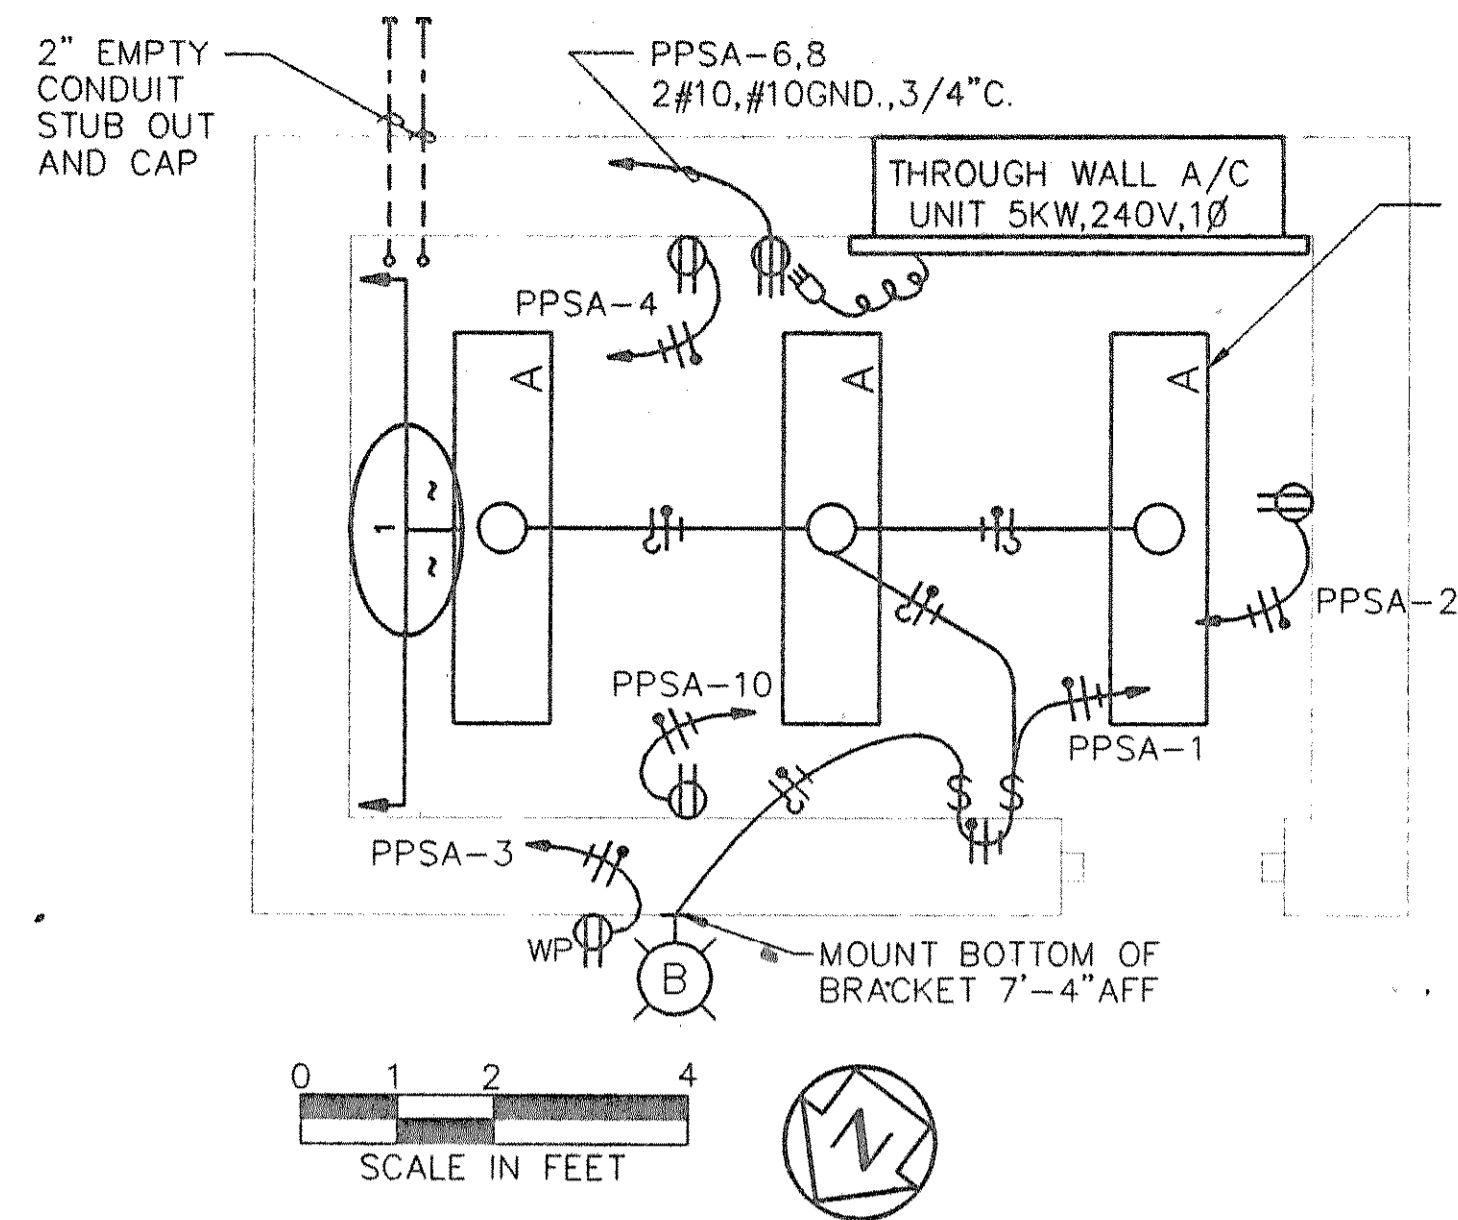


ELECTRICAL ROOM LIGHTING AND POWER PLAN

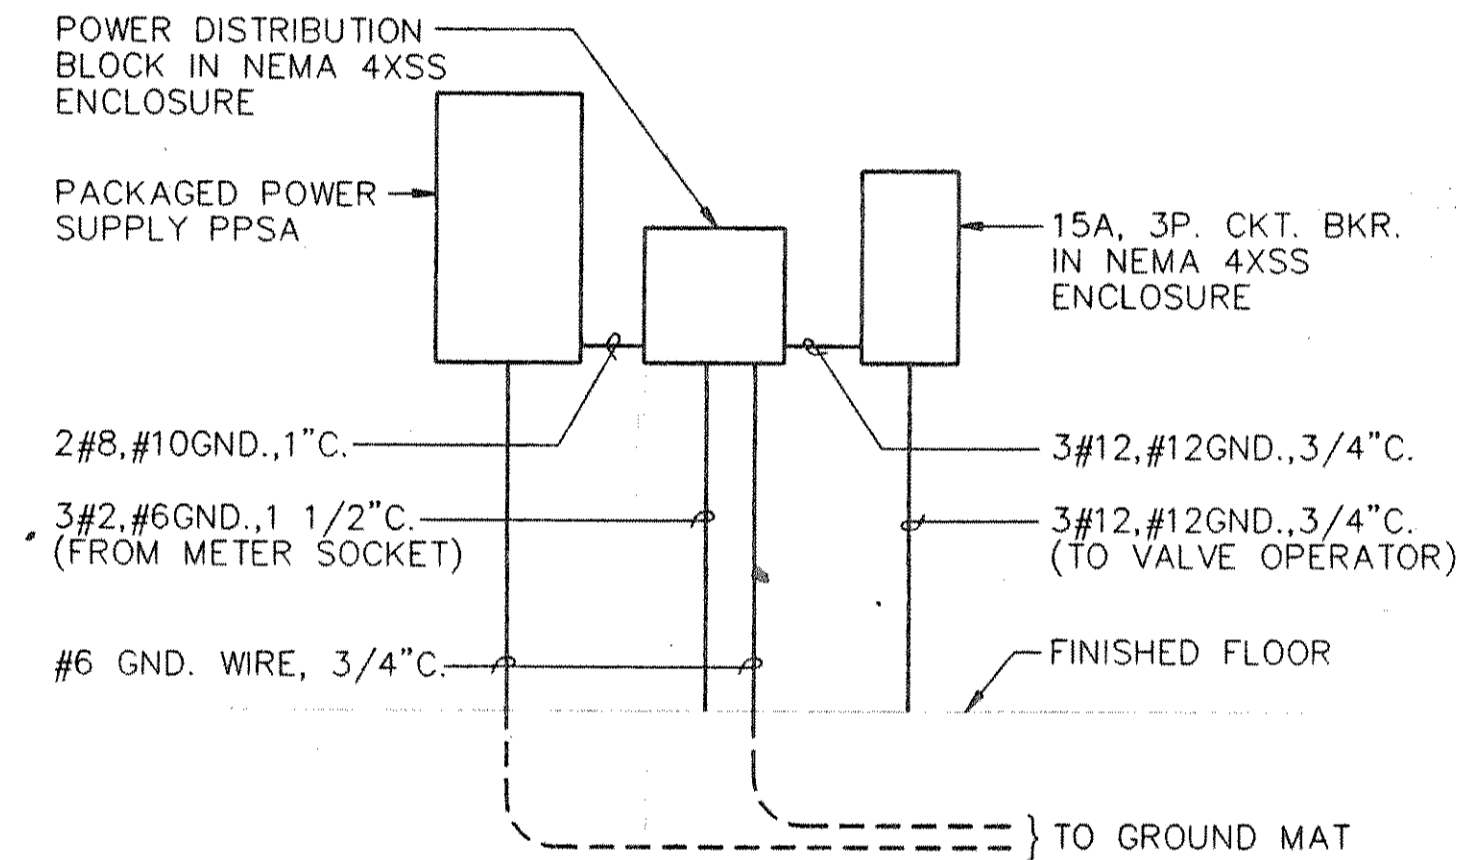


ELEVATION ELECTRICAL EQUIPMENT

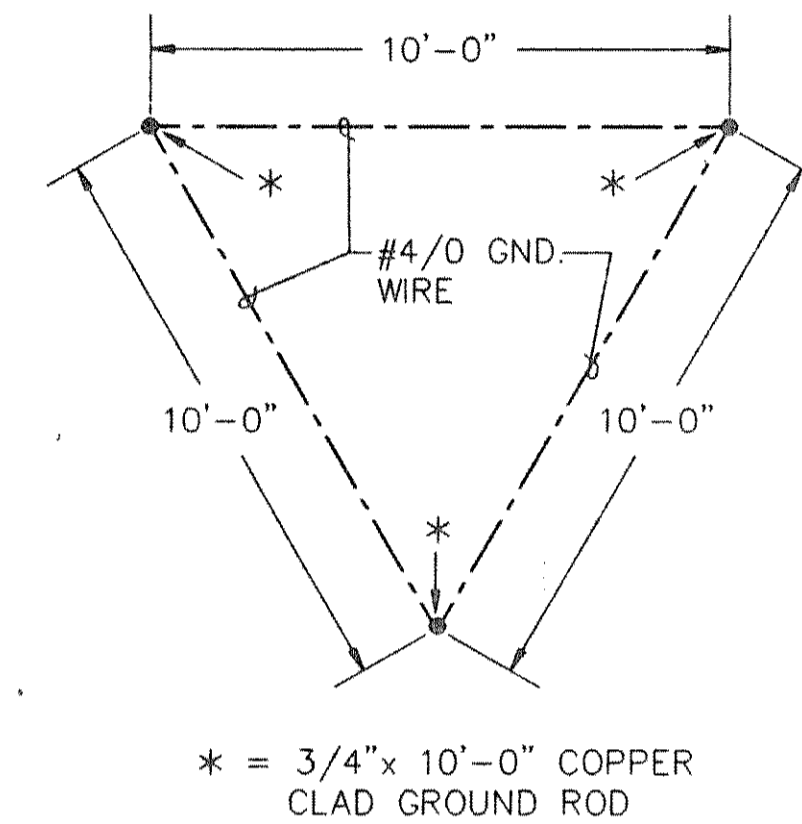


DETAIL B - GROUND MAT

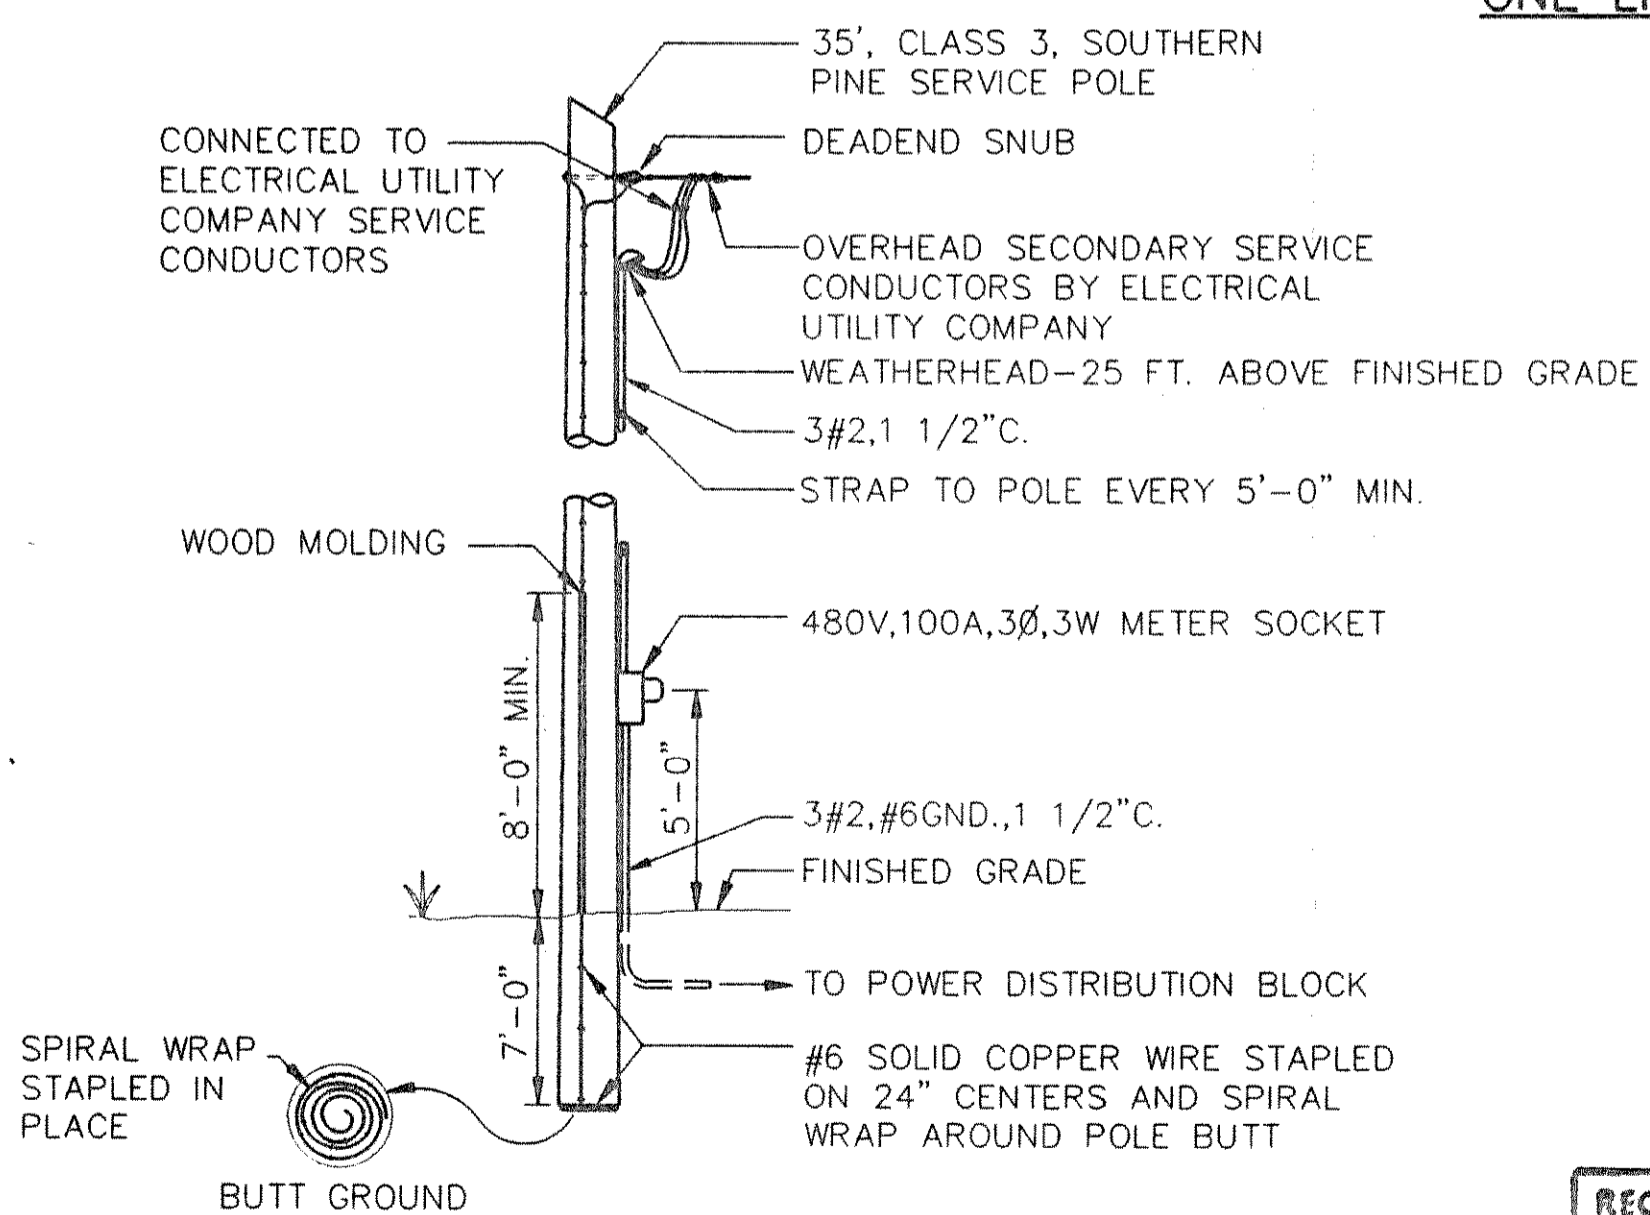

DETAIL A - METER SOCKET AND POLE DETAIL

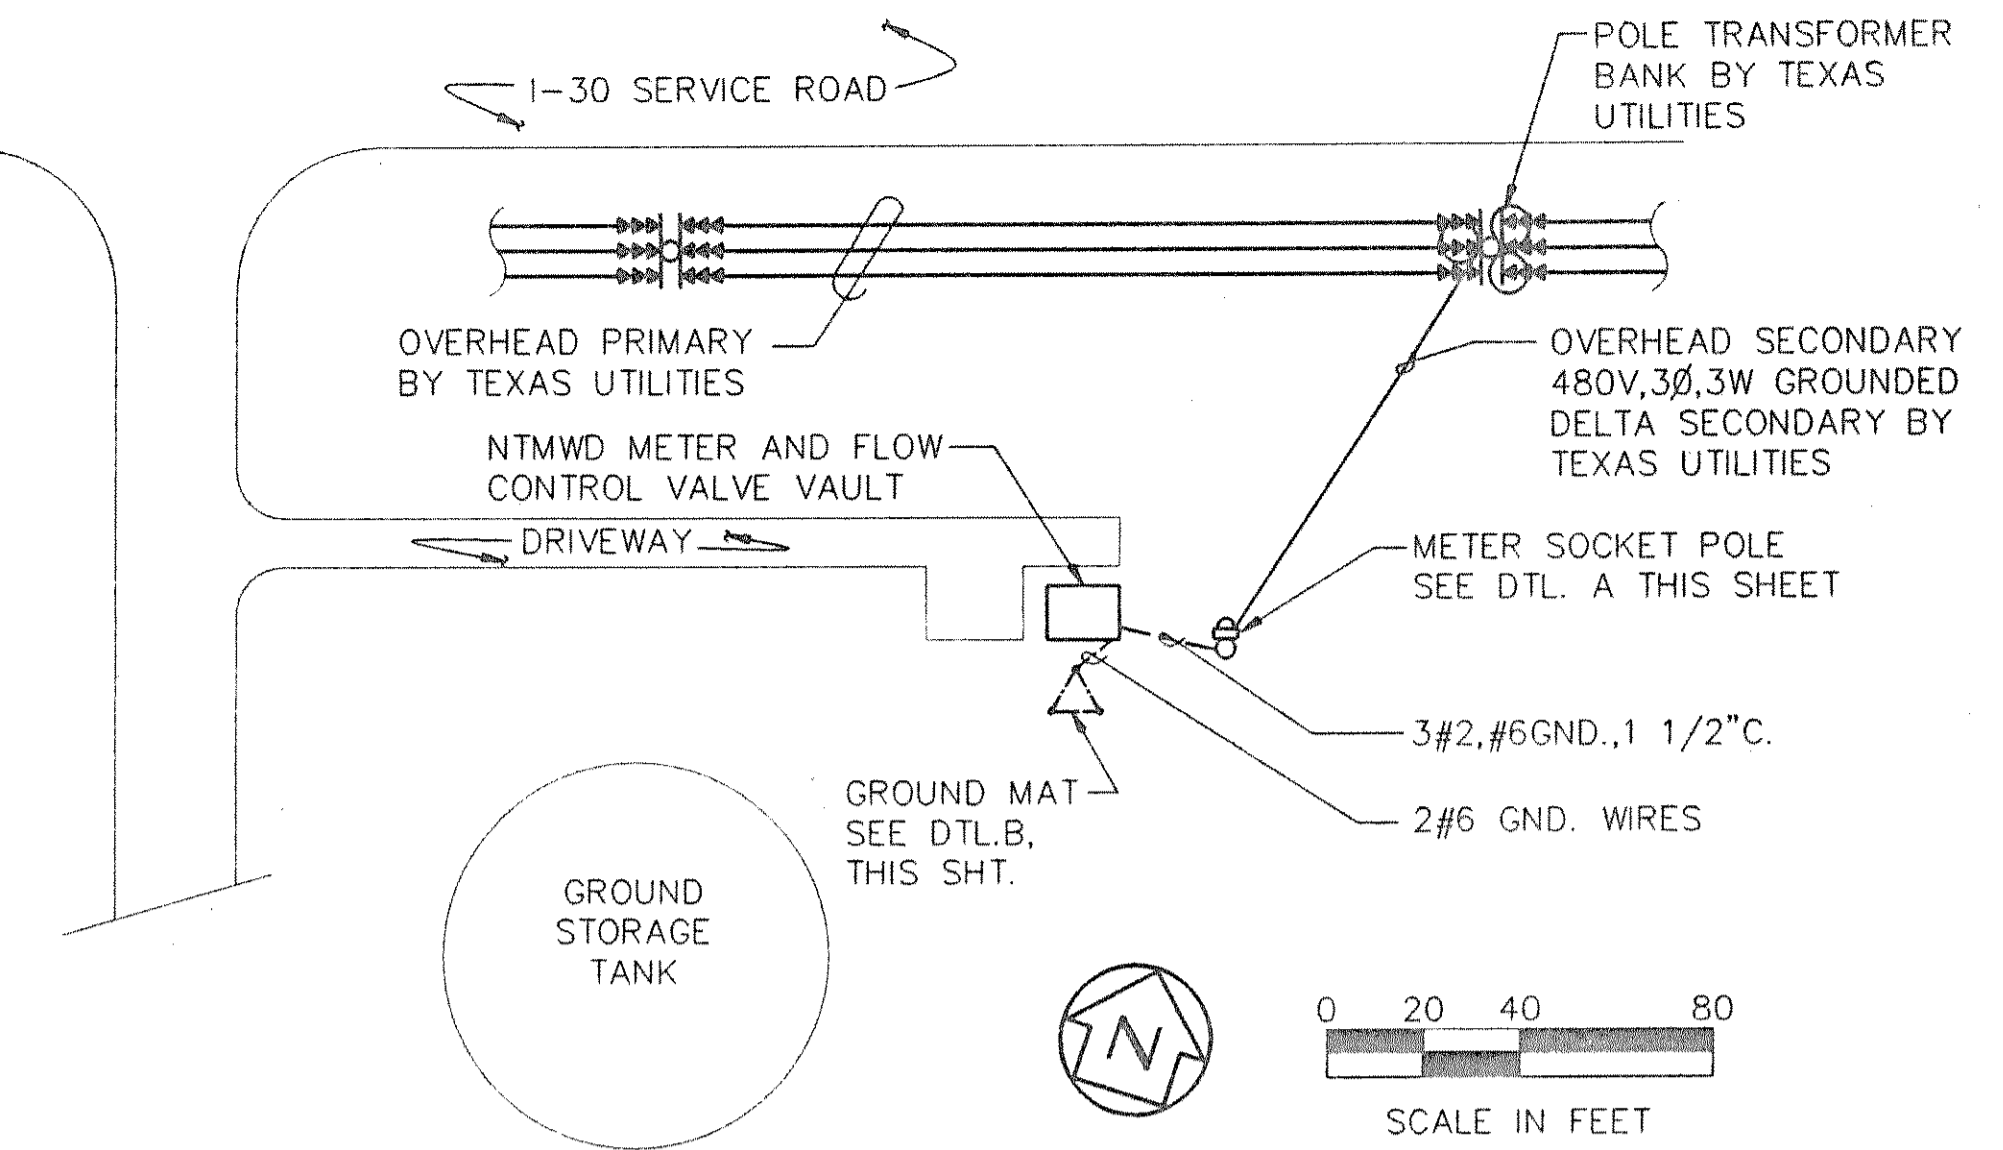


SITE PLAN

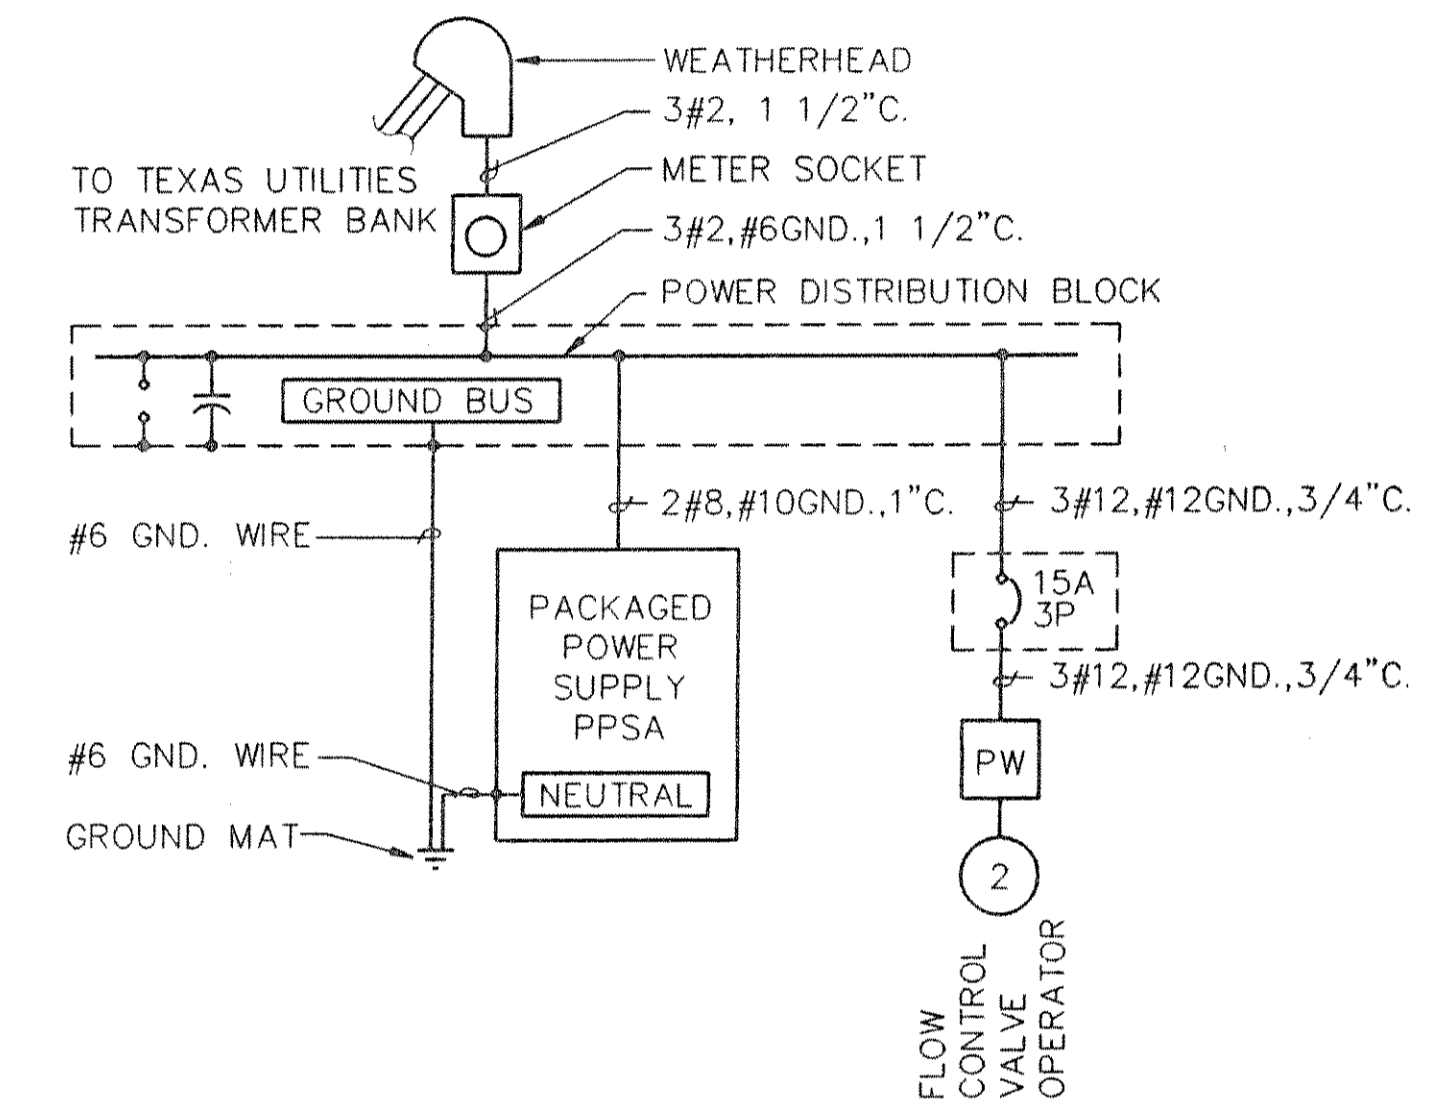

ONE LINE DIAGRAM

RECORD DRAWING

Date 4/15/94 By [Signature]

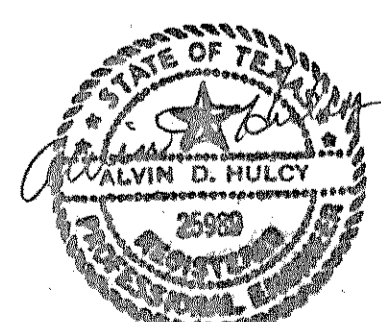

9-27-90

ACAD/BYRD D:\NTD88047\NTD001ED.DWG

DESIGNED	MAC	JOB NO.	NTD88047
DRAWN	6-21-90	DATE	
TRACED		SCALE	AS SHOWN
CHECKED			

FREESE AND NICHOLS, INC.
CONSULTING ENGINEERS
FORT WORTH - ARLINGTON - AUSTIN, TEXAS

NORTH TEXAS MUNICIPAL WATER DISTRICT
WYLIE - ROCKWALL - FARMERSVILLE PIPELINE

METER VAULT - ELECTRICAL
ONE LINE DIAGRAM, LIGHTING AND POWER PLANS

SH. 23
OF 28