


**PLAN - N.T.M.W.D.
FLOW TUBE VAULT**
Scale: 1/2" = 1'-0"

SITE PLAN
Scale: 1" = 20'
(NEW SHOWN DARKENED)

**SECTION - FLOW TRANSMITTER
MOUNTING DETAIL**
Not To Scale

**CONTROL PLATE AT
WATER TREATMENT PANEL**
N.T.S.

NOTE: Mount Flow Transmitter
2" Below Elevation Of Flow Tube
Tops, Slope Tubing To
Transmitters With No Traps.

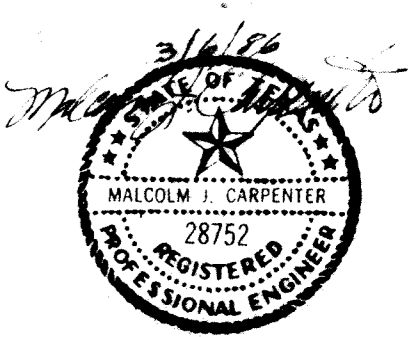

DESIGNED	R.A.H.	JOB NO.	ROK 86803
DRAWN	J.C.C.	DATE	
TRACED		SCALE	AS SHOWN
CHECKED			

FRESE AND NICHOLS, INC.
CONSULTING ENGINEERS
FORT WORTH-ARLINGTON-AUSTIN, TEXAS

CITY OF ROCKWALL, TEXAS
HEATH STREET PUMP STATION-3.0 MG GROUND STORAGE TANK ADDITION

**ELECTRICAL
SITE PLAN AND DETAILS**