




PLAN - EXISTING N.T.M.W.D. INSTRUMENT BUILDING
(NEW SHOWN DARKENED)
N.T.S.

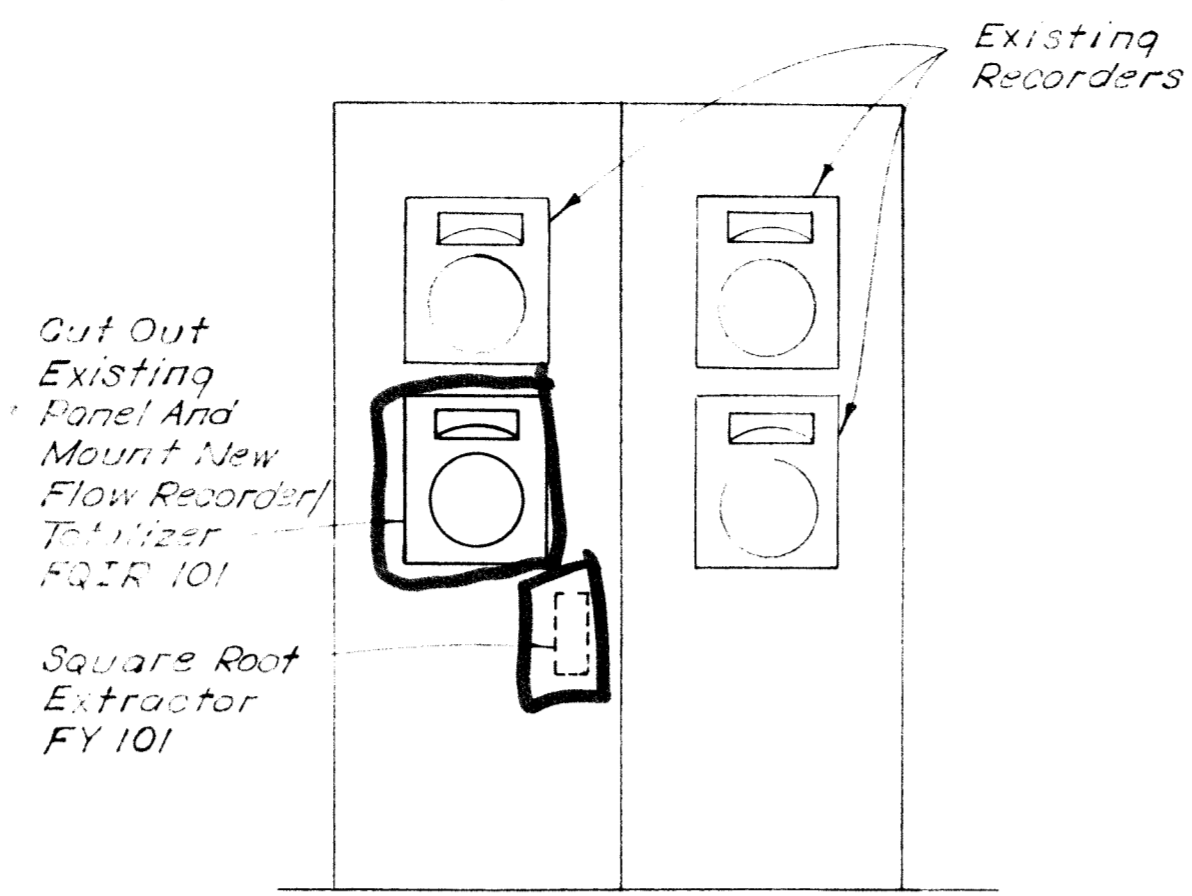


ELEVATION - EXISTING INSTRUMENT RACK N.T.M.W.D. INSTRUMENT BLDG.
(NEW SHOWN DARKENED)
N.T.S.

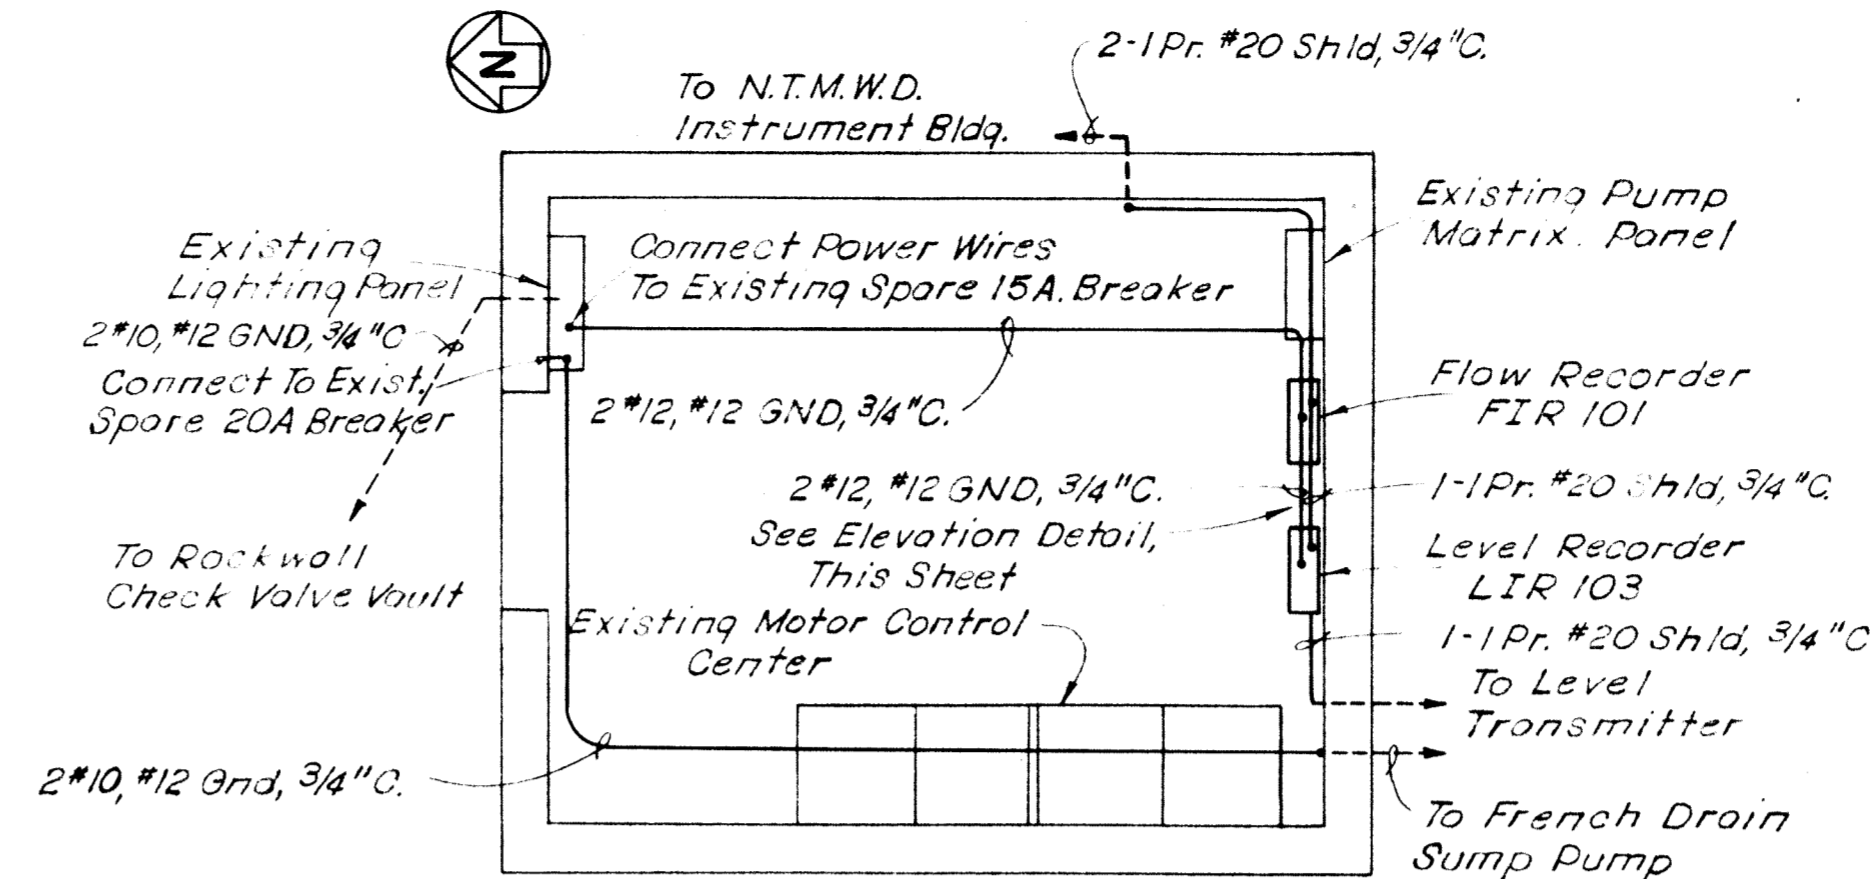


PLAN - EXISTING CITY OF ROCKWALL EQUIPMENT BUILDING
(NEW SHOWN DARKENED)
N.T.S.

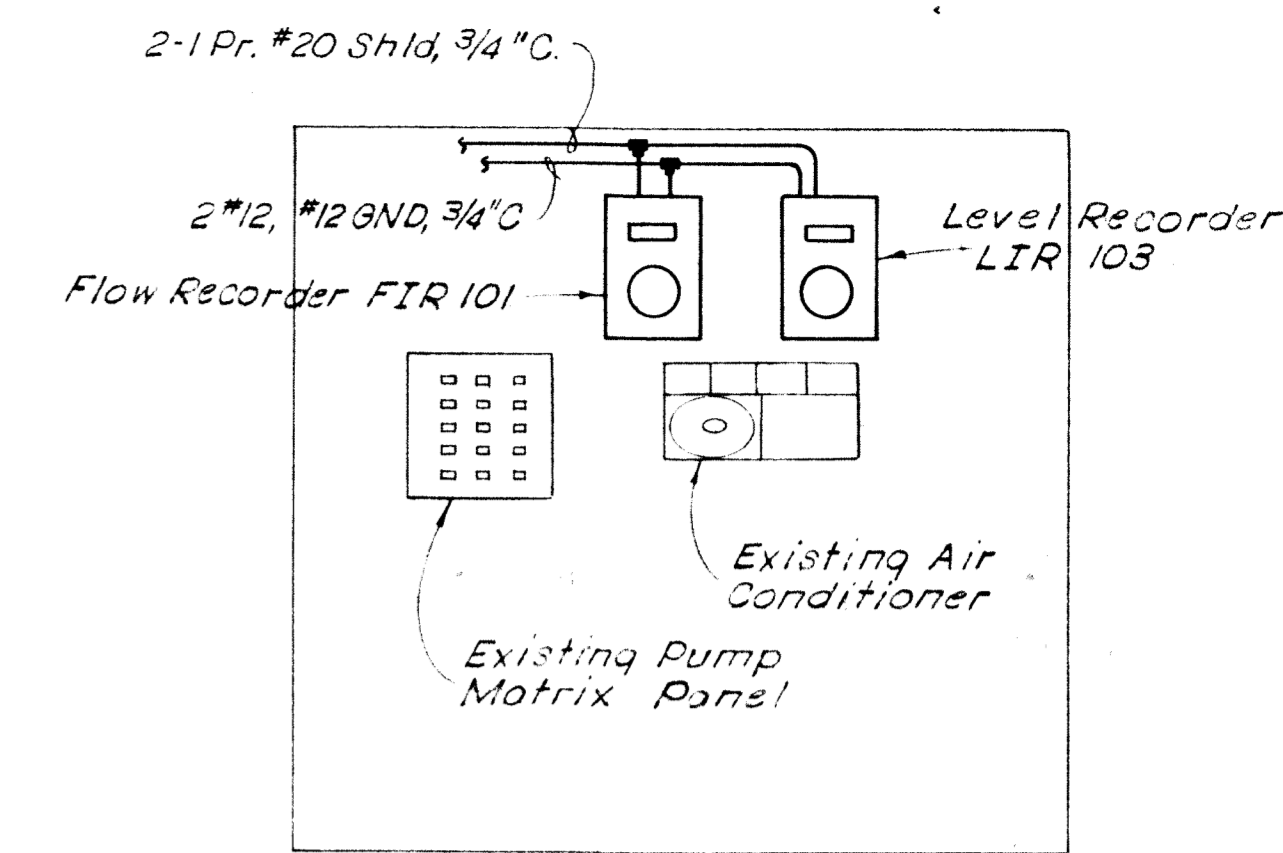



ELEVATION - SOUTH WALL OF EXISTING CITY OF ROCKWALL EQUIP. BUILDING
(NEW SHOWN DARKENED)
N.T.S.

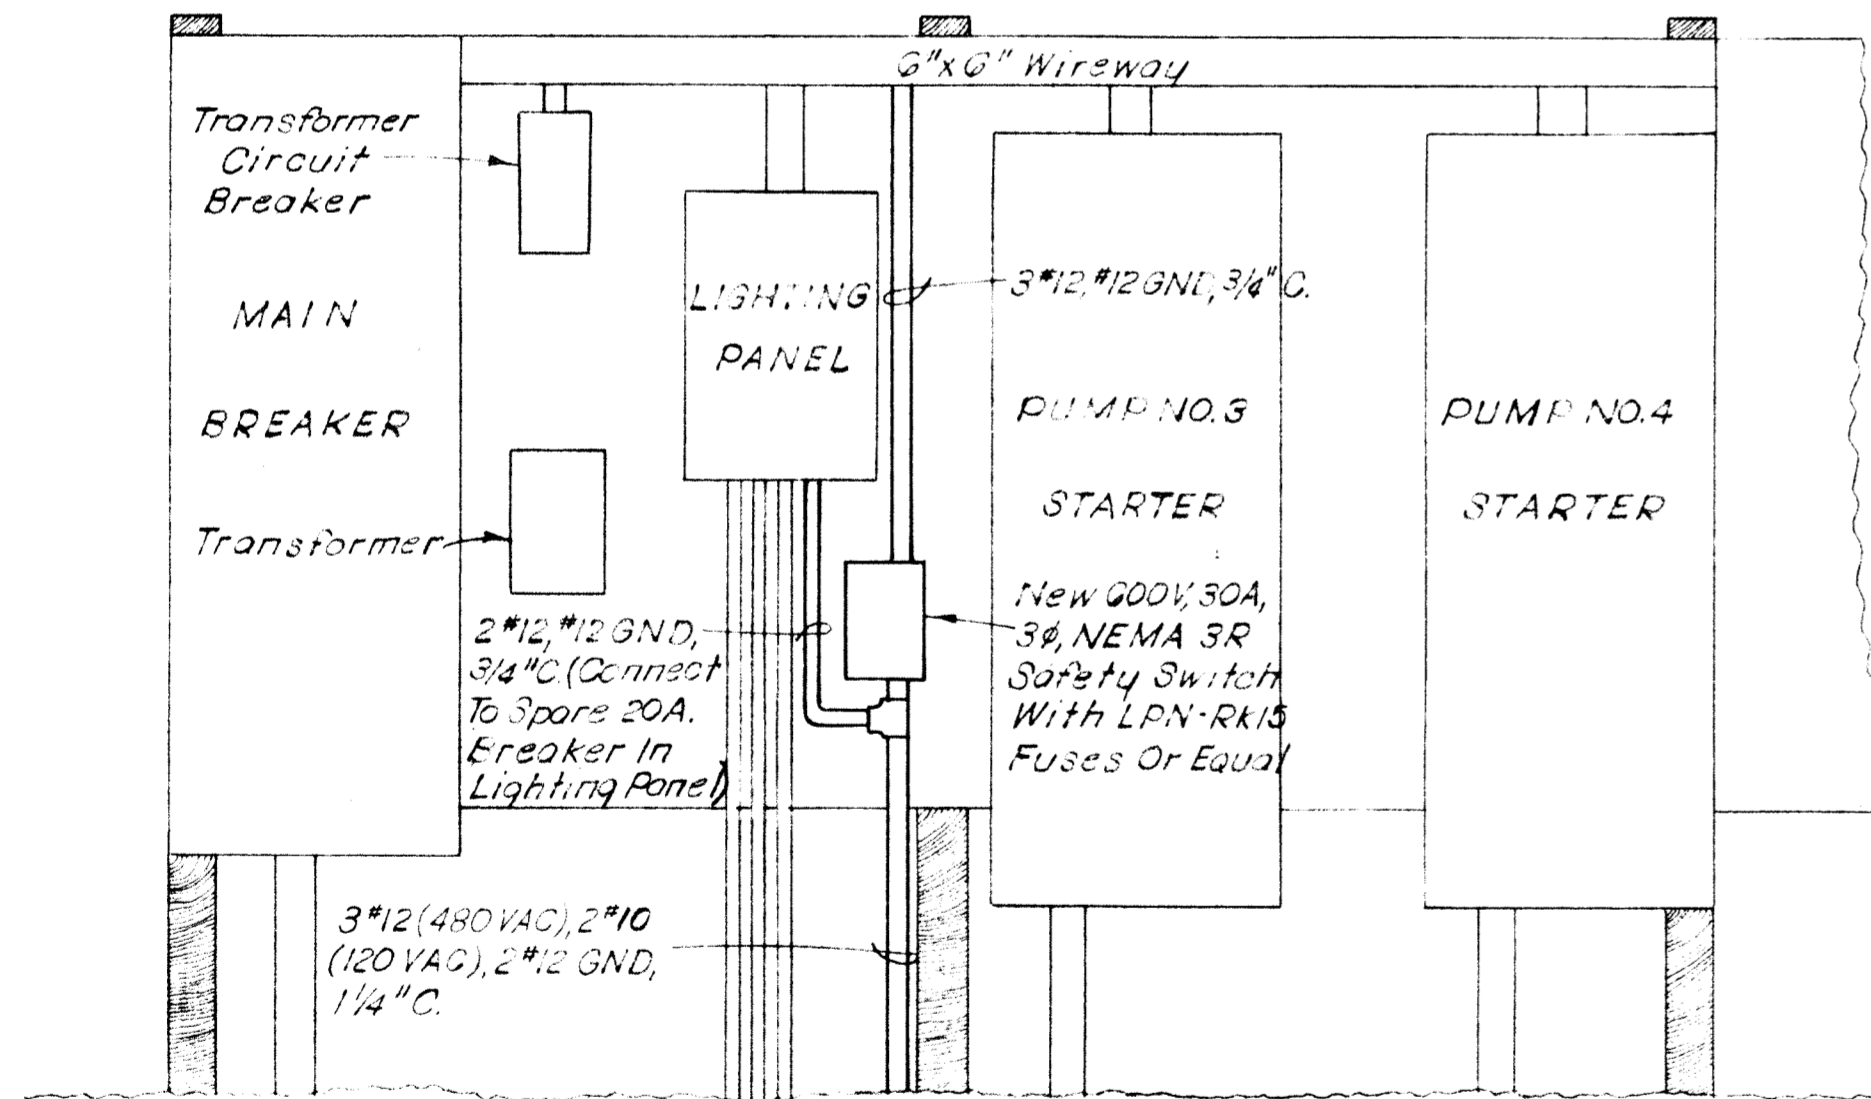

ELEVATION - ELECTRIC EQUIPMENT RACK
(NEW SHOWN DARKENED)
N.T.S.

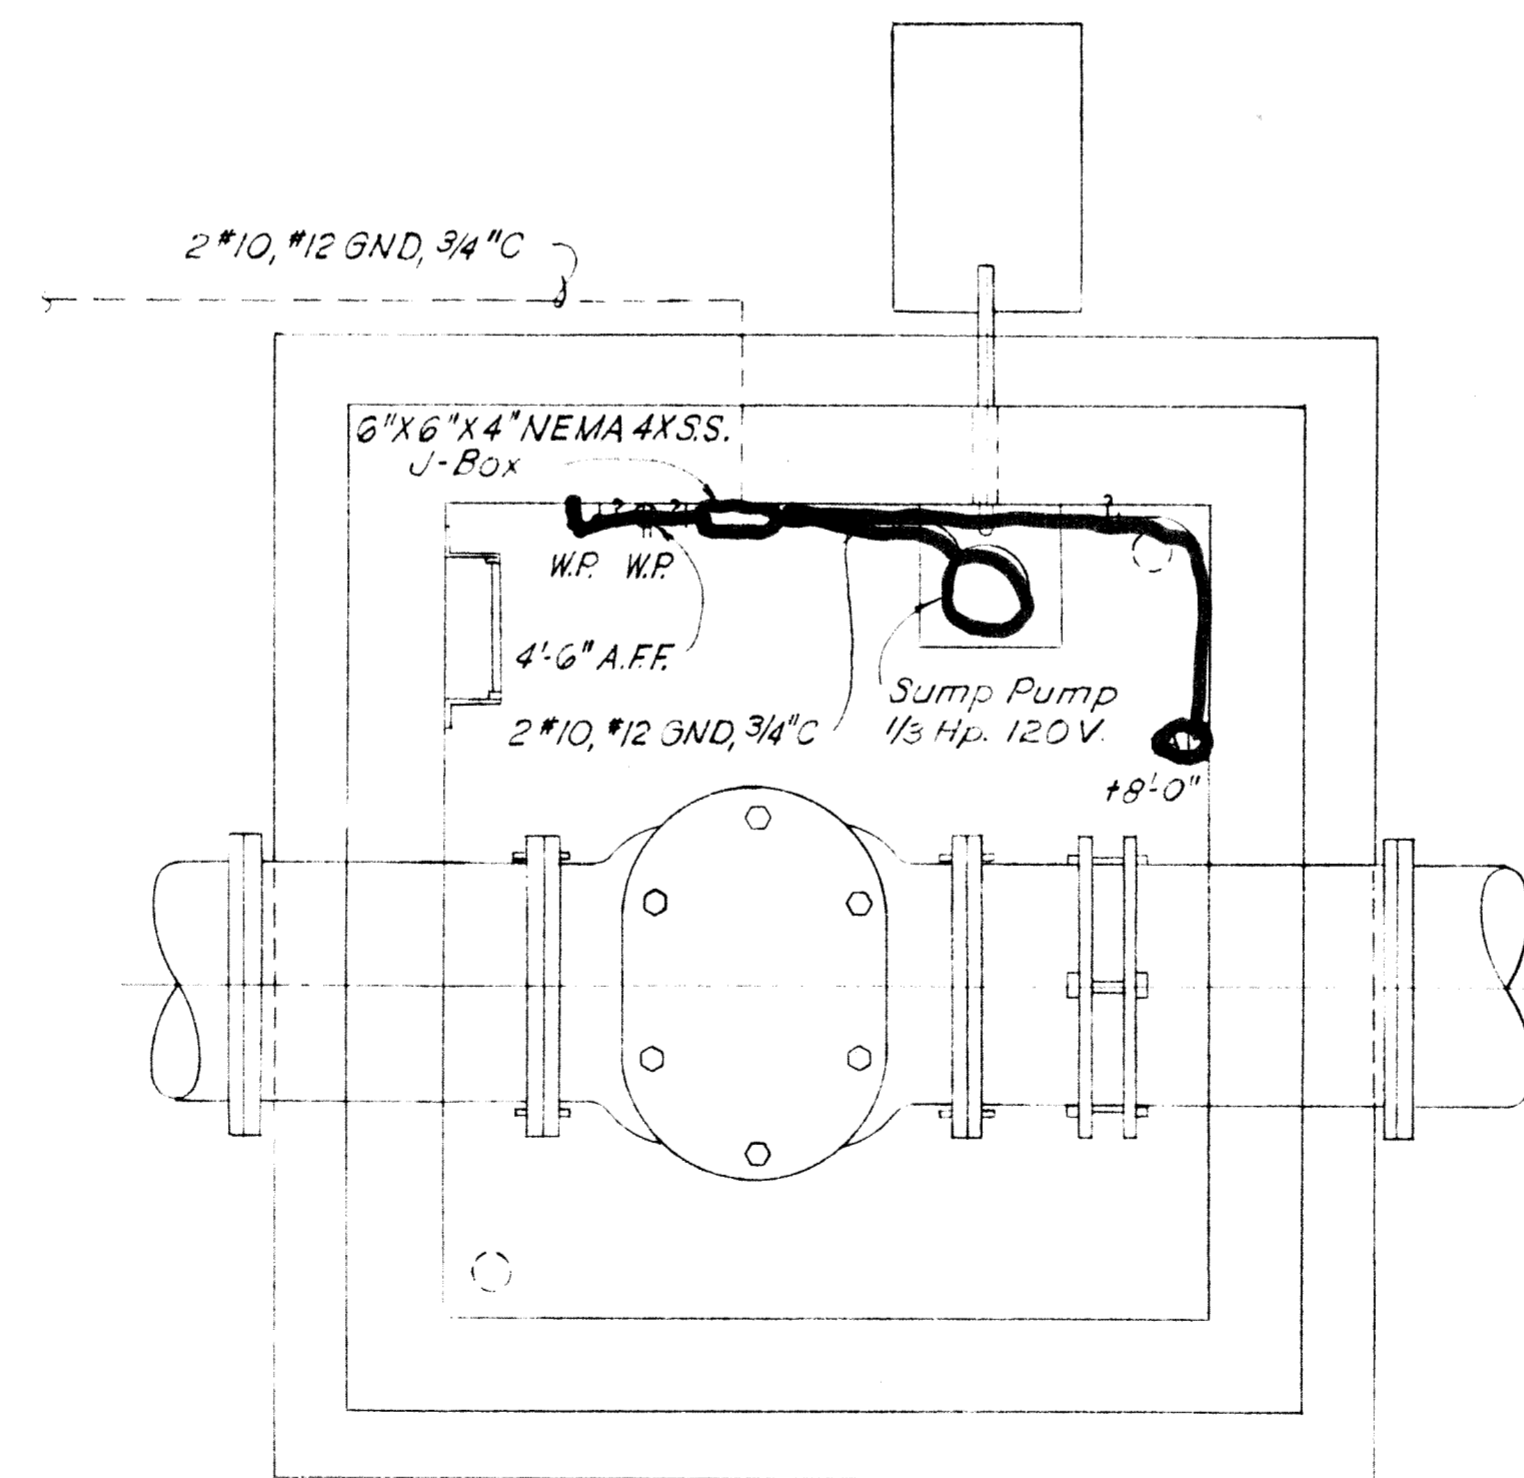

PLAN - ROCKWALL CHECKVALVE VAULT
Scale: 1/2" = 1'-0"

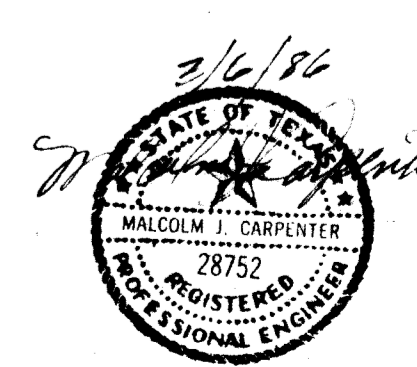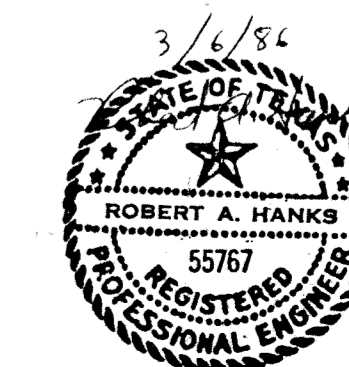

DESIGNED	DATE	JOB NO.	ROK 86803
DRAWN	DATE	SCALE	NOT TO SCALE
TRACED			
CHECKED			

FRESE AND NICHOLS, INC.
CONSULTING ENGINEERS
FORT WORTH-ARLINGTON-AUSTIN, TEXAS

CITY OF ROCKWALL, TEXAS
HEATH STREET PUMP STATION-3.0 MG GROUND STORAGE TANK ADDITION

ELECTRICAL
WIRING DETAILS

E-3

10 OF 10