
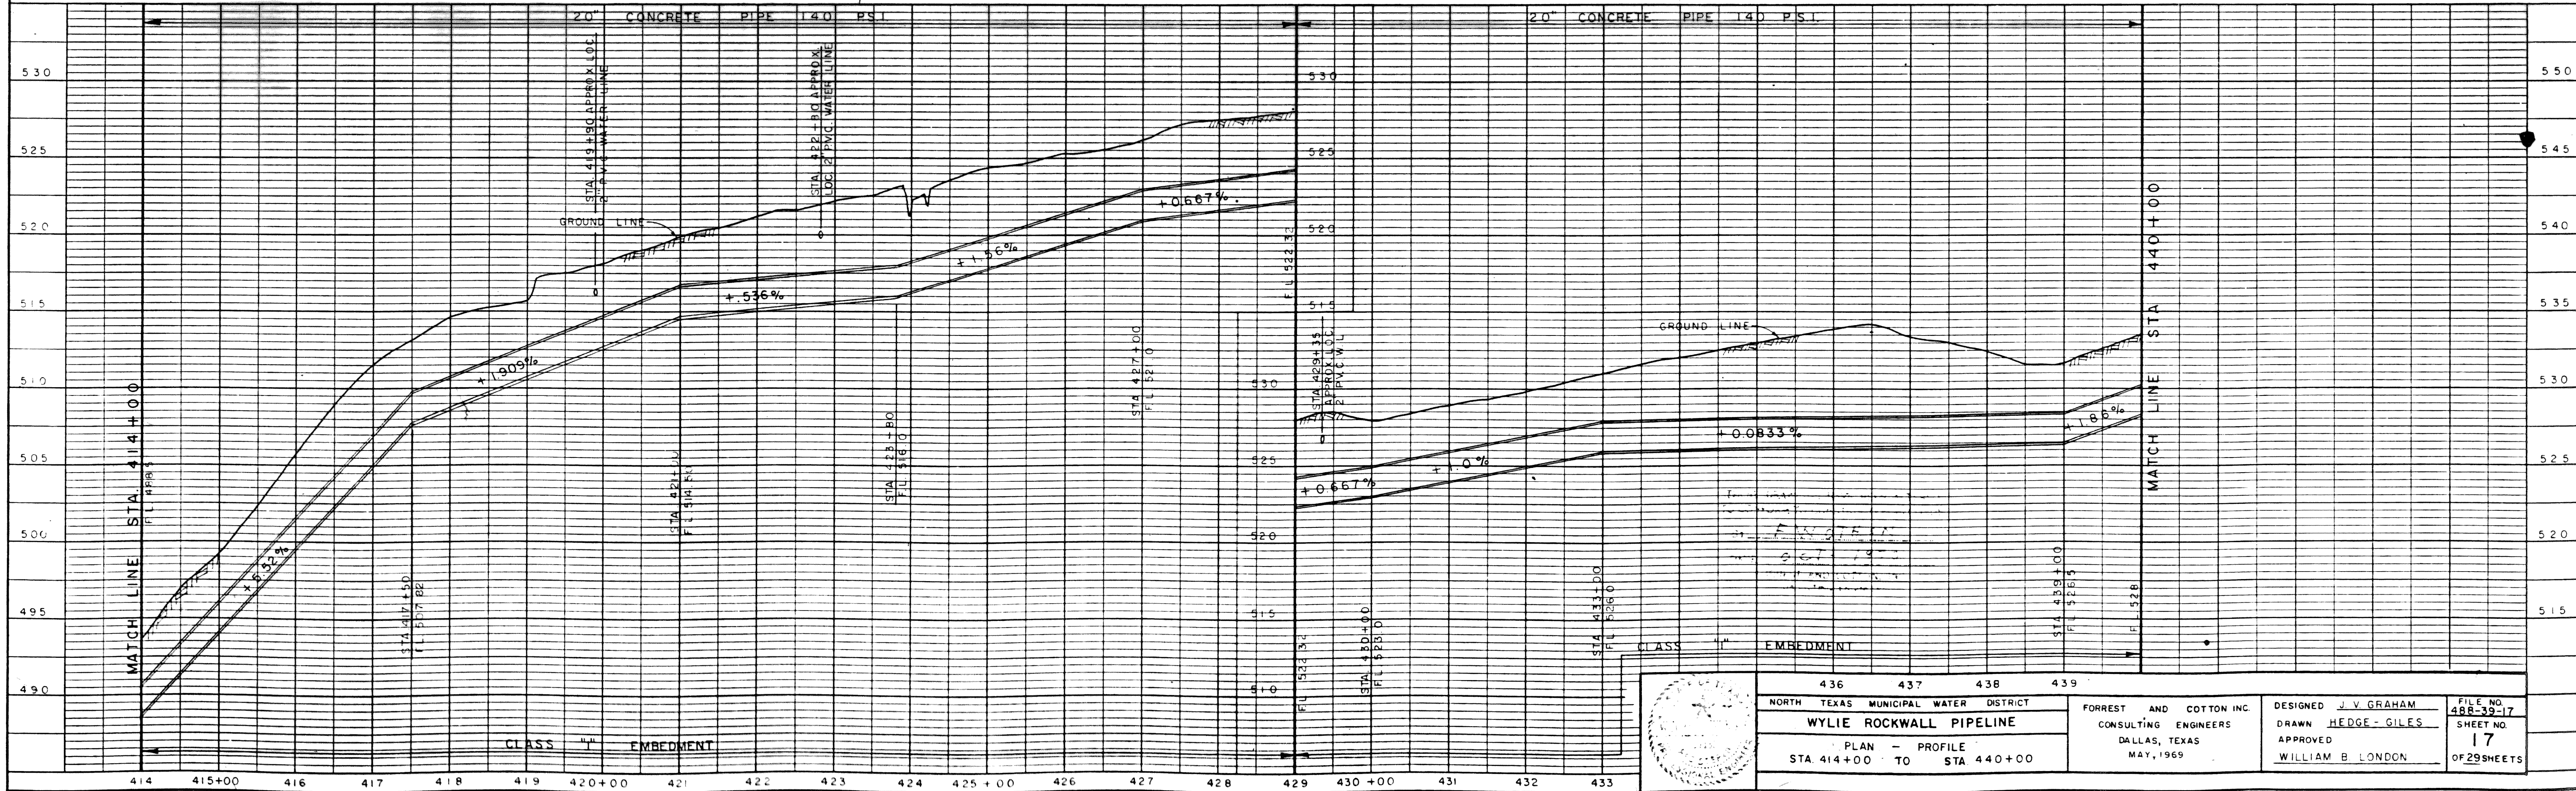
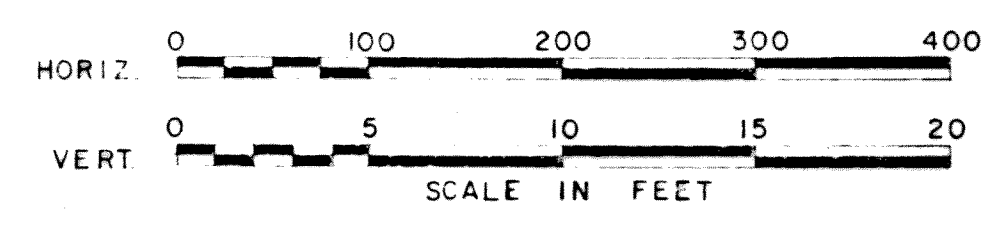


PLAN
 SURVEYED BY DATE
 PLOTTED BY DATE
 NOTE BOOK NO. OF WAY CHECKED
 NO. OF WAY CHECKED

PROFILE
 SURVEYED BY DATE
 PLOTTED BY DATE
 NOTE BOOK NO. GRADES CHECKED
 NO. GRADES CHECKED
 STRUCTURE NOTING CH'VD

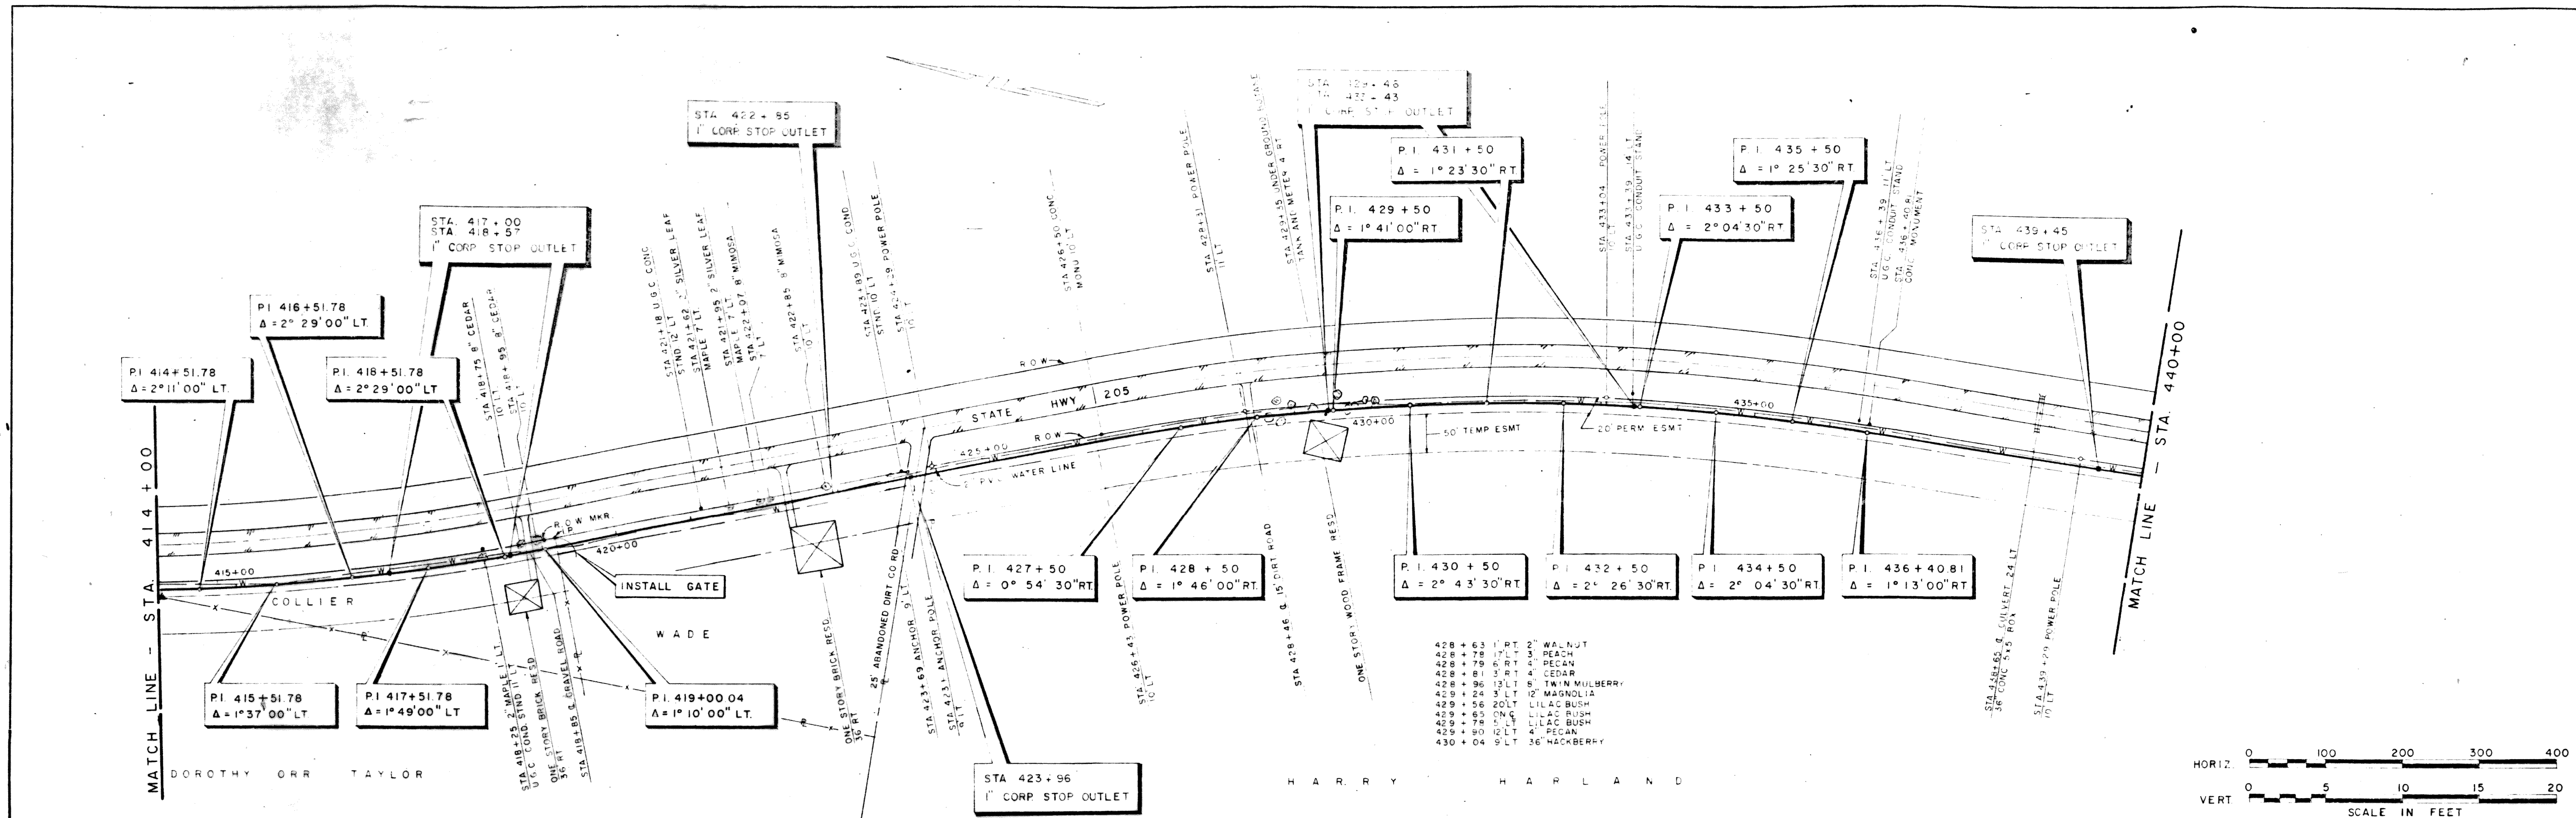

	436 437 438 439	NORTH TEXAS MUNICIPAL WATER DISTRICT	FORREST AND COTTON INC.	DESIGNED J. V. GRAHAM	FILE NO. 488-39-17
	WYLIE ROCKWALL PIPELINE		CONSULTING ENGINEERS	DRAWN HEDGE-GILES	SHEET NO. 17
	PLAN - PROFILE STA 414+00 TO STA 440+00		DALLAS, TEXAS MAY, 1969	APPROVED WILLIAM B. LONDON	OF 29 SHEETS