
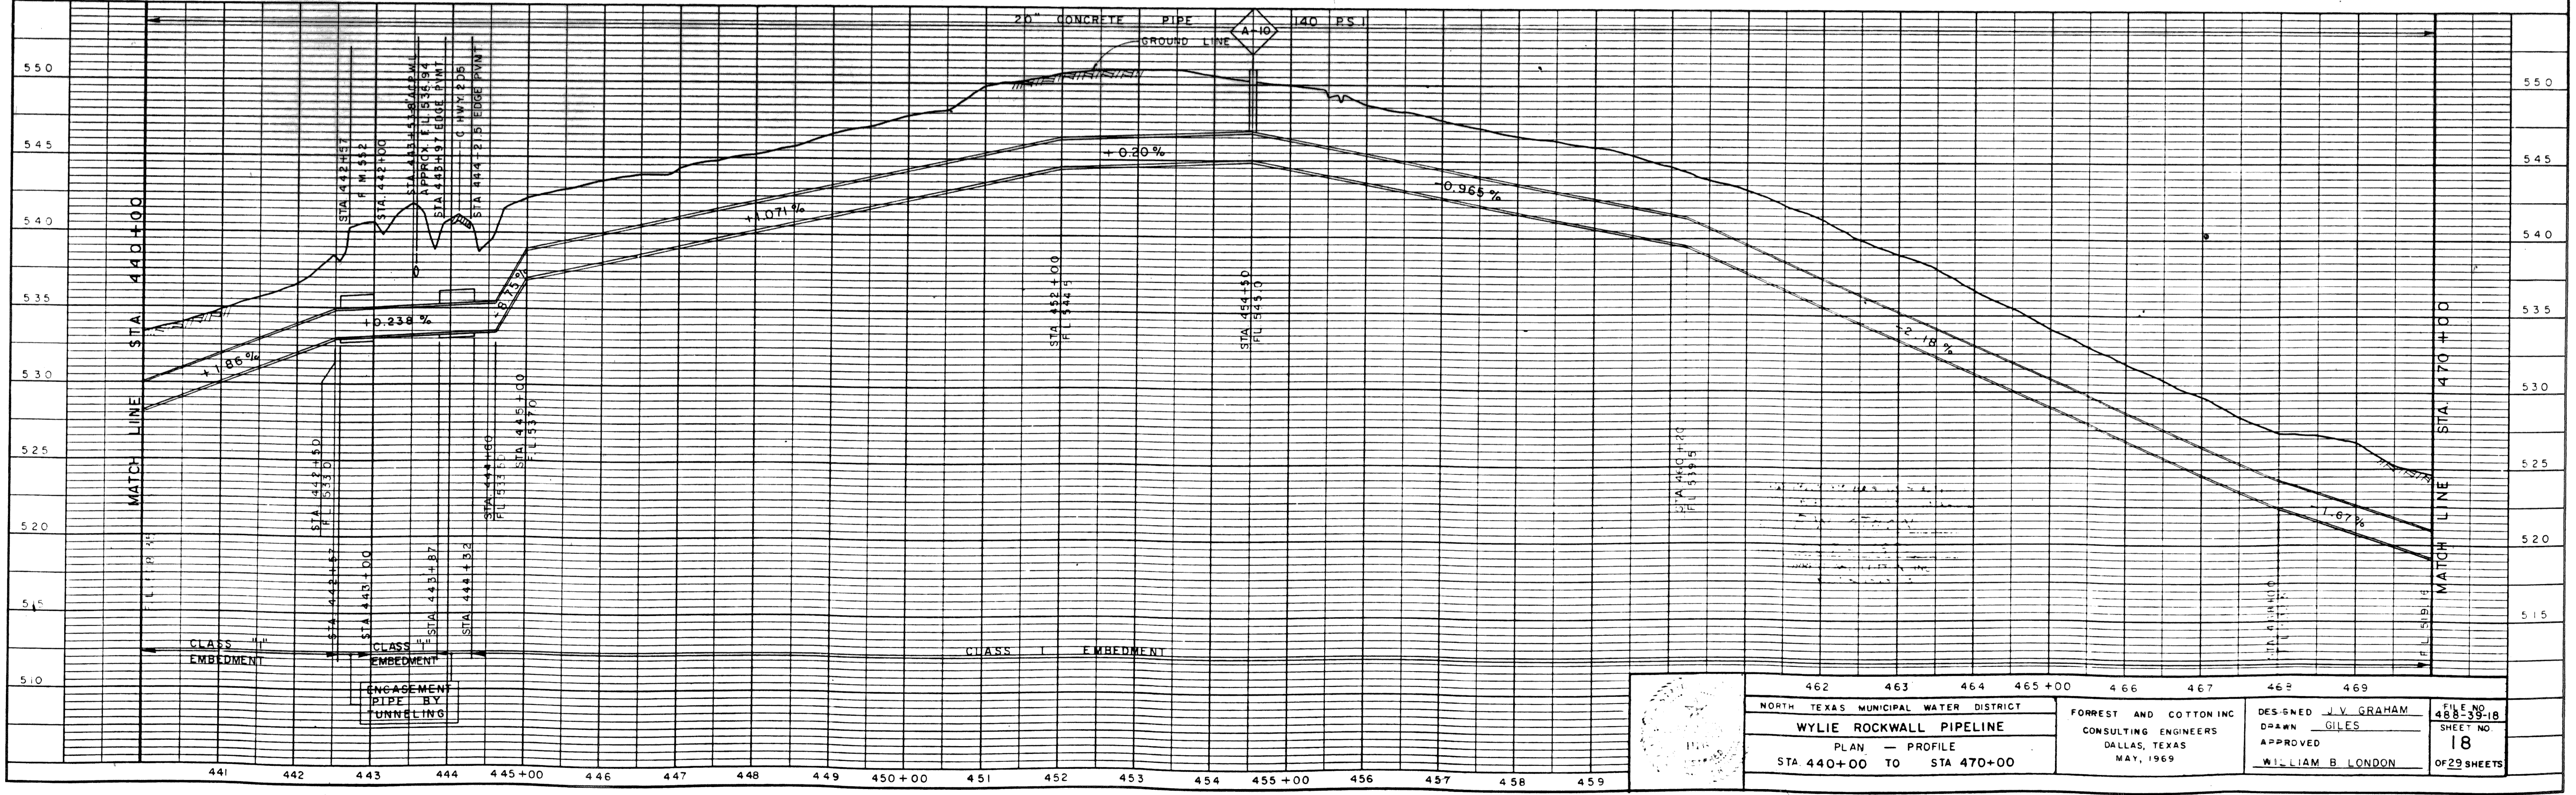
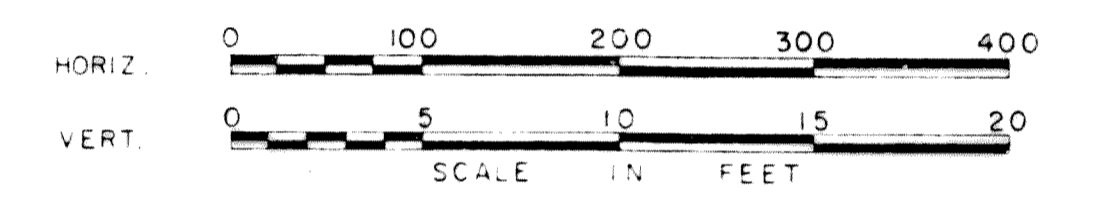


PLAN	SURVISED	BY	DATE
	PLOTTED		
	CHECKED		
	NO.		

PROFILE	SURVISED	BY	DATE
	PLOTTED		
	CHECKED		
	NO.		

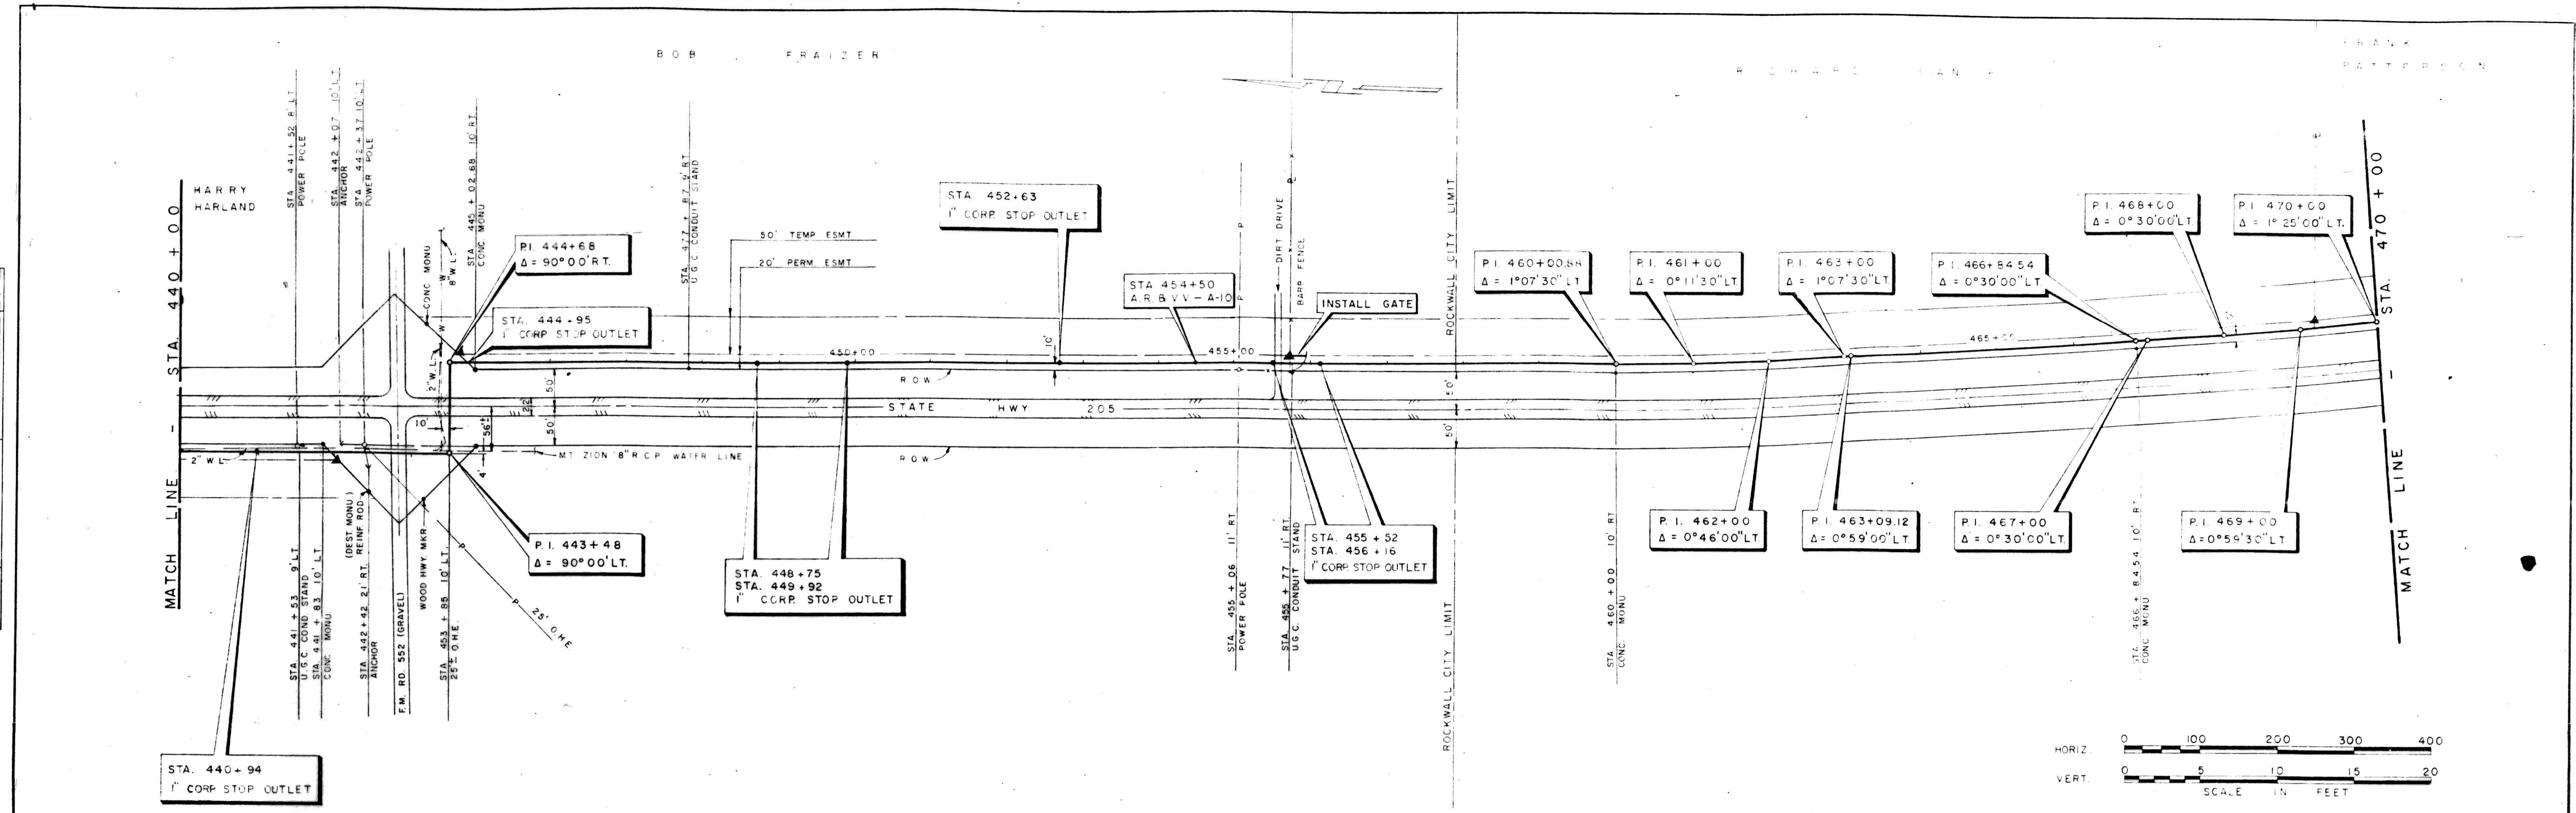

	462 463 464 465+00 466 467 468 469	FORREST AND COTTON INC CONSULTING ENGINEERS DALLAS, TEXAS MAY, 1969	DESIGNED J.V. GRAHAM	FILE NO. 488-39-18	
	NORTH TEXAS MUNICIPAL WATER DISTRICT WYLIE ROCKWALL PIPELINE		DRAWN GILES	SHEET NO. 18	
	PLAN - PROFILE STA 440+00 TO STA 470+00		APPROVED	OF 29 SHEETS	
			WILLIAM B. LONDON		

K-E PLATE 1, PLAN-PROFILE
KEUFFEL & ESSER CO.

48 7012 IMPERIAL™ TRACING CLOTH 2600