

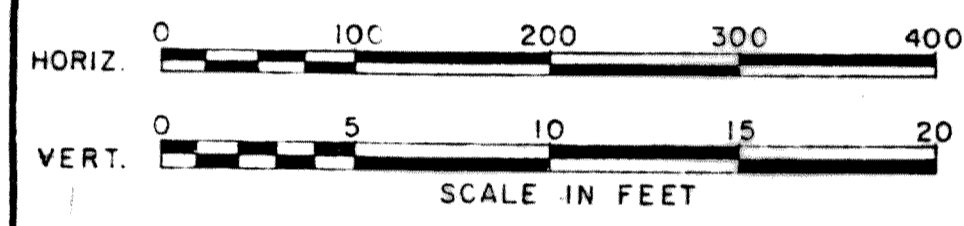
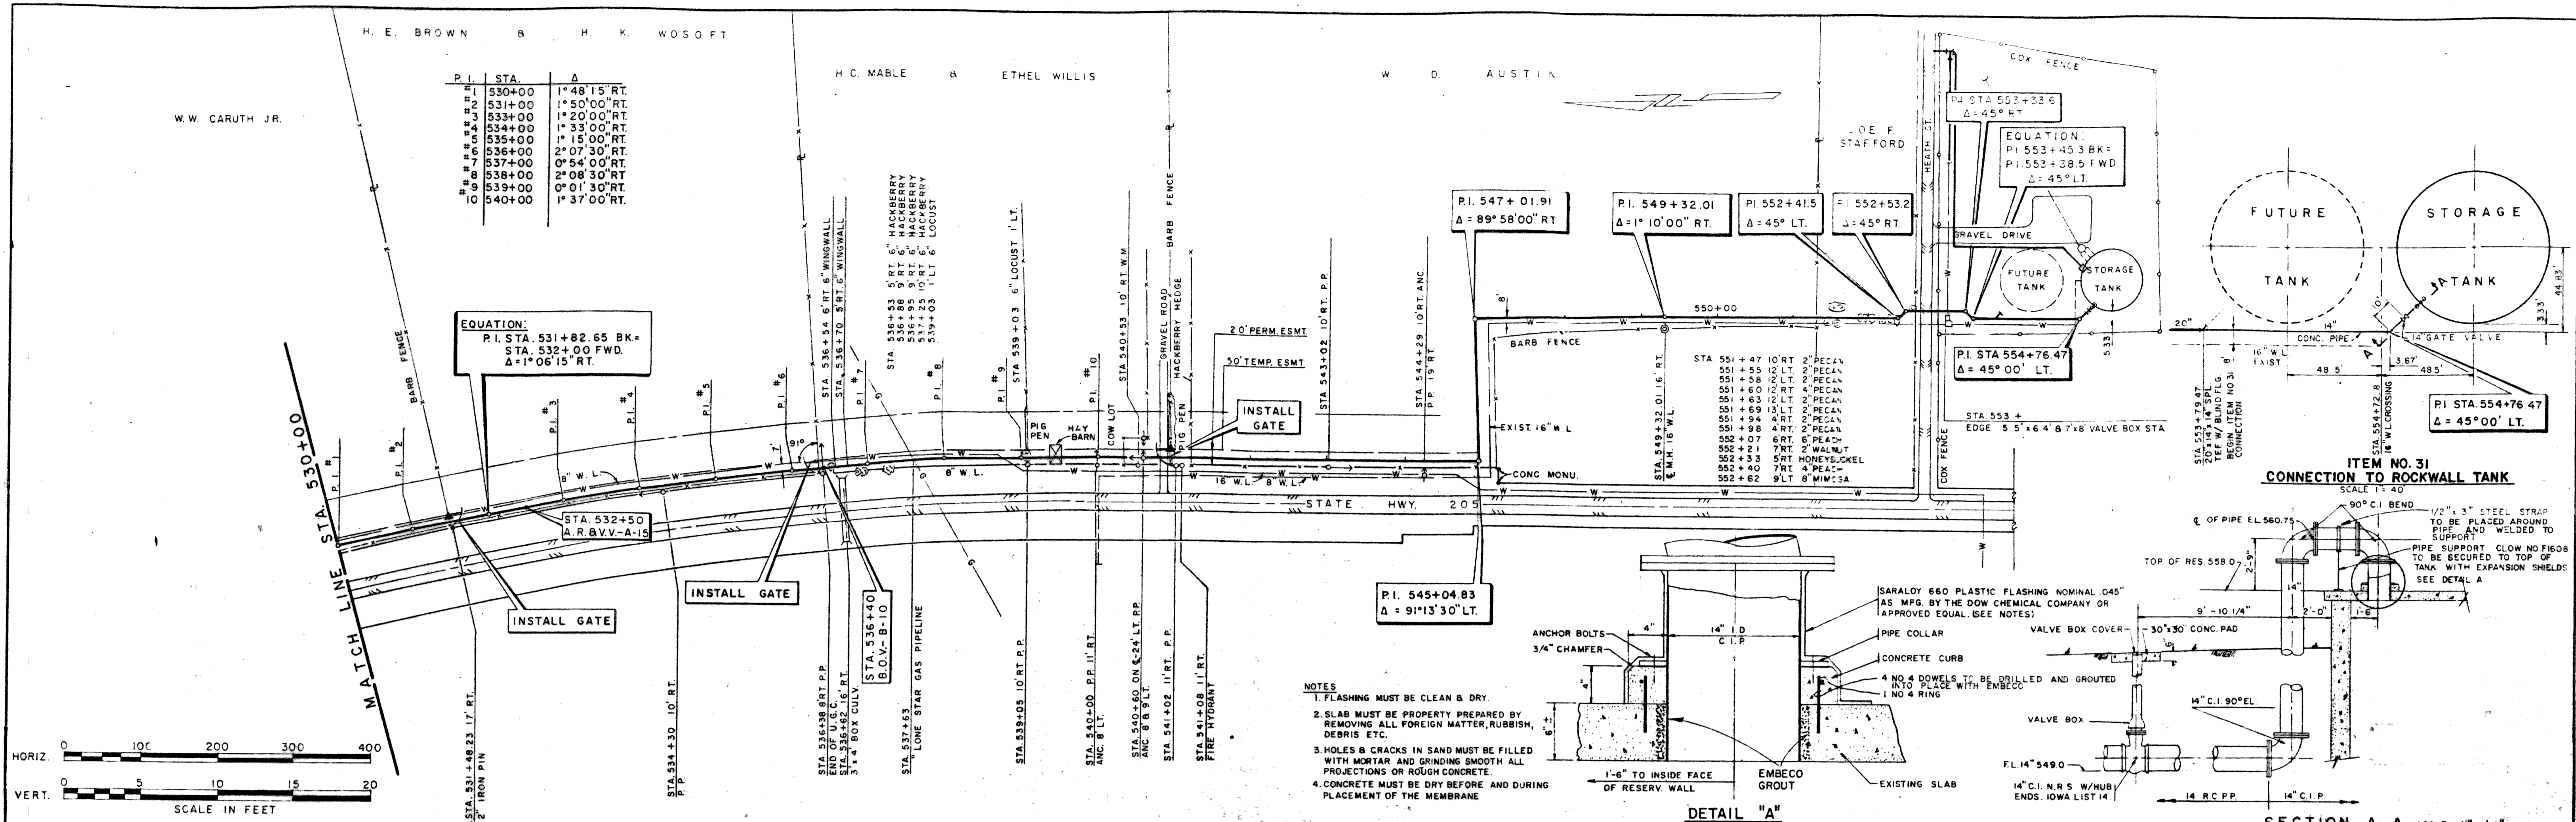
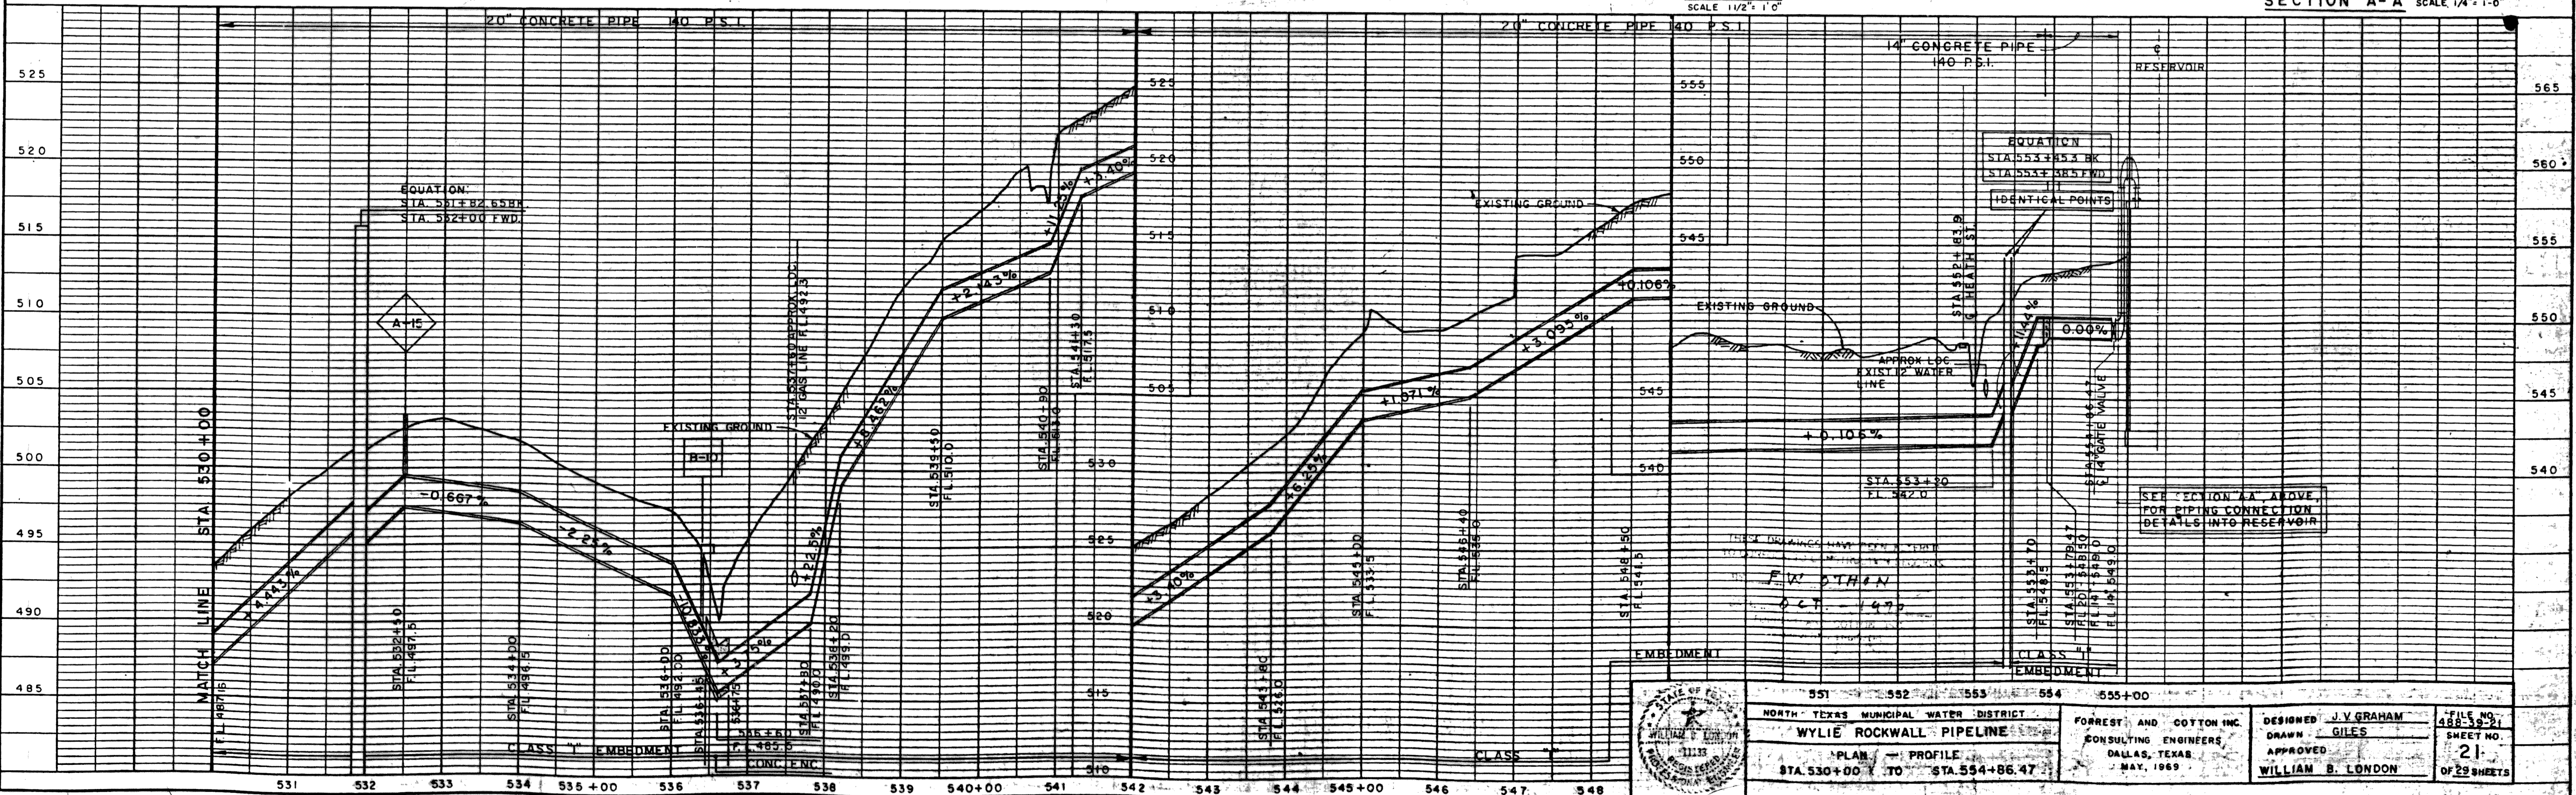


DATE: _____
 BY: _____
 SURVEYED: _____
 NOTE BOOK: _____
 CHECKED: _____
 RT. OF WAY CHECKED: _____
 NO. _____

DATE: _____
 BY: _____
 SURVEYED: _____
 NOTE BOOK: _____
 CHECKED: _____
 STRUCTURE NOTATIONS CHECKED: _____
 NO. _____

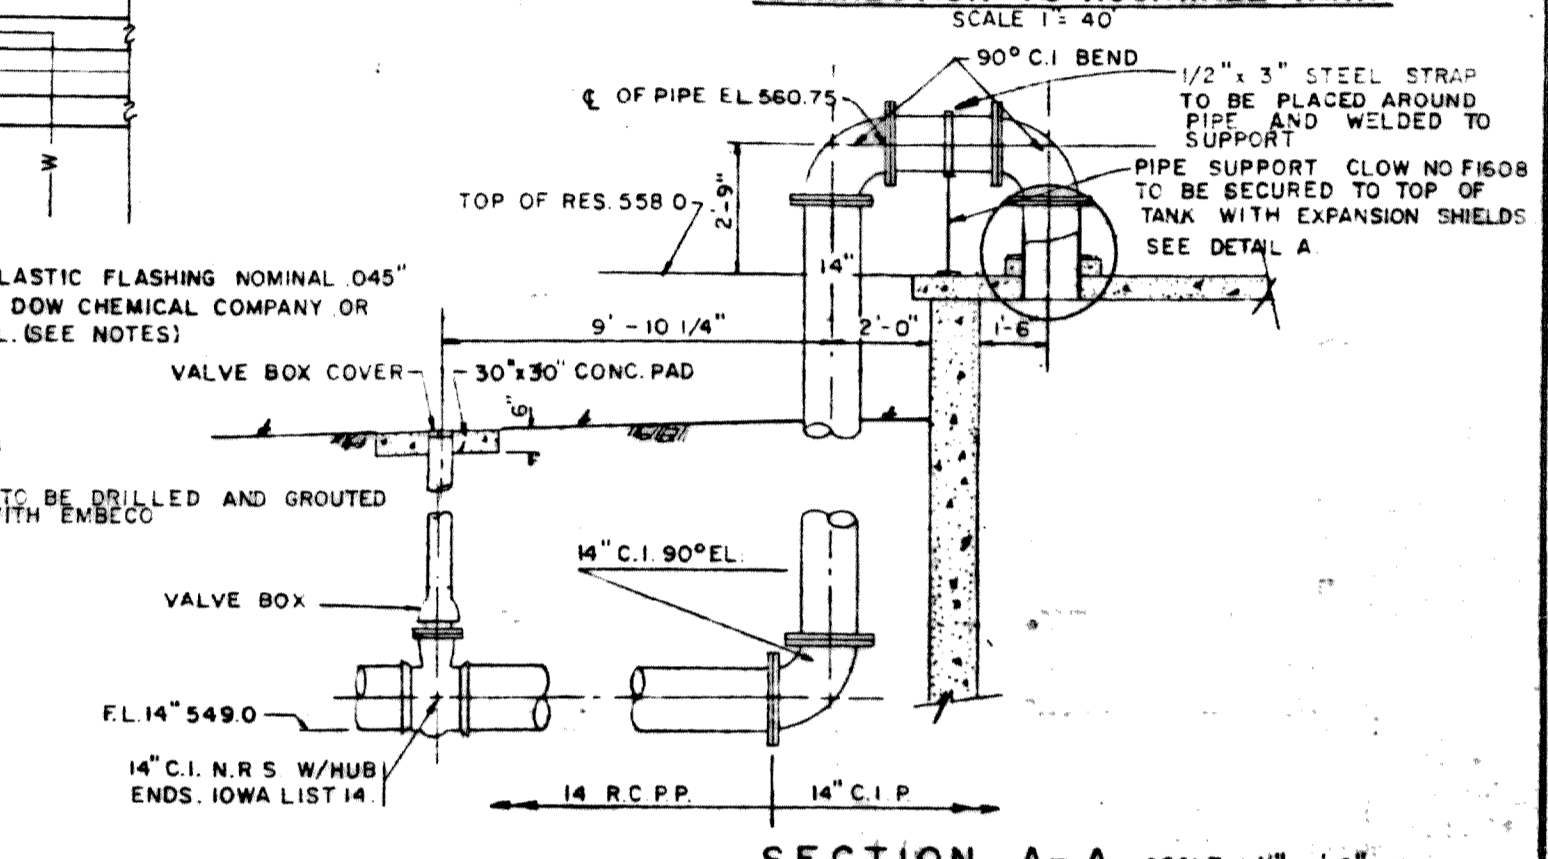

- NOTES**
1. FLASHING MUST BE CLEAN & DRY.
 2. SLAB MUST BE PROPERLY PREPARED BY REMOVING ALL FOREIGN MATTER, RUBBISH, DEBRIS, ETC.
 3. HOLES & CRACKS IN SAND MUST BE FILLED WITH MORTAR & GRINDING SMOOTH ALL PROJECTIONS OR ROUGH CONCRETE.
 4. CONCRETE MUST BE DRY BEFORE AND DURING PLACEMENT OF THE MEMBRANE.

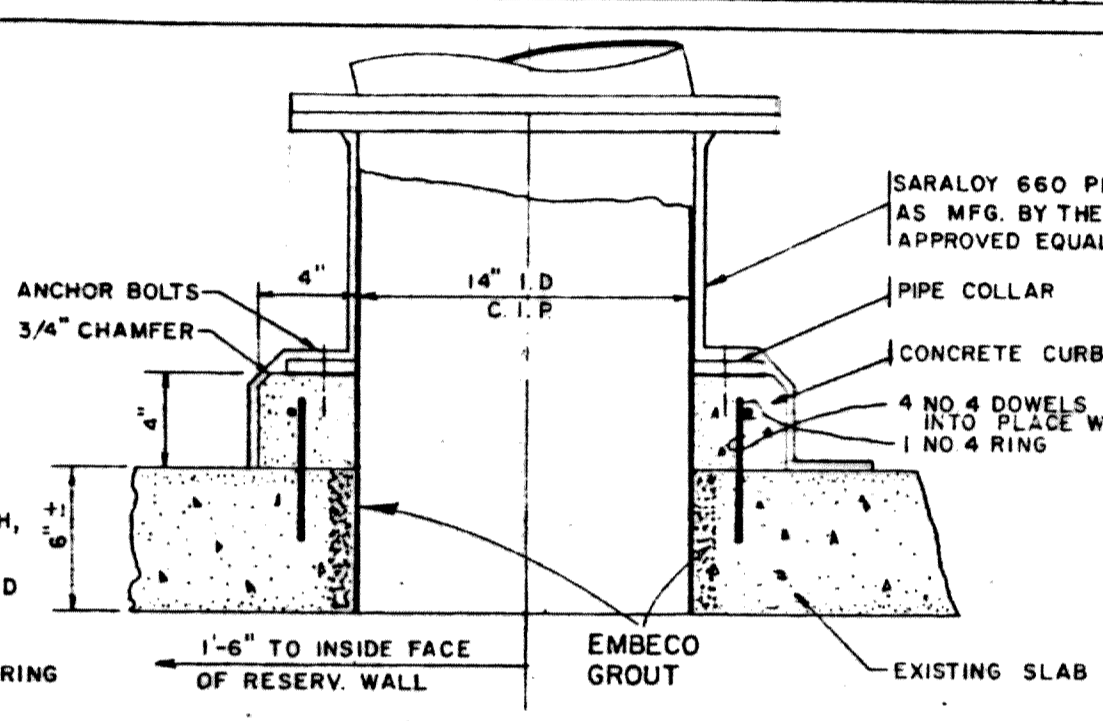

551 552 553 554 555+00

PLATE 1, PLAN-PROFILE

NORTH TEXAS MUNICIPAL WATER DISTRICT
WYLIE ROCKWALL PIPELINE

FORREST AND COTTON INC.
 CONSULTING ENGINEERS
 DALLAS, TEXAS
 MAY, 1969

DESIGNED: J.V. GRAHAM
 DRAWN: GILES
 APPROVED: WILLIAM B. LONDON

FILE NO. 488-19-21
 SHEET NO. 21
 OF 29 SHEETS