

PLANS FOR THE CONSTRUCTION OF

# WYLIE ROCKWALL PIPELINE

FOR THE

# NORTH TEXAS MUNICIPAL WATER DISTRICT

## BOARD OF DIRECTORS

ROBERT L. JORDON ——— PRESIDENT  
A. H. EUBANKS, JR. ——— VICE PRESIDENT  
C. TRUETT SMITH ——— SECRETARY - TREASURER

BYRON CANTRELL	C. HANSFORD RAY
CLIFFORD CARPENTER	W. S. ROACH
BAY COOKSTON	A. R. SCHELL, III
B. W. CRUCE, JR.	CONWAY GENTER
L. L. LEAKE CARPENTER	W. O. WALLACE

APPROVED BY THE BOARD OF DIRECTORS OF THE  
NORTH TEXAS MUNICIPAL WATER DISTRICT THIS  
26 DAY OF JUNE, 1969



*Robert L. Jordan*  
PRESIDENT

ATTEST:

*C. Truett Smith*  
SECRETARY - TREASURER

~~GENERAL MANAGER~~  
E. H. INGRAM ——— ASSISTANT GENERAL MANAGER

THESE DRAWINGS HAVE BEEN ALTERED  
TO CONFORM TO CONSTRUCTION RECORDS.  
BY \_\_\_\_\_  
DATE \_\_\_\_\_  
FORREST AND COTTON, INC.  
CONSULTING ENGINEERS

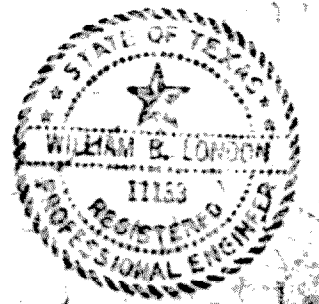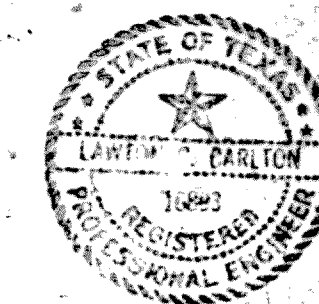

FORREST AND COTTON, INC.  
CONSULTING ENGINEERS  
DALLAS, TEXAS

SUBMITTED *Carl C. Cotton*

APPROVED *William B. Jordan*