



PLAN
 SURVEYED BY: _____ DATE: _____
 PLOTTED BY: _____
 NOTE BOOK NO. _____
 CHECKED BY: _____
 RT. OF WAY CHECKED BY: _____
 NO. _____

PROFILE
 SURVEYED BY: _____ DATE: _____
 PLOTTED BY: _____
 NOTE BOOK NO. _____
 CHECKED BY: _____
 GRADES CHECKED BY: _____
 STRUCTURE NOTATIONS CHECKED BY: _____
 NO. _____

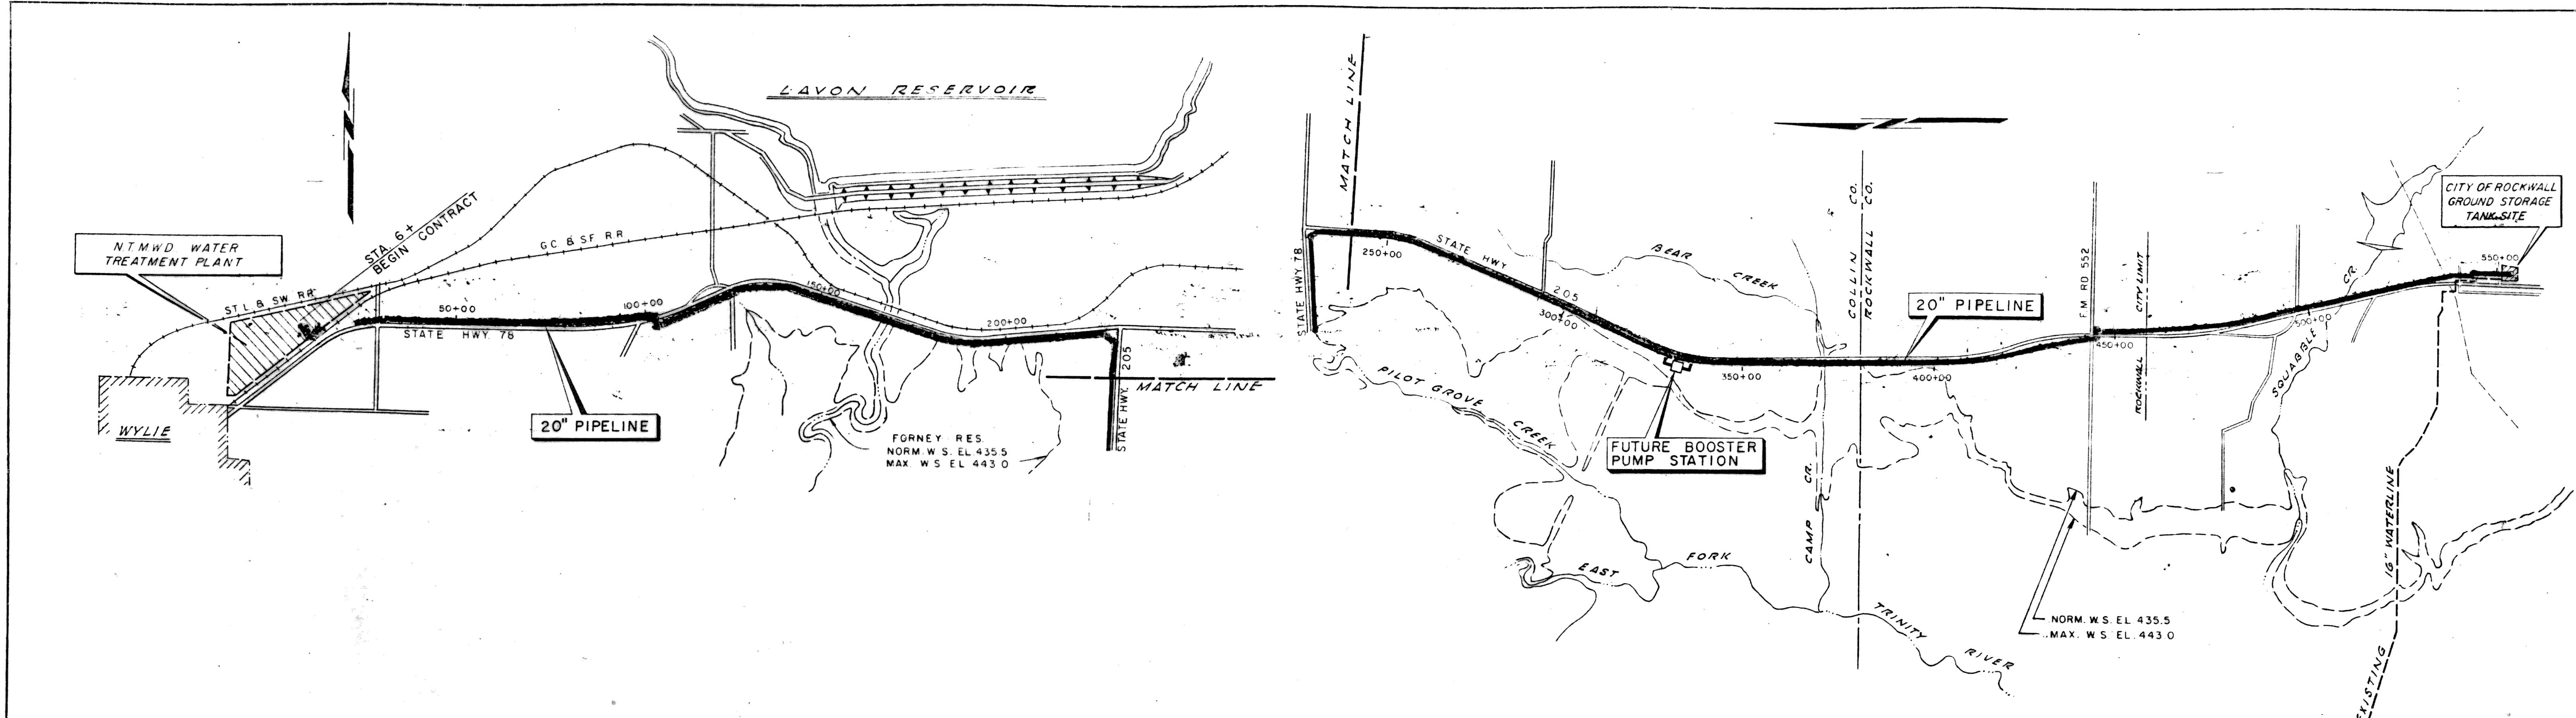

THESE DIMENSIONS HAVE BEEN ALTERED TO CORRECT FOR CONSTRUCTION NECESSITIES.
 BY: F.W. THOMAS
 DATE: 02-1-1970
 FORREST AND COTTON, INC.
 ENGINEERS AND ARCHITECTS
 12133
 DALLAS, TEXAS

HORIZ 2000 0 2000 4000 6000
 VERT 40 0 40 80 120
 SCALE IN FEET

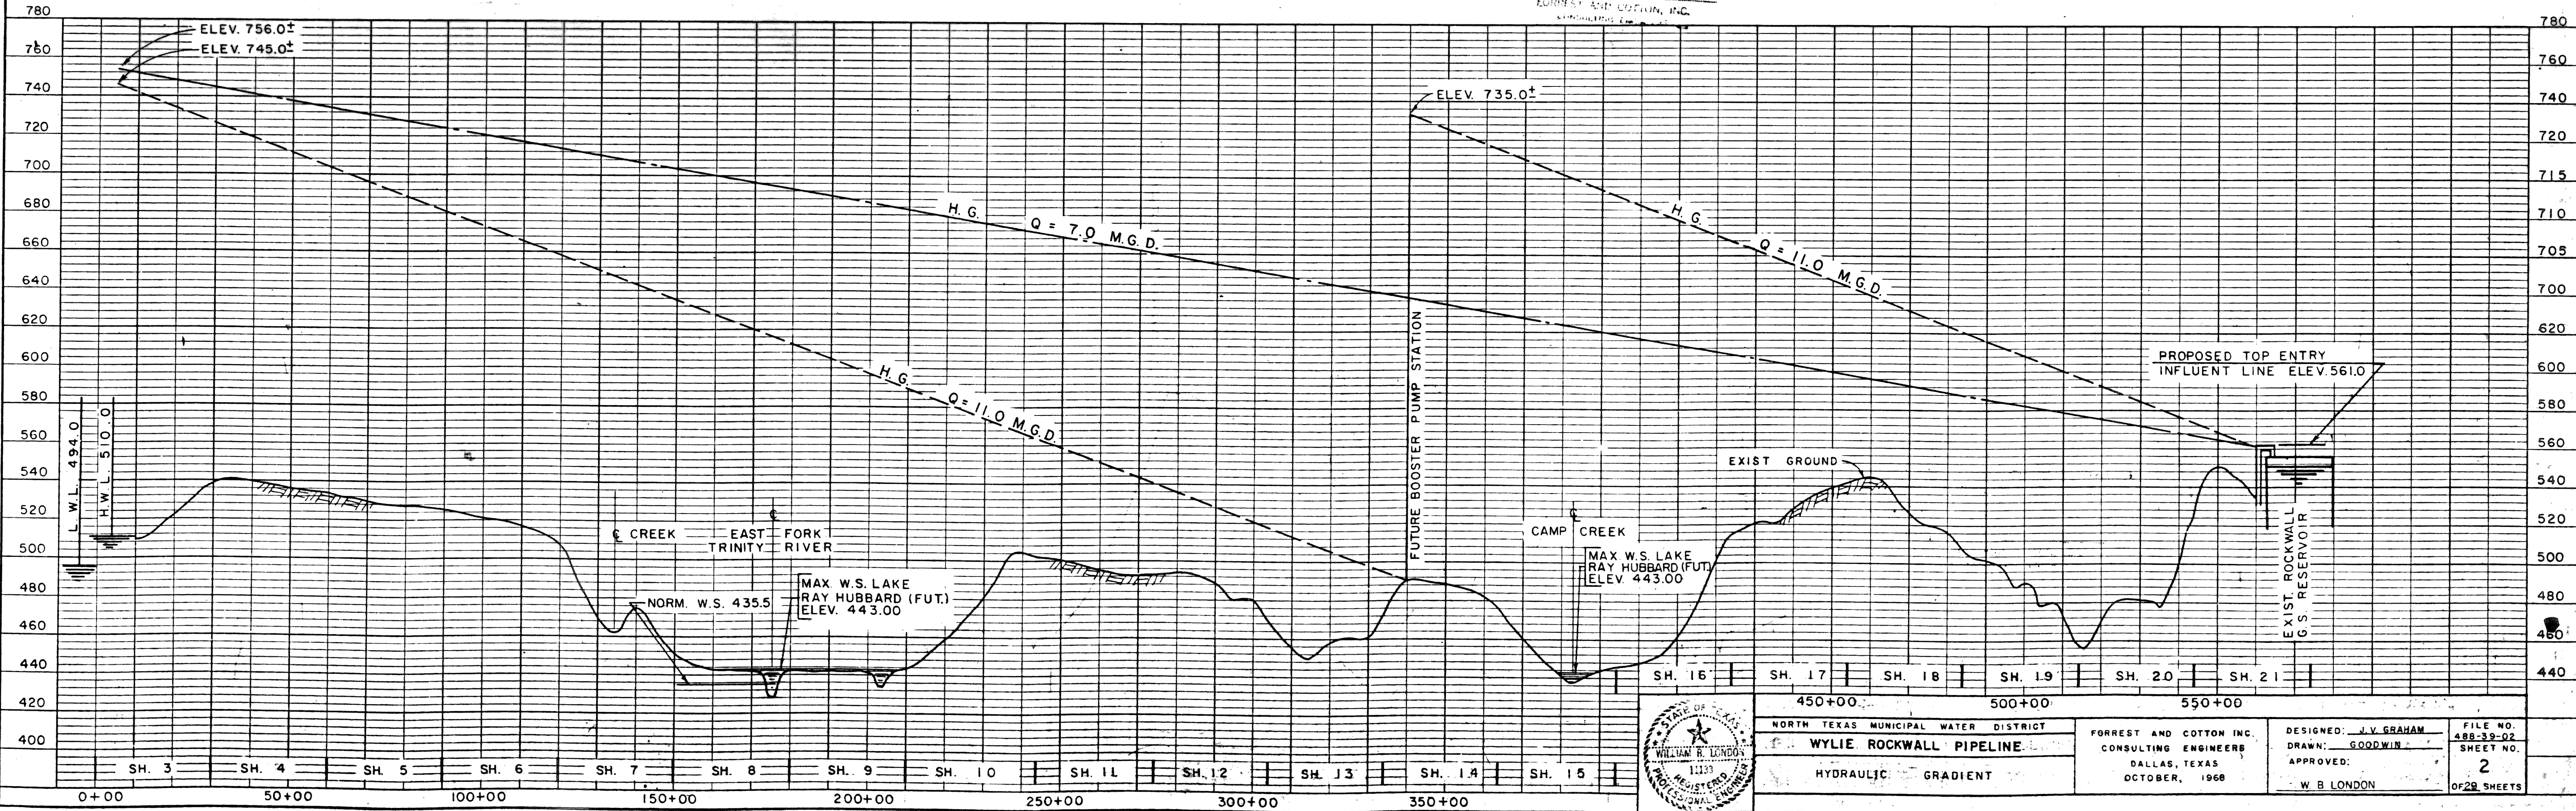

	NORTH TEXAS MUNICIPAL WATER DISTRICT WYLIE ROCKWALL PIPELINE HYDRAULIC GRADIENT	FORREST AND COTTON INC. CONSULTING ENGINEERS DALLAS, TEXAS OCTOBER, 1968	DESIGNED: J.V. GRAHAM DRAWN: GOODWIN APPROVED: W.B. LONDON	FILE NO. 488-29-02 SHEET NO. 2 OF 28 SHEETS
	STA. 0+00 50+00 100+00 150+00 200+00 250+00 300+00 350+00 450+00 500+00 550+00			
	SH. 3 SH. 4 SH. 5 SH. 6 SH. 7 SH. 8 SH. 9 SH. 10 SH. 11 SH. 12 SH. 13 SH. 14 SH. 15 SH. 16 SH. 17 SH. 18 SH. 19 SH. 20 SH. 21			