


1. DRAINAGE PLAN HAS BEEN PREPARED WITH PERMISSION TO USE "C" OF 0.5 FOR EXISTING CONDITION AND "C" OF 0.9 FOR ONLY THE NEW PAVED AREA, THEREBY GIVING A WEIGHTED RUNOFF COEFFICIENT OF APPROXIMATELY 0.534. CONTRACTOR TO GRADE LOT TO ENSURE THAT ALL RUNOFF DRAINS AS PROPOSED ON THE PLAN, AND INTO THE DETENTION POND, WHICH APPROXIMATELY IS NINETY PERCENT OF THE SITE.

DETENTION AREA IS WITHIN A 3,500 SF AREA OF THE AVERAGE DETAINED WATER DEPTH = 4". REQUIRED STORAGE VOLUME PER DETENTION POND CALCULATION IS 1,052.7 CFS. PROVIDED DETENTION POND STORAGE = 1,166.7 CFS

SITE DATA	
EXISTING PAVED AREA	3,945 SQ.FT.
EXISTING BLDG AREA	4,157 SQ.FT.
EXISTING LANDSCAPE AREA	46,011 SQ.FT.
PROPOSED PAVED AREA	9,985 SQ.FT.
PROPOSED LANDSCAPE AREA	36,026 SQ.FT.
TOTAL IMPERVIOUS AREA	18,087 SQ.FT.
TOTAL SITE AREA	54,113 SQ.FT.

RUNOFF CALCULATIONS POST-DEVELOPMENT CONDITIONS											
DRAINAGE ID	AREA (ACRES)	C	T _{CD} (MIN)	I _s (IN/HR)	Q _s (CFS)	I _{pe} (IN/HR)	Q _{pe} (CFS)	I _{ss} (IN/HR)	Q _{ss} (CFS)	I _{bw} (IN/HR)	Q _{bw} (CFS)
A	0.8873	0.543*	10	6.10	2.31	7.10	2.89	8.30	3.14	8.00	3.71
B	0.8161	0.543*	10	6.10	1.71	7.10	1.98	8.30	2.33	8.00	2.74
C	0.0299	0.543*	10	6.10	0.10	7.10	0.12	8.30	0.13	8.00	0.16
TOTAL	1.2423				4.12		4.79		6.60		6.61
Q _{pe} = Q _{bw}	0.13385	0.5	10	6.10	0.41	7.10	0.475	8.30	0.555	8.00	0.655
Q _{ss} (WITH OFFSETS)	0.13385	0.5	10	6.10	0.41	7.10	0.475	8.30	0.555	8.00	0.655
TOTAL (WITH OFFSETS)	1.51				4.94		5.74		6.71		7.82

LEGEND	
---	EXISTING CONTOUR LINE
→	DRAINAGE / GRADING DIRECTION
+ 437.00	EXISTING SPOT ELEVATION
● 655.35	PROPOSED SPOT ELEVATION
---	DRAINAGE DIVIDE LINE
B	DRAINAGE AREA NO.
---	PROPOSED CONTOUR LINE
□	NEW CONCRETE PAVEMENT
□	EXISTING CONCRETE PAVEMENT
□	ASPHALT PAVEMENT
□	LANDSCAPE AREA
□	6"(MIN) RIP-RAP OVER 5'x6" AREA
○	EXISTING CHAIN LINKED FENCE
○	EXISTING WOODEN FENCE
---	PROPERTY LINE
T.O.C.	TOP OF CURB ELEVATION
□	TELEPHONE PEDESTAL
○	POWER POLE
□	SIGN
○	EXISTING SAN SEWER MANHOLE
○	FIRE HYDRANT
T.O.W.	TOP OF WALL
B.O.W.	BOTTOM OF WALL

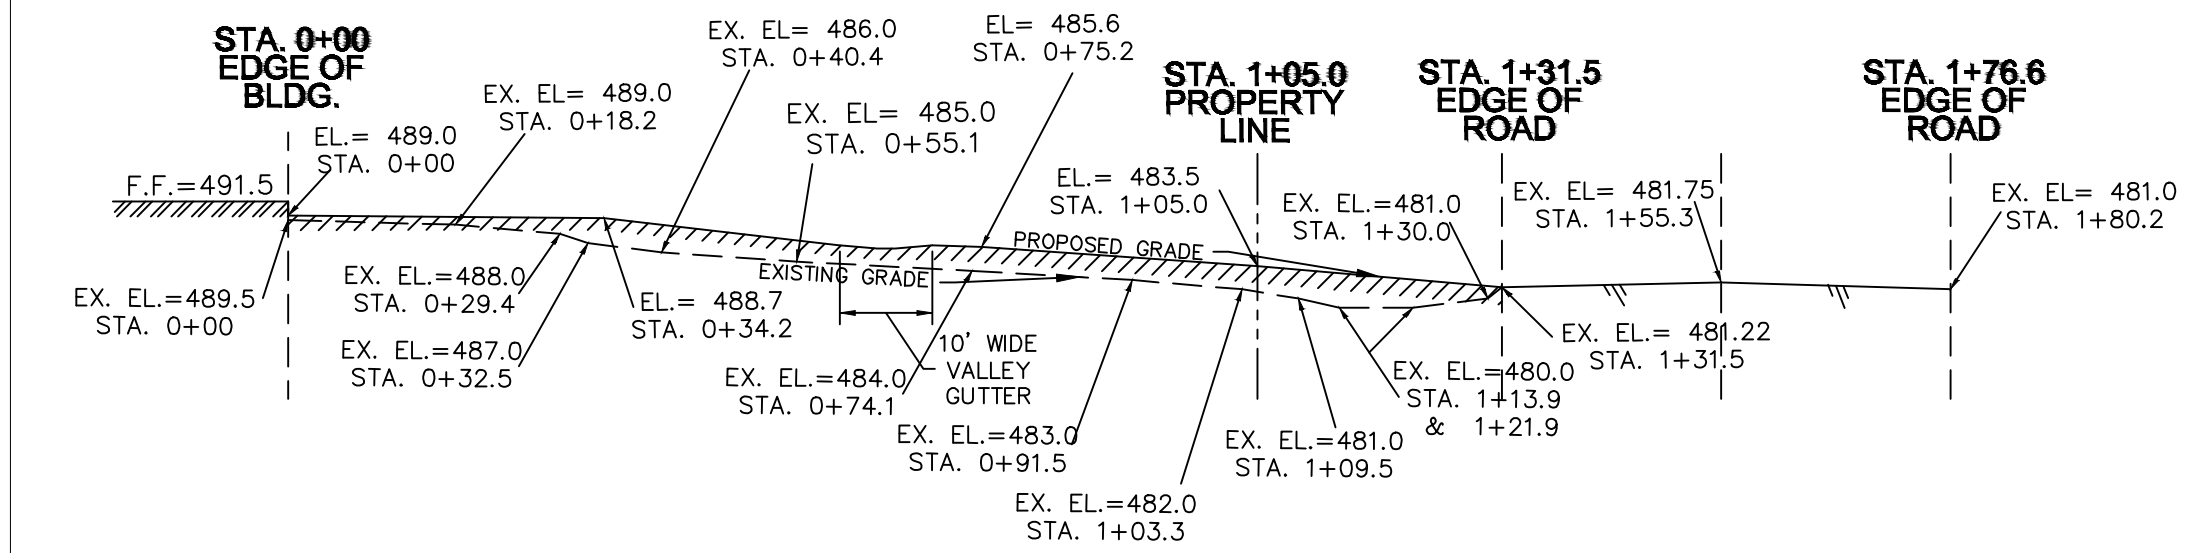

DETENTION/PARKING AREA DISCHARGE OUTLET N.T.S.


CAPACITY OF DETENTION AREA GUTTER SEC. ③ (TYP.)

$Q = (1.49/n) AR^{2.48} S^{0.58}$

$= (1.49/0.013) [(0.495)(0.2475)^{2.48}] (0.0416)^{0.58}$

$= 4.5 \text{ CFS} = 4.5 \text{ CFS ALLOWED (OK)}$

$V = 9.2 \text{ FPS}$

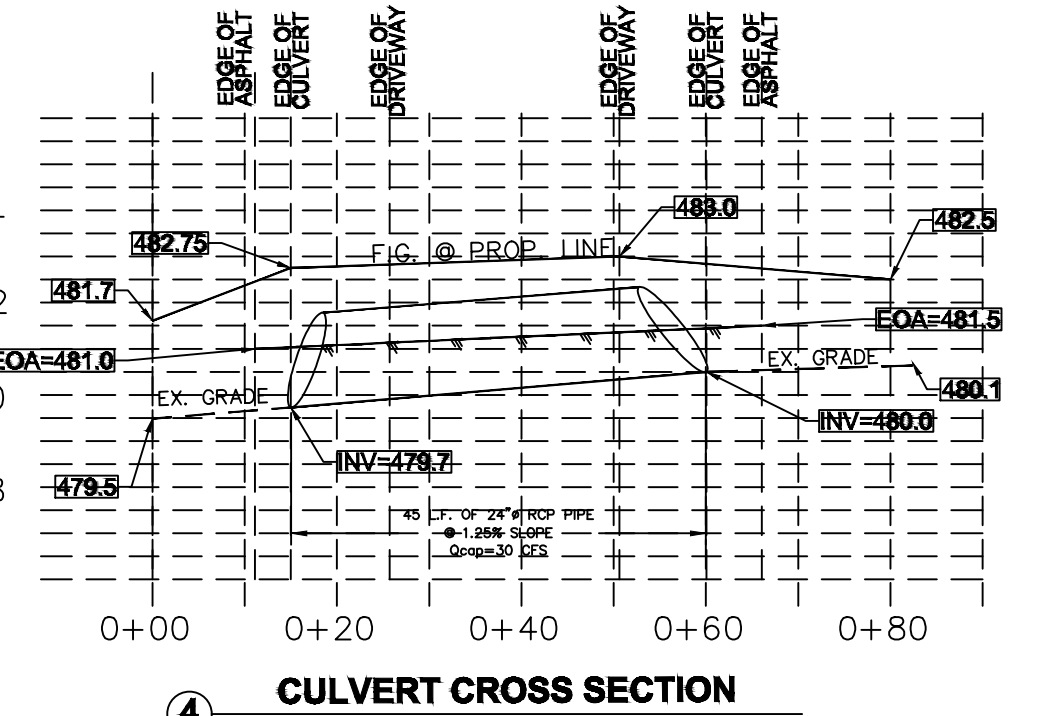


Q_{pe} = Q_{bw}
 EXAMPLE RUNOFF CALCULATIONS FOR: DRAINAGE AREA "A": Q₁₀₀ = (0.543)(0.8873)(7.00) = 3.52 CFS
 INCREASE BETWEEN PRE & POST DEVELOPMENT RUNOFF = 6.61 - 6.09 = 0.52 CFS

SITE WEIGHTED RUNOFF COEFFICIENT CALCULATION			
AREA DESCRIPTION	AREA (Ac.)	C	(C)(AREA)
EX. BLDG. AREA	0.0954	0.5	0.0477
NEW PAVED AREA	0.1343	0.9	0.12087
LANDSCAPE AREA	1.0126	0.5	0.5063
TOTAL	1.2423		0.67487

WEIGHTED RUNOFF COEFFICIENT
 *C_w = 0.67487/1.2423 = 0.543

CROSS SECTION 1

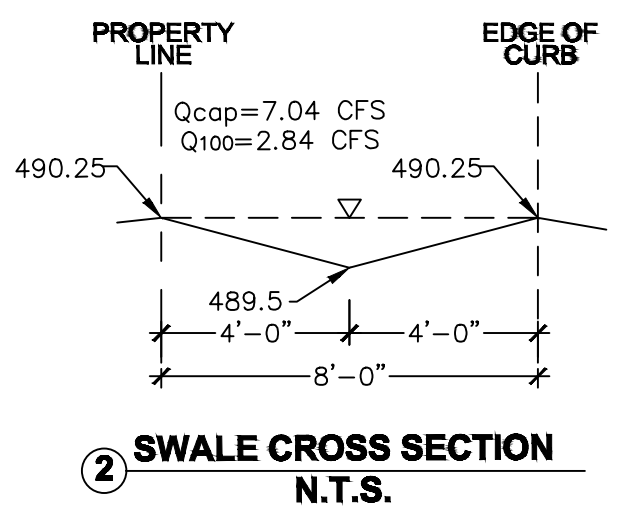


CAPACITY OF SWALE CROSS SECTION ② (TYP.)

$Q = (1.49/n) AR^{2.48} S^{0.58}$

$= (1.49/0.035) [(3.0)(0.2308)^{2.48}] (0.0217)^{0.58}$

$= 7.04 \text{ CFS} > 2.835 \text{ CFS (OK)}$

$V = 2.35 \text{ FPS}$

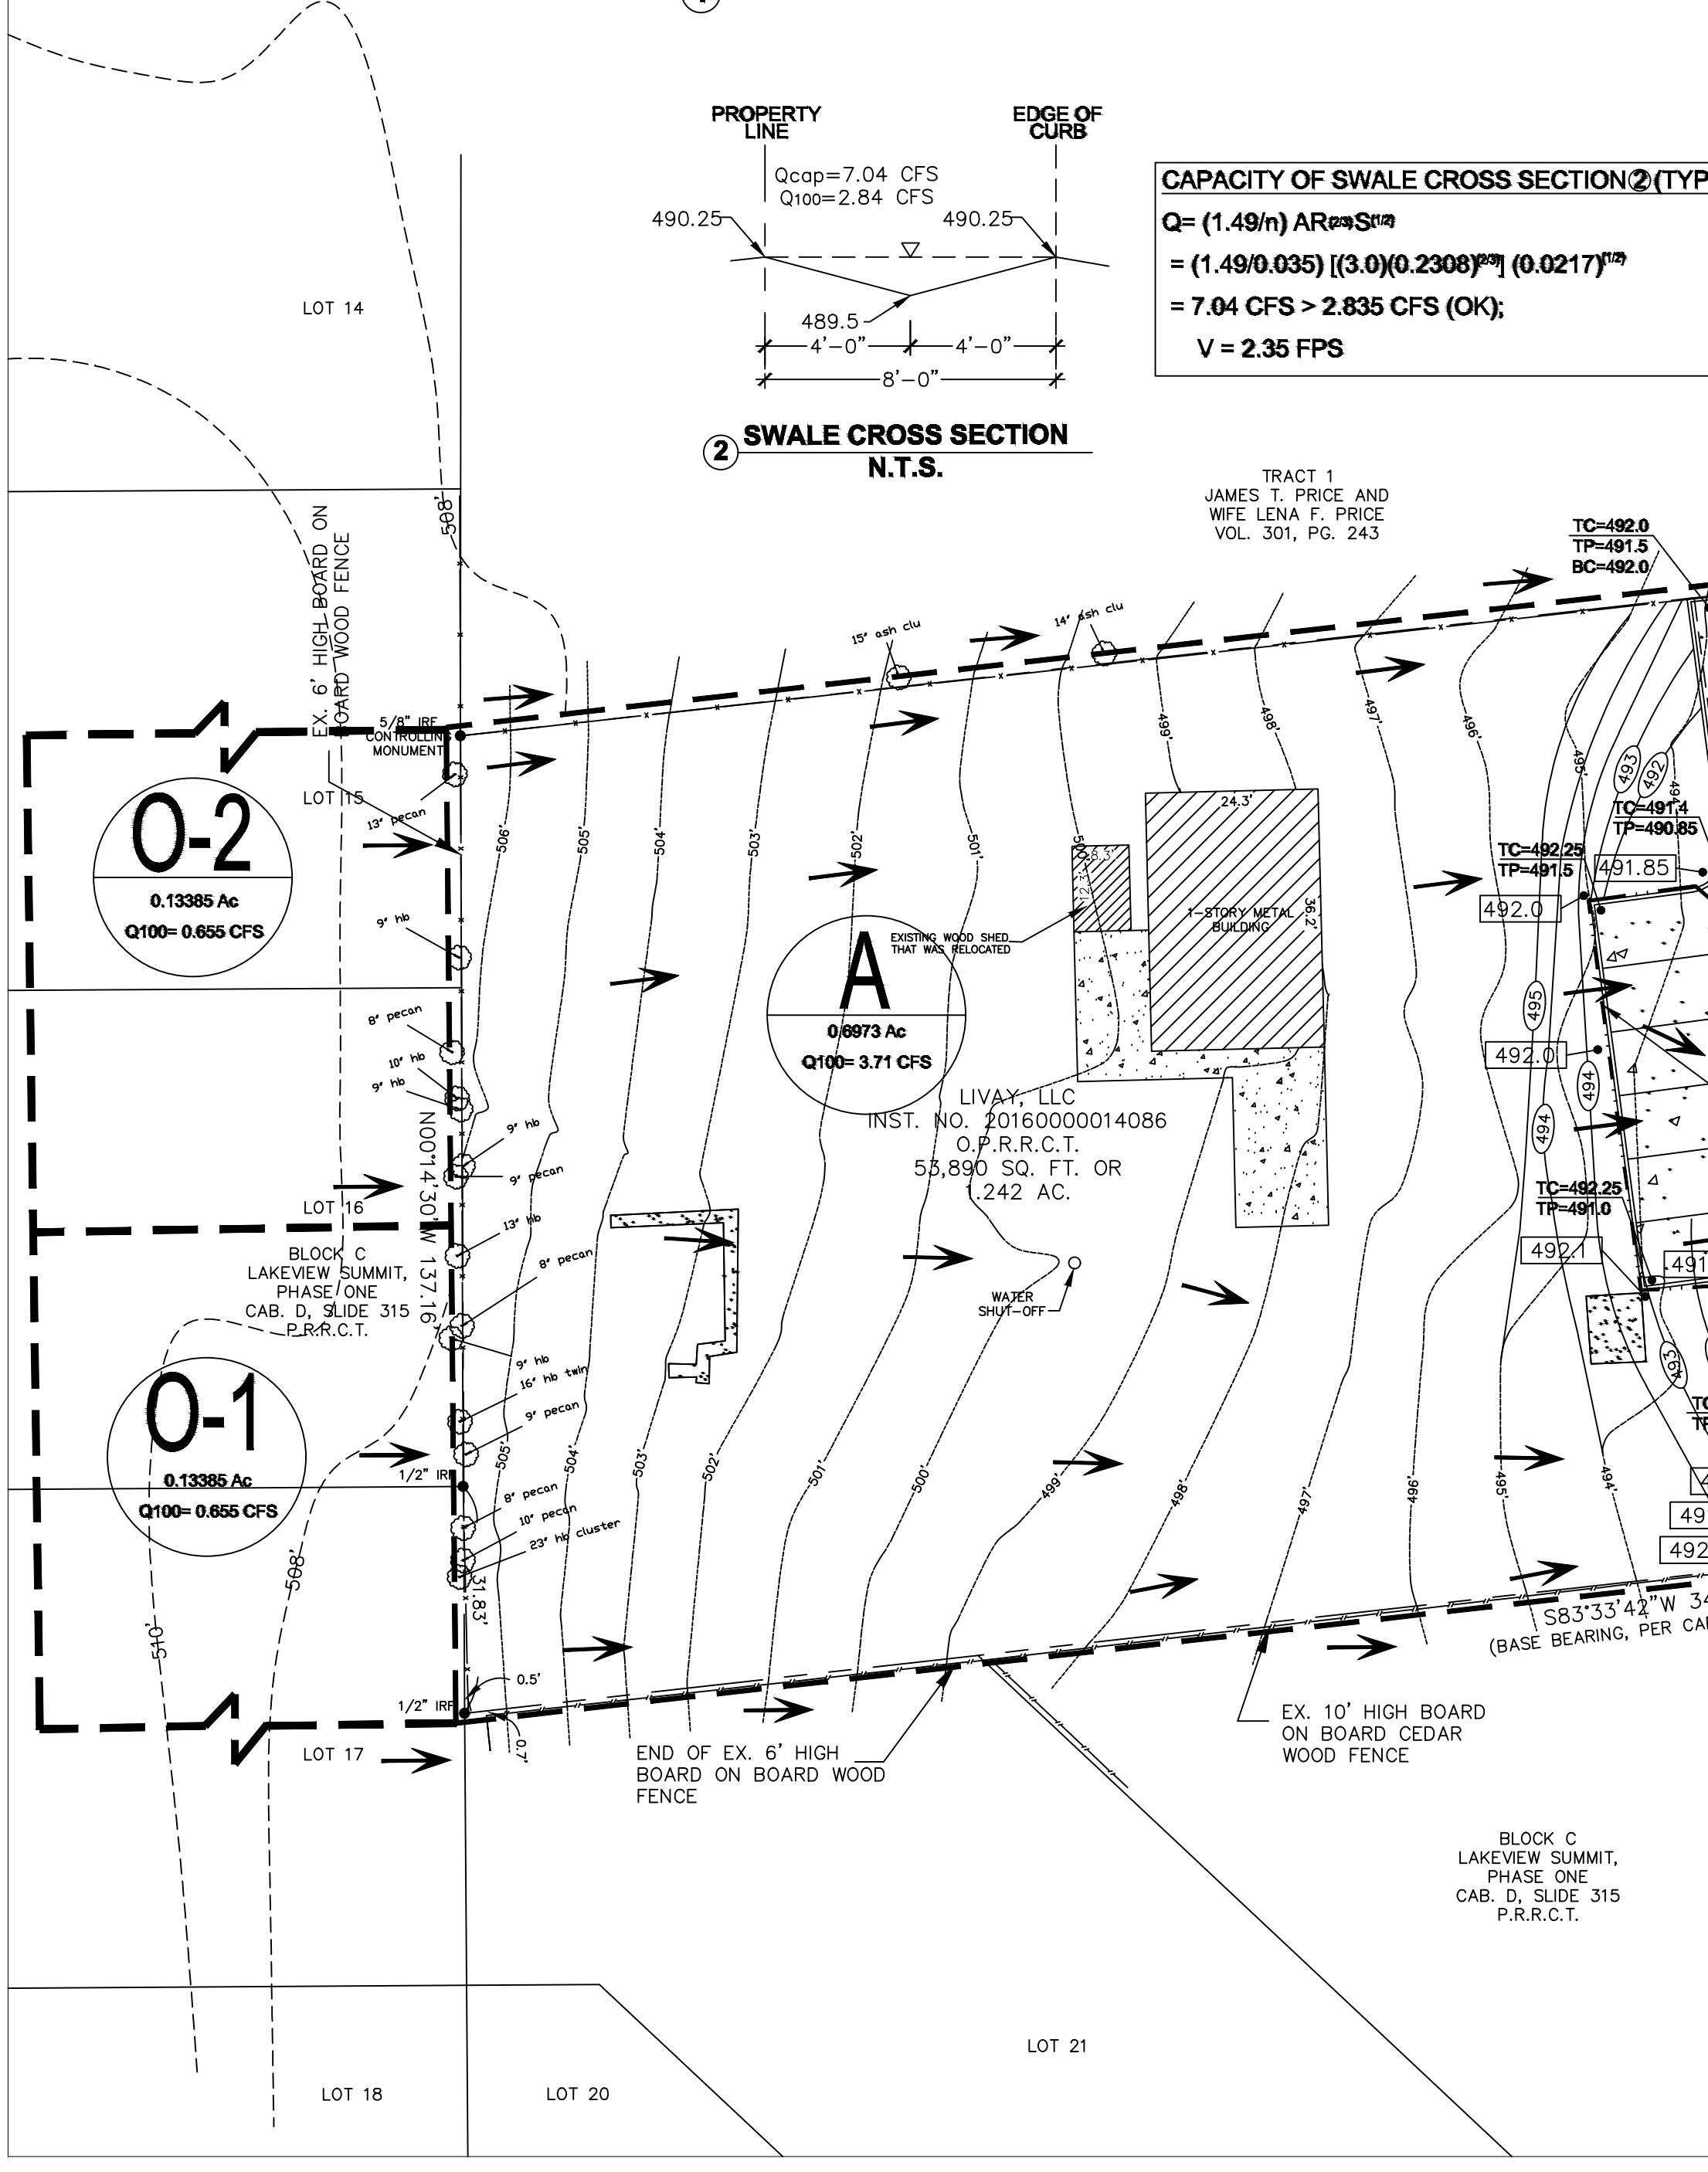



CAPACITY OF DETENTION AREA GUTTER SEC. ③ (TYP.)

$Q = (1.49/n) AR^{2.48} S^{0.58}$

$= (1.49/0.013) [(0.495)(0.2475)^{2.48}] (0.0416)^{0.58}$

$= 4.5 \text{ CFS} = 4.5 \text{ CFS ALLOWED (OK)}$

$V = 9.2 \text{ FPS}$

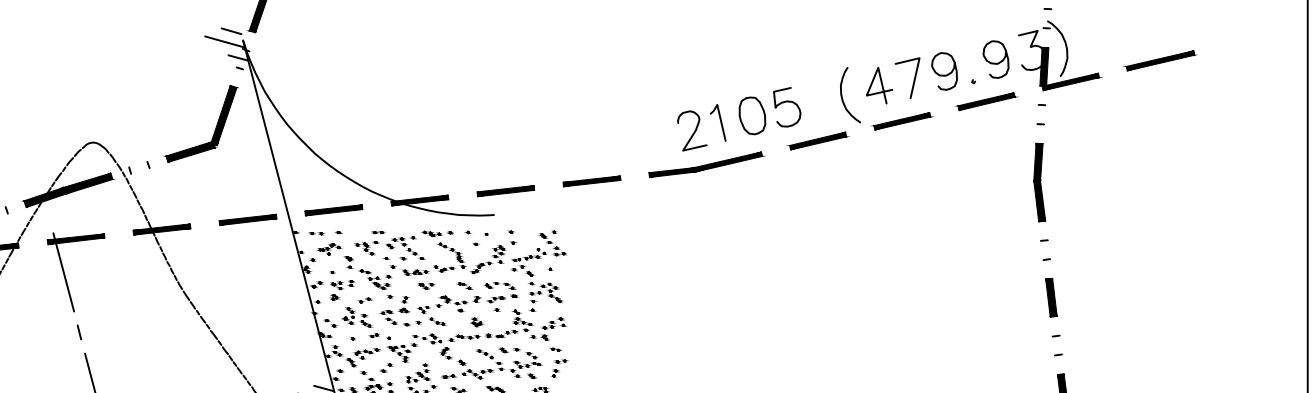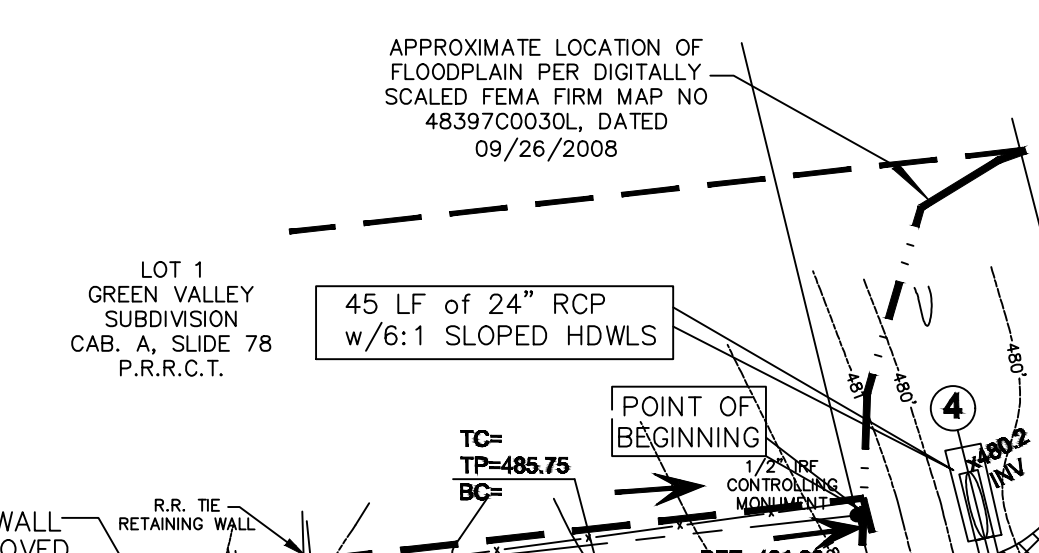

OWNER/APPLICANT NAME:
 LIZARDO OEMENO
 816 COURTLAND DRIVE
 MESQUITE, TX 75150
 (214) 475-5144

OKM ENGINEERING, INC.
 Geotechnical, Environmental & Civil Engineering Consultants
 (TBPE FIRM REG. #F-7241)
 112 S. Madison Avenue
 Dallas, Texas 75028
 Phone: (214) 941-9412
 Fax: (214) 941-9445

REVISIONS	
Date	Description

Project Name & Address:
 PROPOSED OFFICE (REAL ESTATE)
 1201 N. GOLIAD STREET
 LIZARDO OEMENO ADDITION
 LOT 1, BLOCK A
 ROCKWALL, TX 75087

Sheet Title:
DRAINAGE & GRADING PLAN

Date: **AUGUST 30, 2017**


Scale: **1" = 20'** Sheet No.:

OKM Project No.: **17-150** **C-3**

Owner's Project No.: **N/A**

AS-BUILT RECORD DRAWING

CASE #SP2016-033

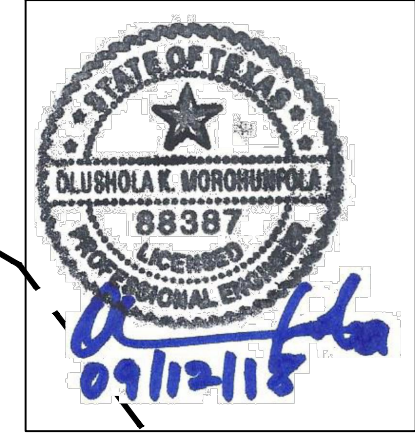

NO CONCRETE TO BE INSTALLED UNTIL DETENTION POND AT THE PARKING AREA IS INSTALLED AND FUNCTIONING PER PLAN.