


**PROPOSED OFFICE (REAL ESTATE)
1201 N. GOLIAD ST
LIZARDO OEMENO ADDITION
LOT 1, BLOCK A
ROCKWALL, TX 75087**

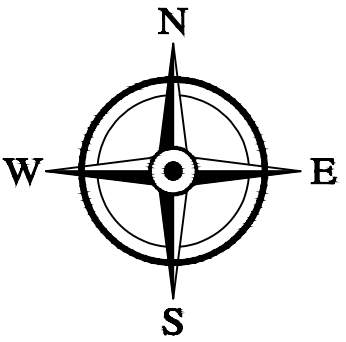

VICINITY MAP
NOT TO SCALE

CIVIL DRAWINGS:

- PLAT
- C-1 SITE, PAVING & DIMENSION CONTROL PLAN
- C-1.1 DEMOLITION PLAN
- C-2 EXISTING DRAINAGE PLAN
- C-3 DRAINAGE & GRADING PLAN
- C-3.1 DETENTION POND CALCULATION SHEET
- C-4 EROSION CONTROL PLAN
- C-5 PAVING & GENERAL STANDARD DETAILS
- L-1 LANDSCAPE PLAN

SELECTED TXDOT/CITY STANDARD DETAILS


- EC(1)-16 TEMPORARY EROSION, SEDIMENT & WATER POLLUTION CONTROL MEASURES (FENCE & VERTICAL TRACKING)
- EC(3)-16 TEMPORARY EROSION, SEDIMENT & WATER POLLUTION CONTROL MEASURES (CONSTRUCTION EXITS)
- SETP-CD SAFETY END TREATMENT FOR 12" DIA. TO 72" DIA. PIPE CULVERTS (TYPE II - PARALLEL DRAINAGE)

**PROPOSED OFFICE (REAL ESTATE)
1201 N. GOLIAD ST
LIZARDO OEMENO ADDITION
LOT 1, BLOCK A
ROCKWALL, TX 75087**

OWNER:

LIZARDO OEMENO
816 COURTLAND DRIVE
MESQUITE, TX 75150
(214) 475-5144

CIVIL ENGINEER:
OKM ENGINEERING, INC.
Mechanical, Environmental & Civil Engineering Consultants
(TSPE FIRM REG. #F-7241)
112 S. Madison Avenue
Dallas, Texas 75028
Phone: (214) 941-9412
Fax: (214) 941-9445

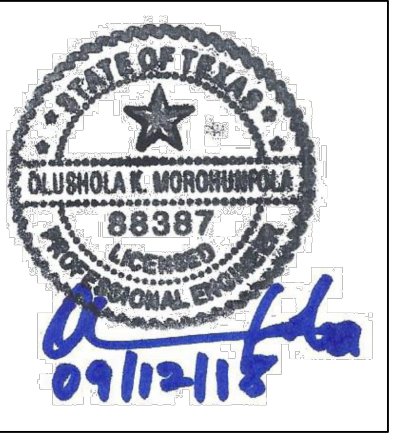

NOTE:
- CONTRACTOR TO COORDINATE ALL UTILITIES IN TIMELY MANNER