
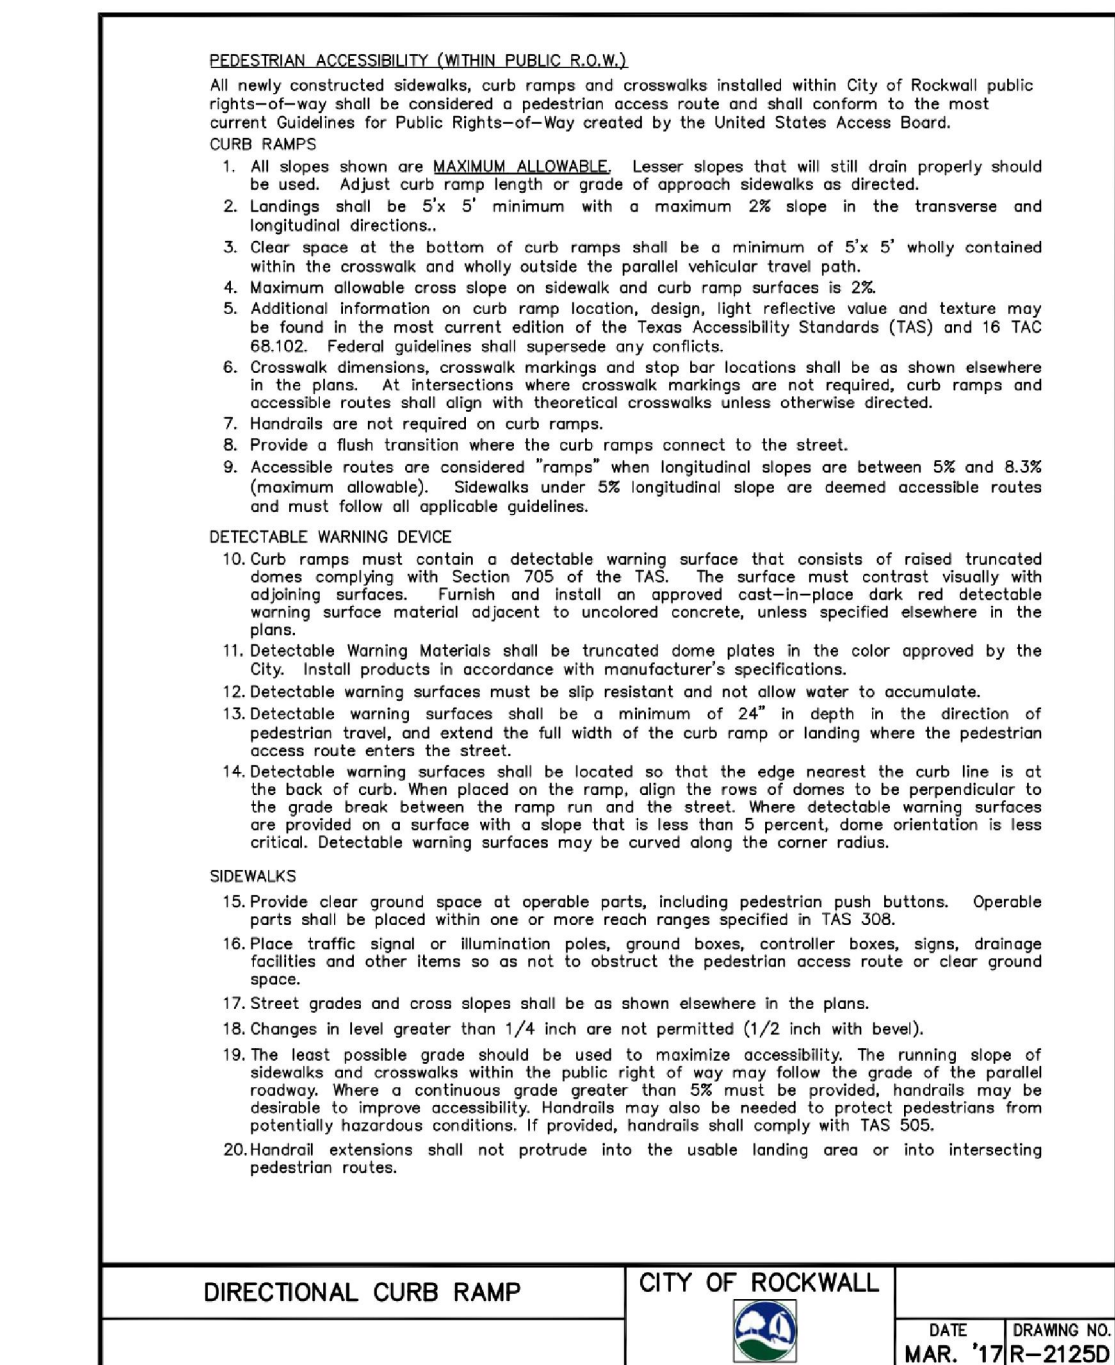
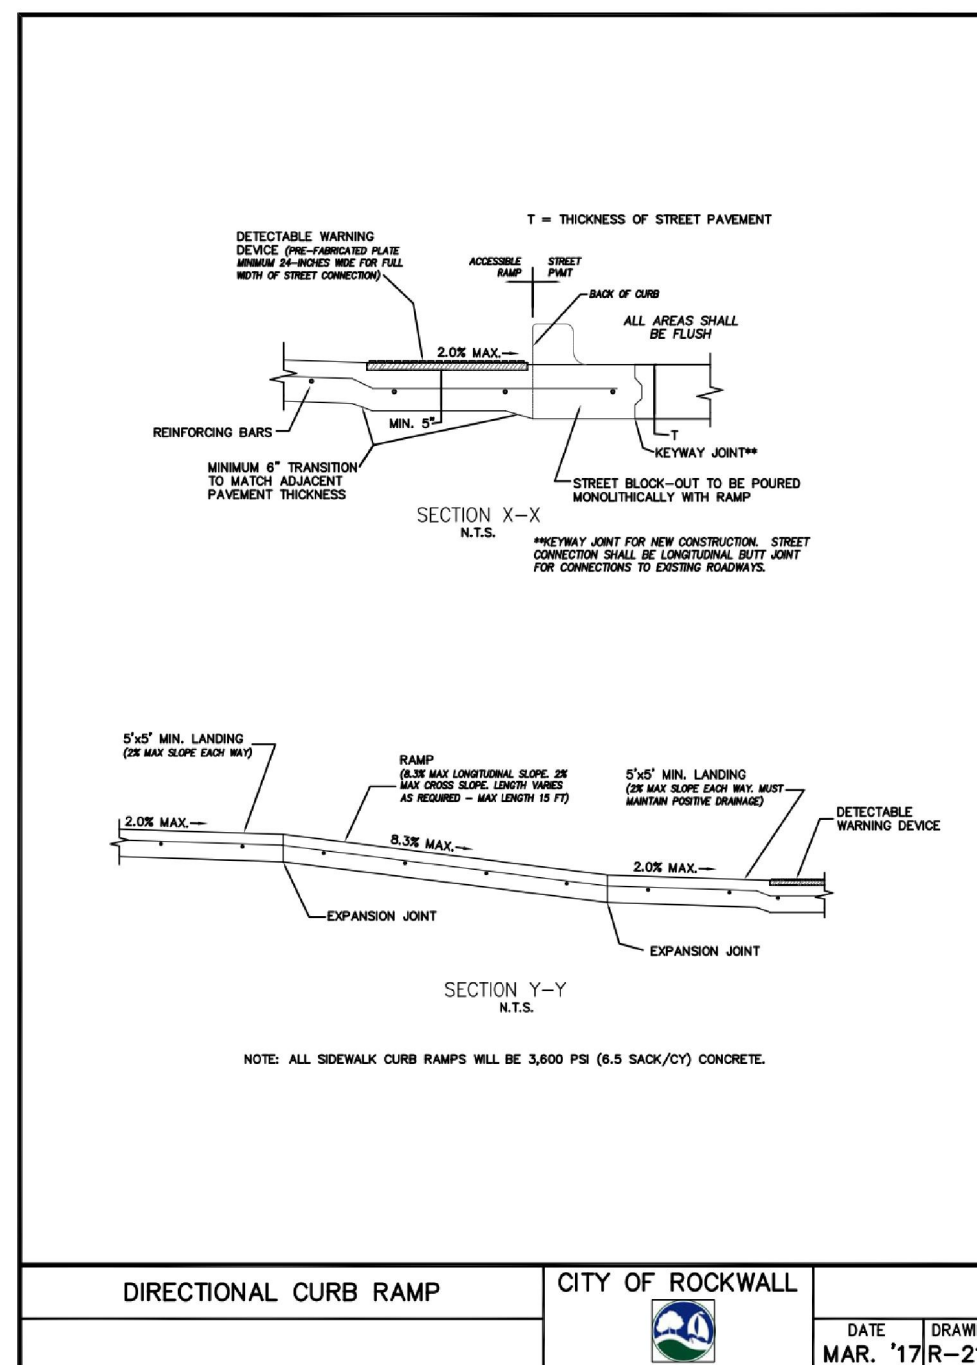
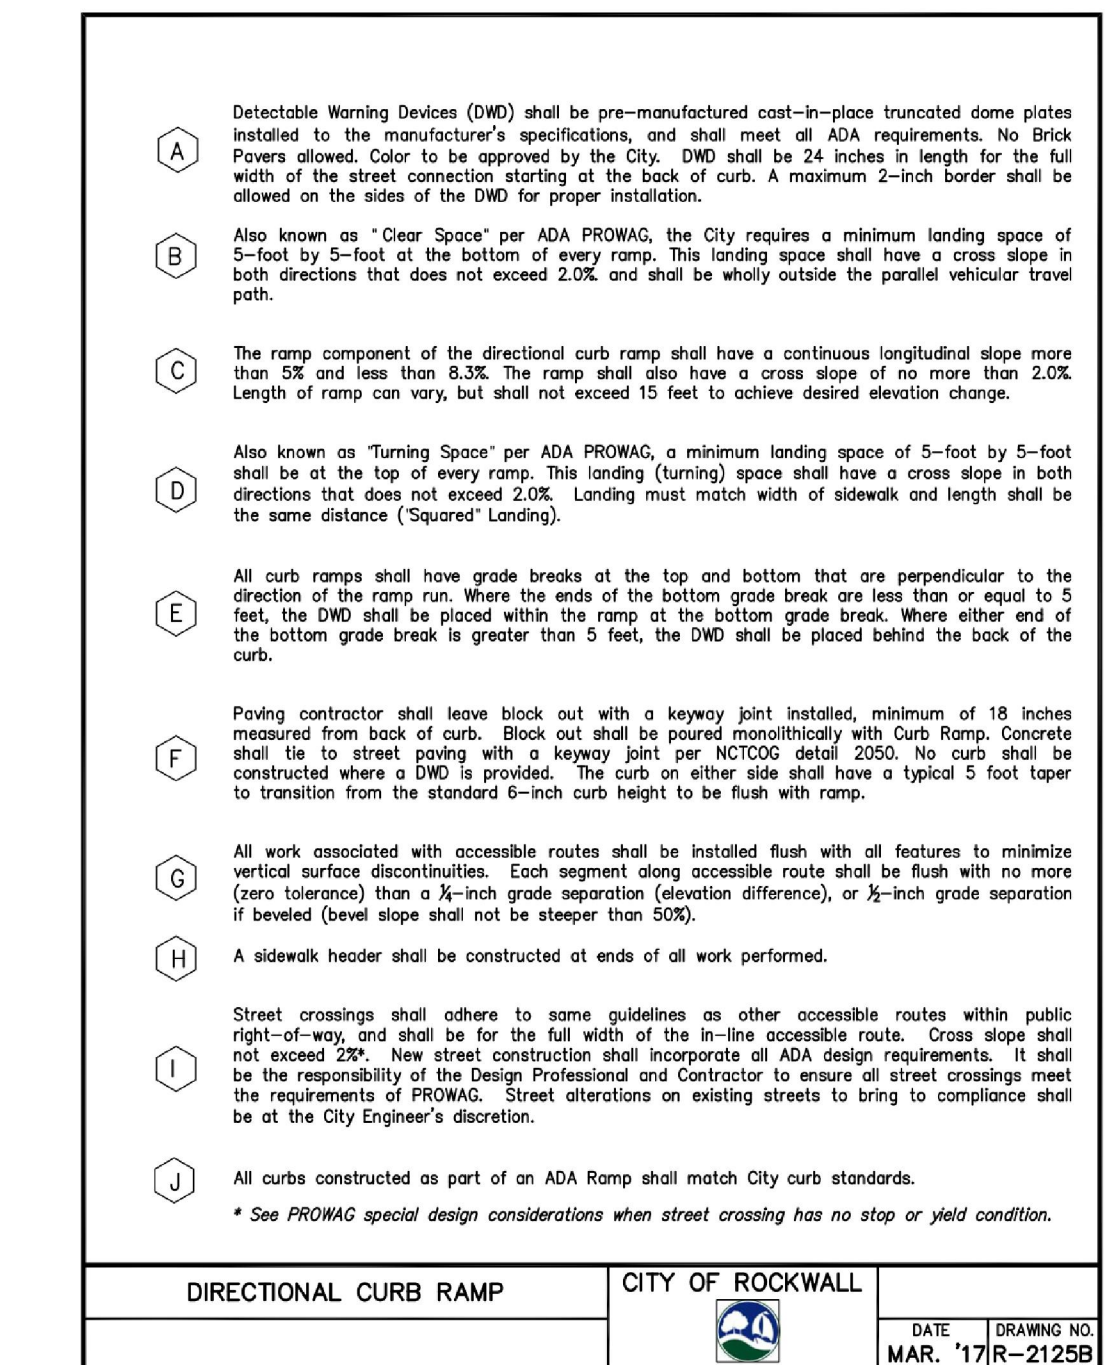
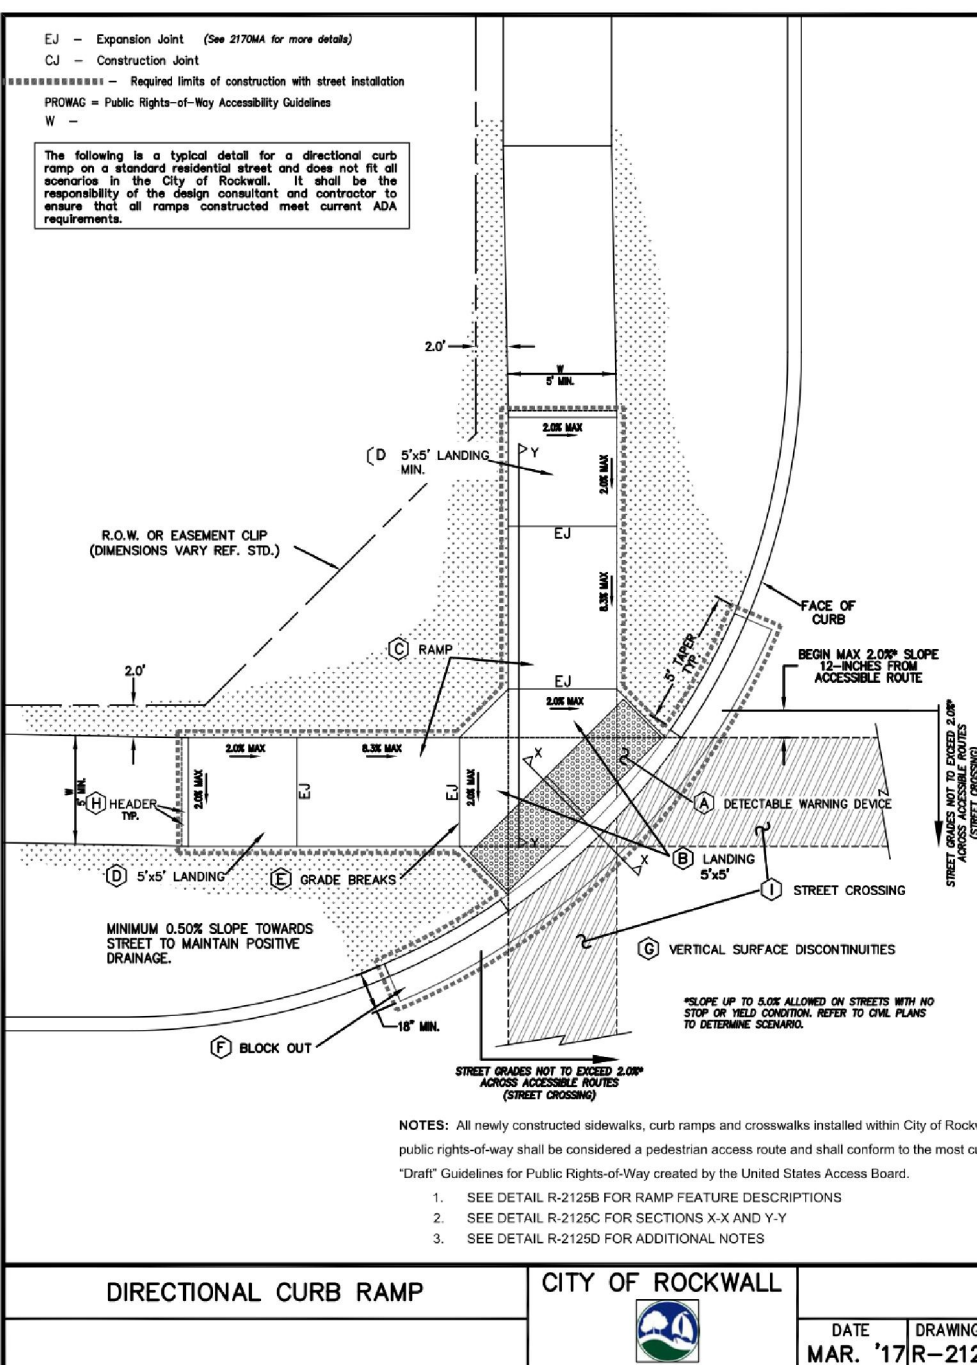
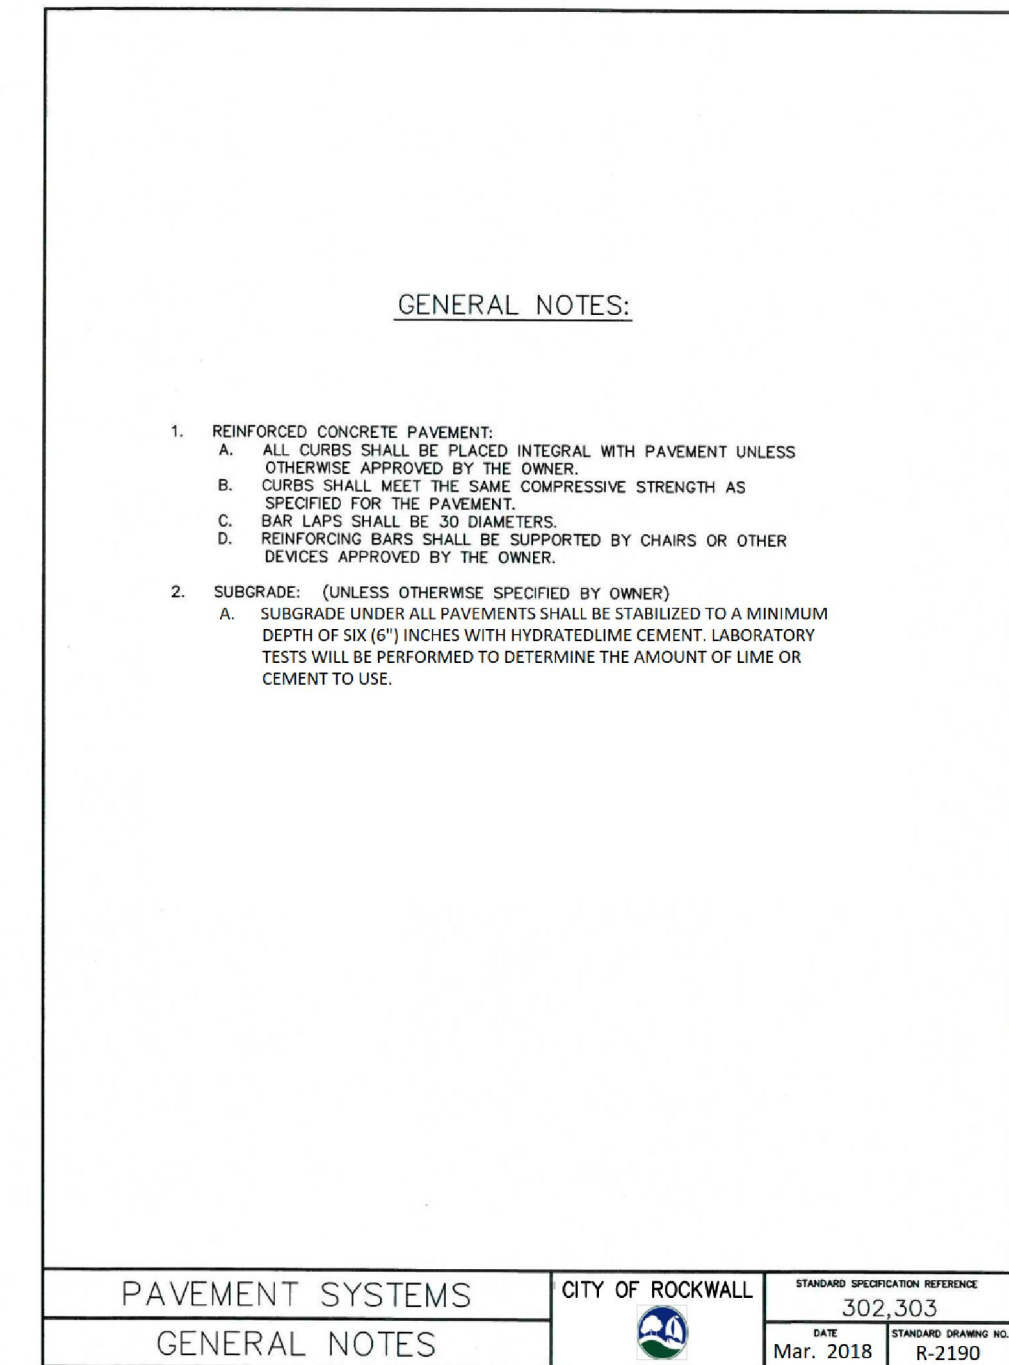
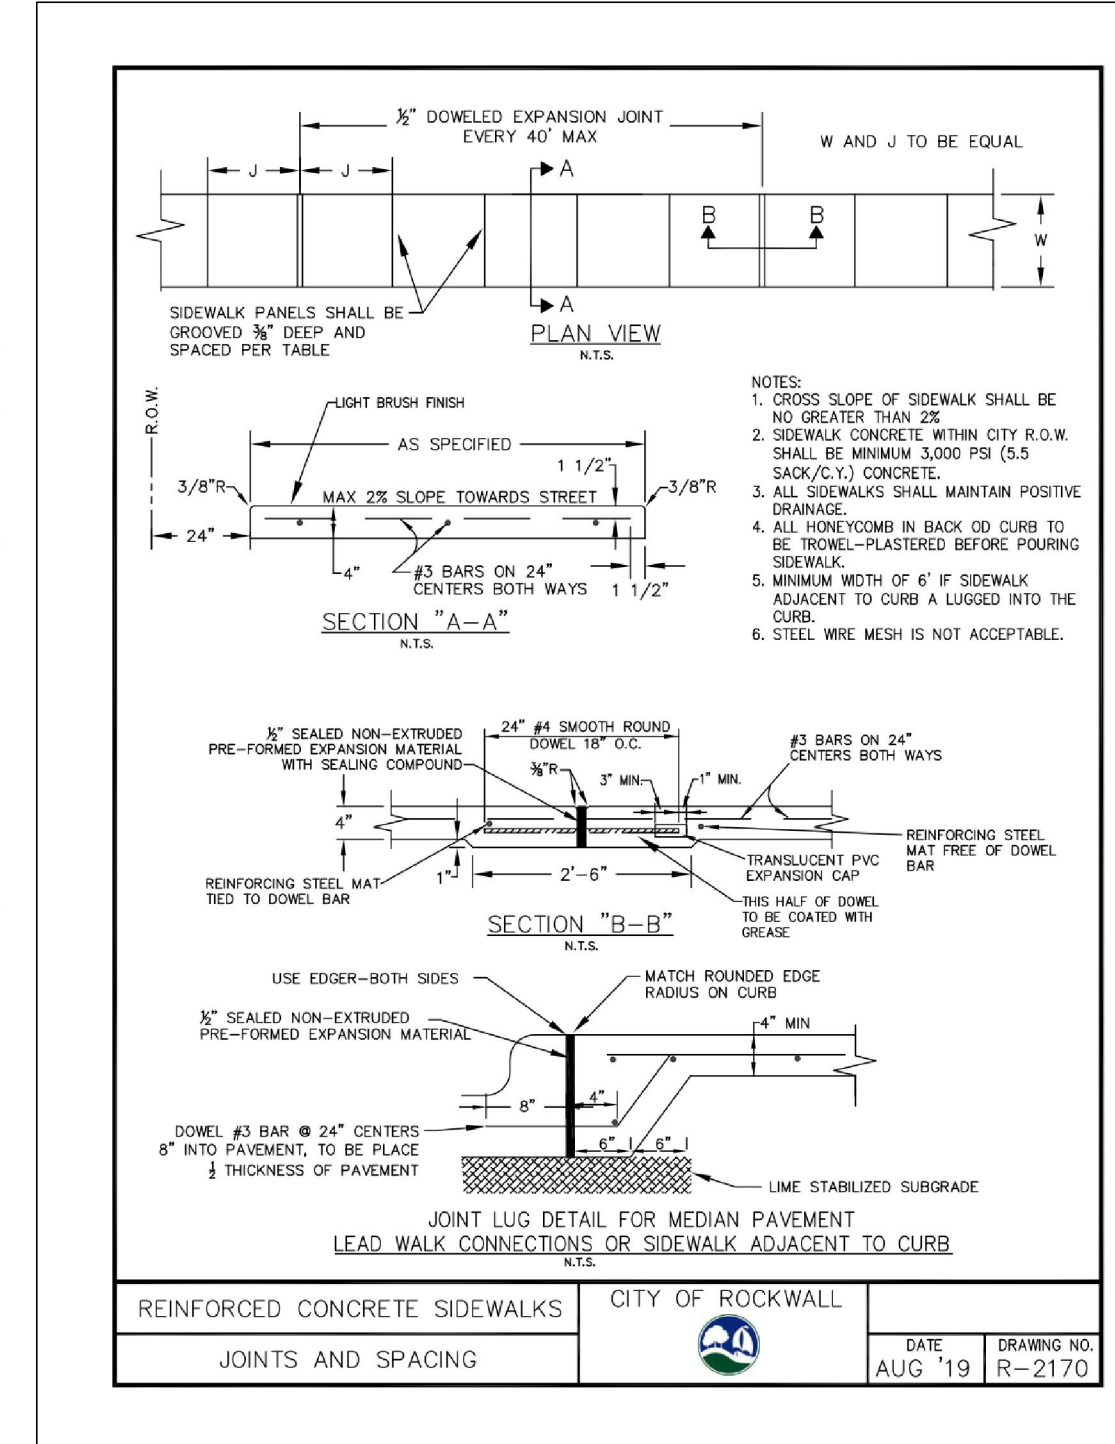
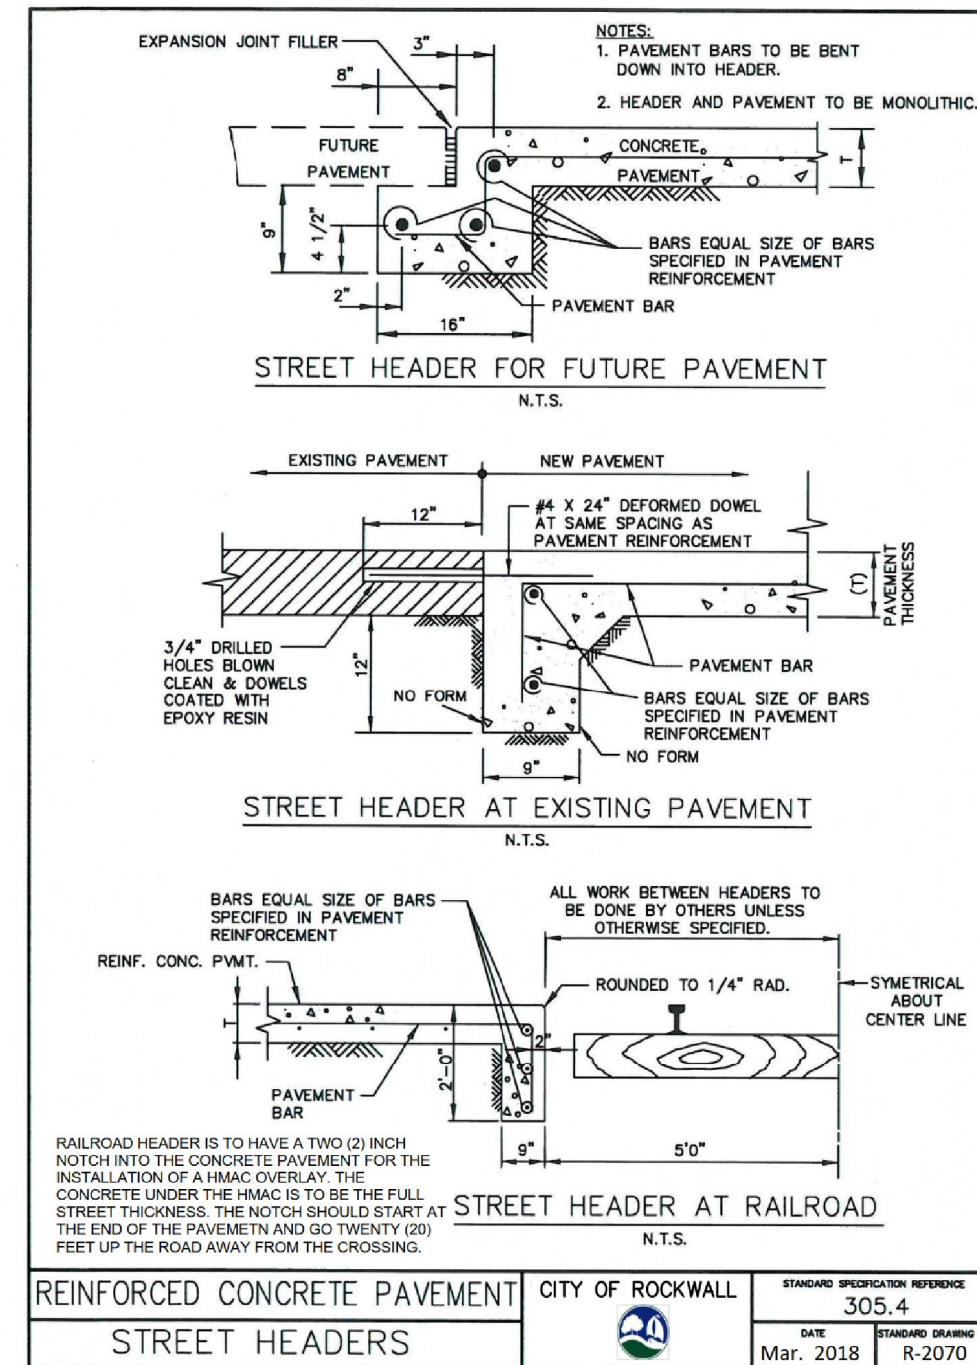
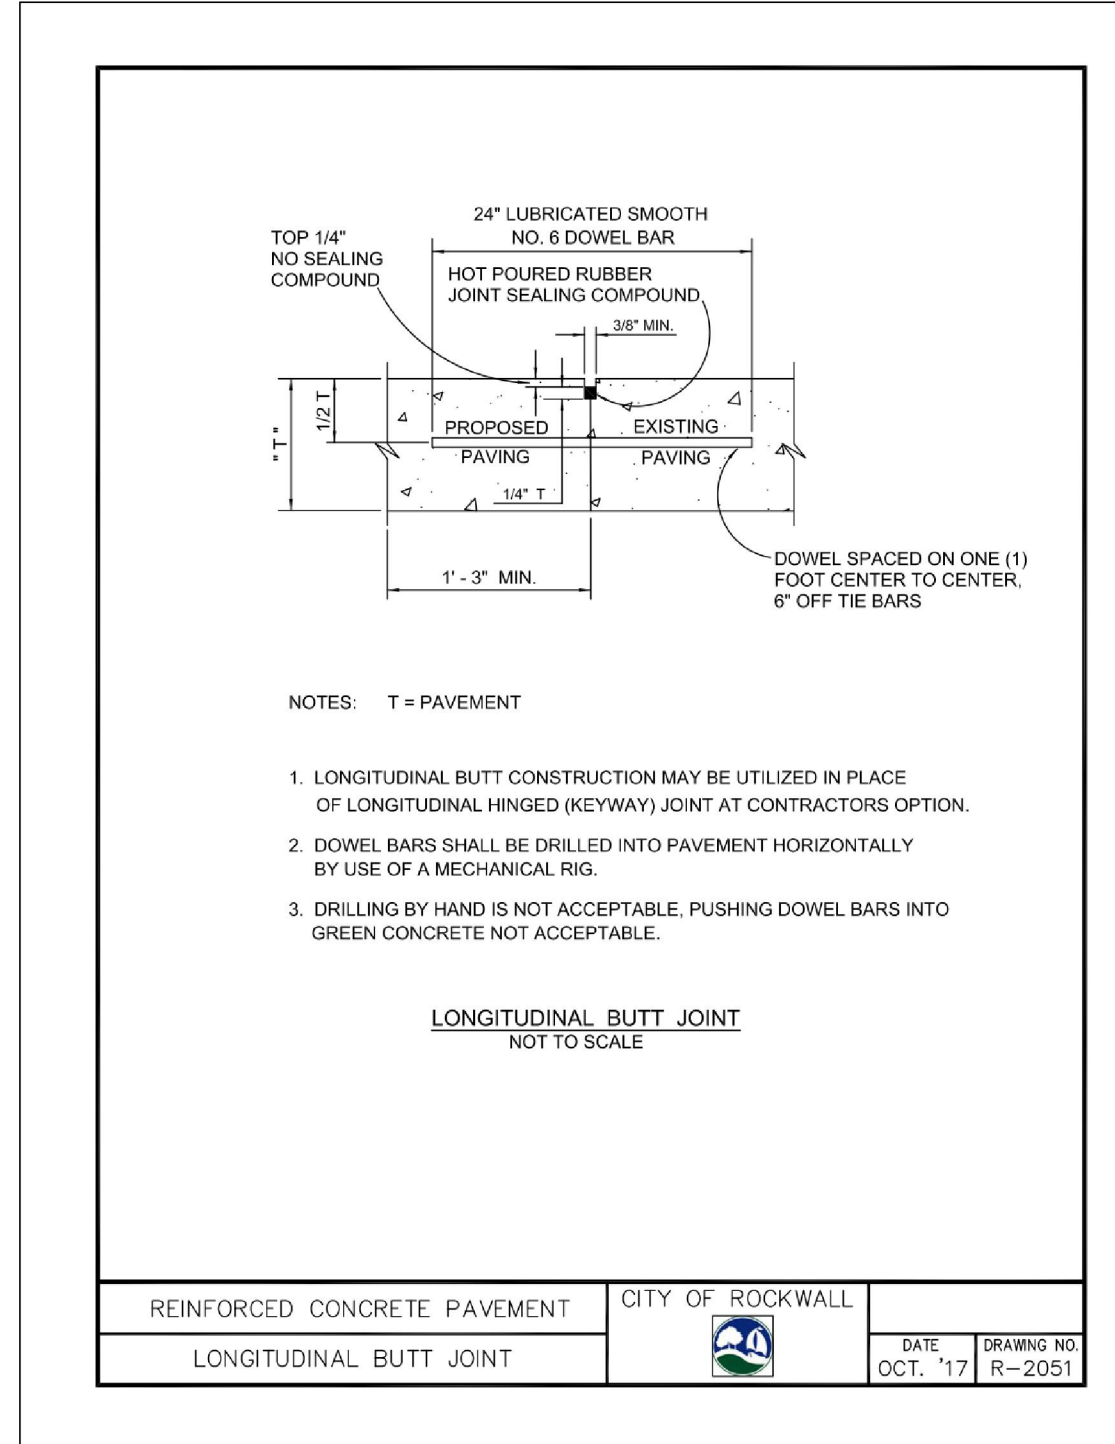


Revision Schedule		
Rev. #	Revision Description	Revision Date

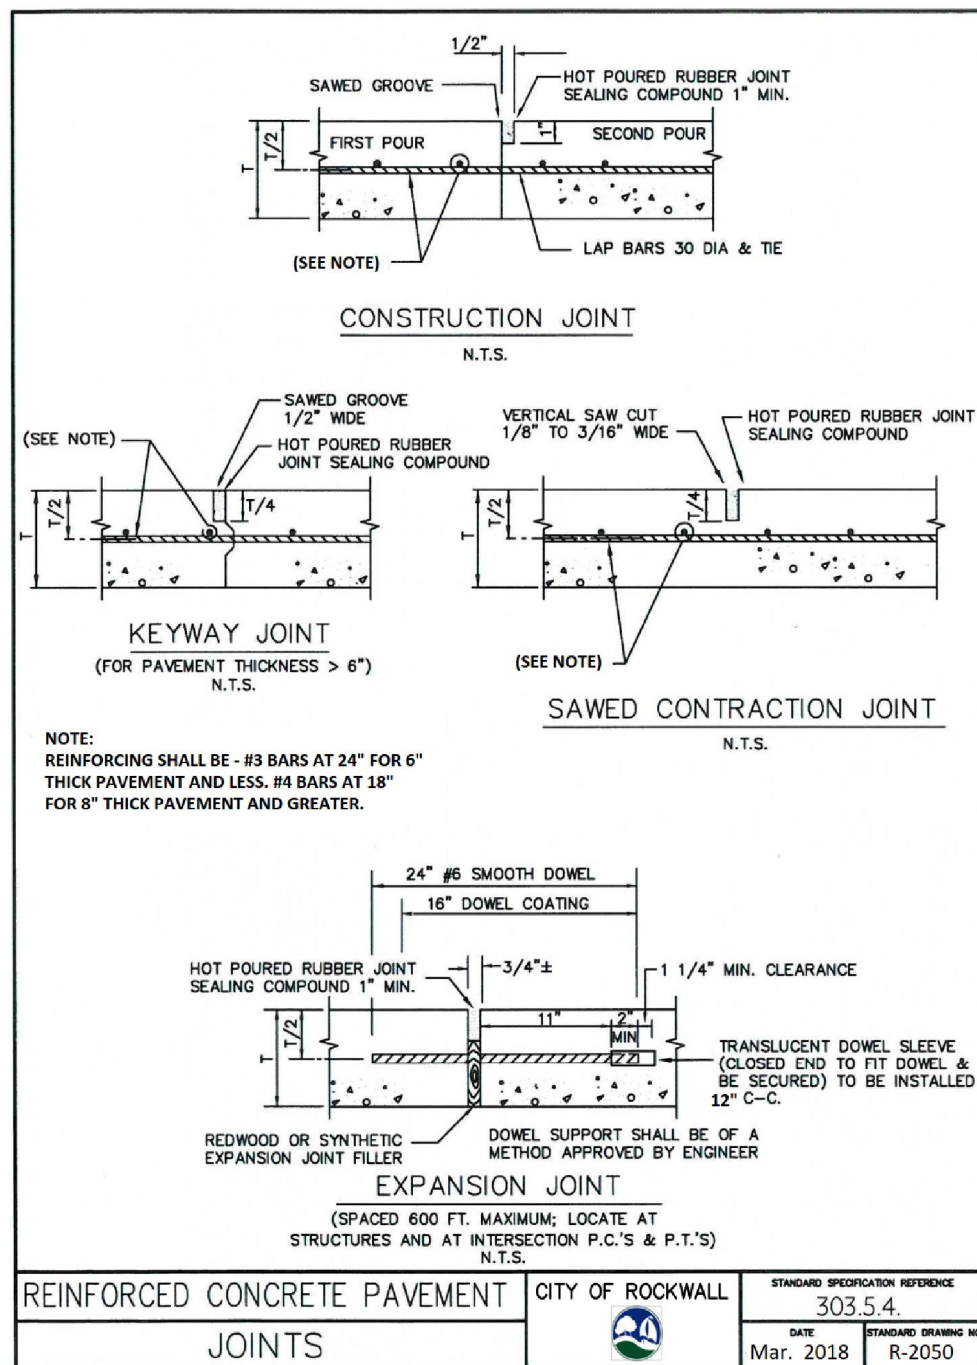

Carrillo Engineering, LLC  
301 Commerce Street, Ste 1410 - Fort Worth, Texas 76102  
Phone 817-697-4996 - Firm Registration #F-15893

OWT ARCHITECTS

509 PECAN STREET SUITE 100 FORT WORTH, TX 76102 817.993.9844

www.owtarchitects.com

ROCKWALL DFPS

ELLIS CENTRE #2 ADDITION BOCK C, LOT 3A-R 1203 SIGMA CT, ROCKWALL, TX 75087

3/1/2021

ISSUE DATE

CITY DETAILS

RECORD DRAWING

TO THE BEST OF OUR KNOWLEDGE CARRILLO ENGINEERING, HEREBY STATES THAT THIS PLAN IS AS-BUILT. THE INFORMATION PROVIDED IS BASED ON SURVEYING AT THE SITE AND INFORMATION PROVIDED BY THE CONTRACTOR.

DATE: SEPTEMBER 27, 2021

C8.02