



Contractor to verify type and depth of existing utilities prior to construction of retaining wall. Conflicting utilities shall be relocated as necessary.

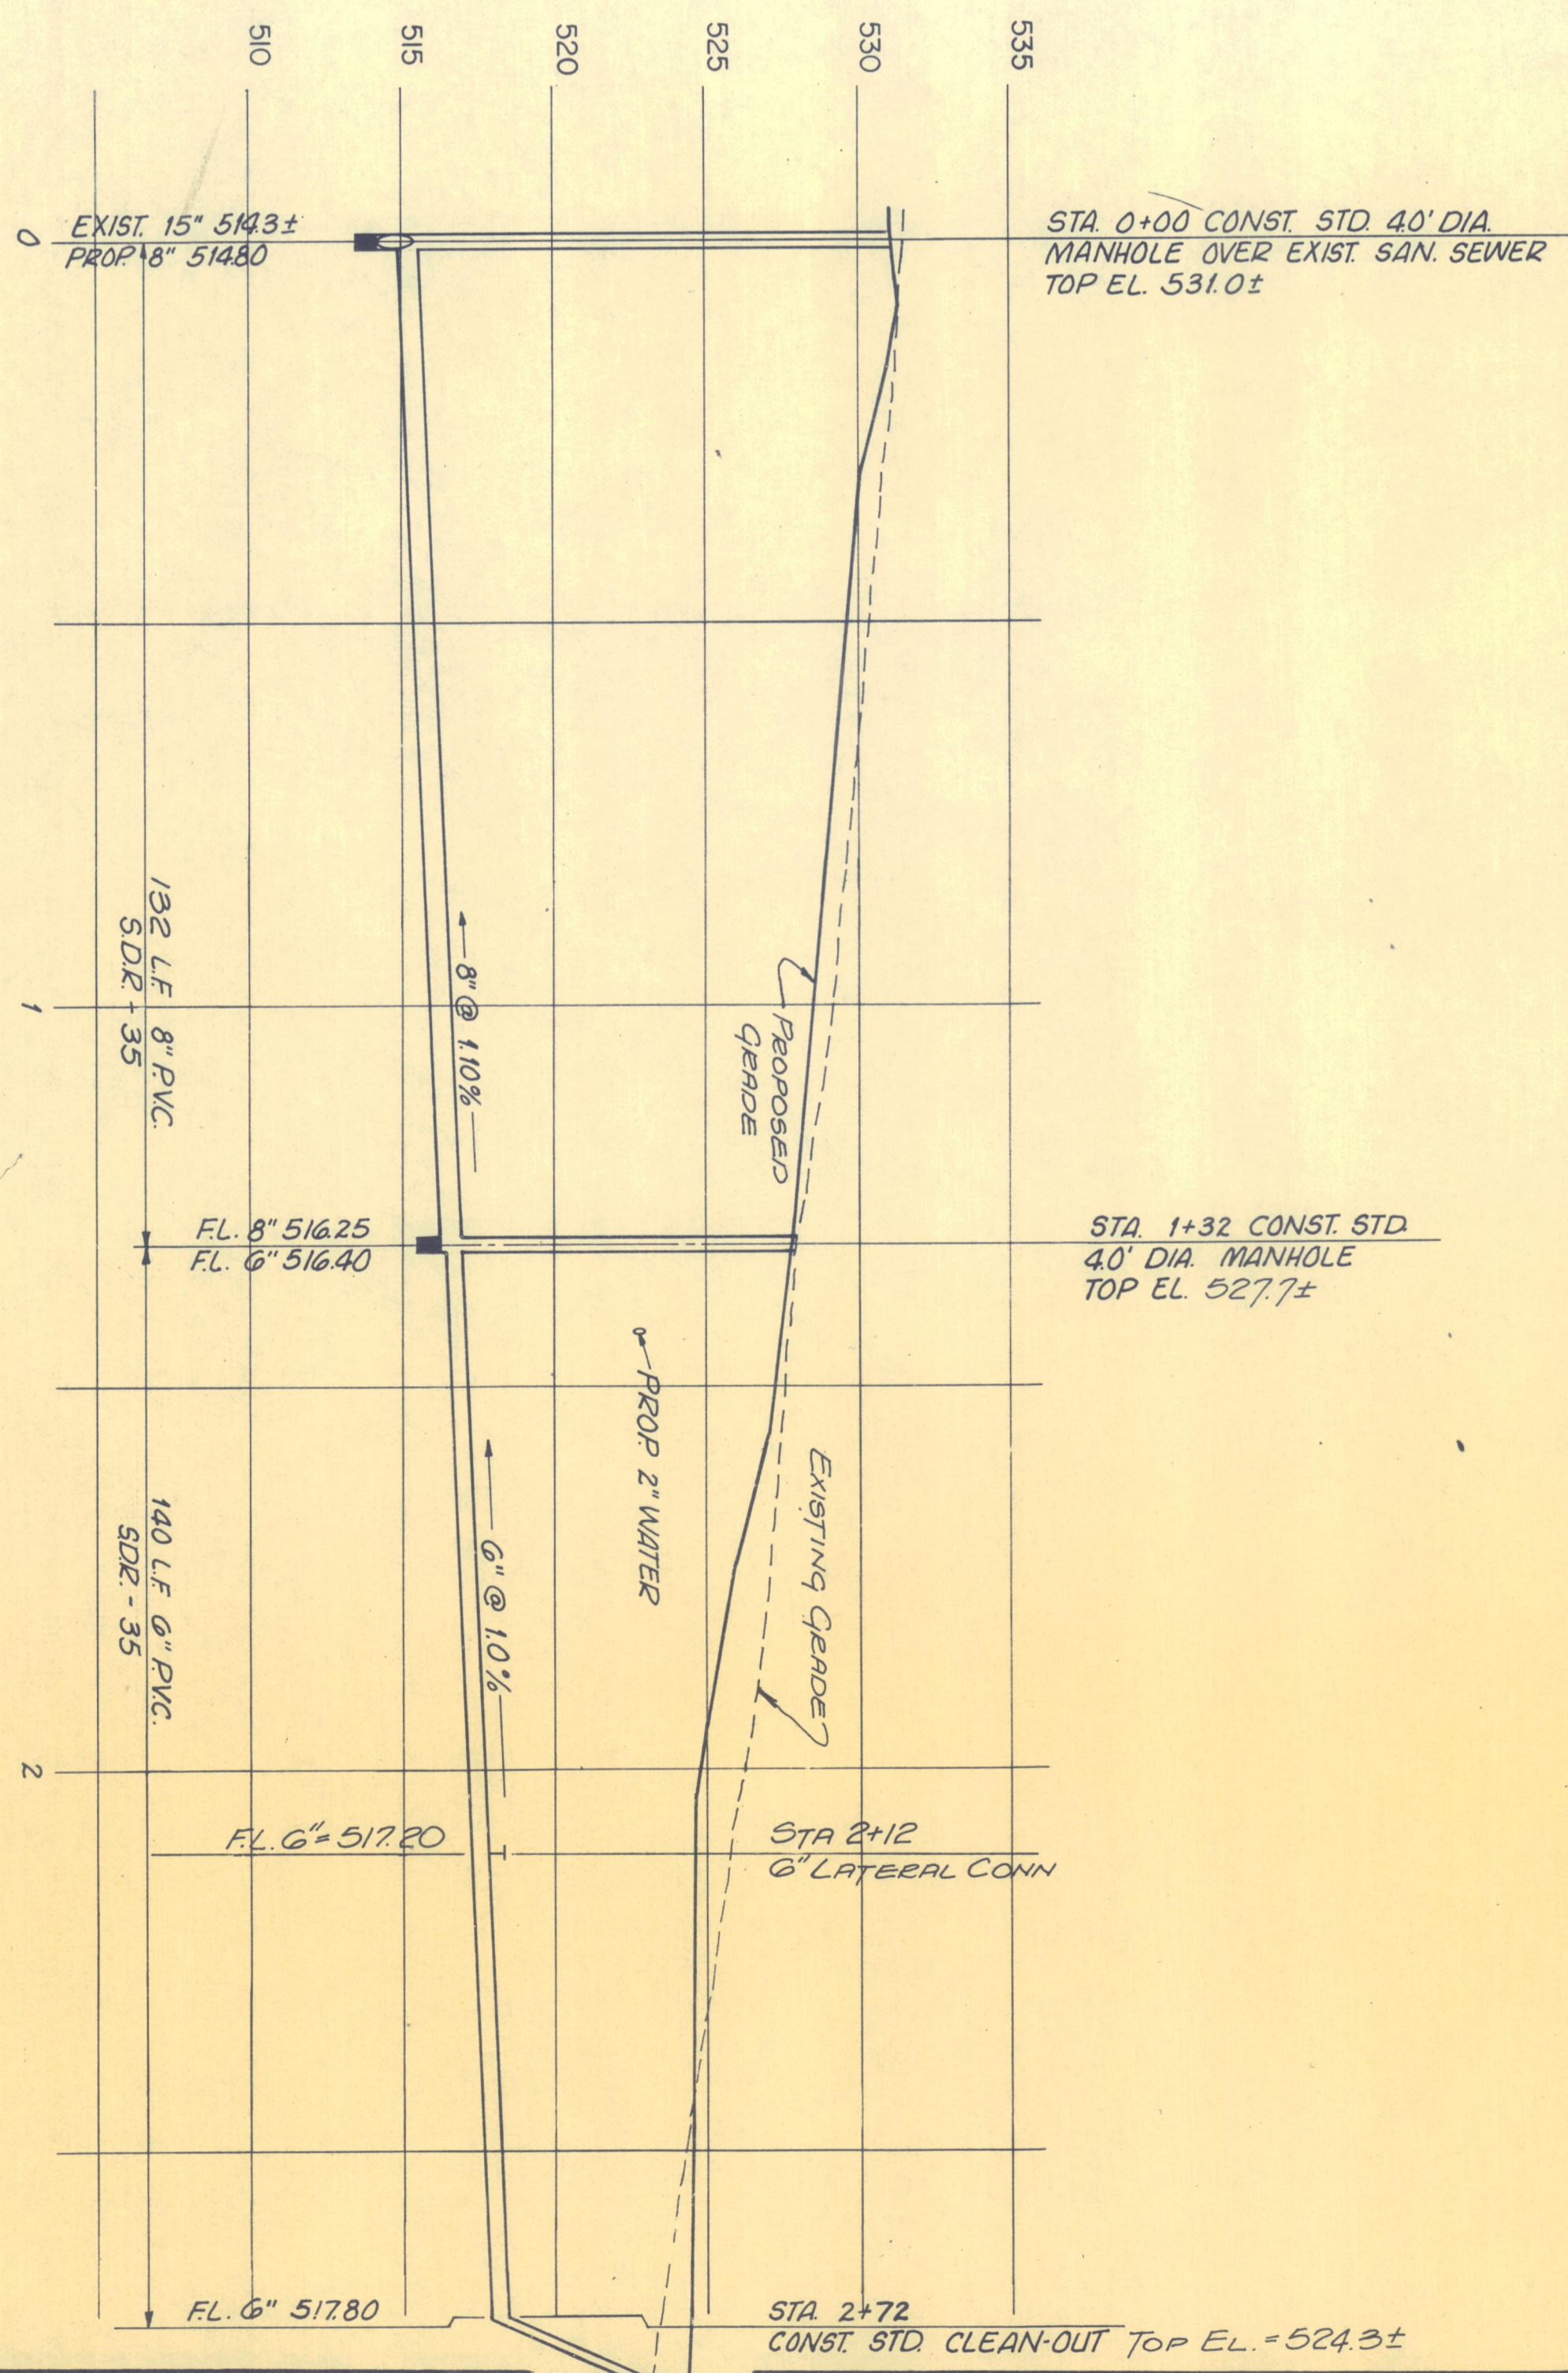

- NOTES:
1. All construction of water and sewer shall conform to the City of Rockwall Standard Specifications and Details for construction. Contractor shall be responsible for obtaining all necessary permits, specifications and details prior to construction, from the City of Rockwall.
  2. Water pipe shall be class 150, AWWA C-900 - 8" V.C. in accordance with Item 15. of the Standard Specifications.
  3. Sanitary sewer pipe shall be 8" V.C., SDR 35 conforming to ASTM D 3034.
  4. Location of existing utilities is approximate only. Contractor to verify location of existing utilities prior to construction.

BLUM CIVIL  
 2000 82-452-02

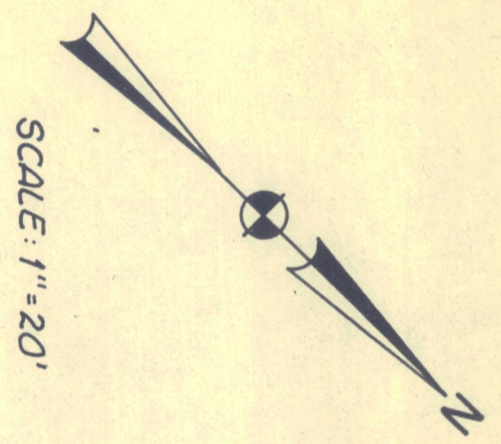

Sheet  
 of  
 sheets  
 date: 10-31-83

Job no:  
 Revisions  
 REVISED 11/23/83

project : CAR WASH  
 ROCKWALL BUSINESS PARK EAST ROCKWALL, TEXAS  
 title : UTILITY PLAN

Haldeman Miller Bregman Hamann  
 Architects  
 Planners  
 Interior Designers  
 214-526-8444  
 3333 Lee Parkway  
 Suite 500  
 Dallas, Texas 75219

Handwritten signature and date: 11/23/83

Blank area for additional notes or stamps.