


Contractor to verify type and depth of existing utilities prior to construction of retaining wall. Conflicting utilities shall be relocated as necessary.



- NOTES:
1. All construction of water and sewer shall conform to the City of Rockwall Standard Specifications and Details for construction. Contractor shall be responsible for obtaining all necessary permits from the City of Rockwall.
 2. Water pipe shall be class 150, AWWA C-900 - 8" V.C. in accordance with Item 15. of the Standard Specifications.
 3. Sanitary sewer pipe shall be 8" V.C., SDR 35 conforming to ASTM D 3034.
 4. Location of existing utilities is approximate only. Contractor to verify location of existing utilities prior to construction.

BLUM CIVIL
 2000 W. 14th Street
 Suite 100
 Rockwall, TX 75087
 972-962-4522

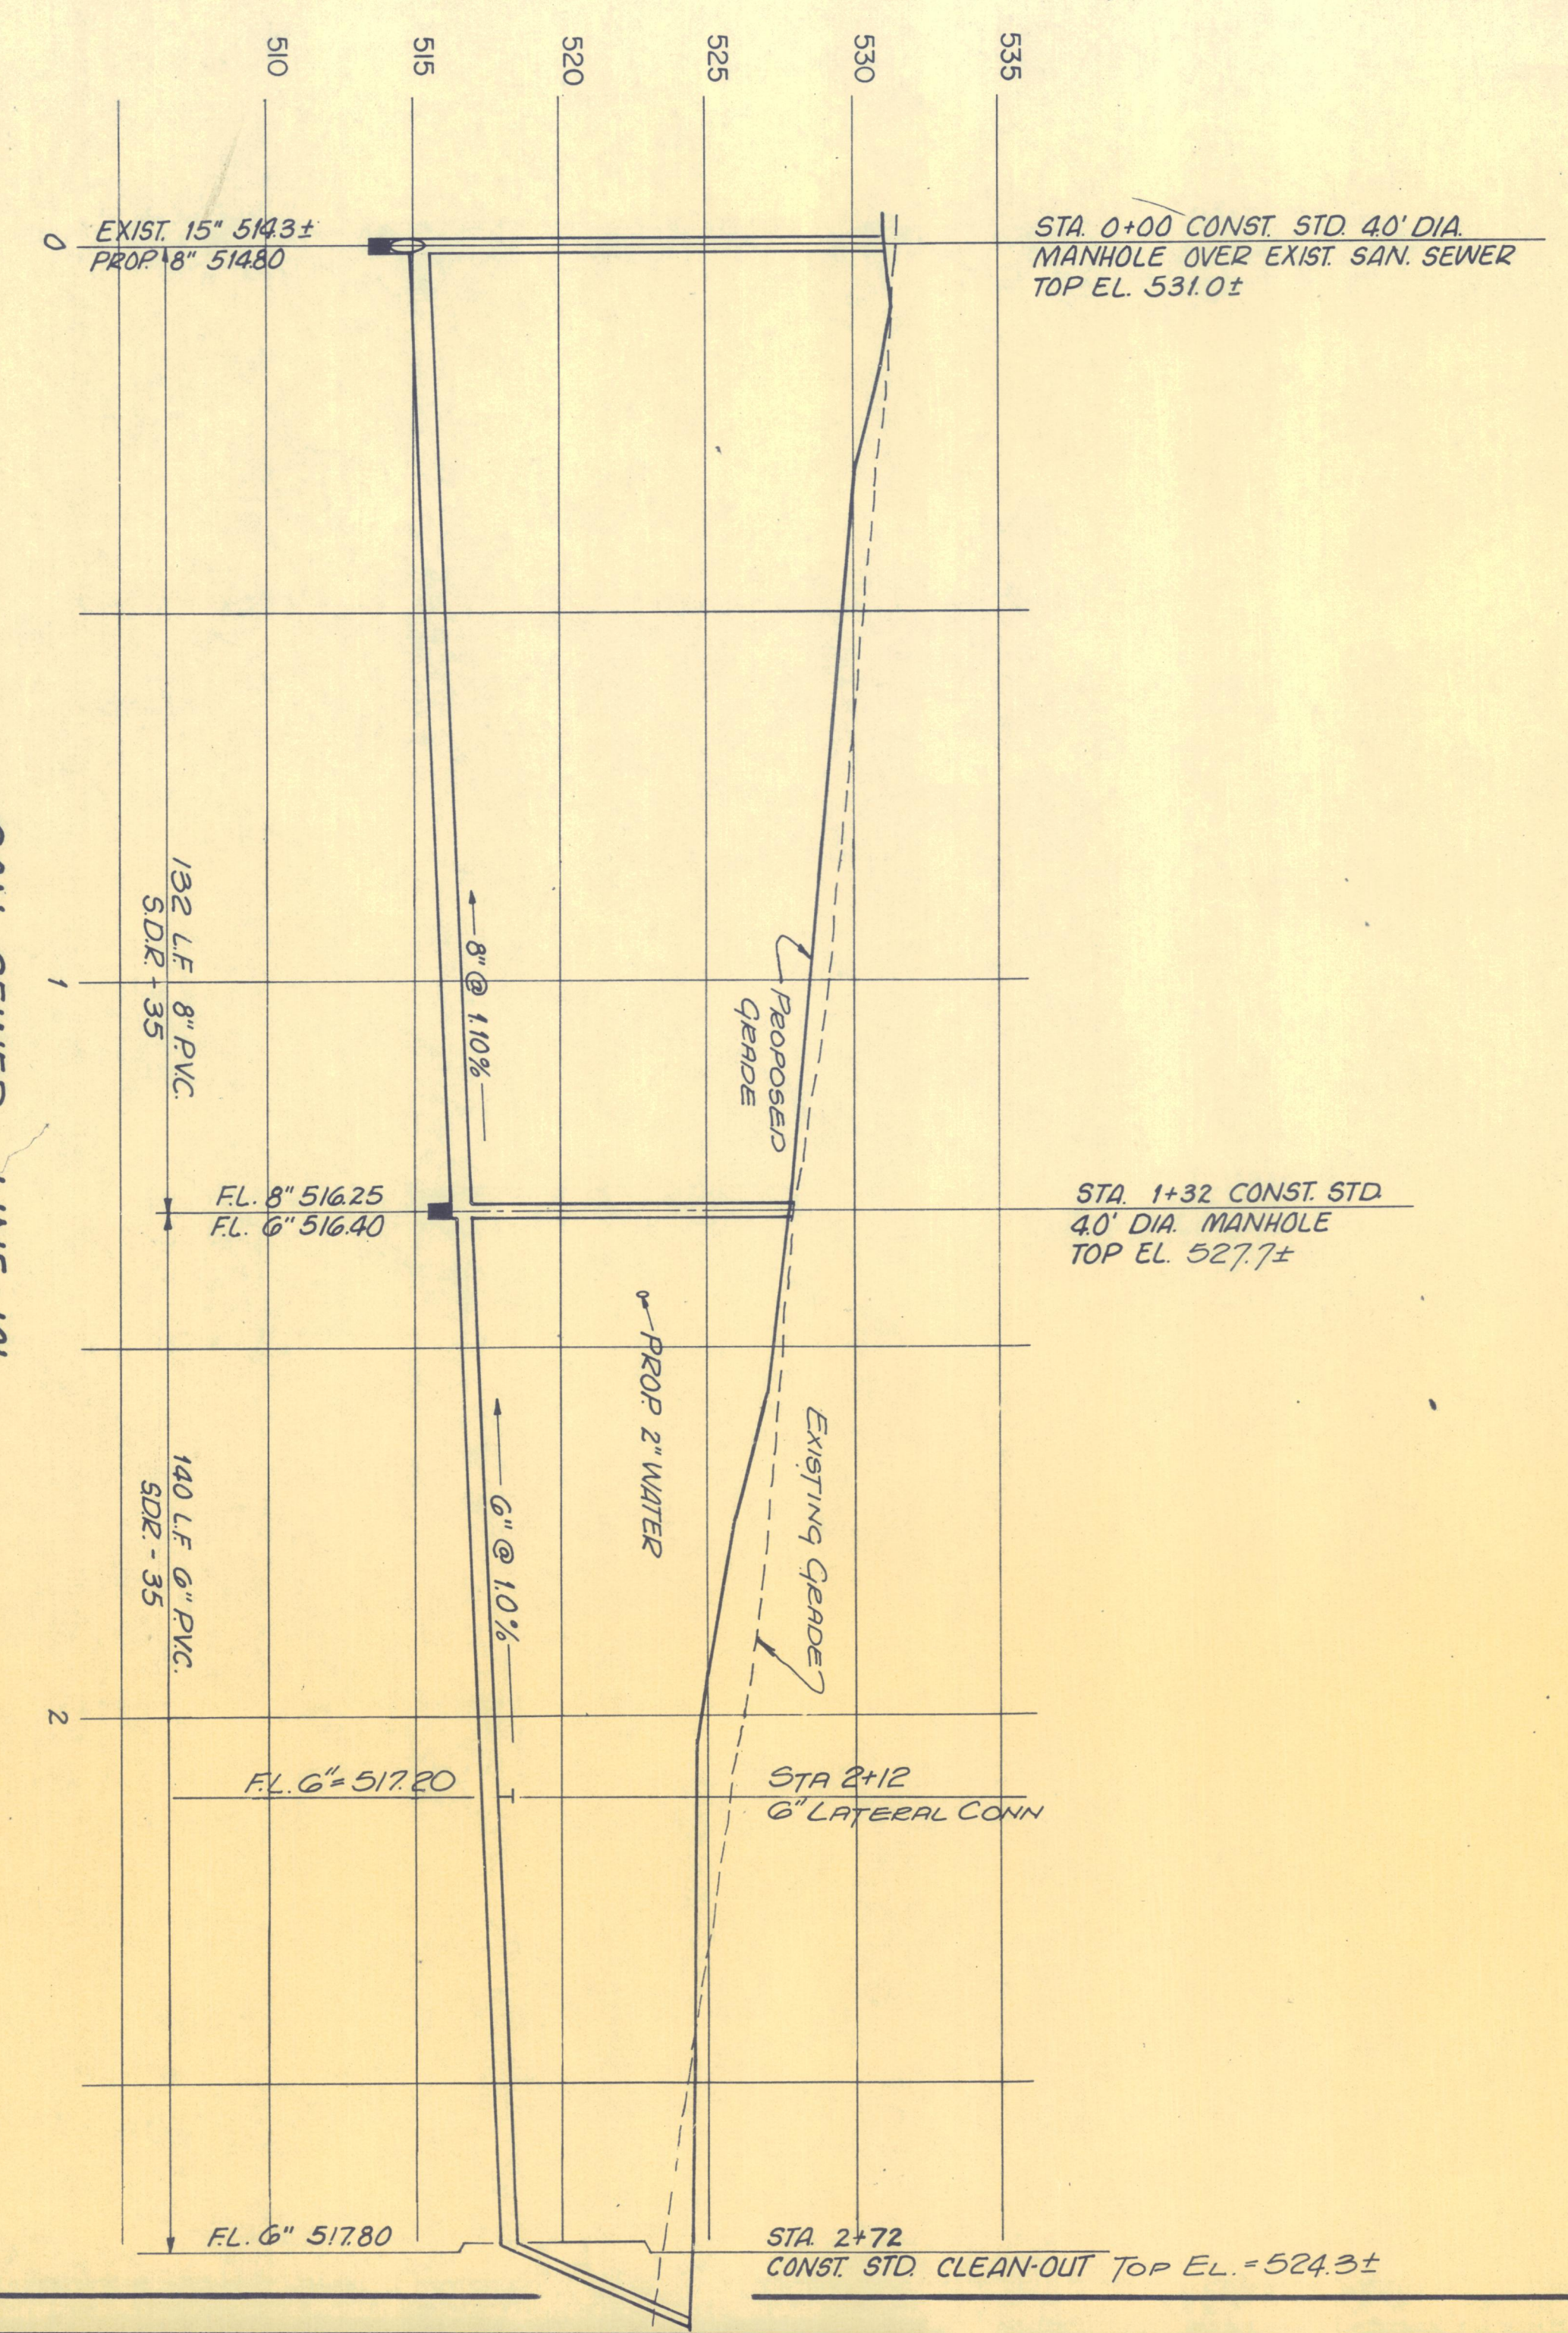

Sheet
 of
 sheets
 C3
 date: 10-31-83

Job no:
 Revisions
 REVISED 11/23/83

project : CAR WASH
 ROCKWALL BUSINESS PARK EAST ROCKWALL, TEXAS
 title : UTILITY PLAN

Haldeman Miller Bregman Hamann Architects
 Planners Interior Designers
 214-526-8444
 3333 Lee Parkway Suite 500
 Dallas, Texas 75219

H M B H

4071

Blank area for additional notes or stamps.